


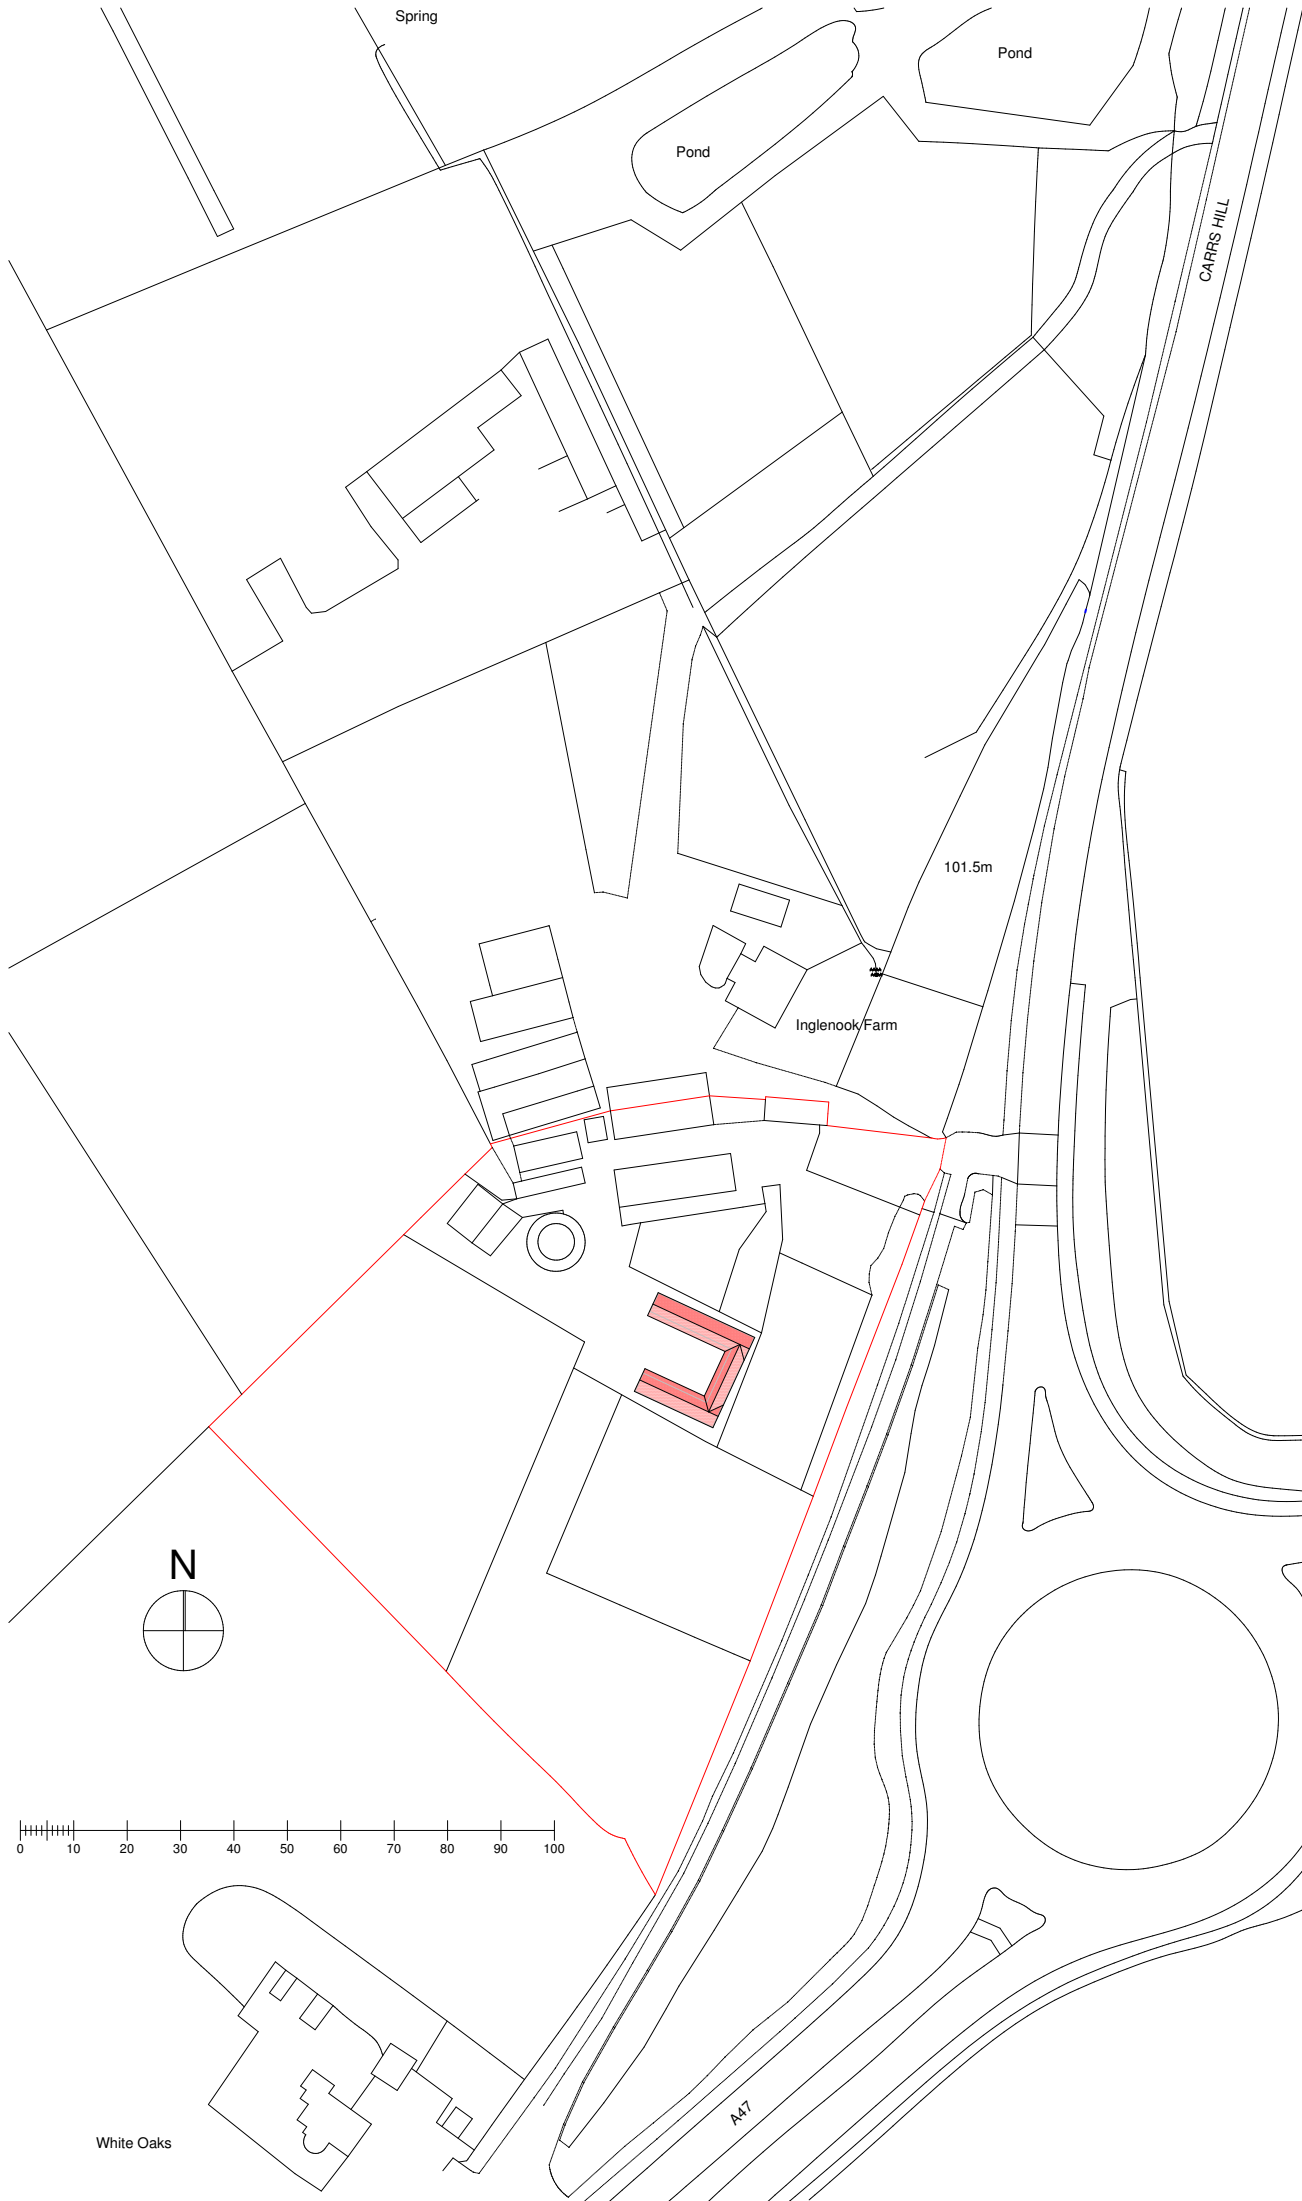

DRAWING MAY BE SCALED FOR PLANNING PURPOSES ONLY.
COPYRIGHT REMAINS PROPERTY OF THE DRAWING ROOM (ARCHITECTS) LTD. NO COPIES OF DRAWING TO BE TAKEN WITHOUT PERMISSION.

PERMISSION IS NOT GRANTED FOR THESE
PLANS TO BE USED FOR THE PURPOSES
OF OBTAINING BUILDING QUOTATIONS UNTIL
RELEVANT APPROVALS HAVE BEEN GRANTED
BY LOCAL AUTHORITY.

IT IS THE RESPONSIBILITY OF THE CLIENT TO CHECK THAT THE
PLAN DOES NOT CONTRAVENE OR AFFECT COVENANTS OR
ENCKROACH ANY BOUNDARIES. IT IS NOT THE RESPONSIBILITY
OF THE DRAWING ROOM (ARCHITECTS) LTD TO CHECK ANY MATTERS
RELATING TO LAND TITLE OR PORTIONS OF PUBLIC DRAINAGE.

IT IS THE RESPONSIBILITY OF THE CLIENT TO ENSURE THAT ANY
ISSUES RELATING TO THE PARTY WALL ACT ARE IMPLEMENTED
AT THE RELEVANT STAGES.

ALL DRAWINGS ARE BASED UPON MEASURED SURVEYS ONLY.

IT IS THE CLIENT'S RESPONSIBILITY TO APPOINT A QUALIFIED
STRUCTURAL ENGINEER TO DEAL WITH ALL STRUCTURAL
SPECIFICATIONS RESULTING FROM ALL NEW CONSTRUCTION
WORK AND ALL ALTERATIONS TO THE EXISTING STRUCTURE.
NO RESPONSIBILITY IS ACCEPTED BY THE DRAWING ROOM
(ARCHITECTS) LTD FOR ANY STRUCTURAL ELEMENTS.

IT IS THE NOT RESPONSIBILITY OF THE DRAWING ROOM (ARCHITECTS)
LTD TO ADMINISTER ANY AGREEMENTS WITH OTHER STATUTORY
BODIES & SEVEN-TENTH WATER LTD. LOCATION OF DRAINAGE
(WHERE SHOWN) & INVERT LEVELS ARE TO BE VERIFIED PRIOR TO
COMMENCEMENT OF BUILDING WORKS. NO RESPONSIBILITY IS ACCEPTED
FOR THE POSITIONING OF ANY BELOW GROUND DRAINAGE.



130 Moat Street, Wigston
Leicester. LE18 2GE.
0116 288 0111
info@tdrarchitects.co.uk www.tdrarchitects.co.uk

Job Title:- Development at:
Davidson Equestrian, Inglenook Farm,
Barwell, United Kingdom, LE9 8BD

Dwg Title:- As Built Site Plan

Date:- March 2024

Scale:- 1:500

Dwg No:-	Size:-	Rev
4070 - 02	A1	