

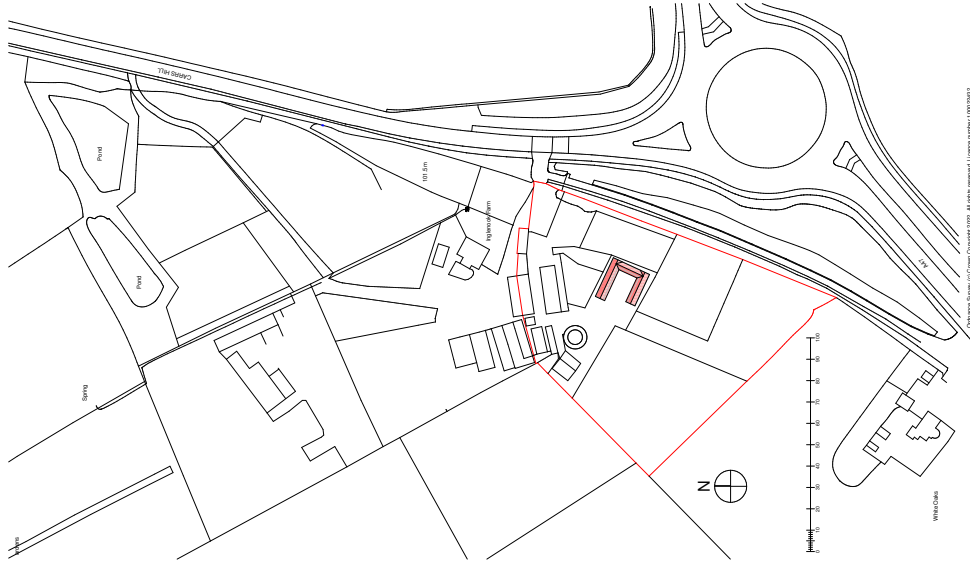


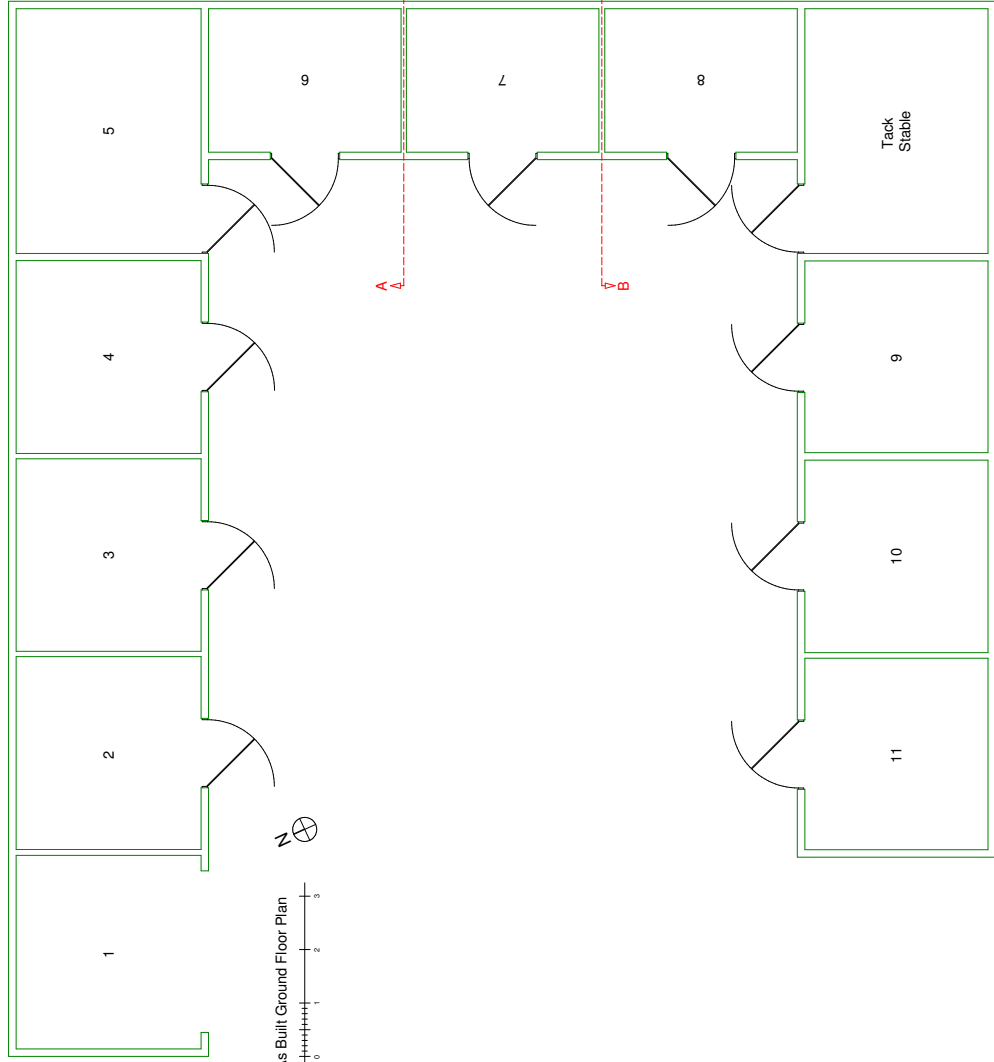

DRAWING MAY BE CALLED FOR PLANNING PURPOSES ONLY. COPYRIGHT REMAINS PROPERTY OF THE DRAWING ROOM ARCHITECTS LIMITED. ALL RIGHTS RESERVED. NO PART OF THIS DRAWING MAY BE REPRODUCED OR TRANSMITTED IN ANY FORM OR BY ANY MEANS, ELECTRONIC OR MECHANICAL, WITHOUT PERMISSION IN WRITING FROM THE DRAWING ROOM ARCHITECTS LIMITED.	PERMISSION IS NOT GRANTED FOR THESE PLANS TO BE USED FOR THE PURPOSES OF OBTAINING A BUILDING REGULATION APPROVAL. ANY SUCH USE WITHOUT THE RELEVANT APPROVALS HAVE BEEN GRANTED BY LOCAL AUTHORITY	IT IS THE RESPONSIBILITY OF THE CLIENT TO CHECK THAT THE PROPOSED WORK DOES NOT CONTRADICT ANY EXISTING ENFORCEMENT OF BUILDING REGULATIONS. IT IS NOT THE RESPONSIBILITY OF THE DRAWING ROOM ARCHITECTS LTD TO CHECK ANY MATTERS RELATING TO LAND TITLE OR FORTHCOMING PUBLIC ENFORCEMENT.	IT IS THE RESPONSIBILITY OF THE CLIENT TO ENSURE THAT ANY ISSUES RELATING TO THE PARTY WALL ACT ARE IMPLEMENTED AT THE RELEVANT STAGES	ALL DRAWINGS ARE BASED UPON MEASURED SURVEYS ONLY.	IT IS THE CLIENT'S RESPONSIBILITY TO OBTAIN ALL NECESSARY CONSENTS AND APPROVALS FROM THE LOCAL AUTHORITY BEFORE COMMENCING WORK. THE CLIENT IS RESPONSIBLE FOR SPECIFICATIONS RESULTING FROM ALL NEW CONSTRUCTION WORK AND ALL ALTERATIONS TO THE EXISTING STRUCTURE. THE DRAWING ROOM ARCHITECTS LTD IS NOT RESPONSIBLE FOR ANY STRUCTURAL ELEMENTS.	IT IS THE CLIENT'S RESPONSIBILITY OF THE DRAWING ROOM ARCHITECTS LTD TO ADMINISTER ANY AGREEMENTS WITH OTHERS IN ACTION RELATING TO THE PROPOSED WORK. THE CLIENT IS RESPONSIBLE FOR OBTAINING ALL NECESSARY CONSENTS AND APPROVALS FROM THE LOCAL AUTHORITY. THE CLIENT IS RESPONSIBLE FOR THE COMMENCEMENT OF BUILDING WORKS. NO RESPONSIBILITY IS ACCEPTED FOR THE FORTHCOMING OF ANY BUILDING WORKS.
The Drawing Room (Architects) Ltd						
130 Moat Street, Wigston Leicester, LE18 2GE. 0116 288 0111 info@drawingroom.co.uk www.drawingroom.co.uk						
Job Title: Development at: Davidson Equine, Inglesbrook Farm, Barwell, United Kingdom, LE19 8BD						
Dwg Title: As Built Plans & Elevations						
Date: March 2024						
Scale: 1:50 1:100 1:1250						
Dwg No: 4070 - 01						
Size: A1						
Rev						

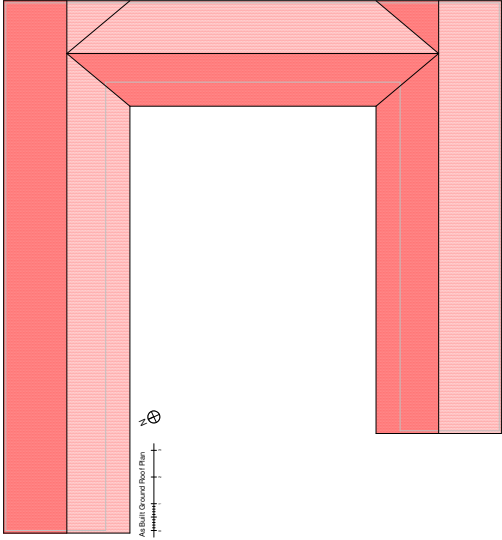