



Proposed Canopy over Car Wash Area Rear Elevation

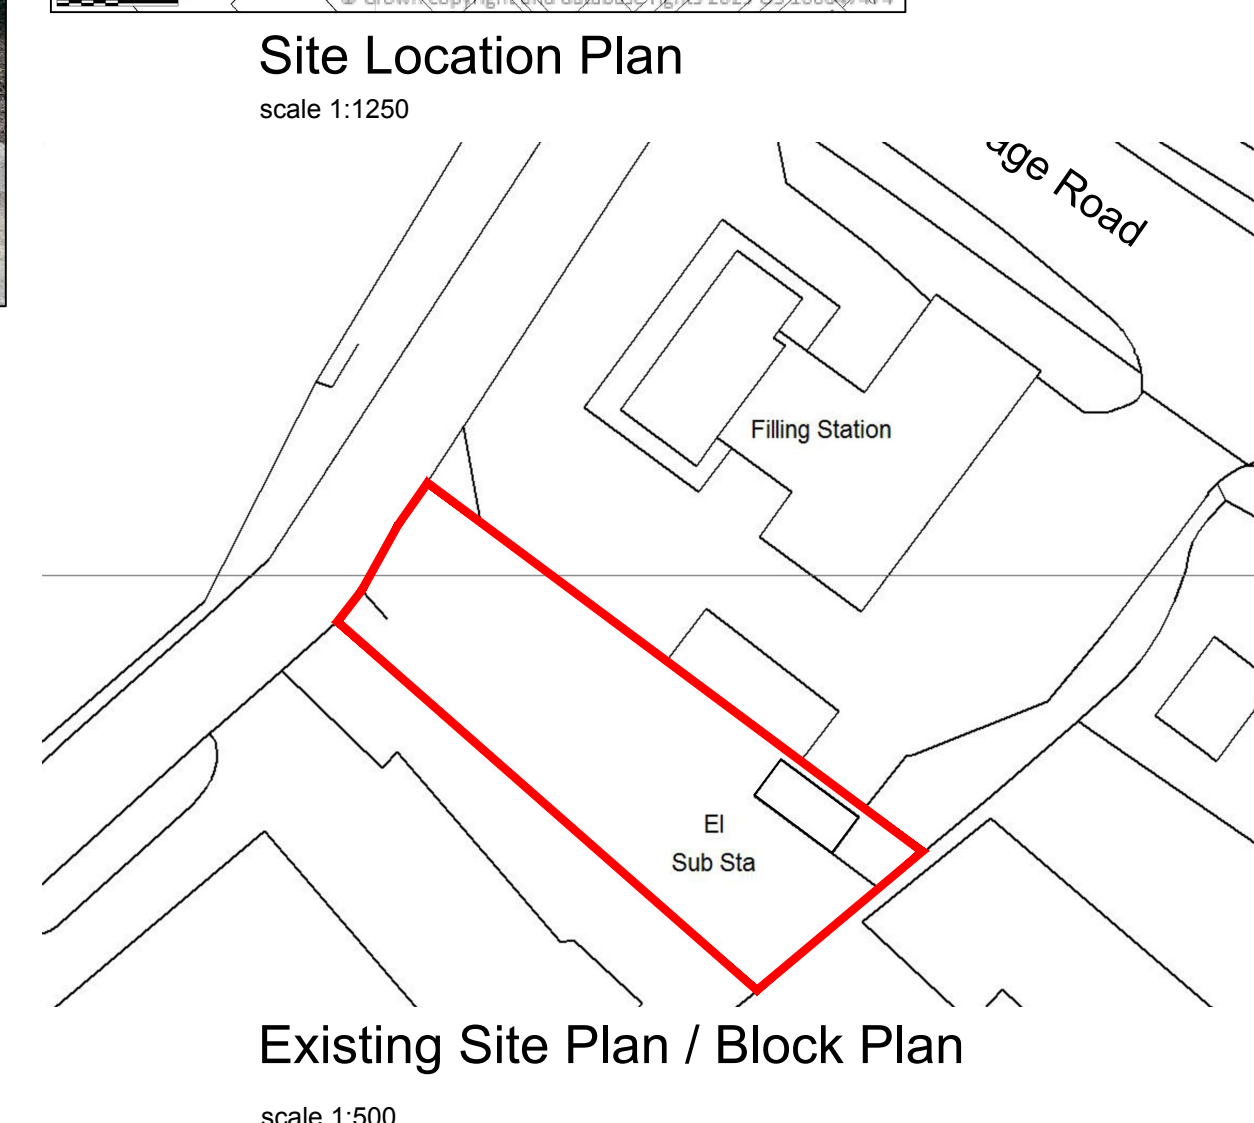

Car Drying/vacuum Area Front Elevation

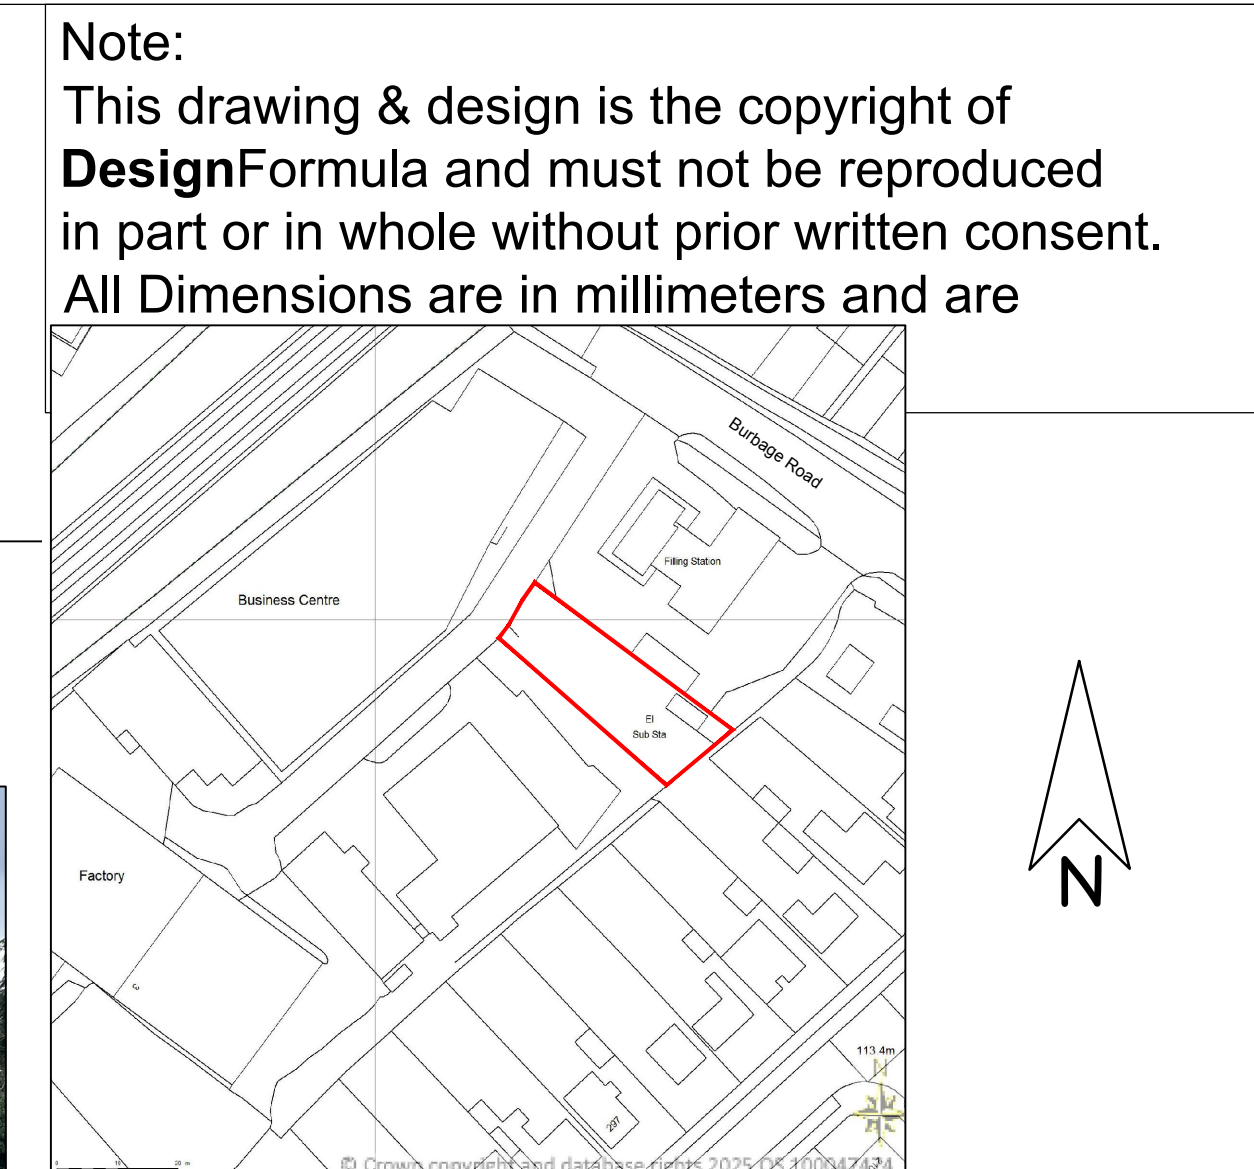

Note:
-All Dimensions are in millimeters and are approximate.
-New Extension in Render & Timber Cladding.
-New windows to match existing.
-New RWP drains to be connected to existing.


DESIGNFORMULA
07814262723

Project Title: Automatic Engineers
Hinckley Limited
Burbage Road, Hinckley

Details: Retrospective Application
Approval of Erected Canopies,
Car Wash Use And
Associated external works
including concrete hard surface

Drawing: Existing & Proposed
Plans-Elevations PLANNING

Scale: 1:100 & as noted @ A1
Date: Feb 2025
Drg No: 5107-200Rev B

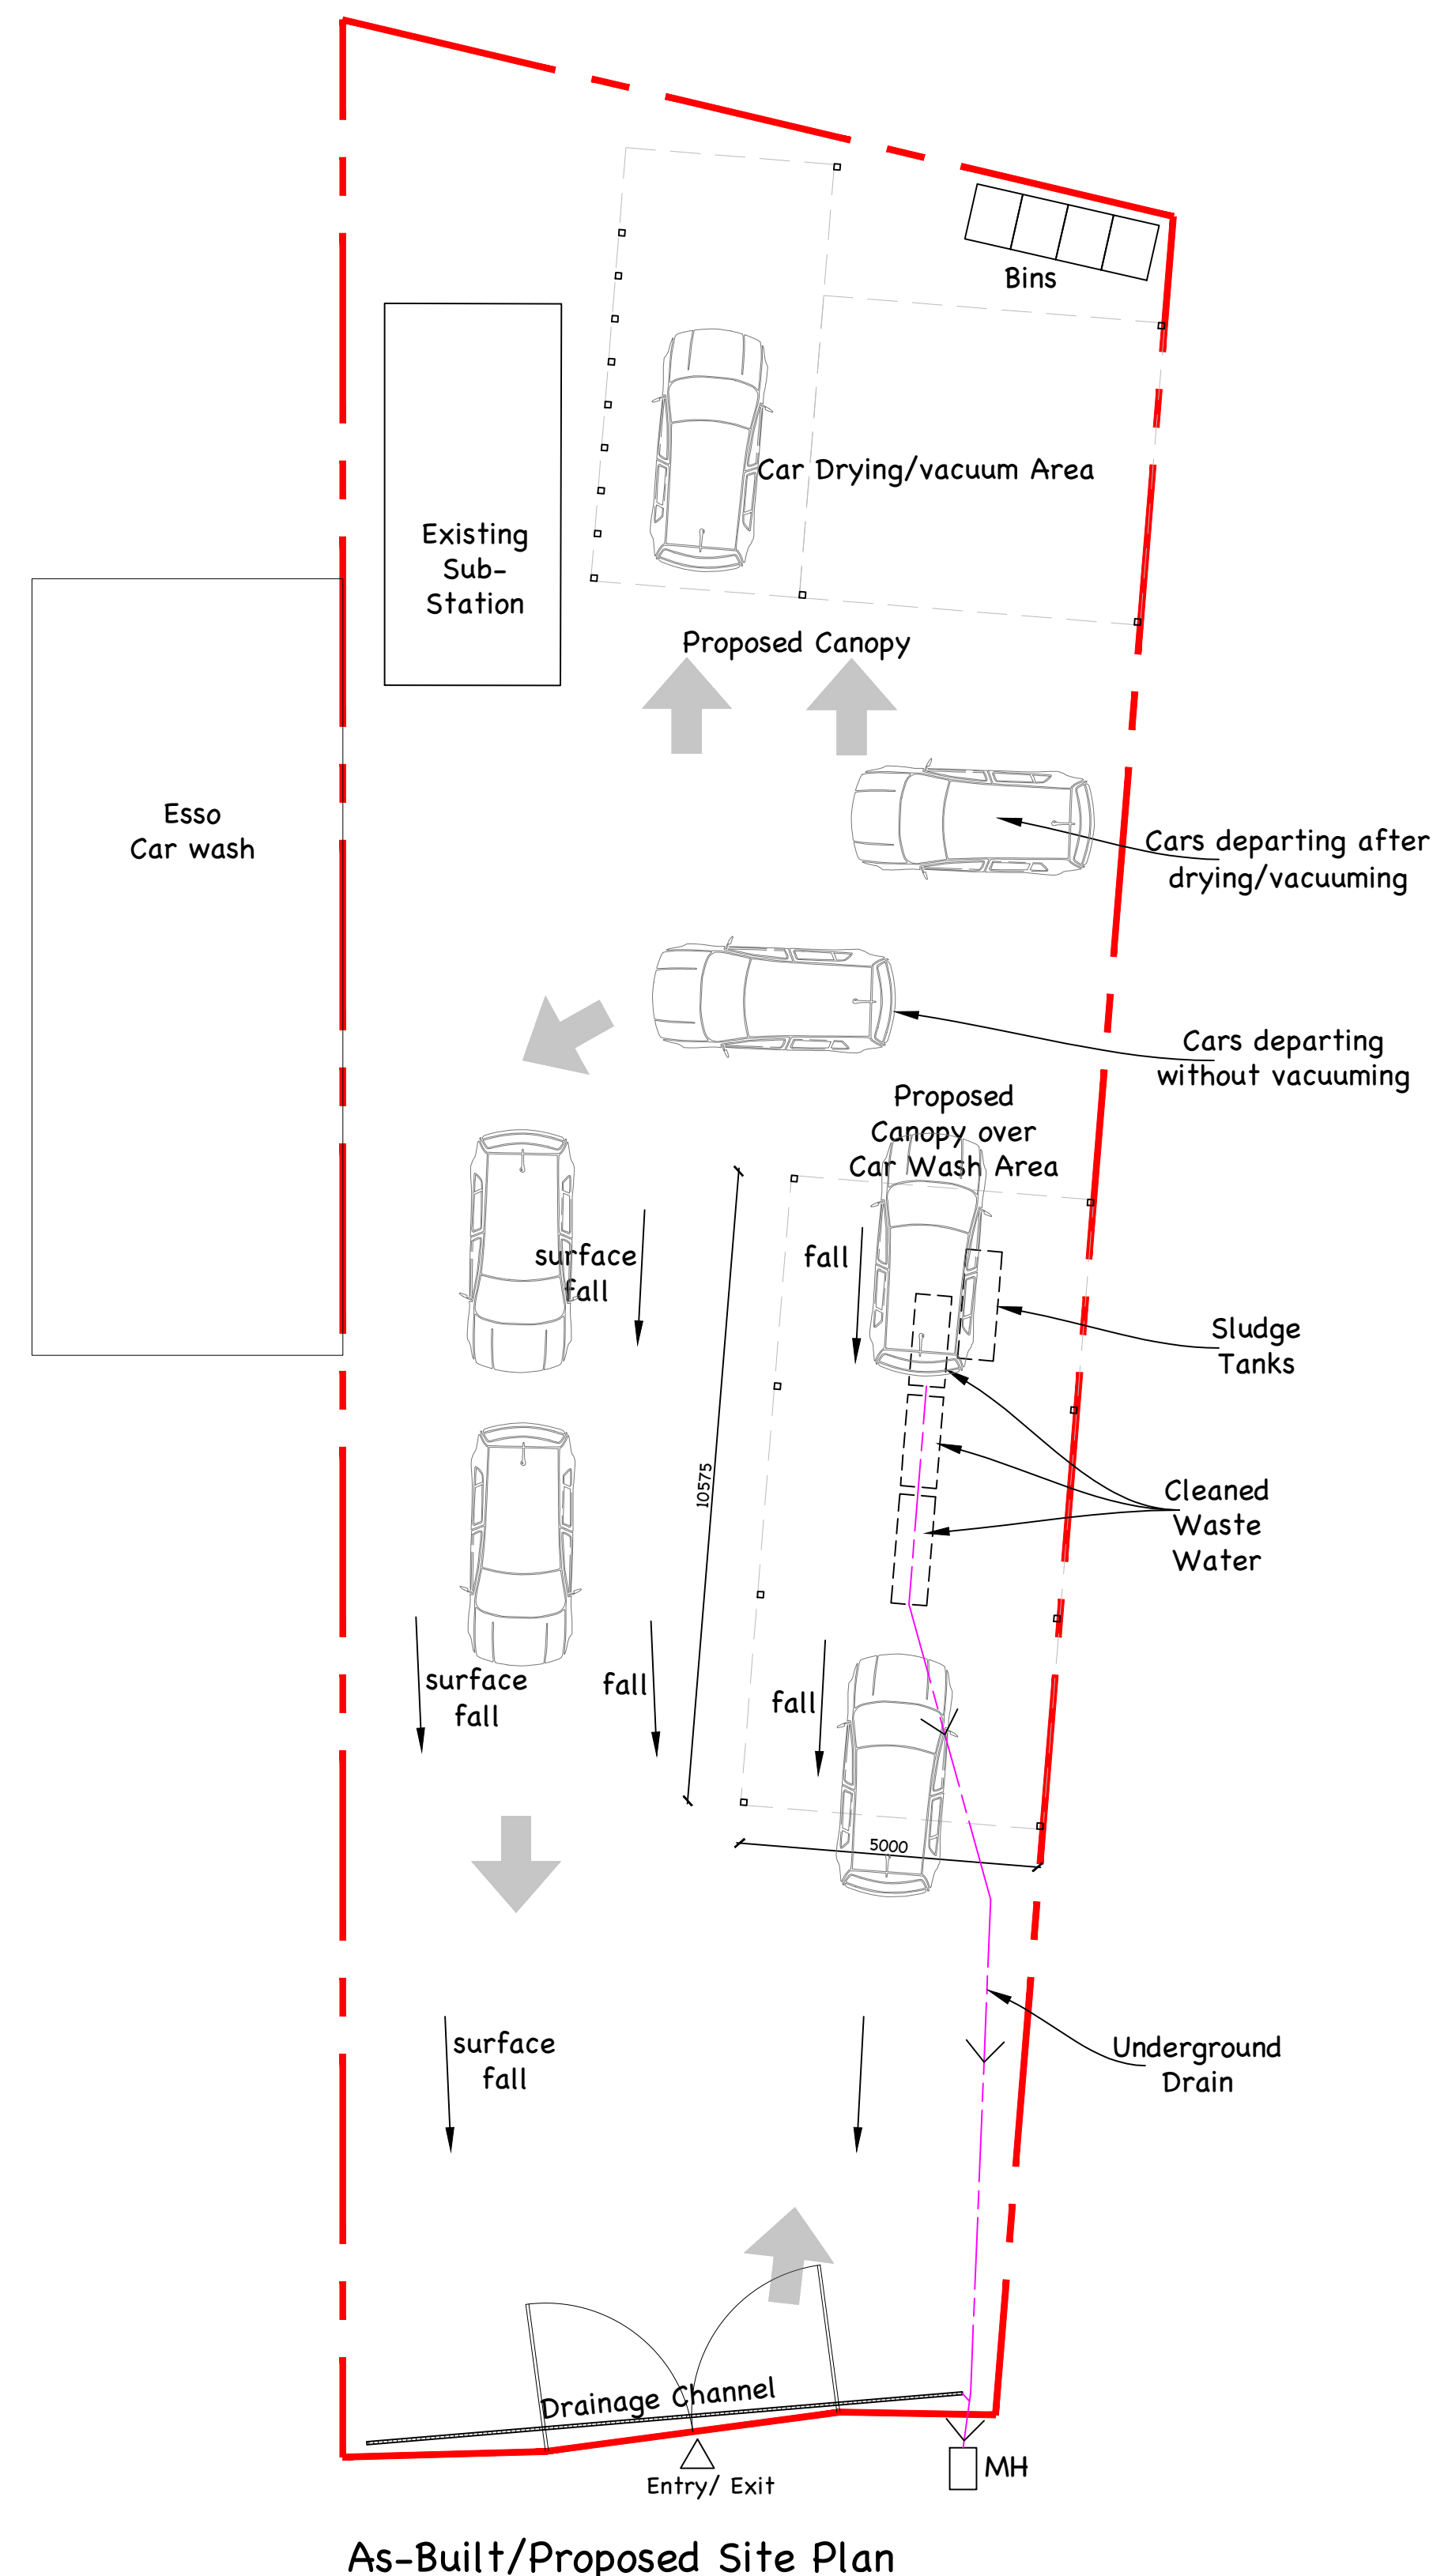

Rev B - Canopy photos added
Rev A - Redline highlighted in Red