


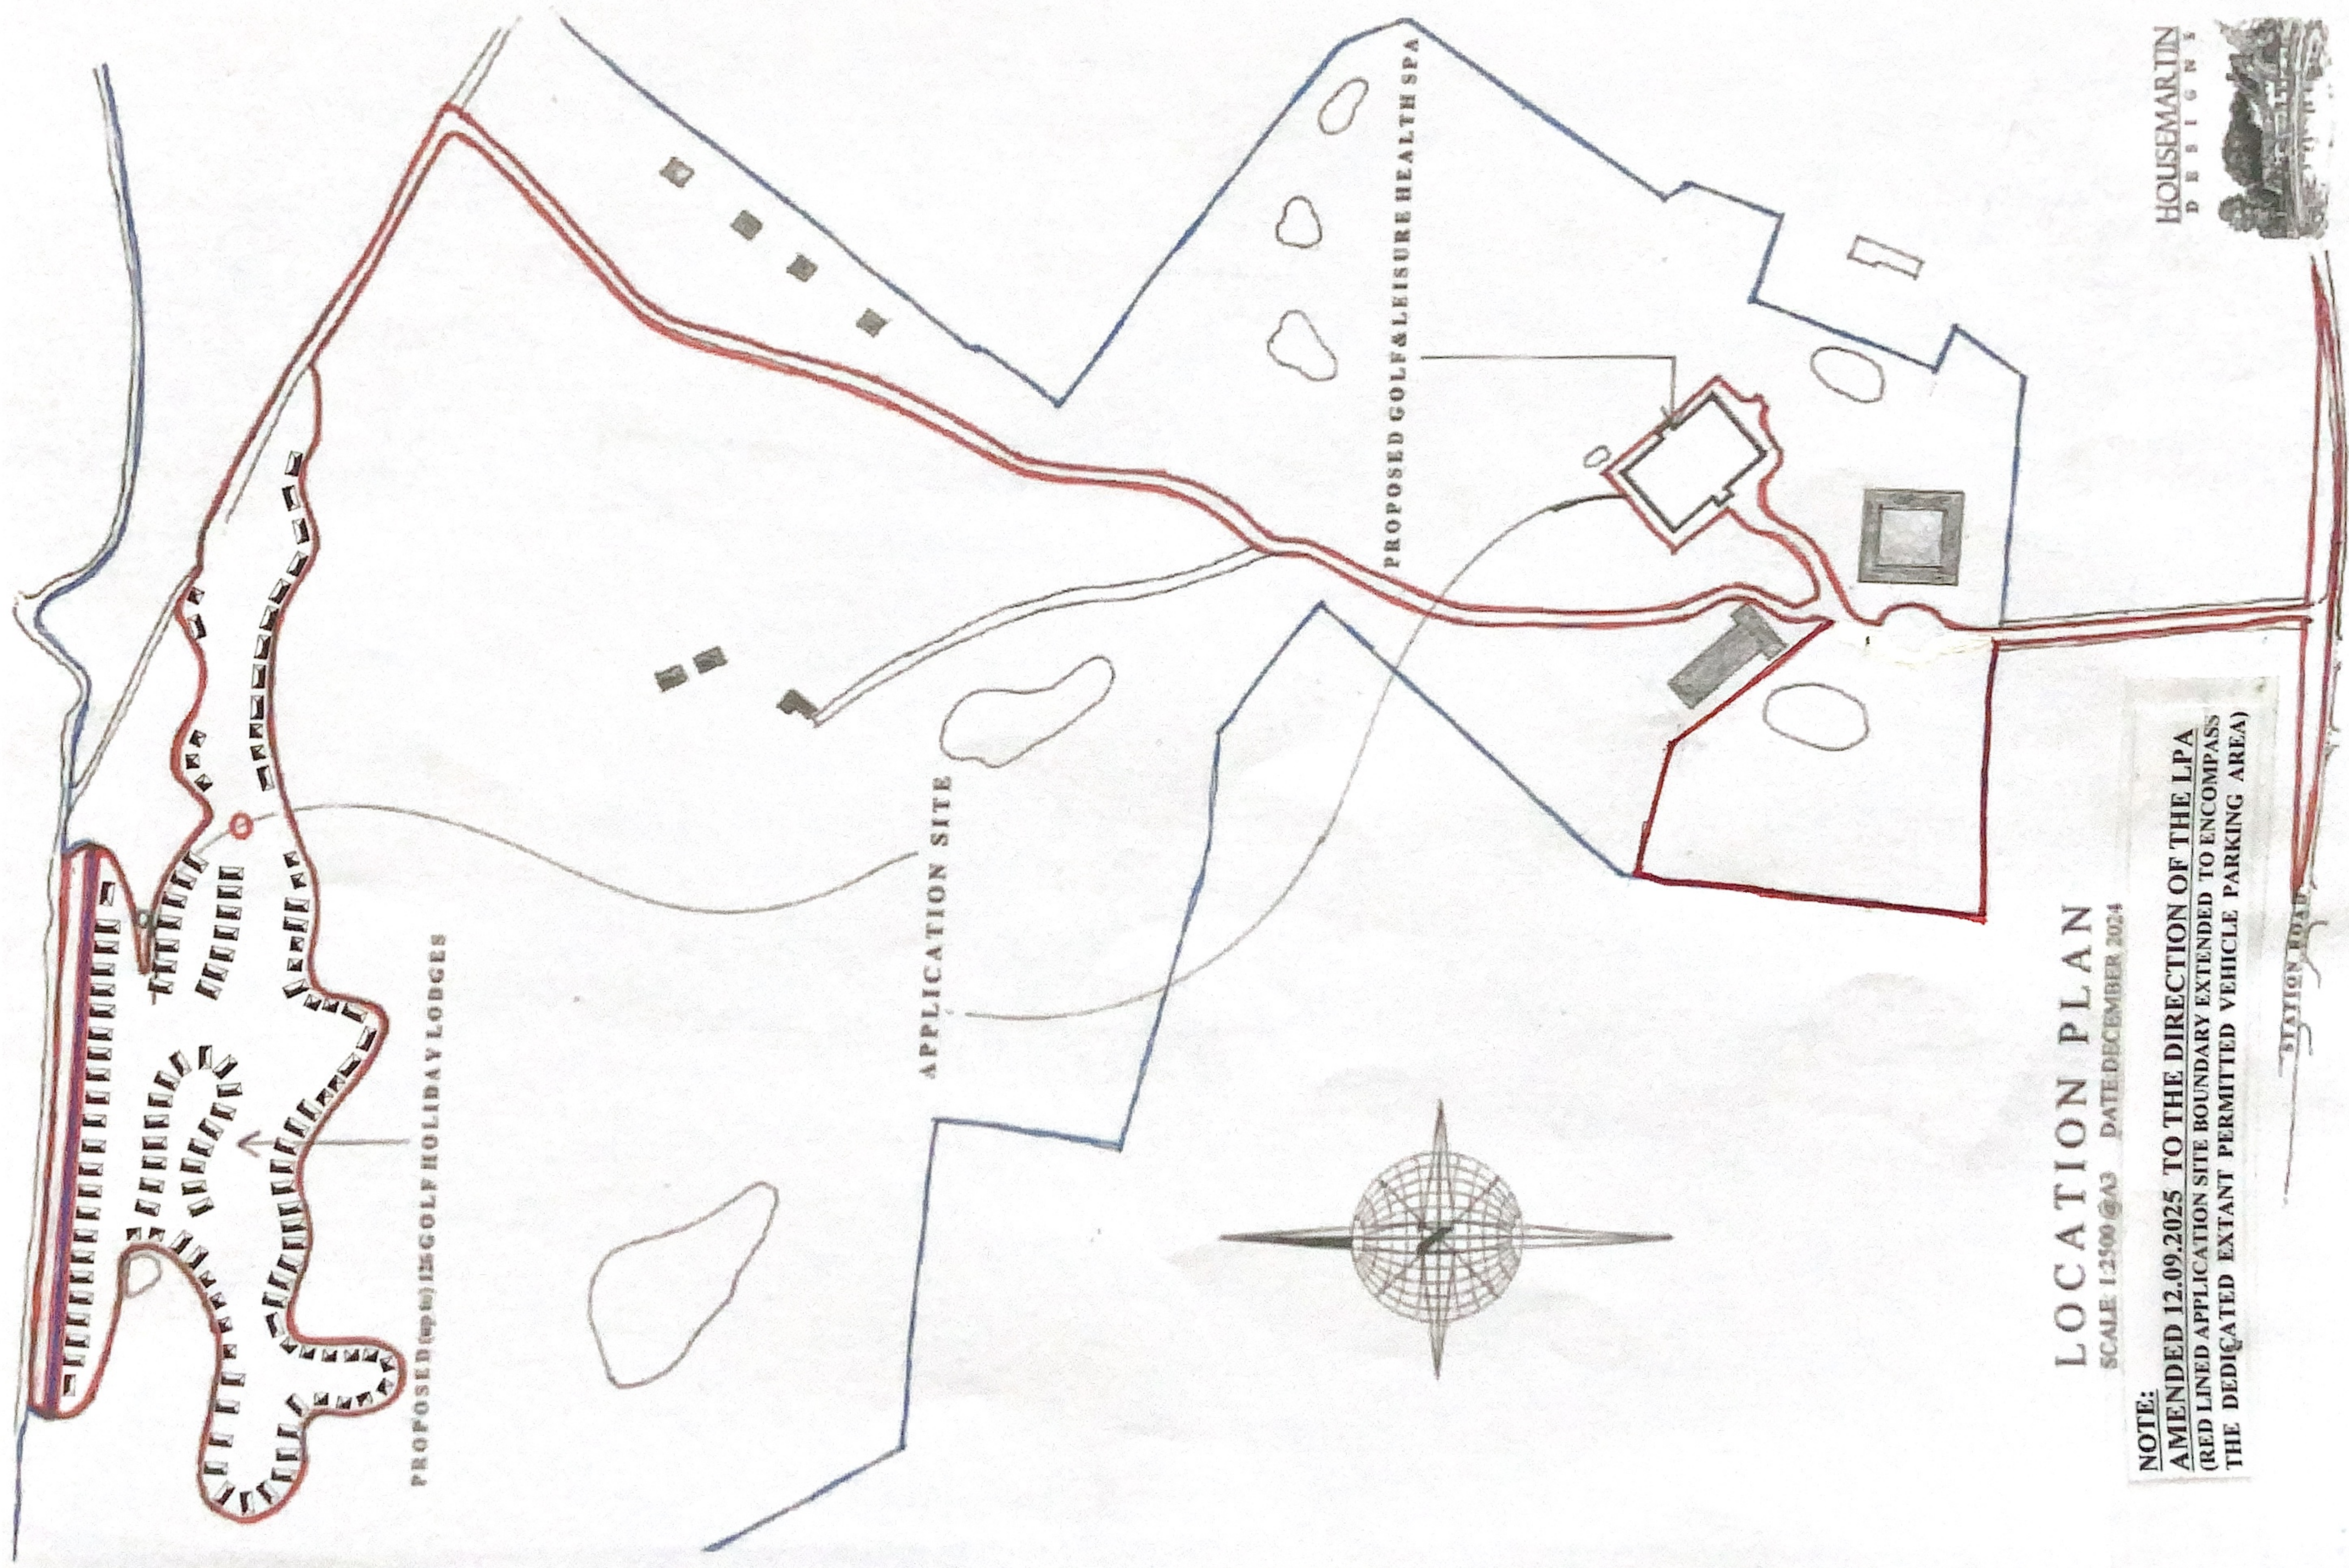

LOCATION PLAN

SCALE 1:2500 @A3 DATE DECEMBER 2024

NOTE:
AMENDED 12.09.2025 TO THE DIRECTION OF THE LPA
(RED LINED APPLICATION SITE BOUNDARY EXTENDED TO ENCOMPASS
THE DEDICATED EXTANT PERMITTED VEHICLE PARKING AREA)

HOUSEMARTIN
DESIGNS

