
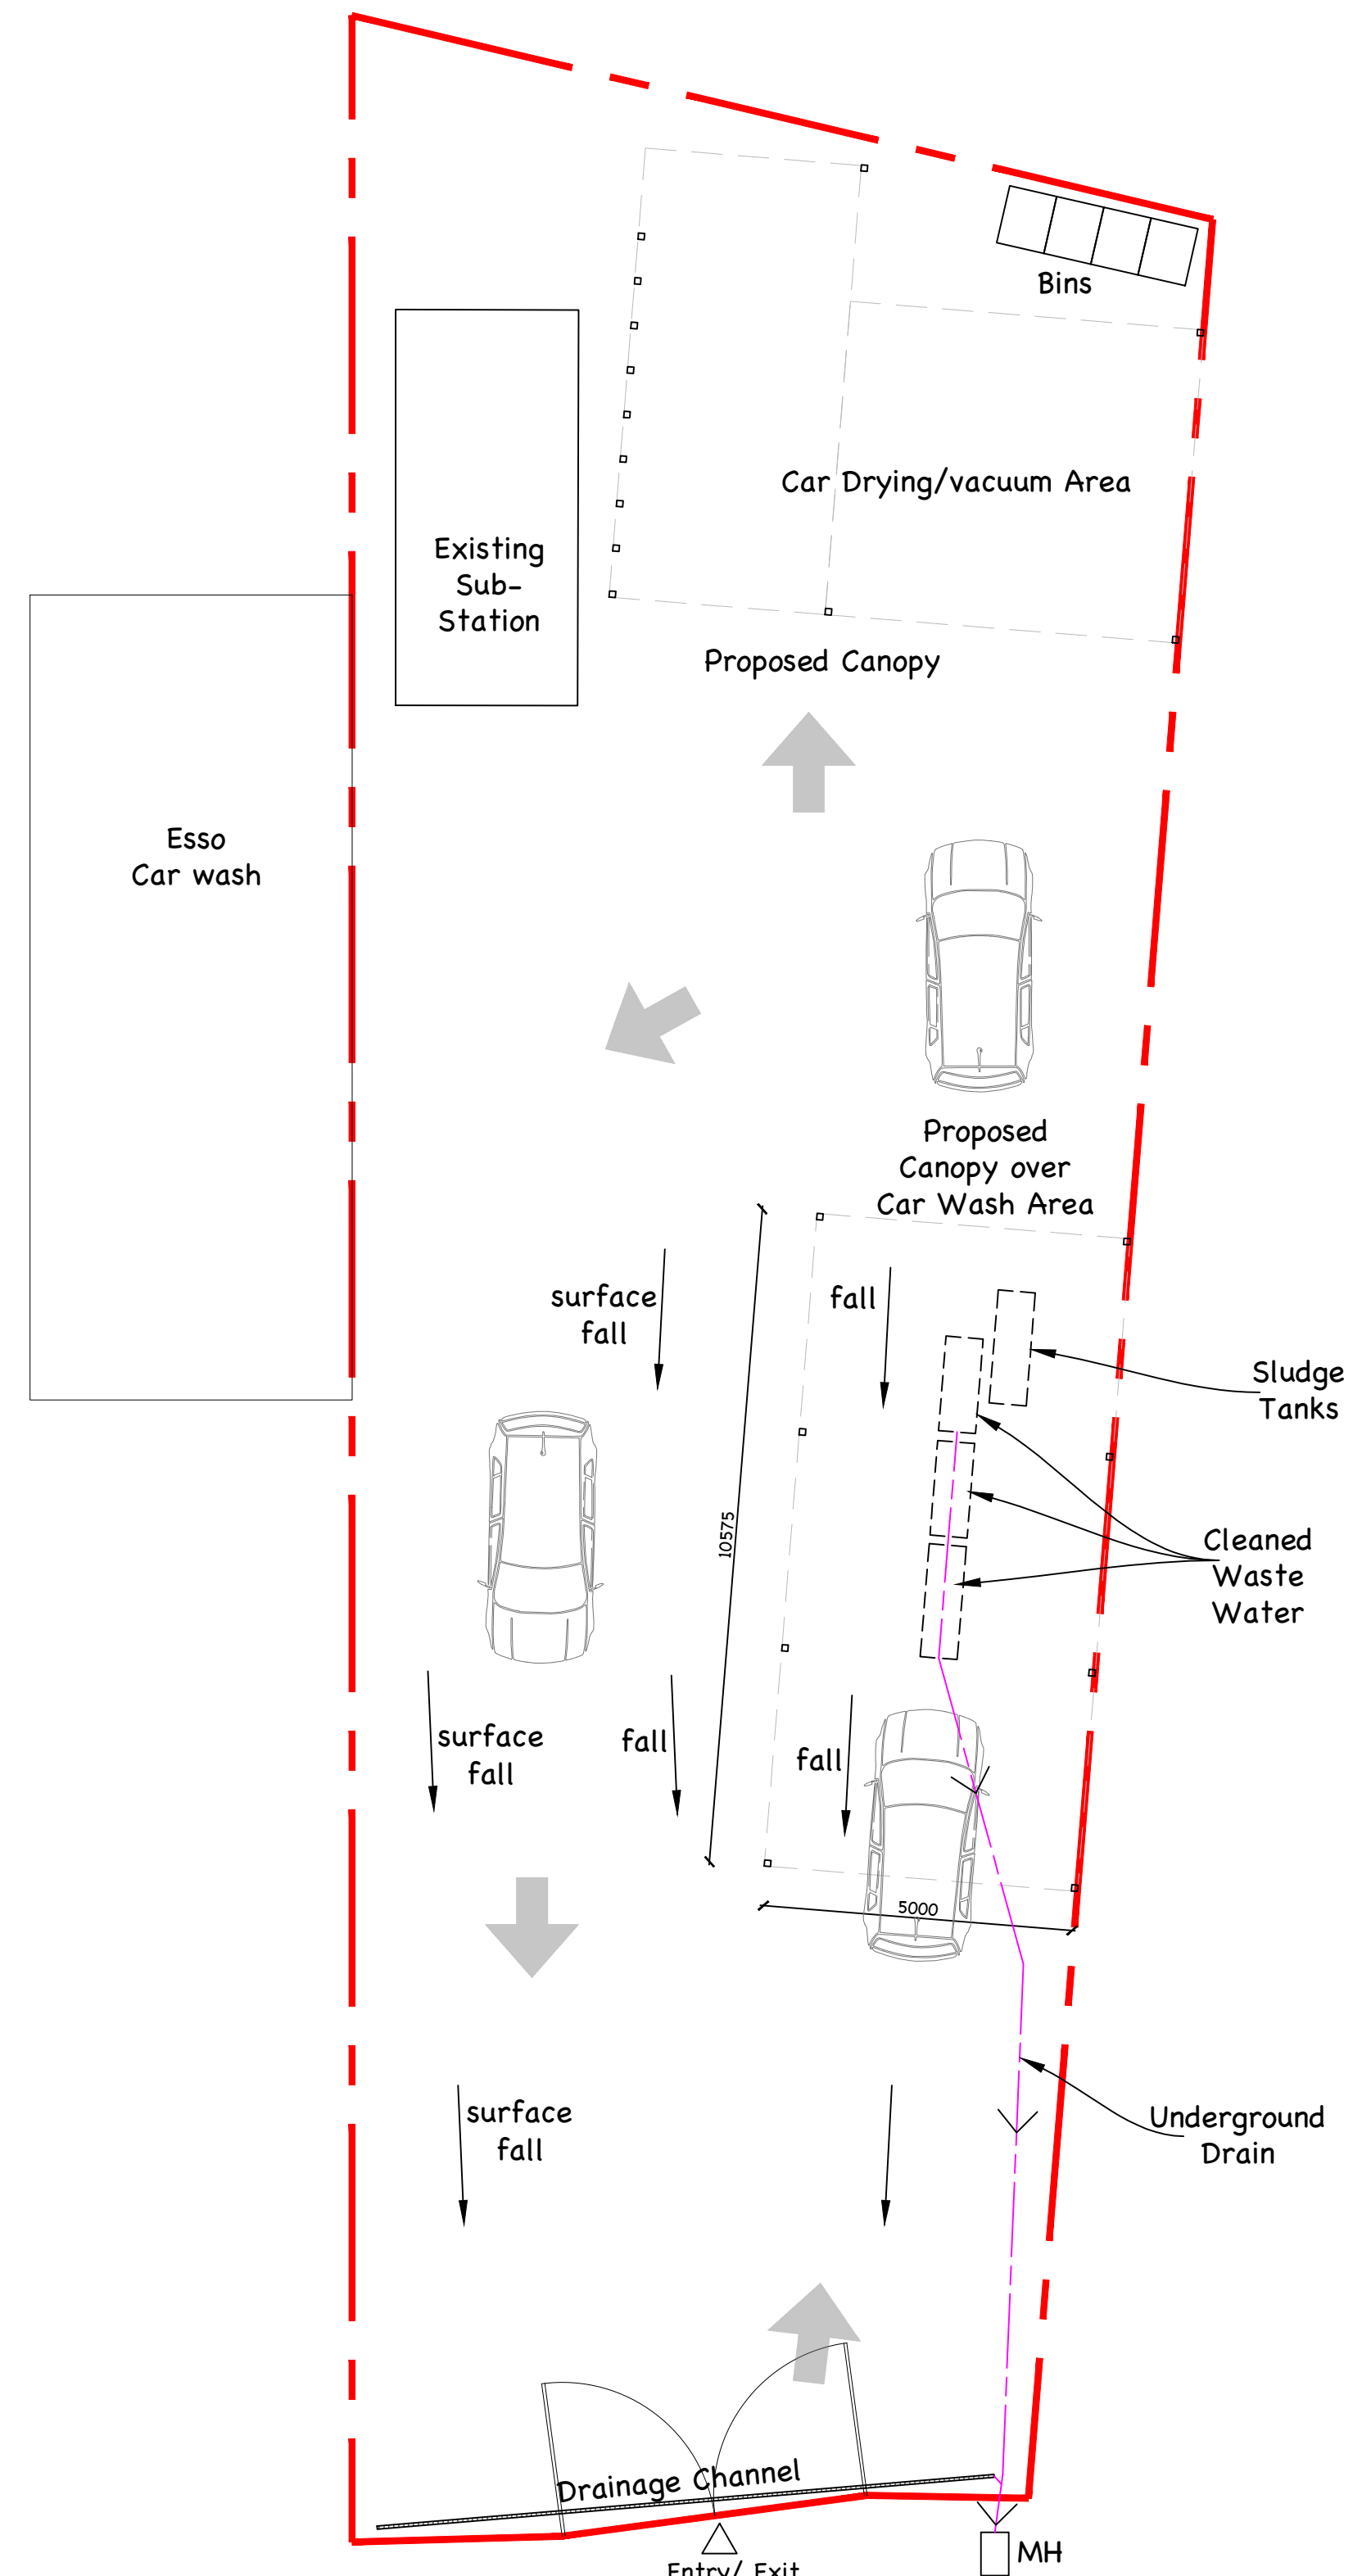


1:5 = 25cm	1:200 = 10m
1:10 = 50cm	1:250 = 12.5m
1:20 = 100cm	1:500 = 25m
1:50 = 2.5m	1:1250 = 62.5m
1:100 = 5m	1:2500 = 125m

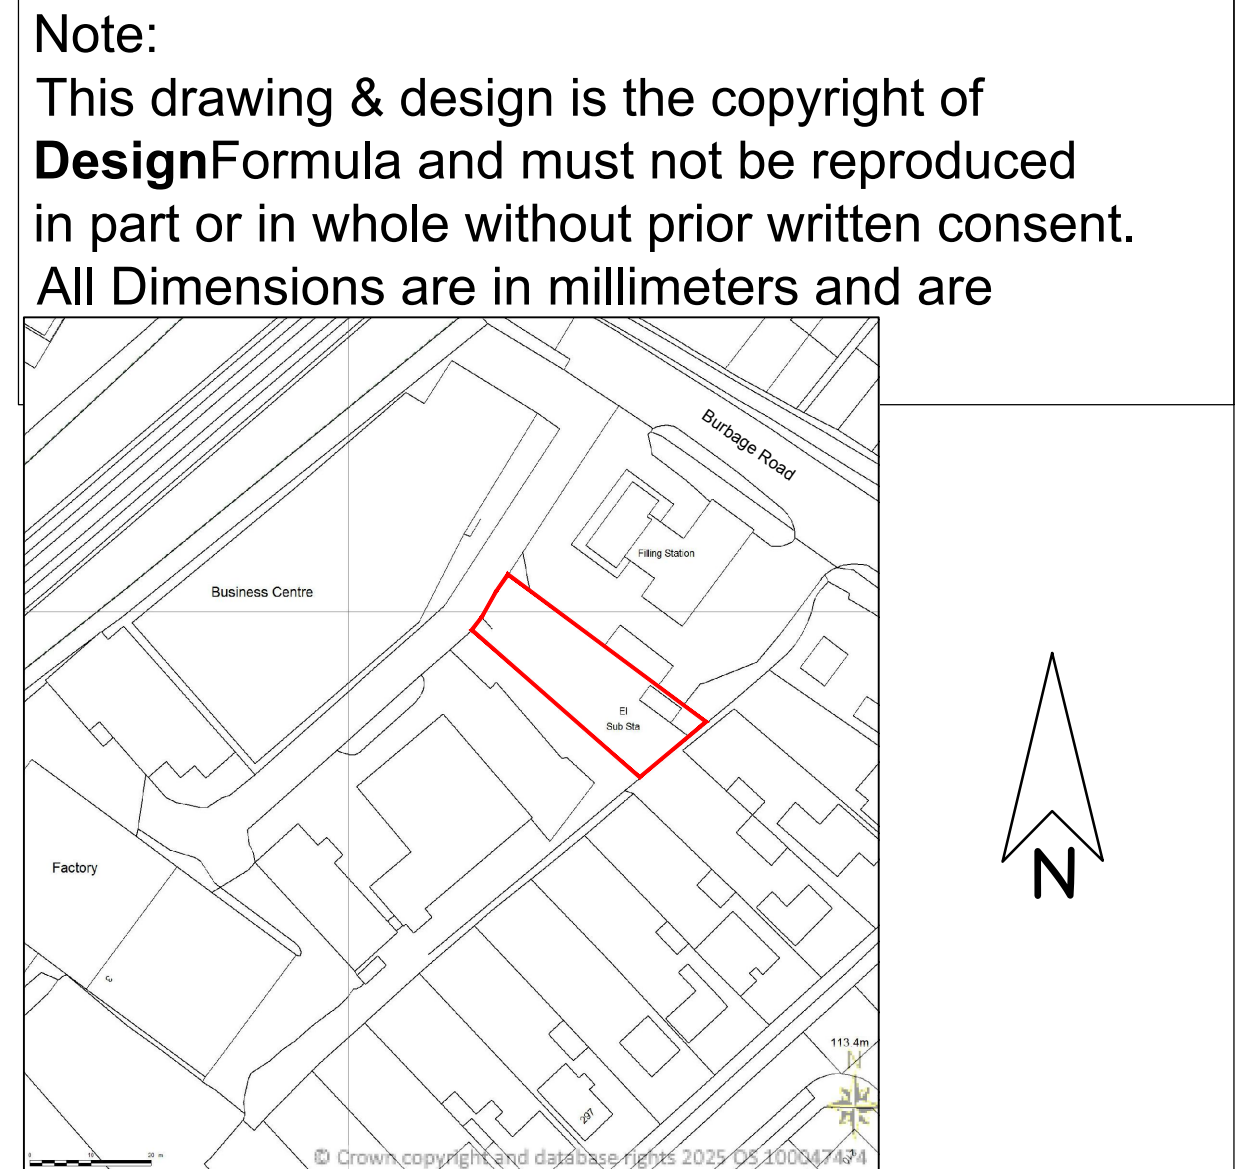

As-Built/Proposed Site Plan

Rev A - Redline highlighted in Red

Note: This drawing & design is the copyright of DesignFormula and must not be reproduced in part or in whole without prior written consent. All Dimensions are in millimeters and are		
Site Location Plan scale 1:1250		
Existing Site Plan / Block Plan scale 1:500		
Note: -All Dimensions are in millimeters and are approximate. -New Extension in Render & Timber Cladding. -New windows to match existing. -New RWP drains to be connected to existing.		
DESIGNFORMULA 07814262723		
Project Title: Automatic Engineers Hinckley Limited Burbage Road, Hinckley		
Details: Retrospective Application Approval of Erected Canopies, Car Wash Use And Associated external works including concrete hard surface		
Drawing: Existing & Proposed Plans-Elevations PLANNING		
Scale: 1:100 & as noted @ A1	Date: Feb 2025	Drg No: 5107-200Rev A