



25/00487/FUL. RESTORING GARAGE BACK TO DOMESTIC DWELLING.

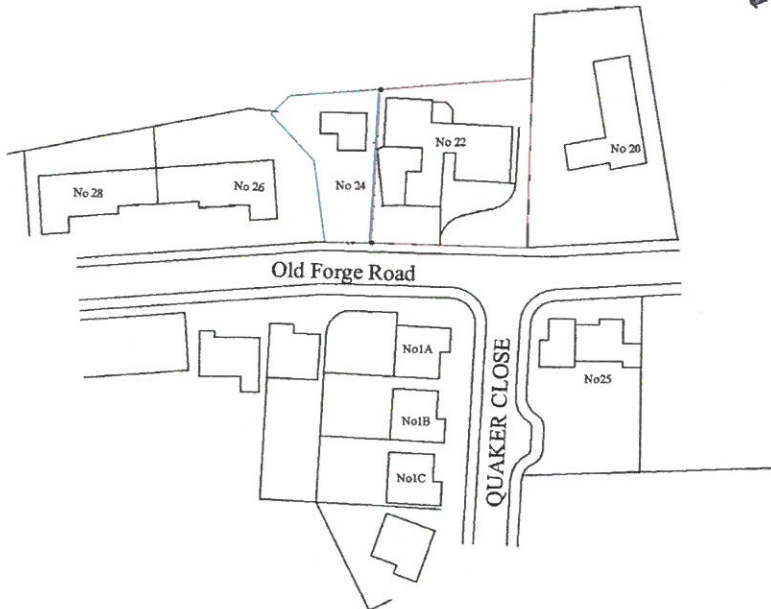

Location Plan 1:1250

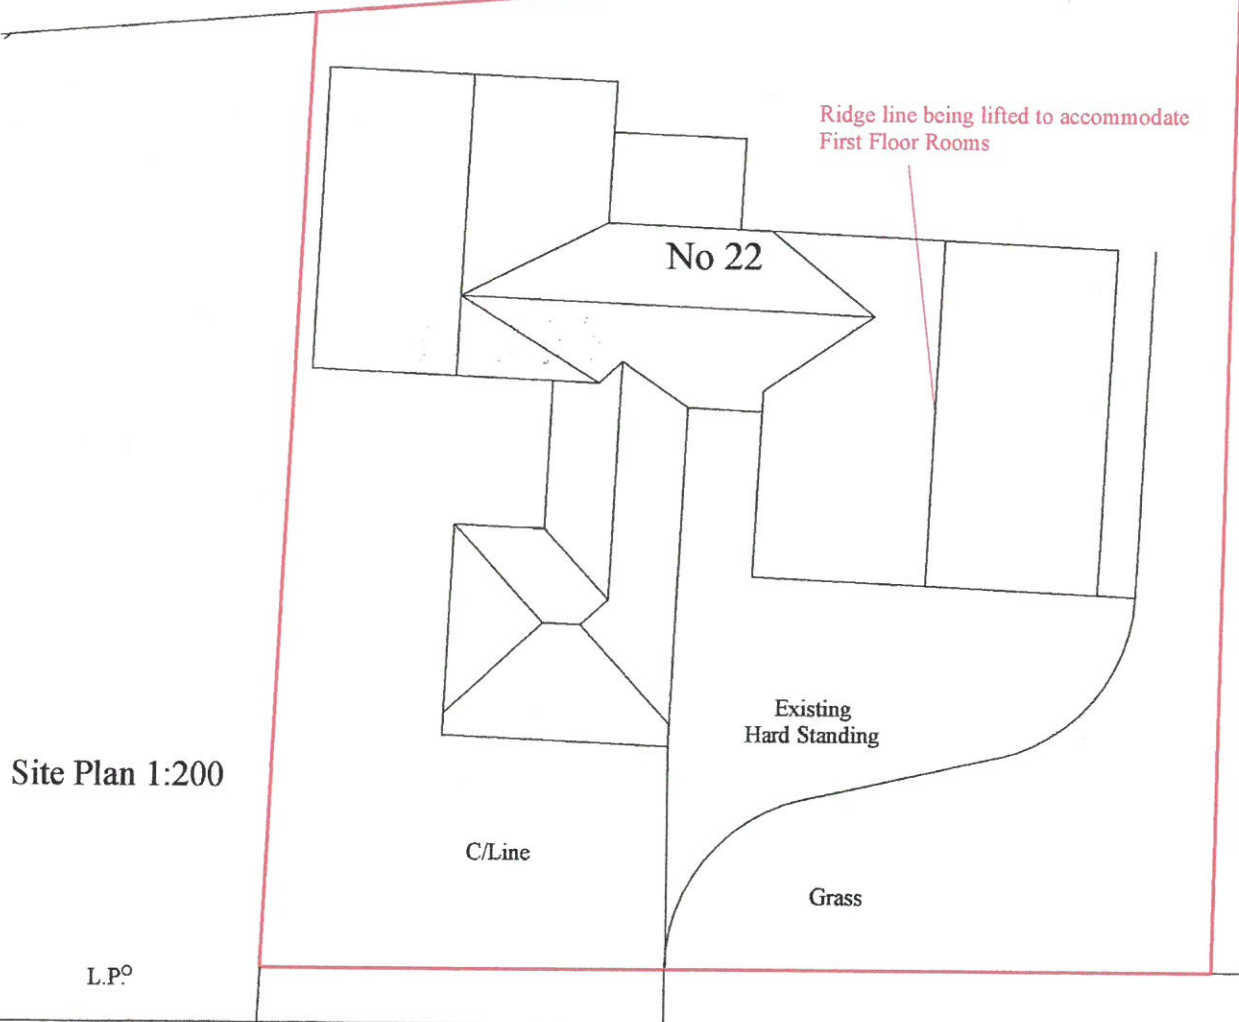

Site Plan 1:200

L.P.

~~New Perspective Drawing Services 07286 669394~~

Client
~~John David White~~

Site Address
22 Old Forge Road
Fenny Drayton

Drawing Title
SITE PLAN AND LOCATION PLAN
Relating to Proposed Attic Room Extension

Scale
1:200 & 1:1250 @ A4 Sheet size

Date
Sept 2014

Drawn By
JHW

Drawing No

1409-15-01

Revision

AS OUTLINED IN
R.E.D.



A hand-drawn map of a residential area. The map shows several lots and buildings. At the top, there are lots labeled No 23, No 26, No 24, No 22, and No 20. A road labeled "Old Forge Road" runs horizontally across the middle. Below this road, there are lots labeled No 1A, No 1B, and No 1C, and a lot labeled No 25. A street labeled "QUAKER CLOSE" runs vertically on the right side. A red square is marked on lot No 24, and a red "E" is marked on the road between No 24 and No 22.

Site Plan 1:200

No 22

Existing
Hard Standing

2

3 4

L.P.°

L.P.^o

Drawing Title
SITE PLAN AND LOCATION PLAN - PARKING PLAN

Scale
1:200 & 1:1250 @A4 Sheet size


Date 10-8-21 Drawn By pmw

Revision

25/00487/FUL

REVERSAL BACK TO DOMESTIC

DWELLING

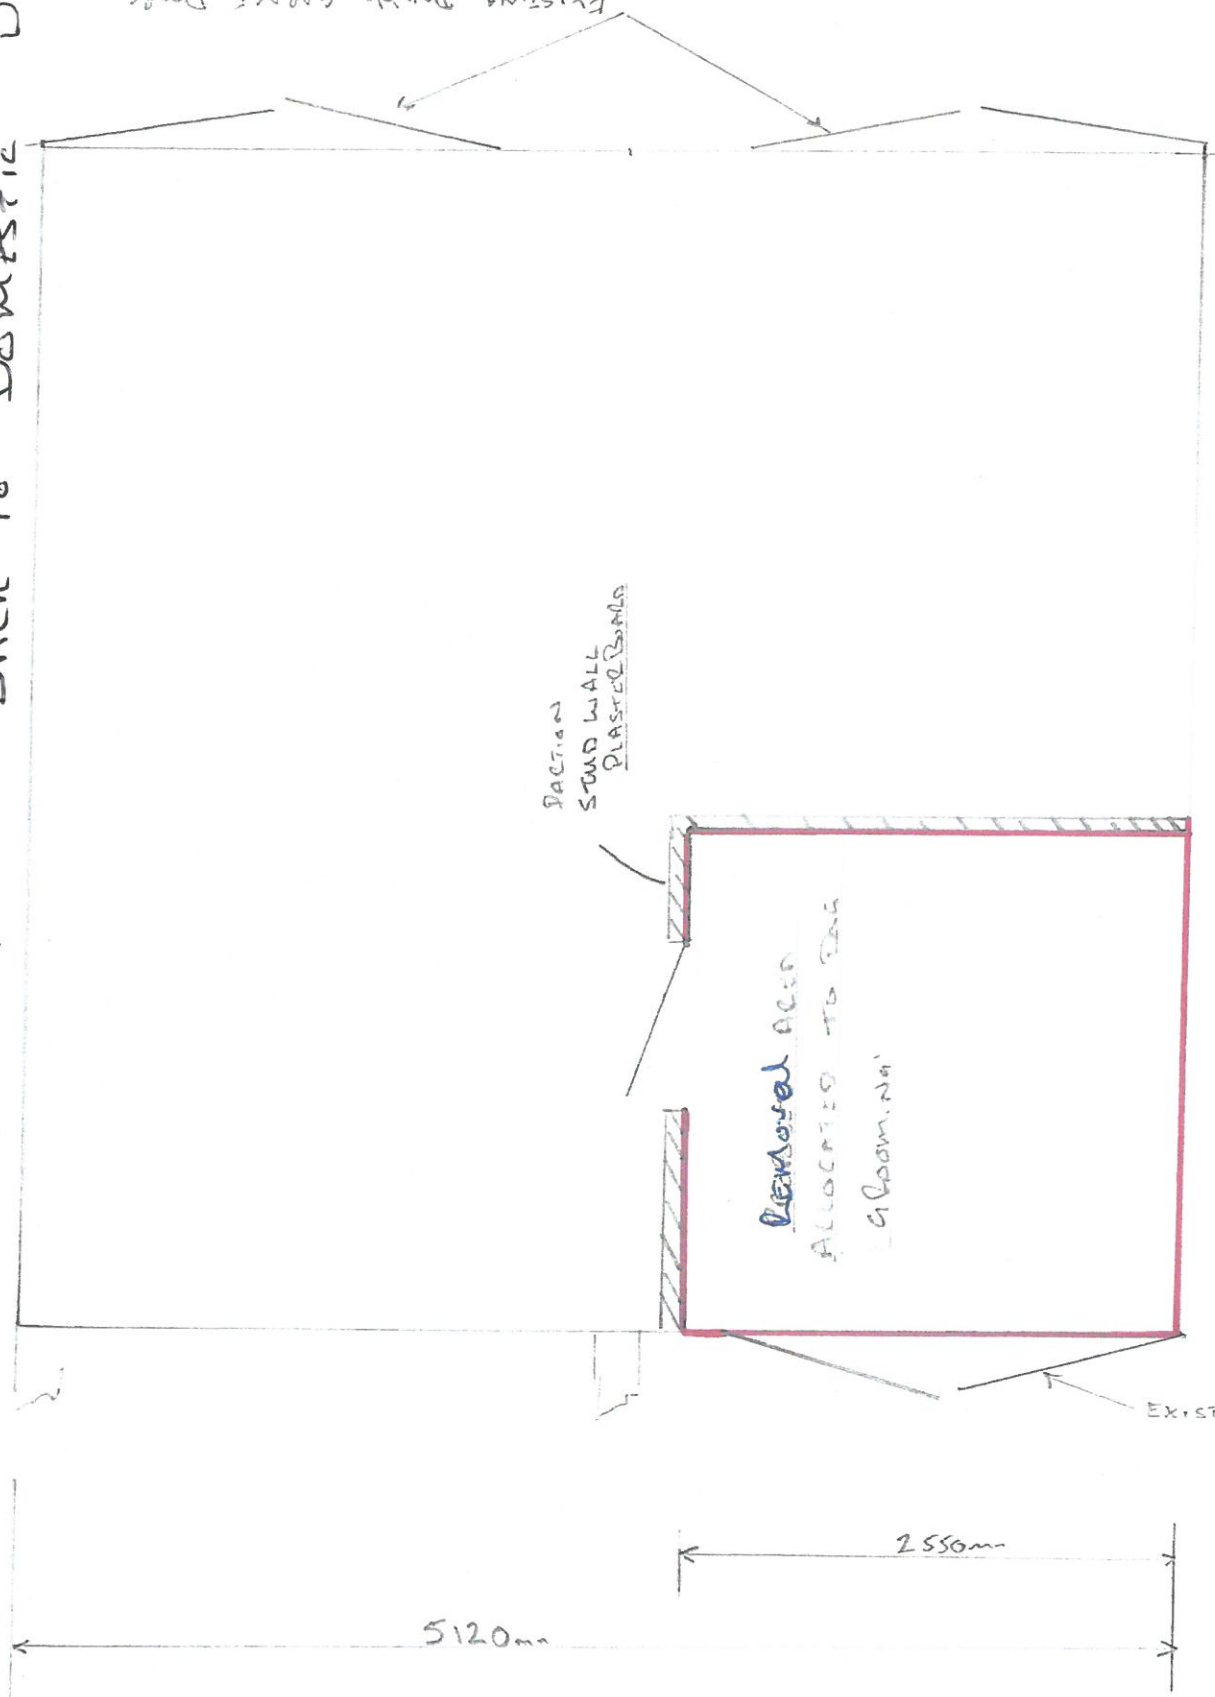

EXISTING DOUBLE GARAGE DOORS

PARTIAL STUD WALL
PLASTERED

REMOVED AREA
ALLOCATED TO THE
GARAGE

EXISTING DOUBLE
GARAGE DOORS

2550
2650mm
5120mm

APPROX 26.6m

~~PROPOSED DOOR
SPACE 1.5m
24m x
GARAGE SPACE~~

~~PROPOSED DOOR
22m x 2.5m~~