


Based upon the Ordnance Surveys map with the permission of the Controller of His Majesty's Stationery Office, Crown Copyright Reserved.  
National Grid Electricity Distribution, Avonbank, Feeder Road, Bristol, BS2 0TB. License No. 100022432.  
CARE SHOULD BE EXERCISED TO ENSURE THE PRECISE POSITION OF THE NGED APPARATUS IF WORK IS TO BE EXECUTED IN ITS VICINITY. If in doubt, contact your local NGED office.

Copyright: This copy has been made by or with the authority of National Grid Electricity Distribution pursuant to section 47 of the Copyright Designs and Patent Act 1988 unless that Act provides a relevant exception to copyright this must not be copied without the prior permission of the copyright owner.


Information is given as a guide only  
and its accuracy cannot be guaranteed.

PLEASE NOTE: This plan ONLY shows assets owned by National Grid Electricity Distribution (NGED).  
Electricity assets owned by National Grid Electricity Transmission (NGET) and IDNO's (Independent Network Operators)  
MAY be present in this area.

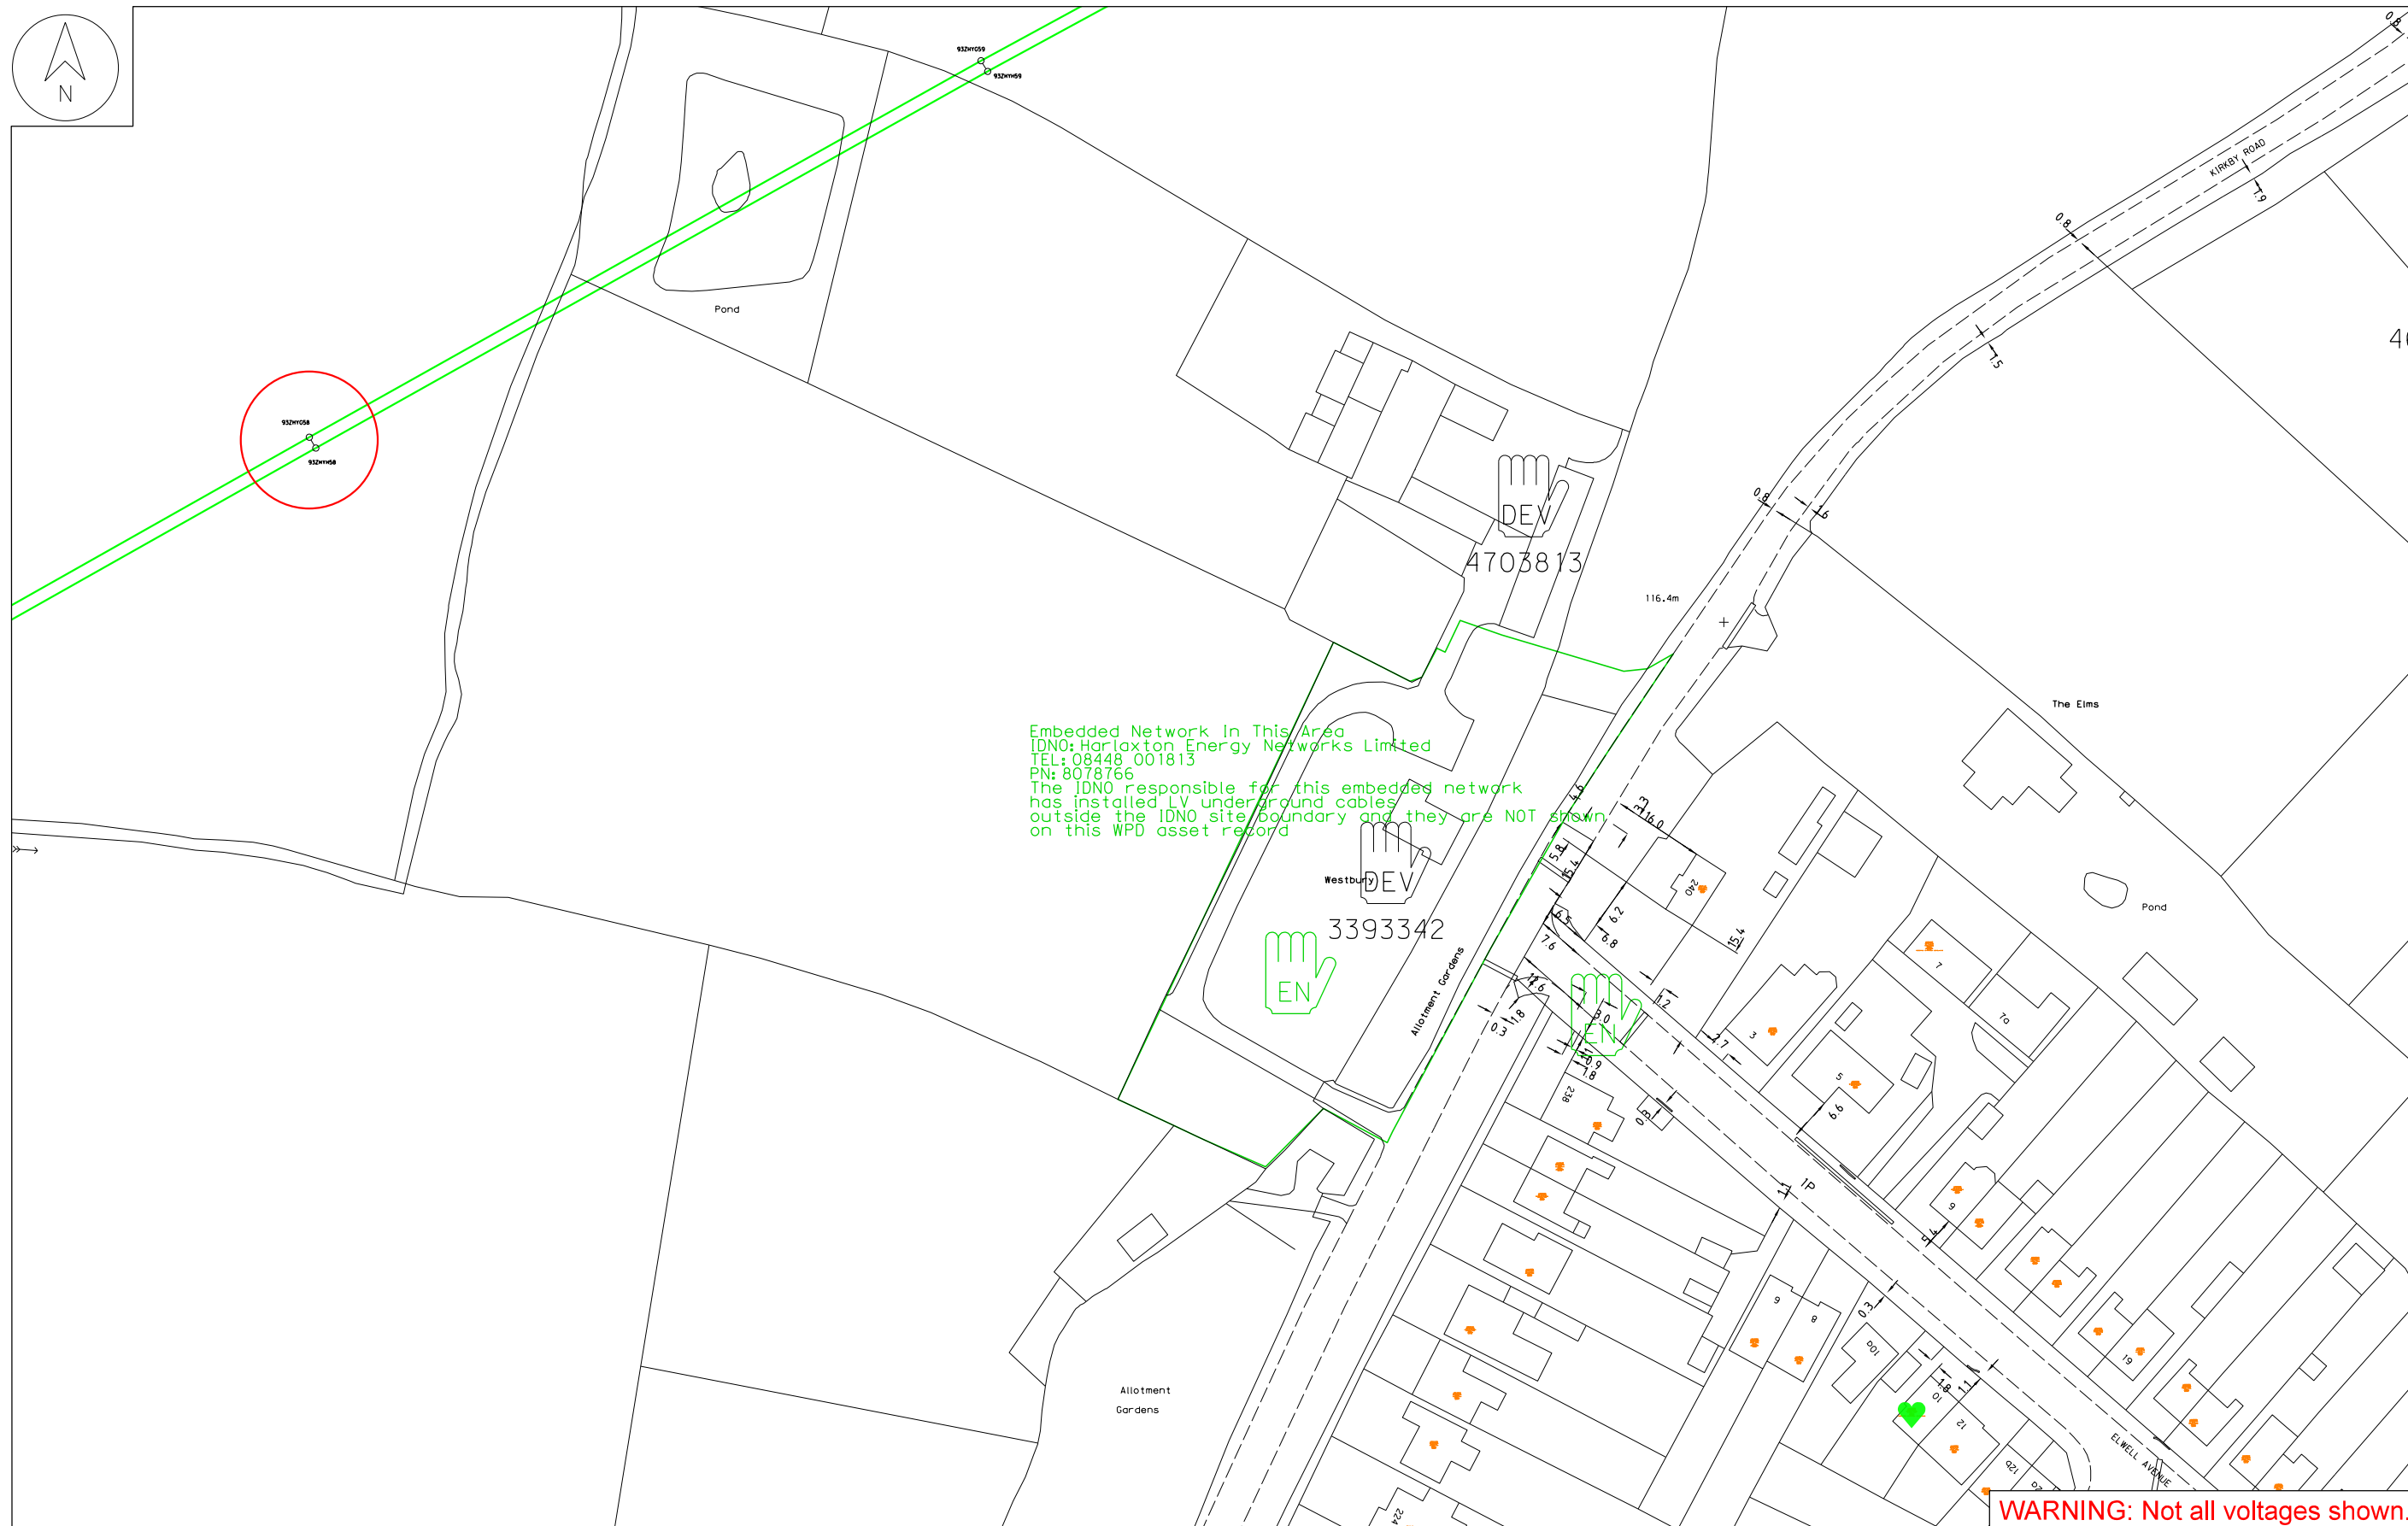

Embedded Network In This Area  
IDNO: Harlaxton Energy Networks Limited  
TEL: 08448 001813  
PN: 8078766  
The IDNO responsible for this embedded network  
has installed LV underground cables  
outside the IDNO site boundary and they are NOT shown  
on this WPD asset record

**WARNING: Not all voltages shown.**

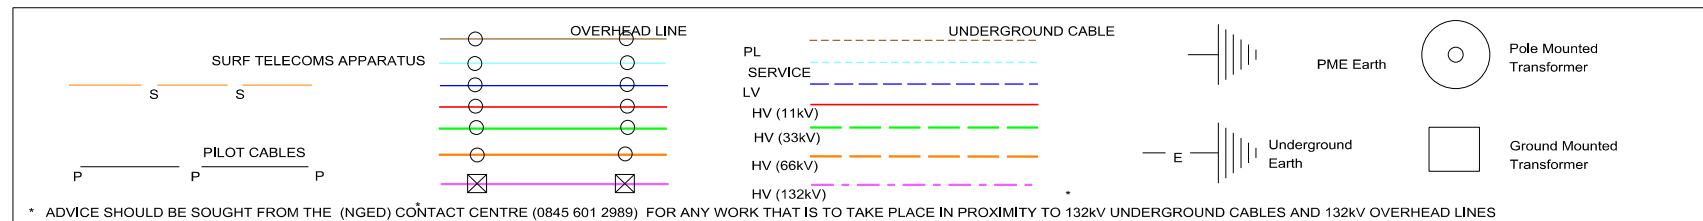

TITLE:  
DRAWN BY:  
DATE: 13/06/2023  
SCALE 1:1031  
PLOT CENTRE: 444652.538,298204.584

@ A3

