
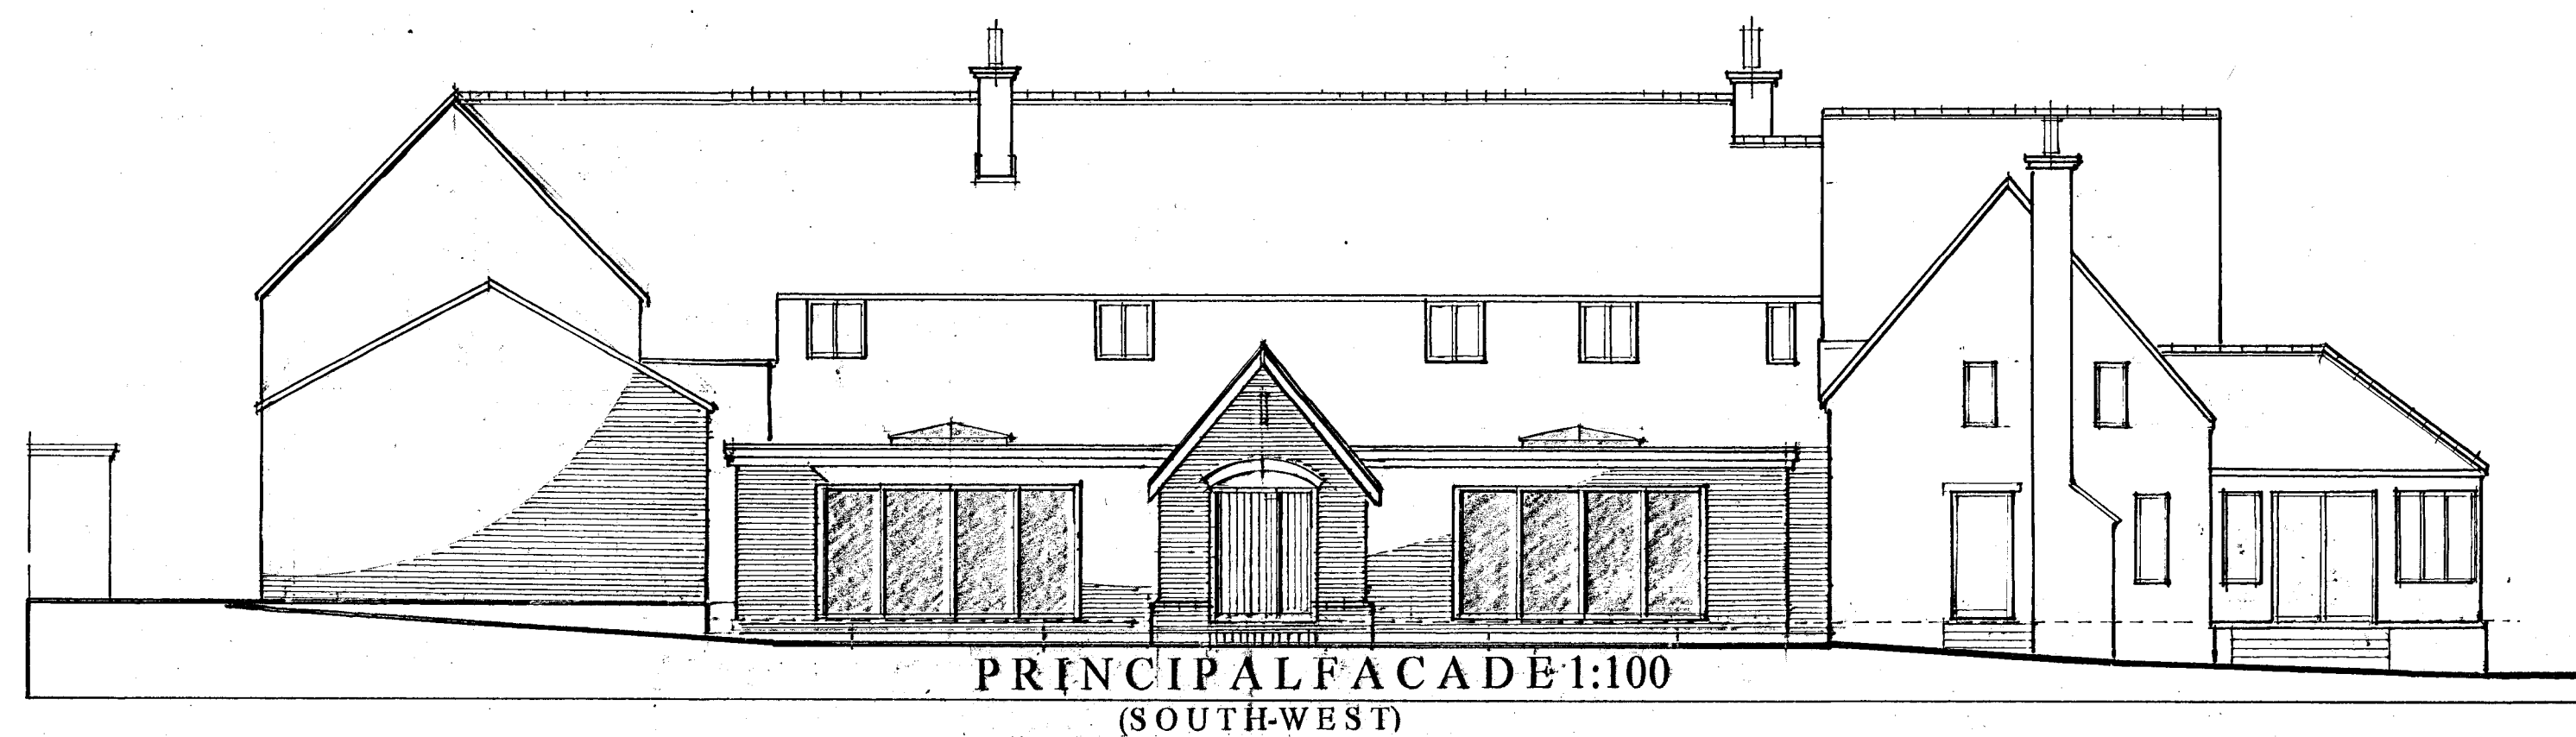
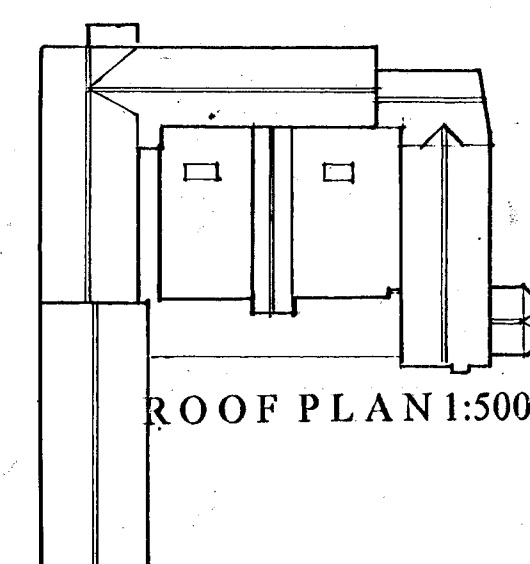
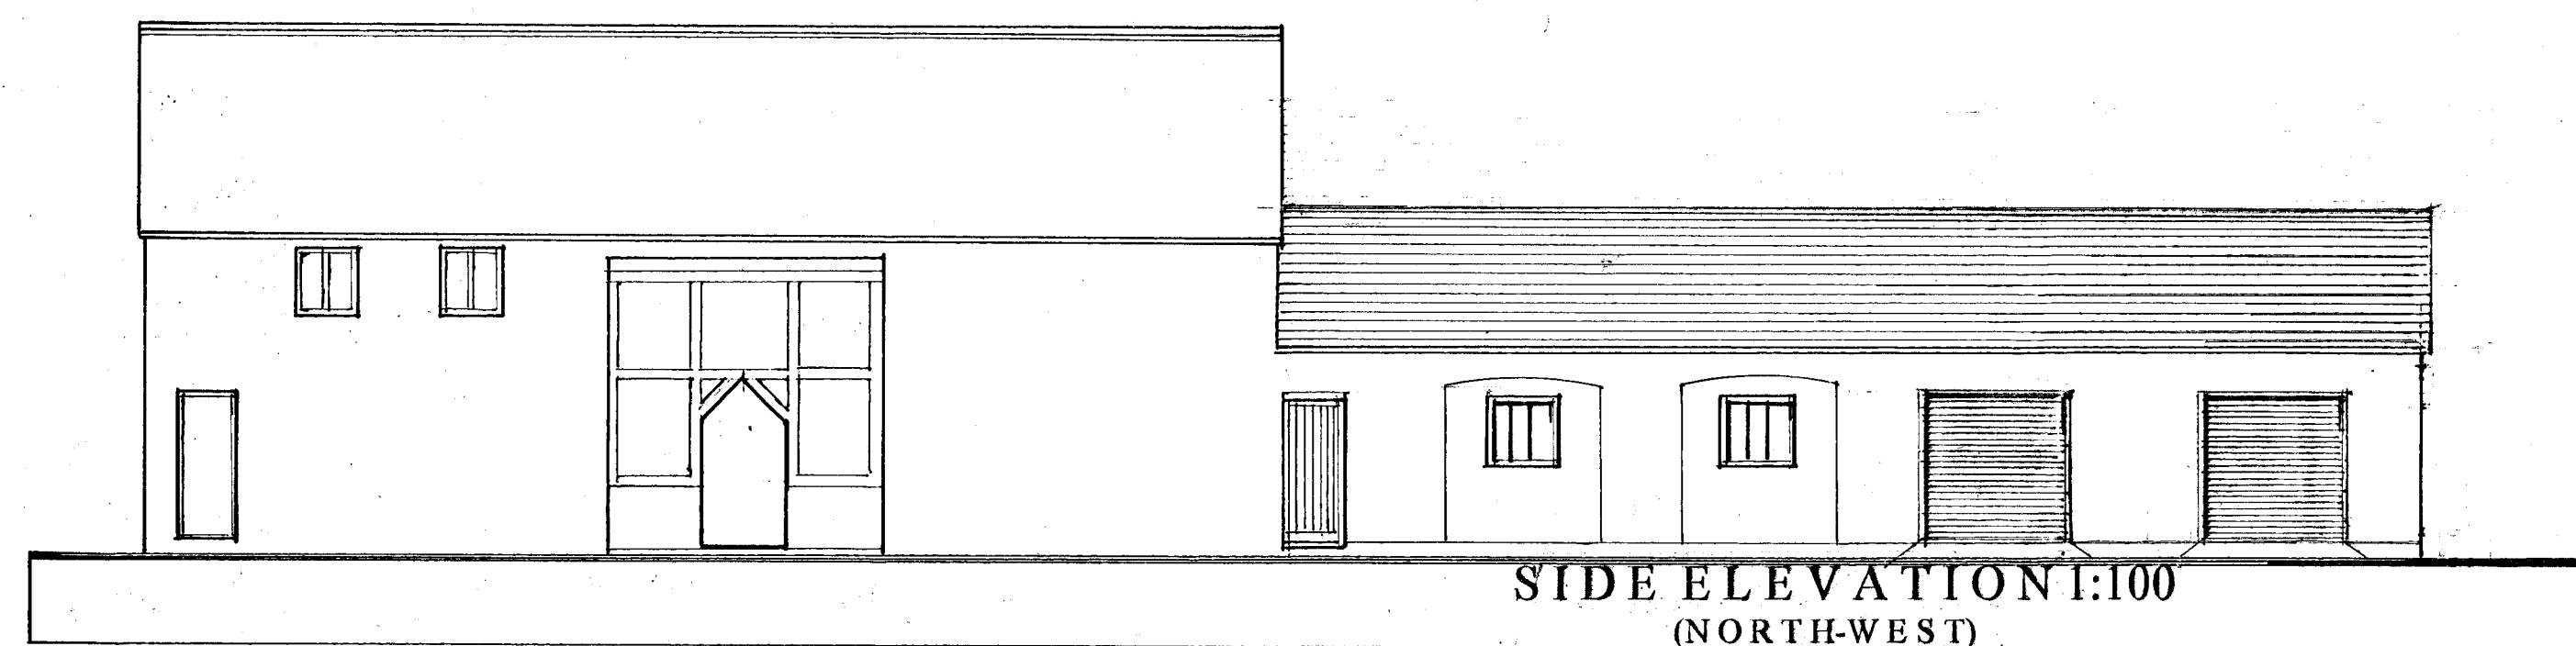
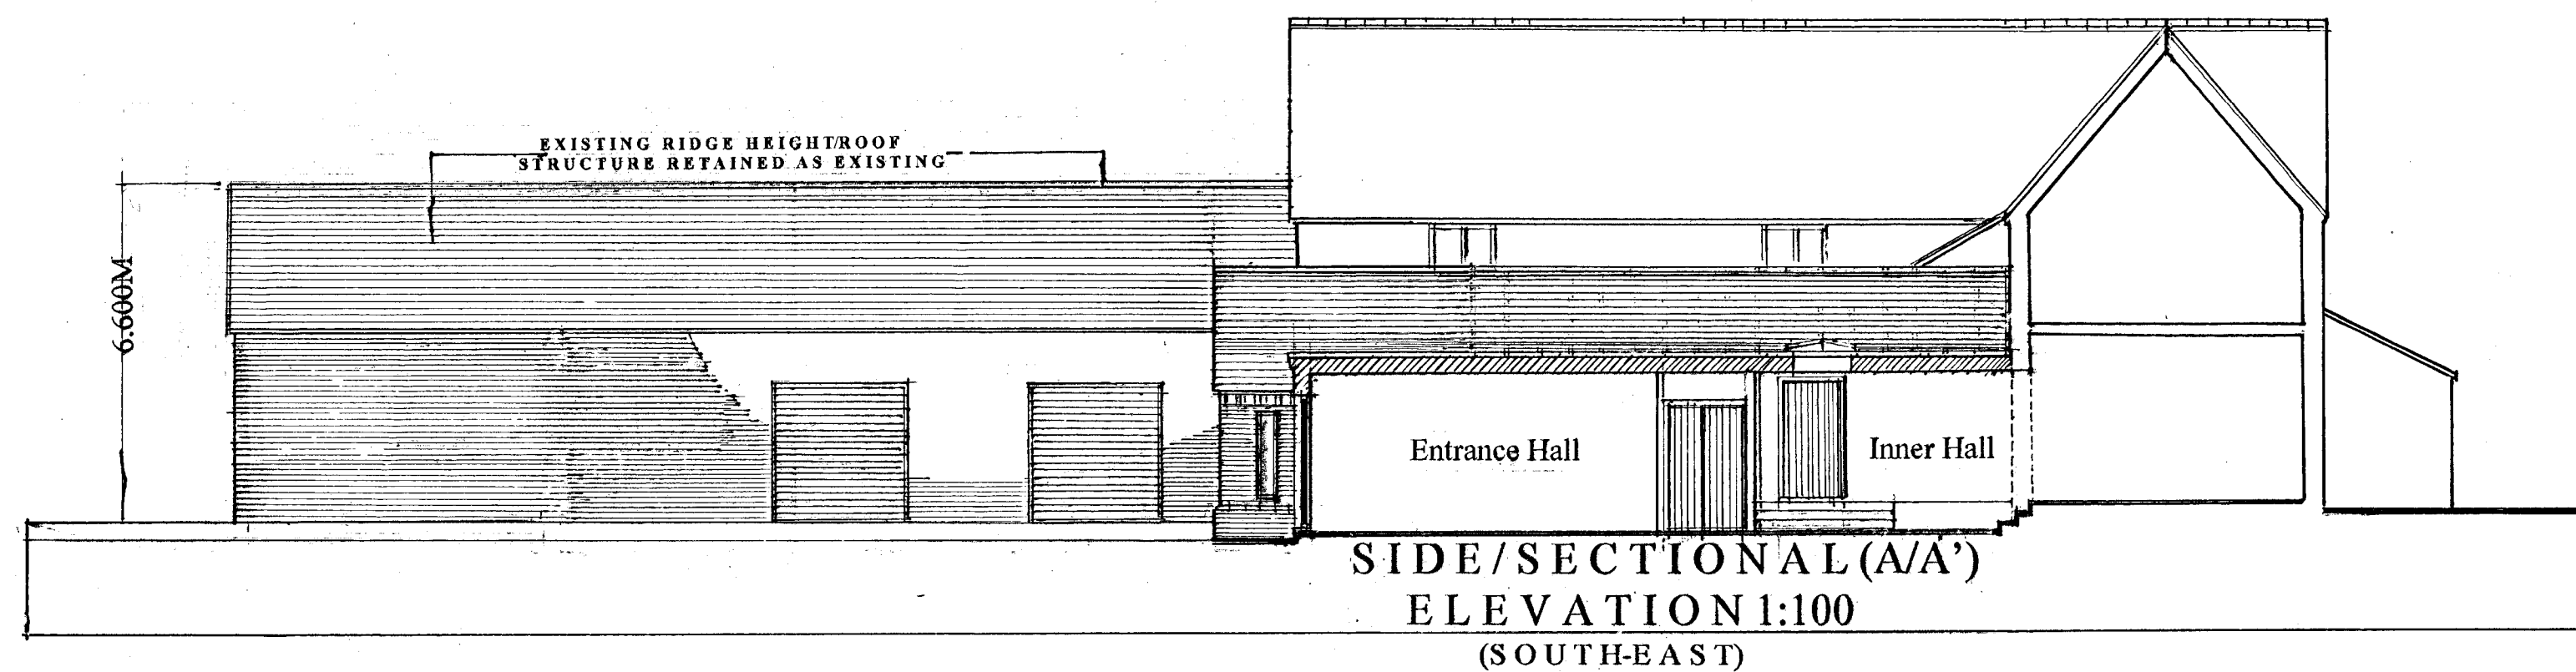
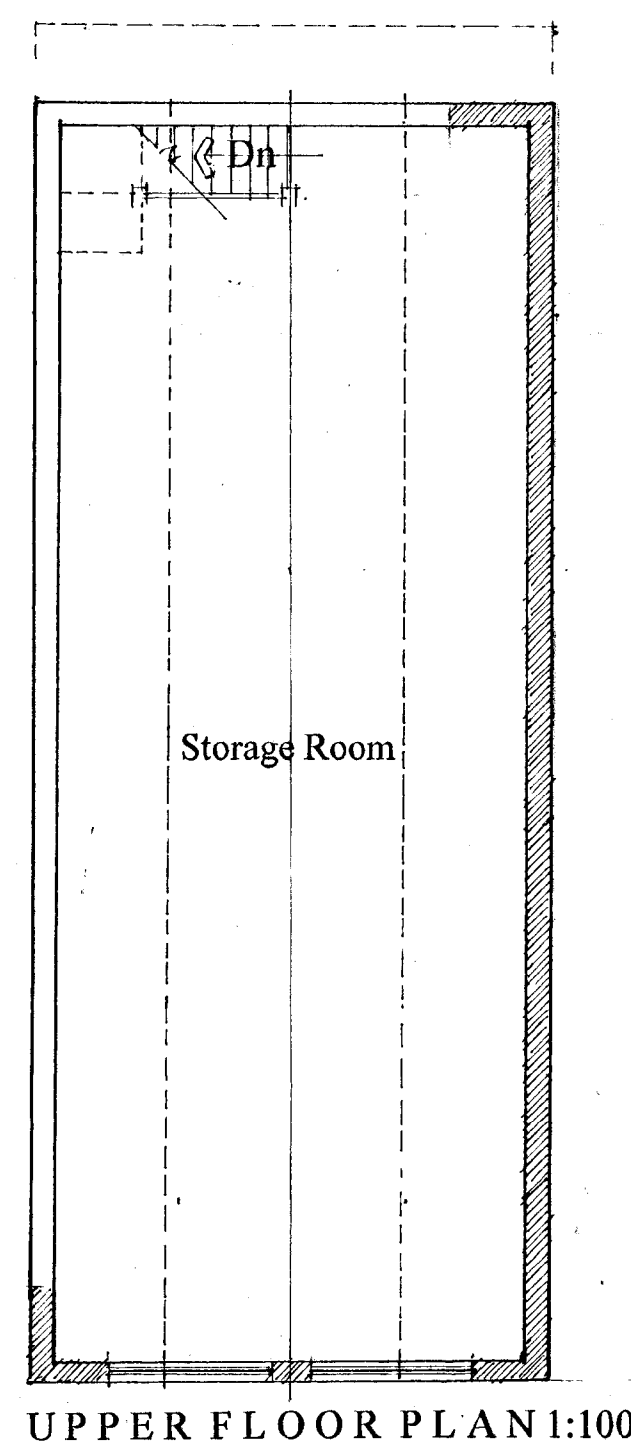


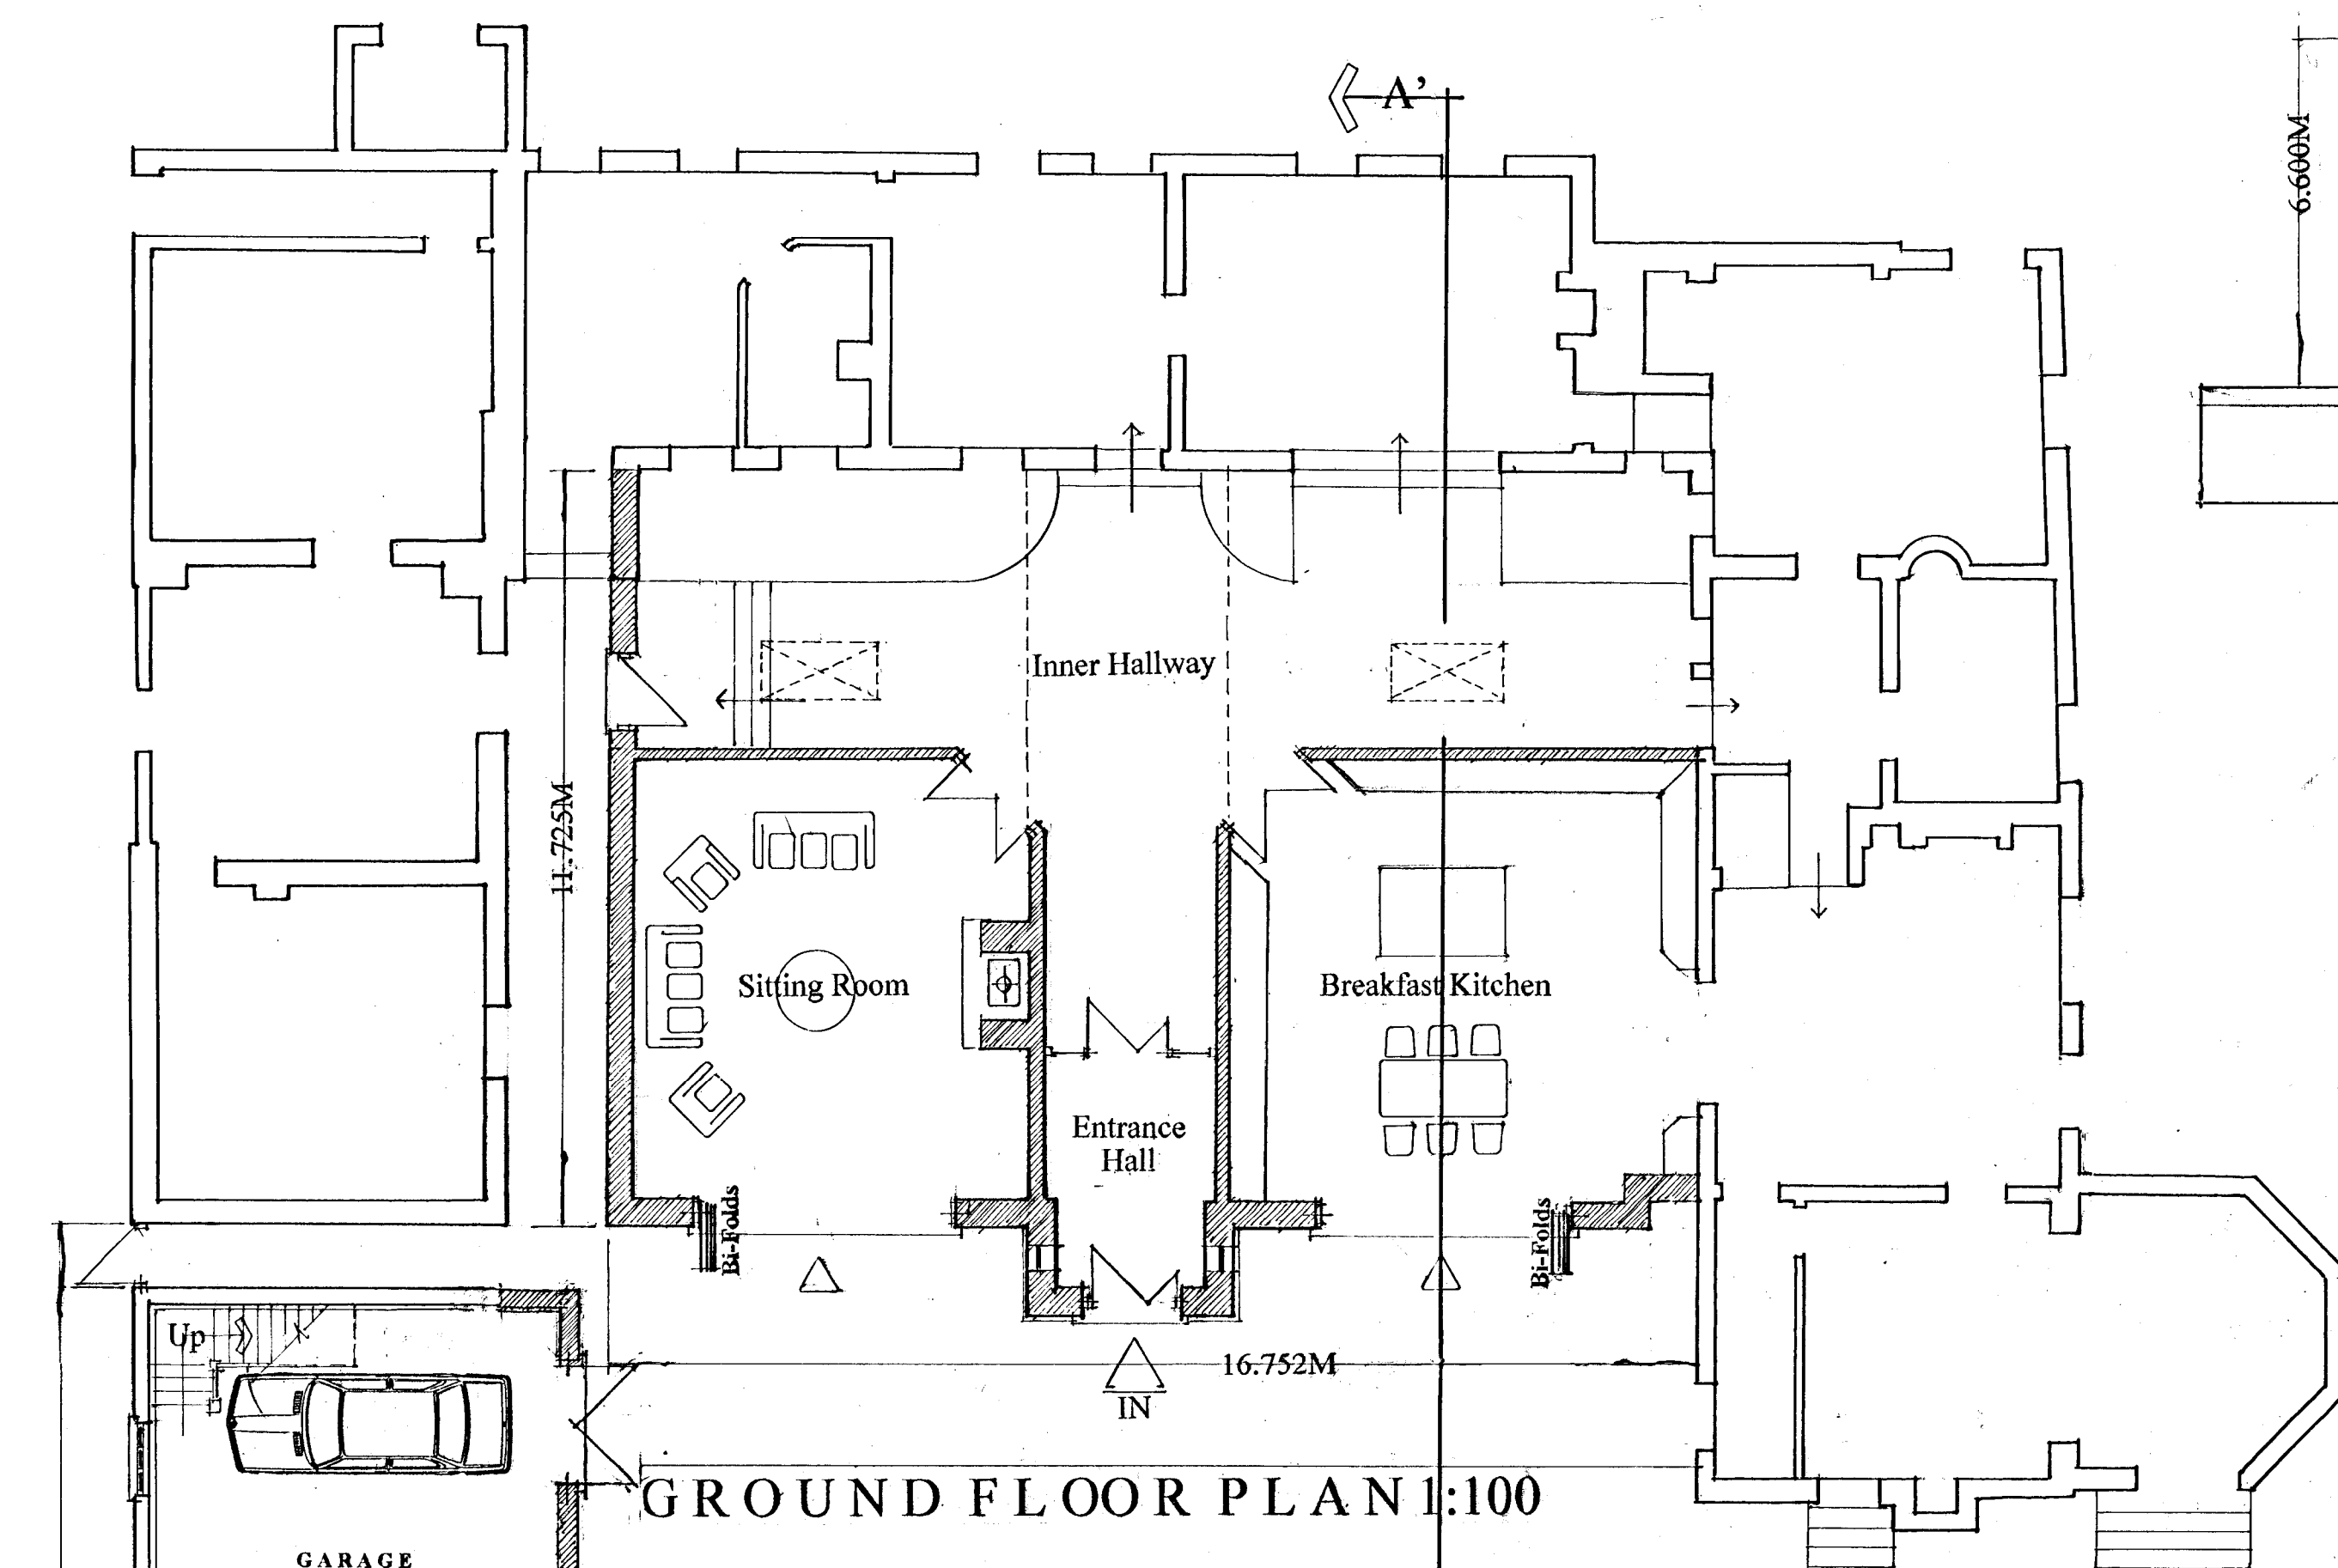

CLIENT:
Singular Homes Ltd.

PROJECT:
Retention of As-Built Extension &
Alteration Works (Unit No:1)
Hall Farm,
Orton-on-the-Hill,
Leicestershire.

DRAWING TITLE:
Existing Floor Plan(s) & Elevations.
Roof Plan.

SCALE: 1:100/1:500 @A1
DATE: August 2025.
DRWG.No: HMD/0592/02.
© Copyright 2025

HOUSEMARTIN
DESIGNS



© Copyright HMD.
The Copyright, Designs & Patents Act 1988 - as amended