



A3	Revision note		Date	Signature	Checked
	RevNo	Revision note	15/09/2024	RM	AN
A		FIRST FLOOR JOIST DIRECTION AS PER SITE INTRUSIVE OBSERVATION			


REAR GARDEN

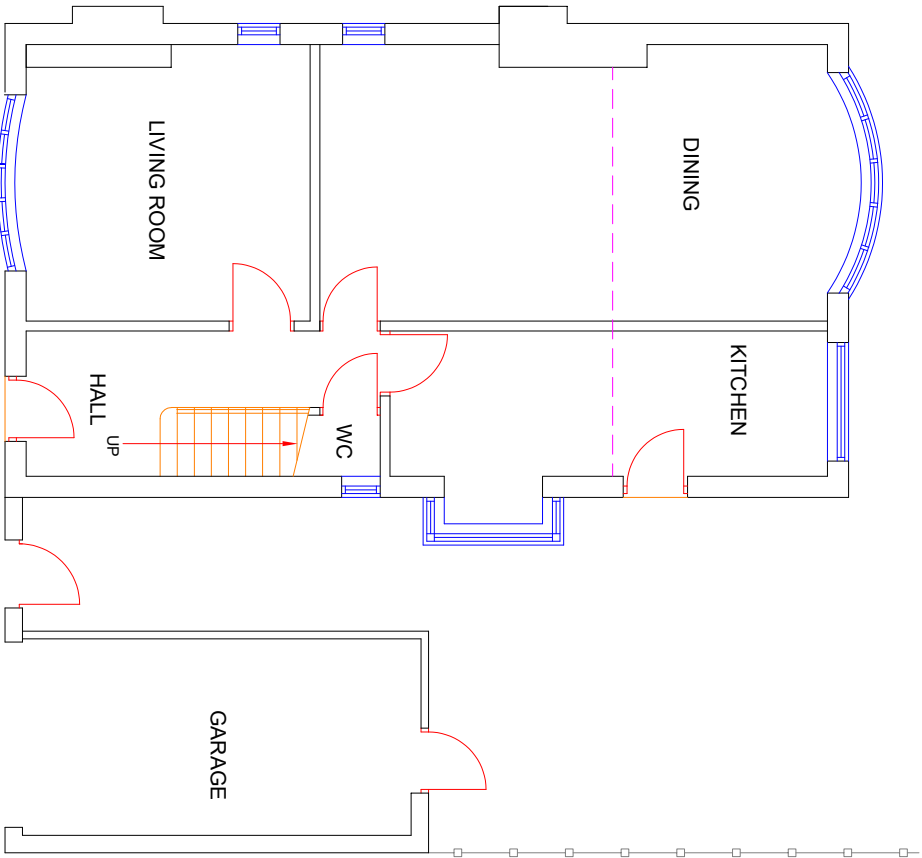

EXISTING GROUND FLOOR PLAN
SCALE 1:100

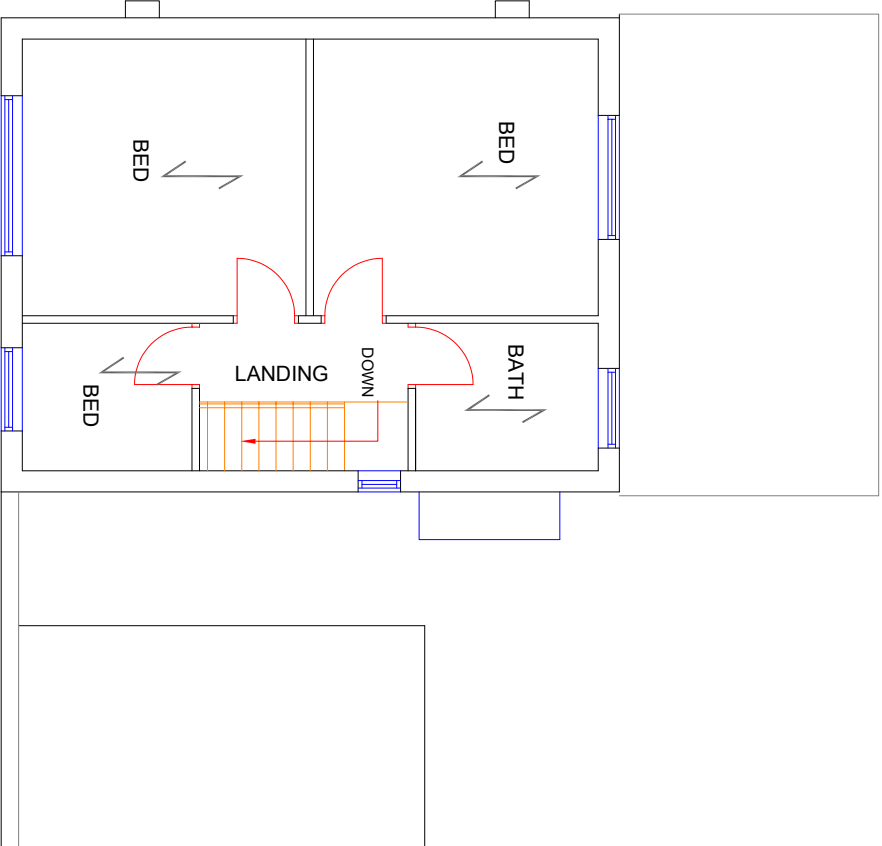

EXISTING FIRST FLOOR PLAN
SCALE 1:100

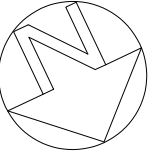

Consultant



Civil/Structural and planning Consultants
1 Ensign Business Centre, Westwood Way,
Westwood Business Park, Coventry, CV4 8JA
Tel: 02476 982010, Mob: 07852125530
info@ama-consultancy.com

Address

192 KIRKBY ROAD
BARWELL
LEICESTERSHIRE
LE9 8FS

Title

PLANS AS EXISTING

Drawn	Checked	Approved
RM	AN	AN

Dwg No.

AMA 783-002

Scale	Date	Revision
1:100	11.01.23	A

AS BUILT

