




A3		RevNo	Revision note	Date	Signature	Checked

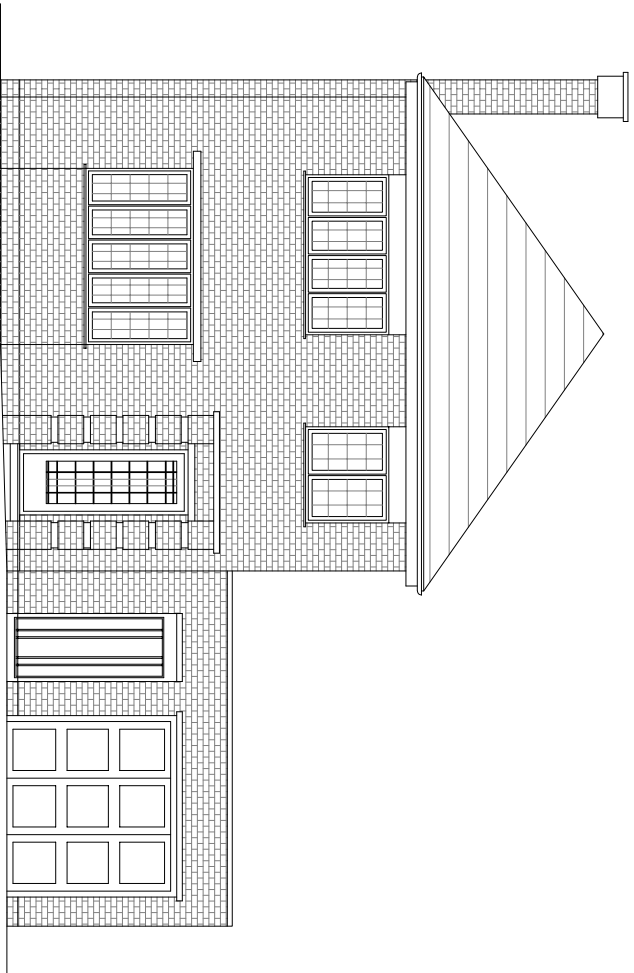


EXISTING FRONT ELEVATION
SCALE 1:100

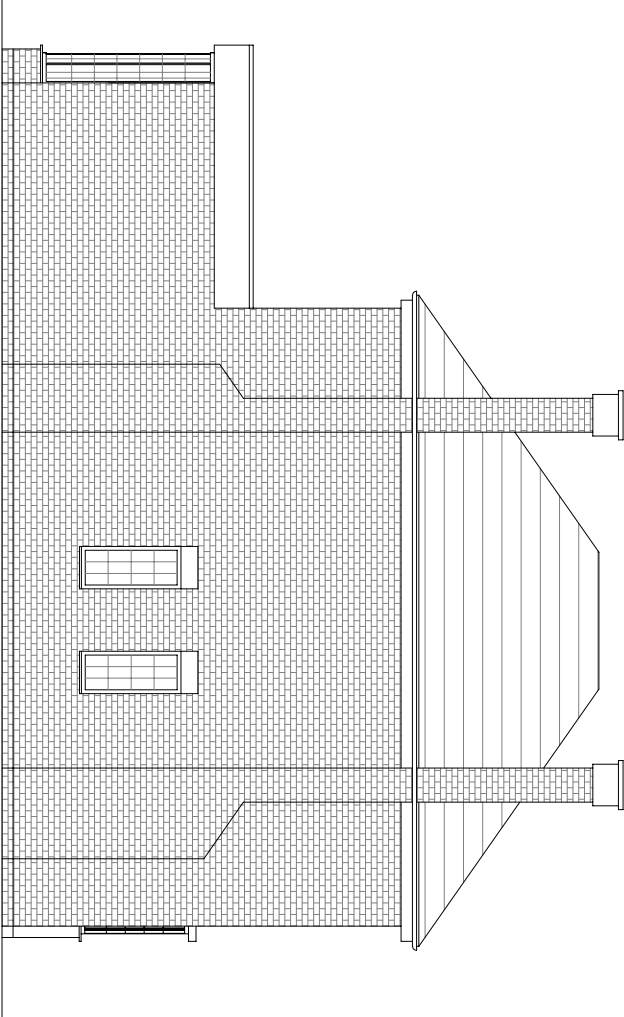

EXISTING SIDE ELEVATION
SCALE 1:100

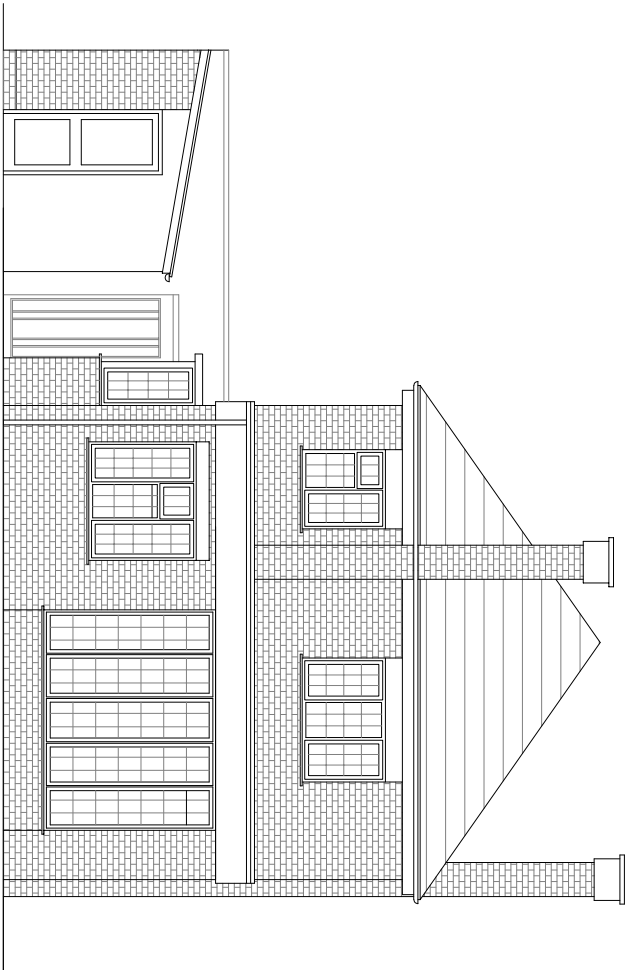

EXISTING REAR ELEVATION
SCALE 1:100

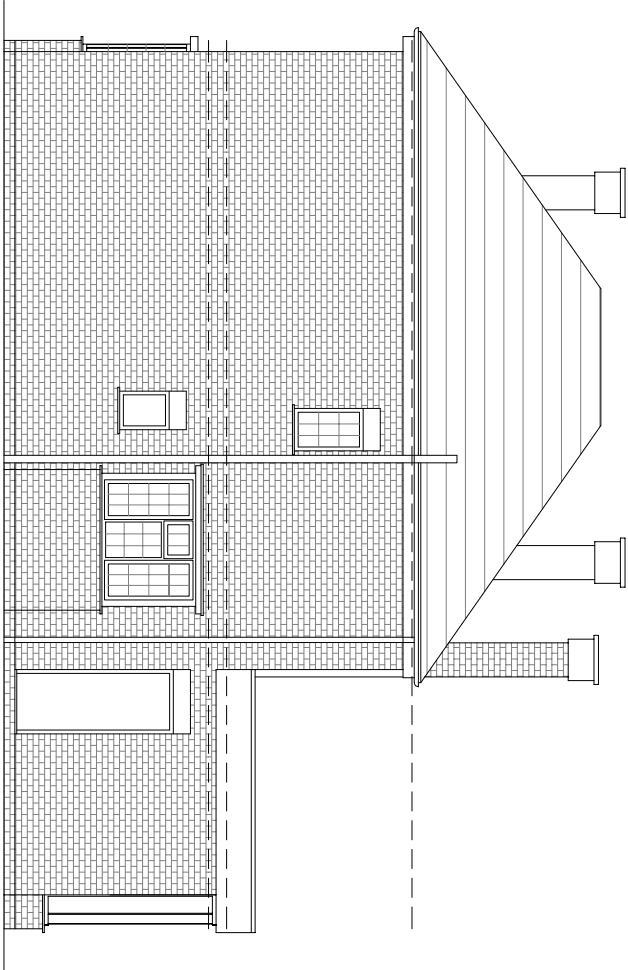

EXISTING SIDE ELEVATION
SCALE 1:100



AS BUILT

Consultant		
 AMA UK CONSULTANCY LTD Civil/Structural and planning Consultants 1 Ensign Business Centre, Westwood Way, Westwood Business Park, Coventry, CV4 8JA Tel: 02476 982010, Mob: 07852125530 info@ama-consultancy.com		
Address		
192 KIRKBY ROAD BARWELL LEICESTERSHIRE LE9 8FS		
Title		
ELEVATIONS AS EXISTING		
Drawn RM	Checked AN	Approved AN
Dwg No.		
AMA 783-004		
Scale	Date	Revision
1:100	11.01.23	