

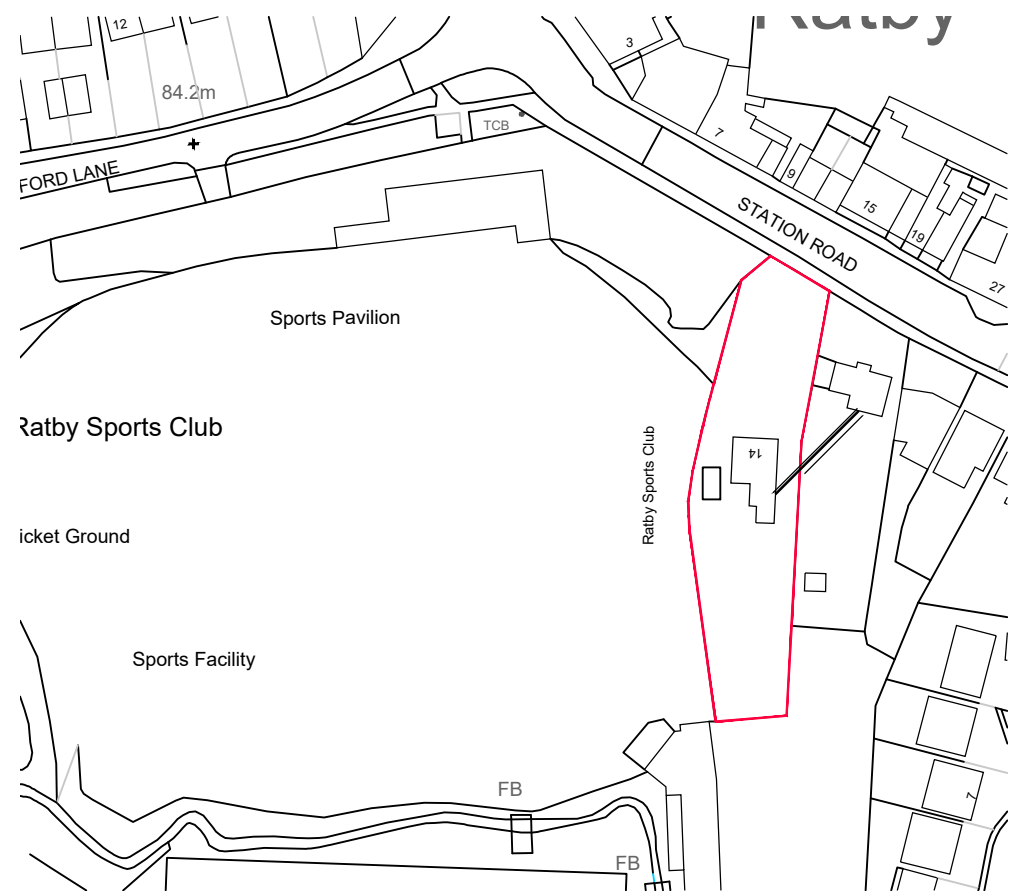


THIS DRAWING IS ISSUED FOR THE SOLE AND EXCLUSIVE USE OF THE NAMED RECIPIENT. DISTRIBUTION TO ANY THIRD PARTY IS ON THE STRICT UNDERSTANDING THAT NO LIABILITY IS ACCEPTED BY DESIGN STUDIO ARCHITECTS LTD FOR ANY DISCREPANCIES, ERRORS OR OMISSIONS THAT MAY BE PRESENT AND NO GUARANTEE IS OFFERED AS TO THE ACCURACY OF THE INFORMATION SHOWN. THIS DRAWING IS FOR REFERENCE ONLY. PLEASE REPORT ANY DISCREPANCIES TO THE DESIGNER BEFORE ANY WORKS COMMENCE. ALL DIMENSIONS TO BE CHECKED ON SITE BEFORE ANY WORKS COMMENCE. DESIGN STUDIO ARCHITECTS LTD. COPYRIGHT RESERVED.


Rev.	Description.	Drwn.	Chk.	Date.
P01	FIRST ISSUE.	CC	KS	19.11.2025

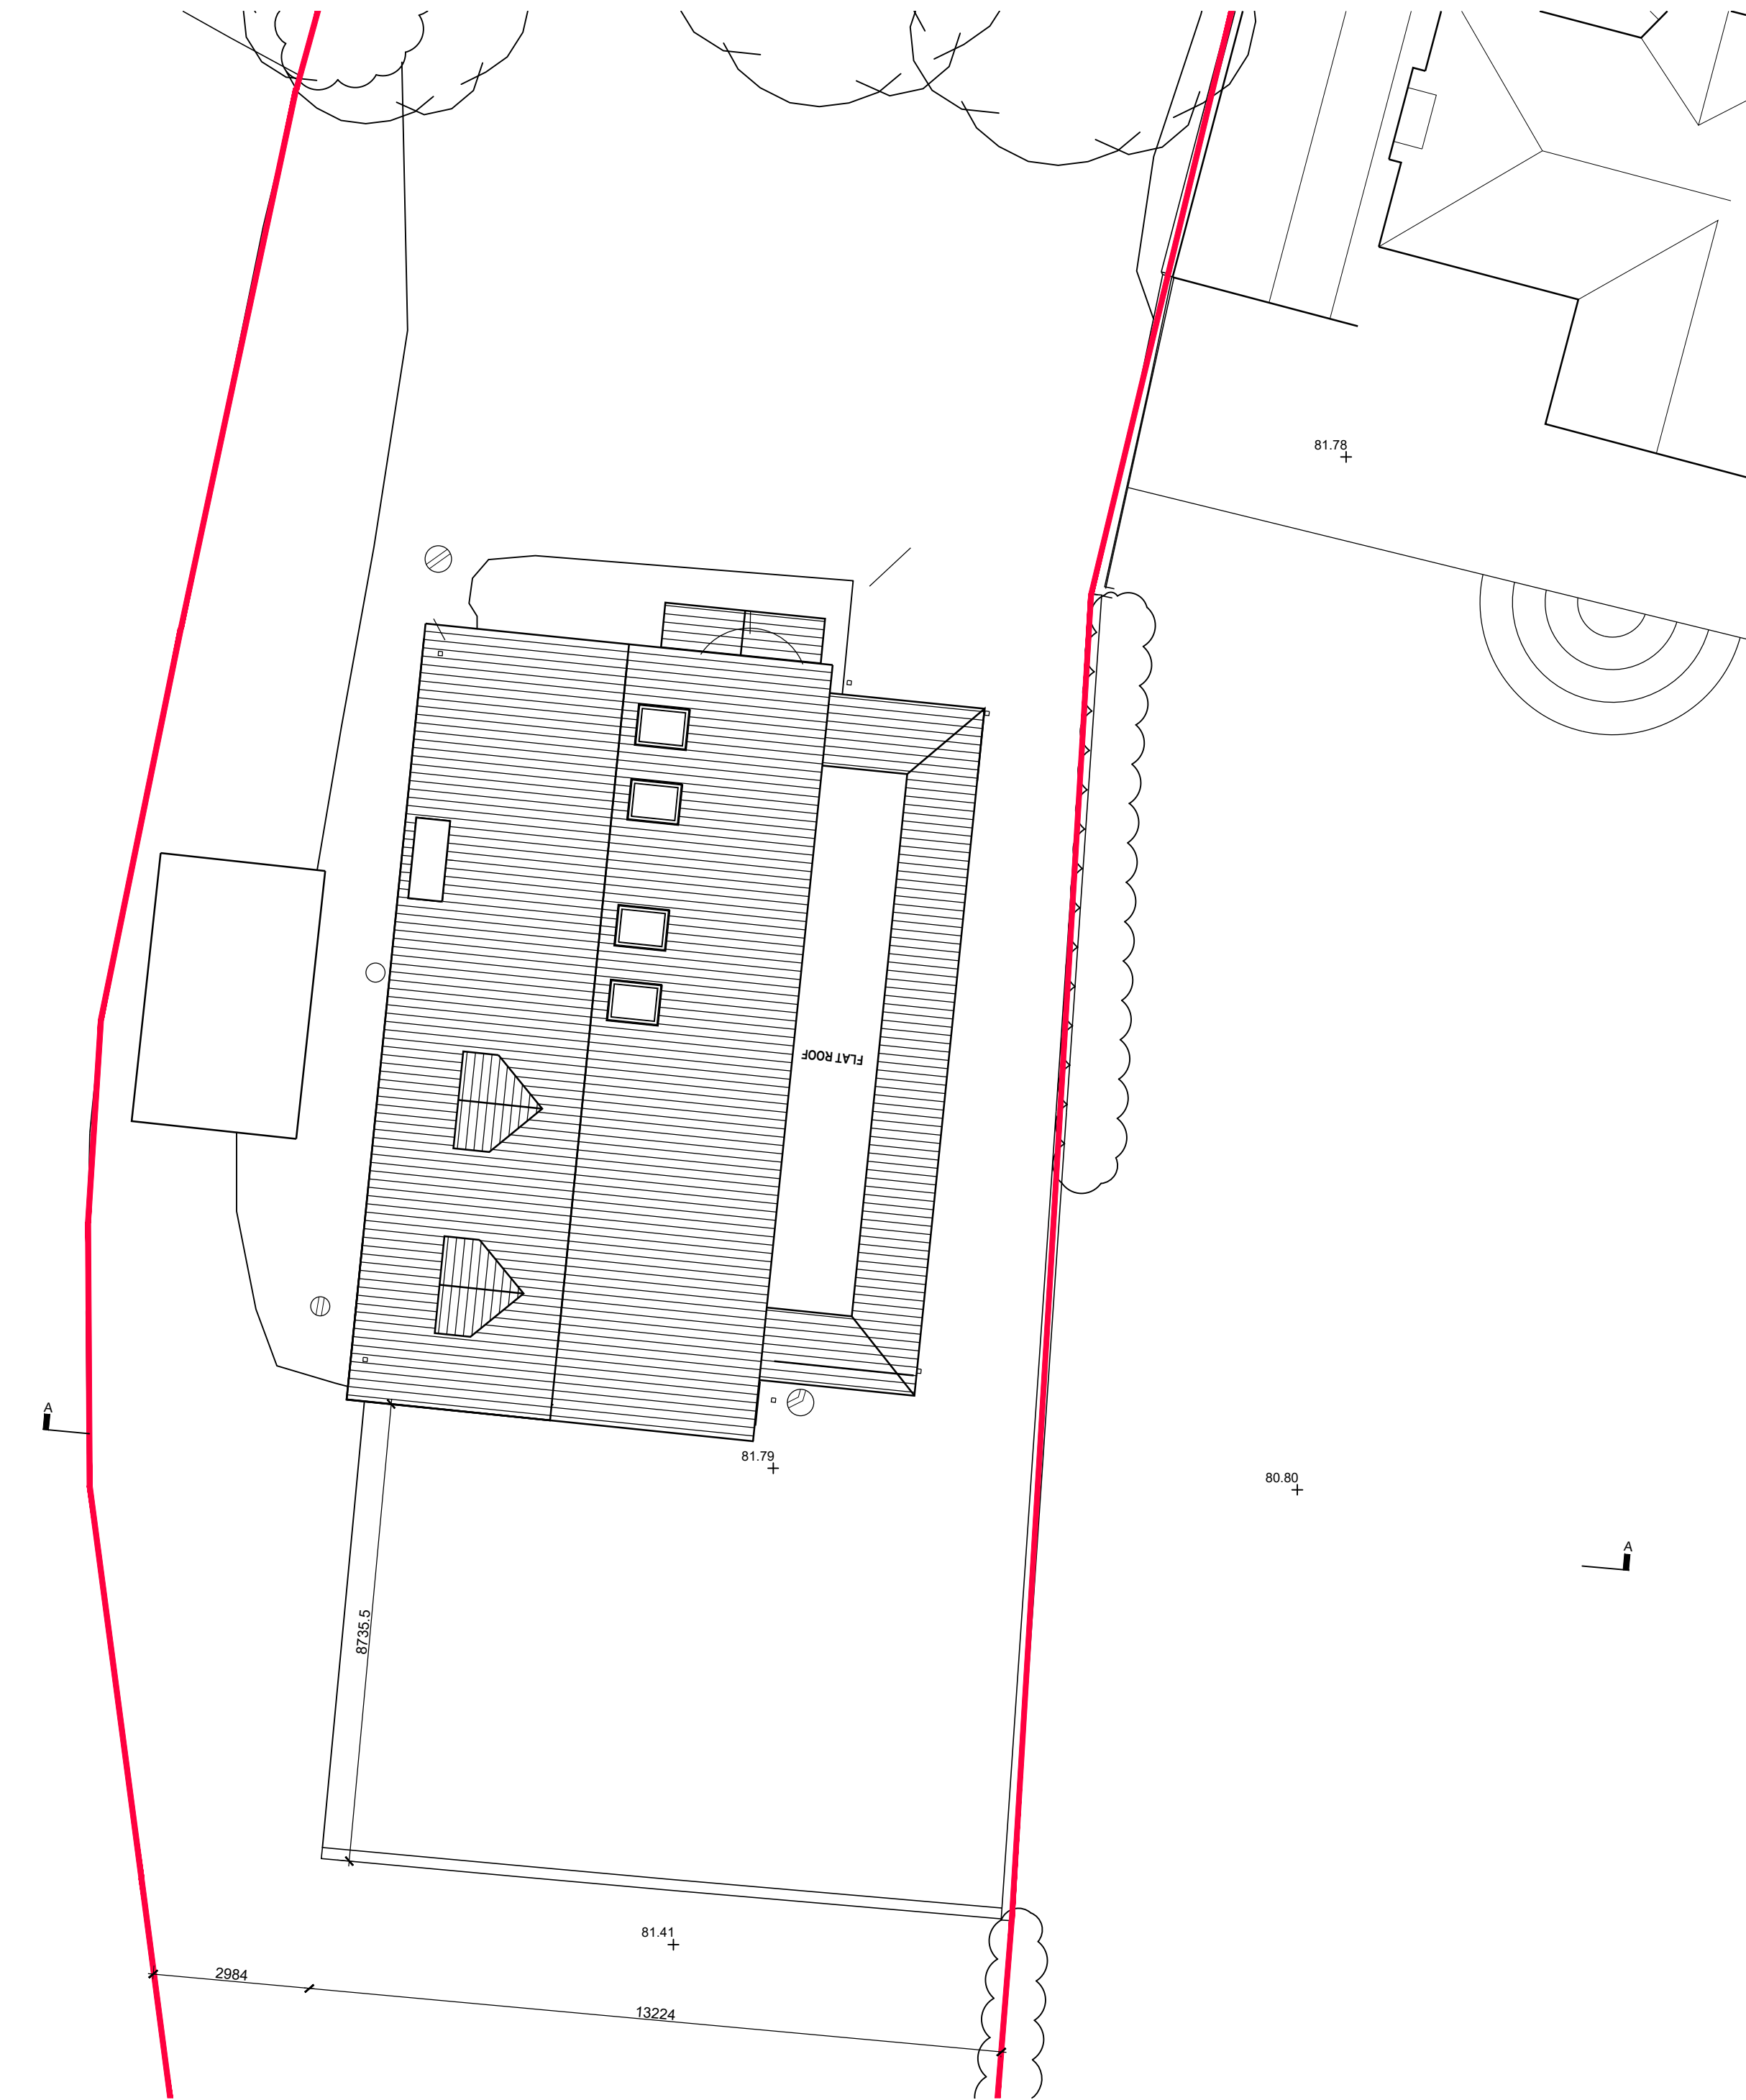


10DS MAP
Scale 1:1250

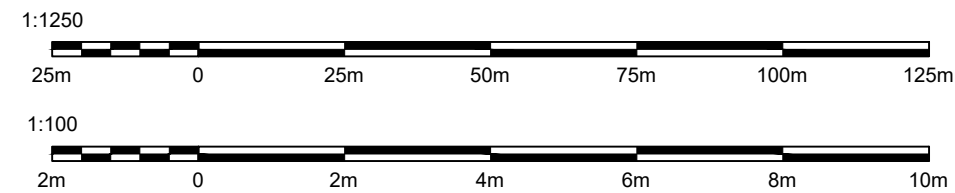


06AS BUILT ON SITE
Scale 1:100

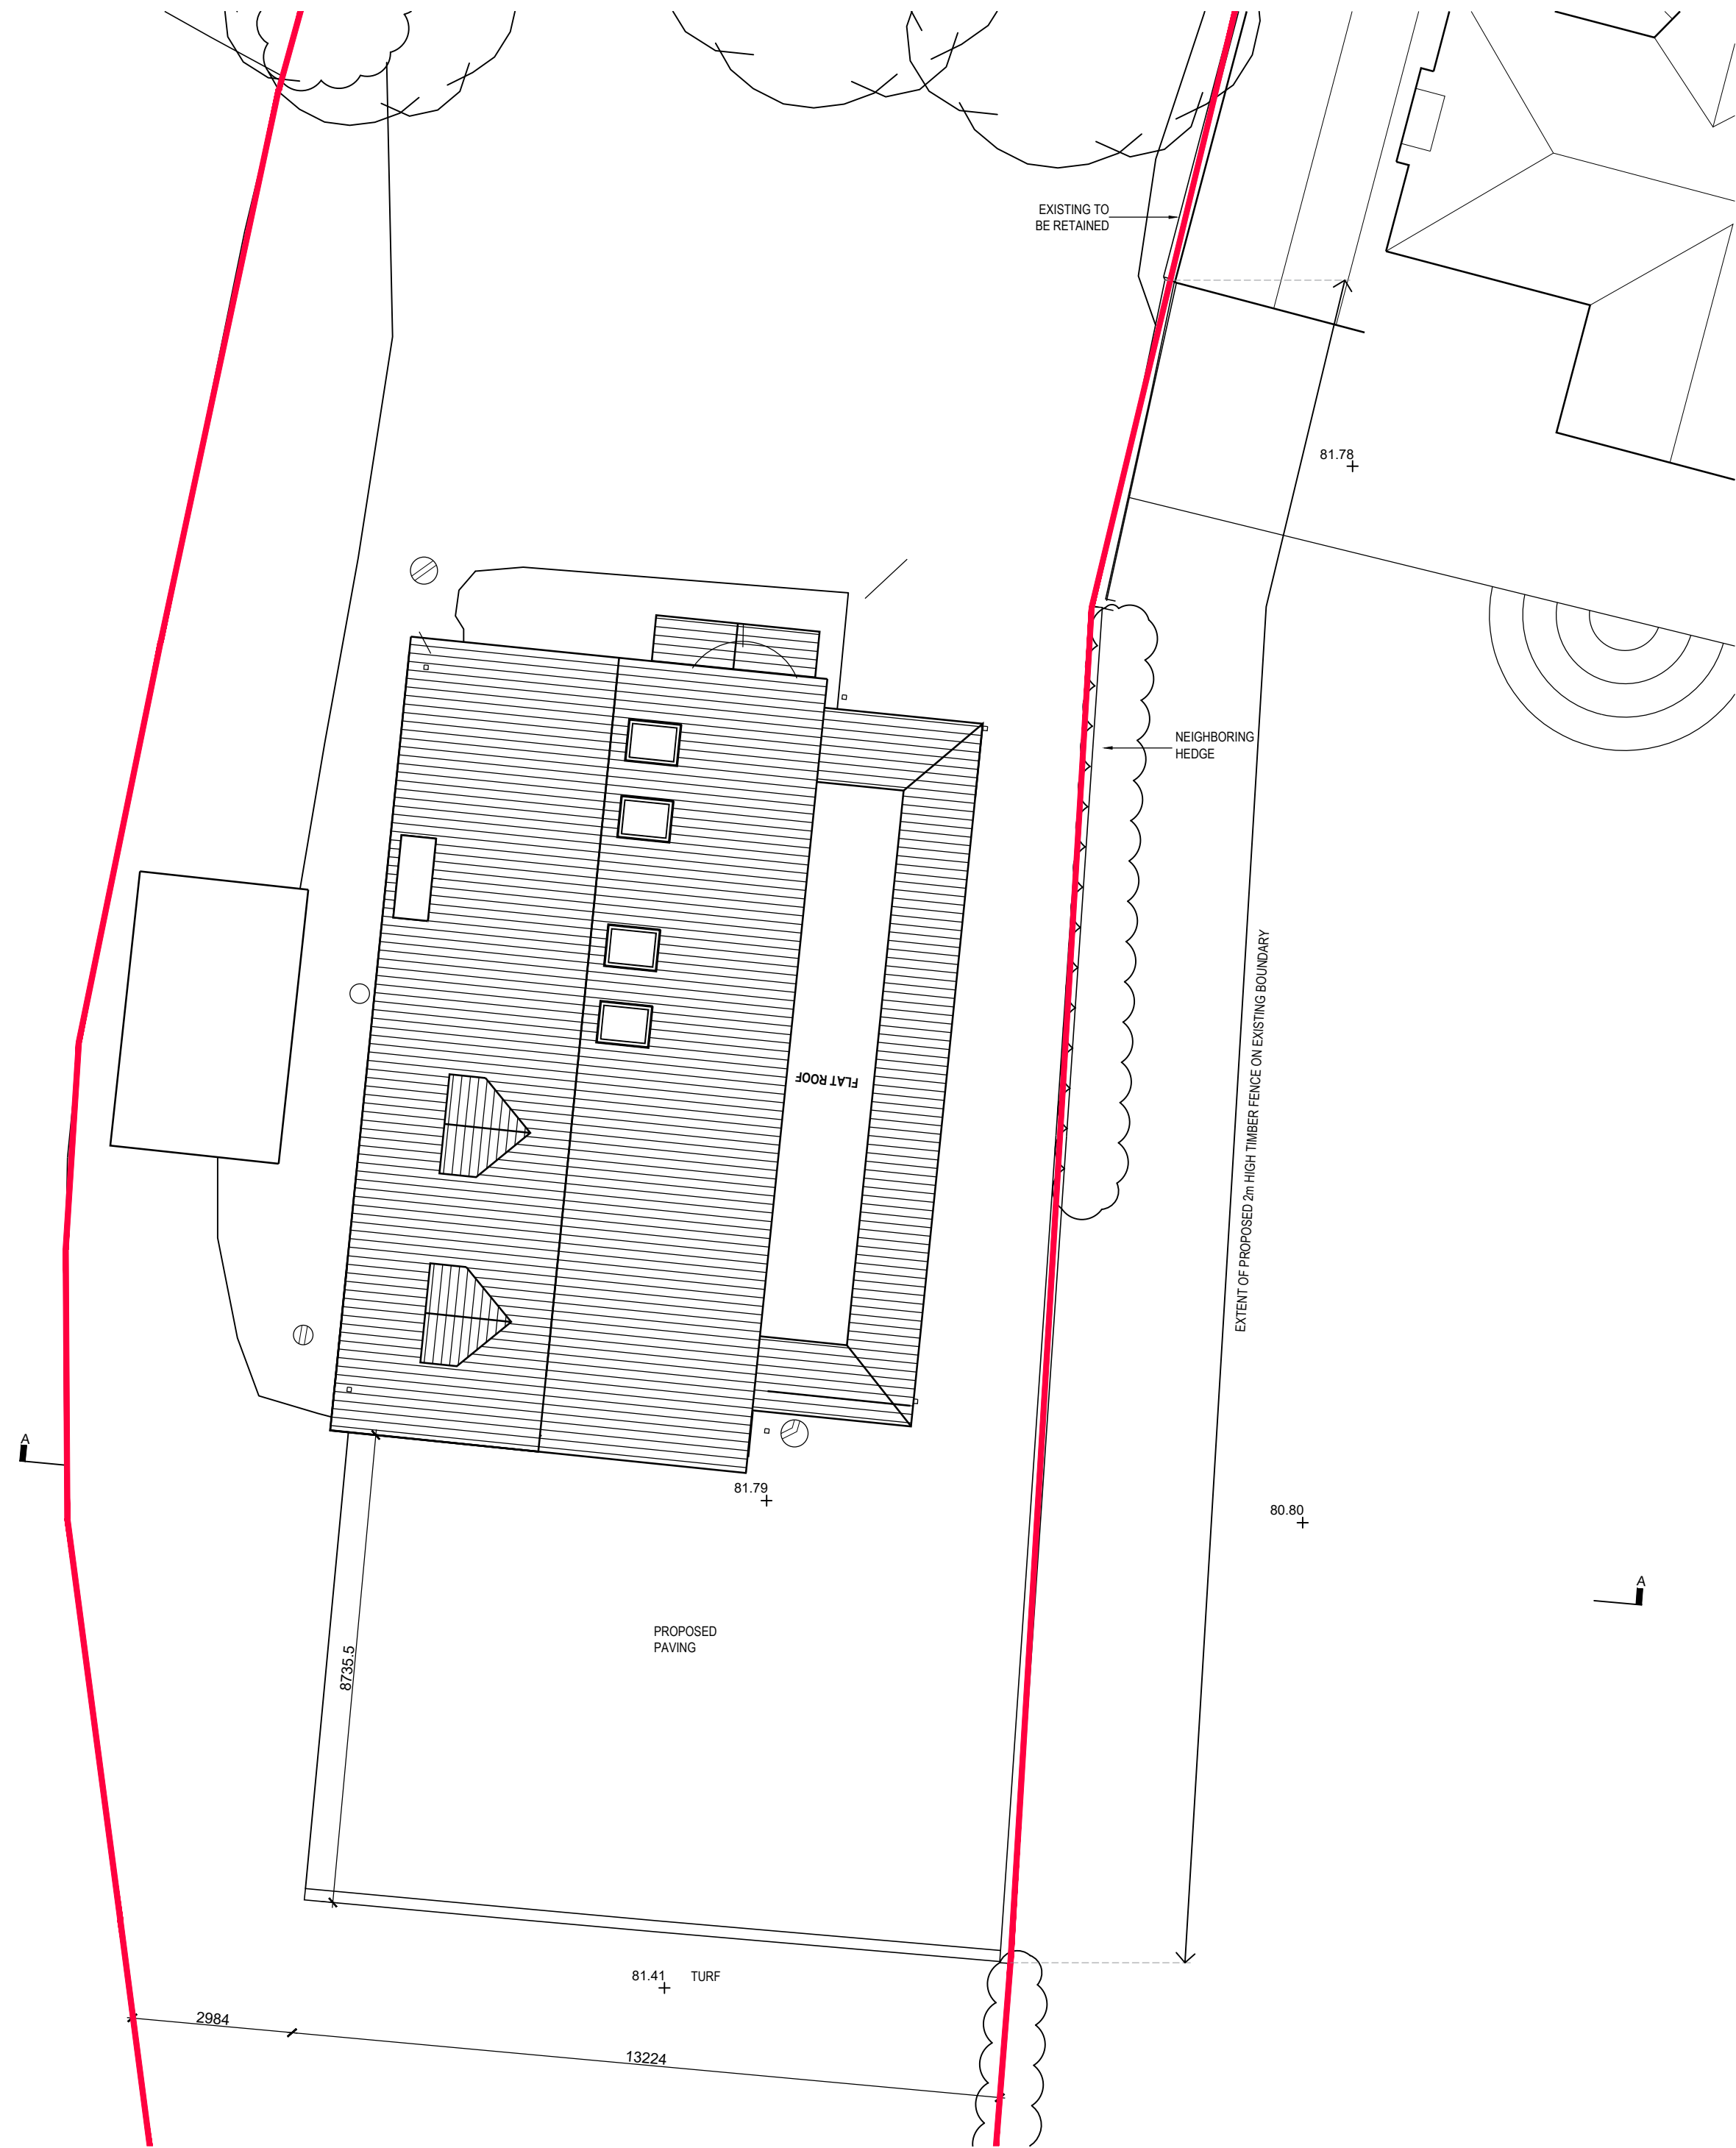


07PROPOSED
Scale 1:100

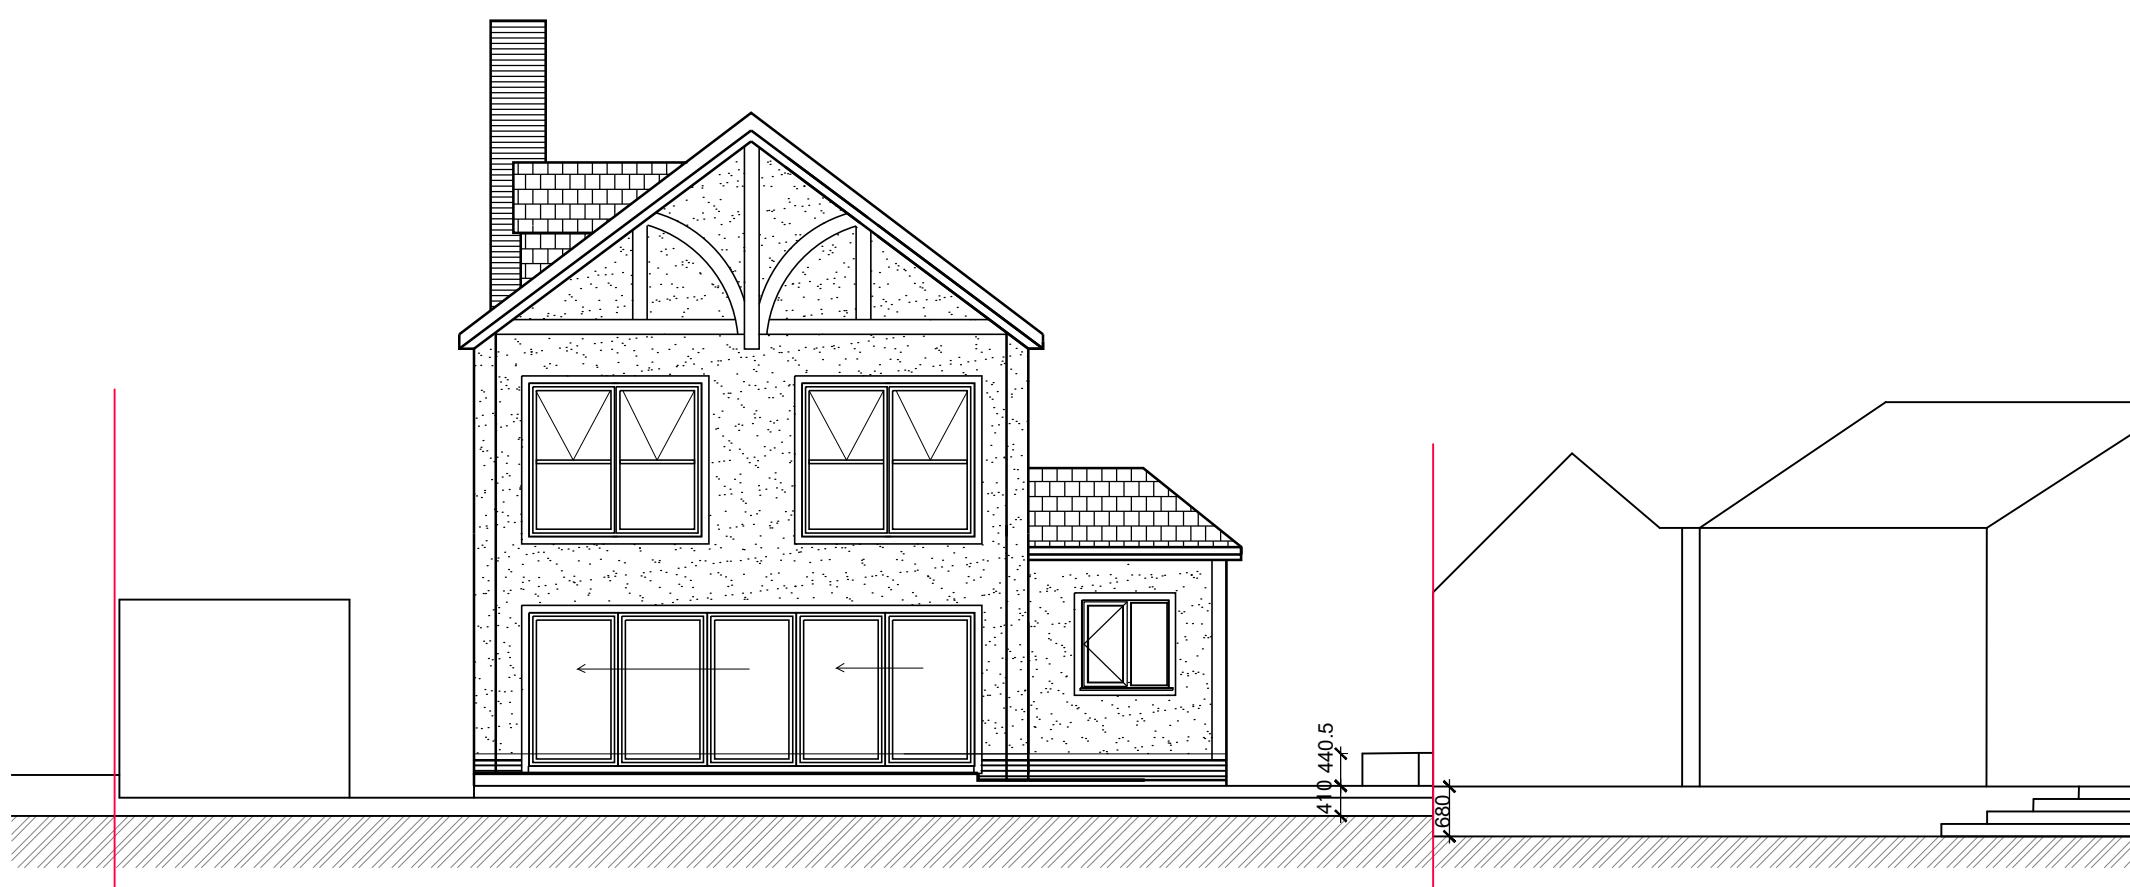

08SITE SECTION AS BUILT ON SITE

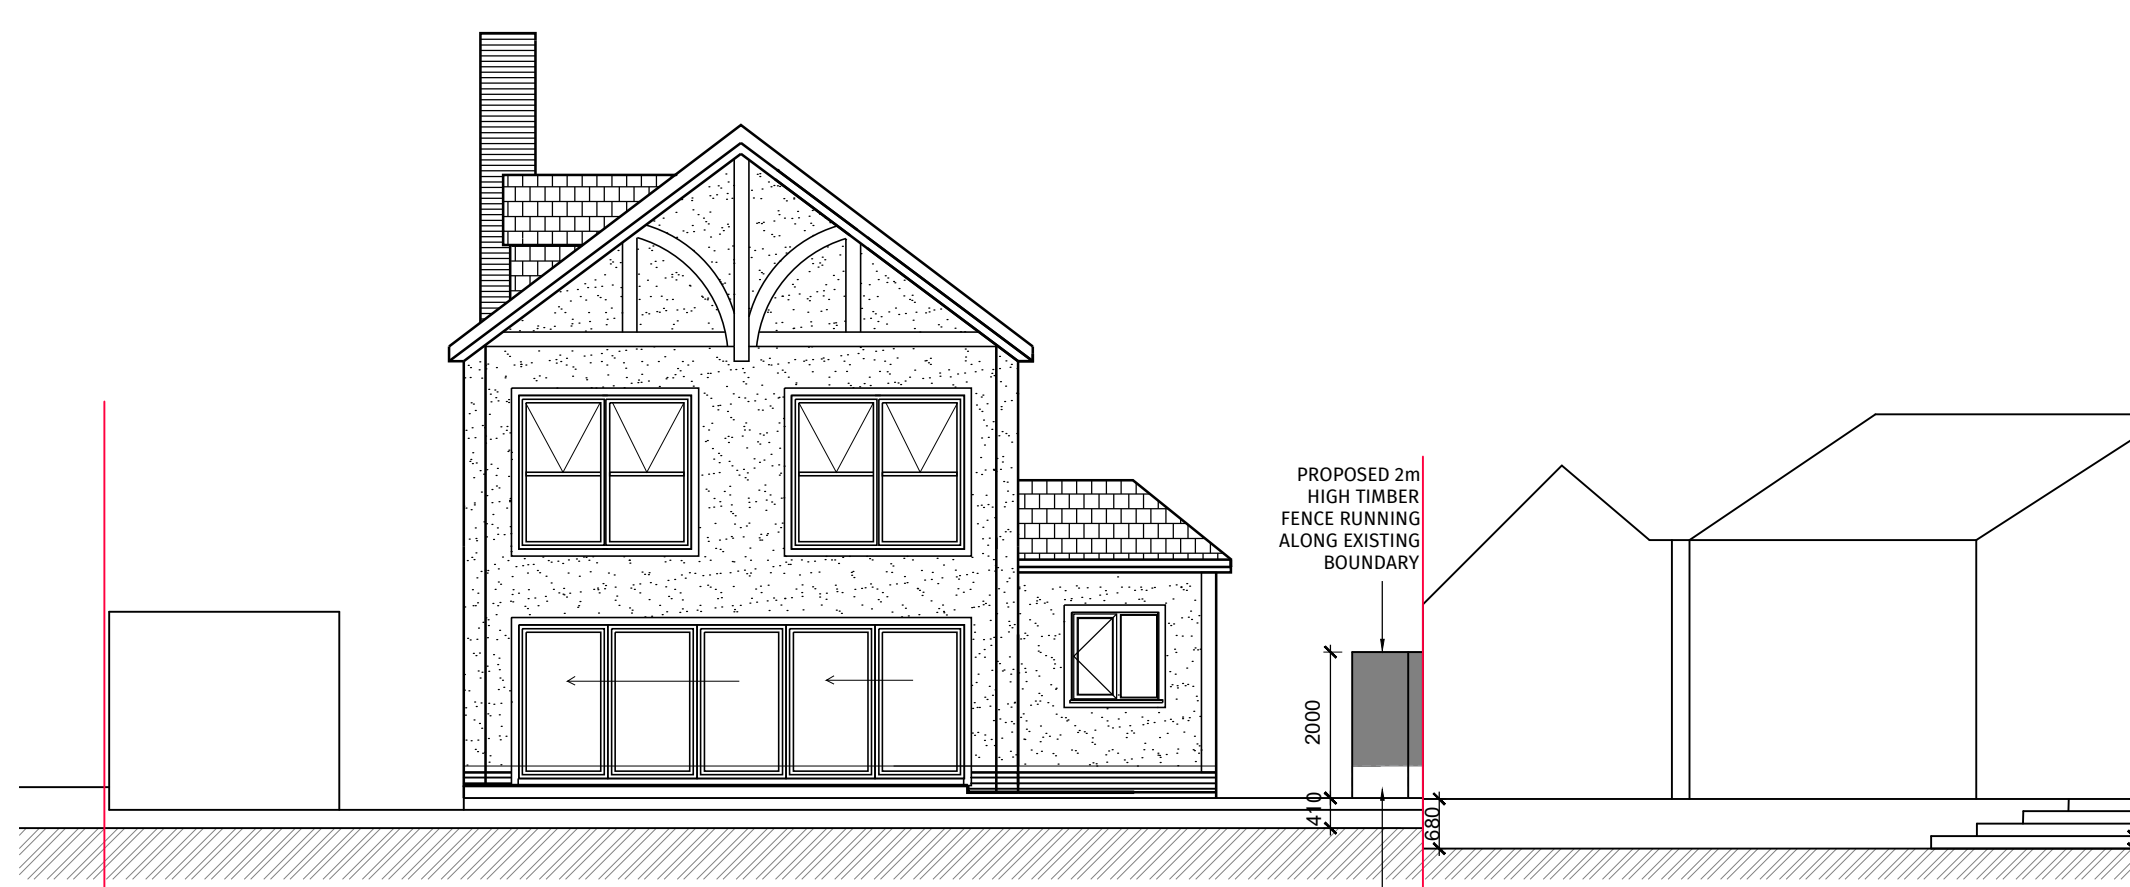

09SITE SECTION PROPOSED

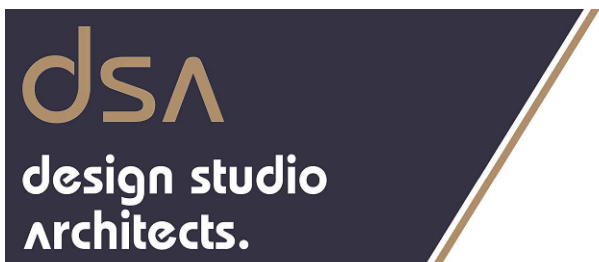

Regent House, 7 Upper King Street
Leicester, LE1 6XB

t:0116 251 0606 | w:ds-a.co.uk | e:info@ds-a.co.uk

Project Details:

Lukbinder Bath
14 Station Road
Ratby
Leicester
LE6 0JN

Drawing Name:

21116

Drawing Stage: SKETCH SCHEME

Drawn: CC Check: KS Date: 18/11/2025 Scale:1:100&1:1250

Drawing Number:

21116 DSA ZZ XX DR A 301 P01

PRODUCT CODE DRAWN ZONE LEVEL TYPE ROLE NUMBER REVISION

