




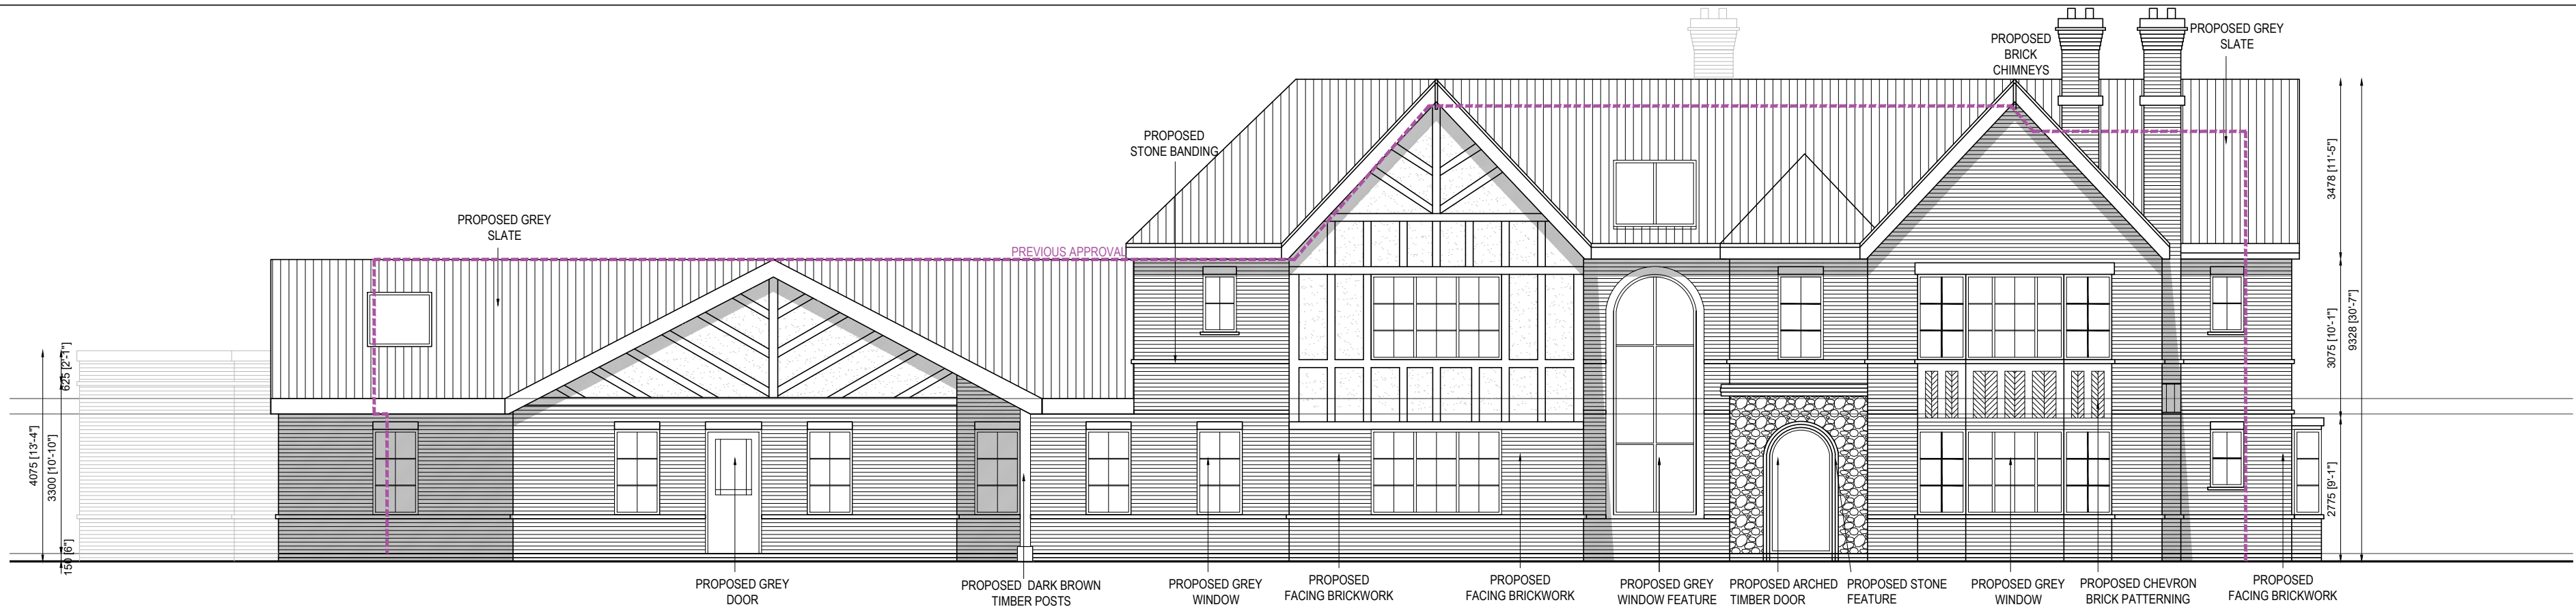


PROPOSED FRONT ELEVATION -A-A
SCALE 1/100

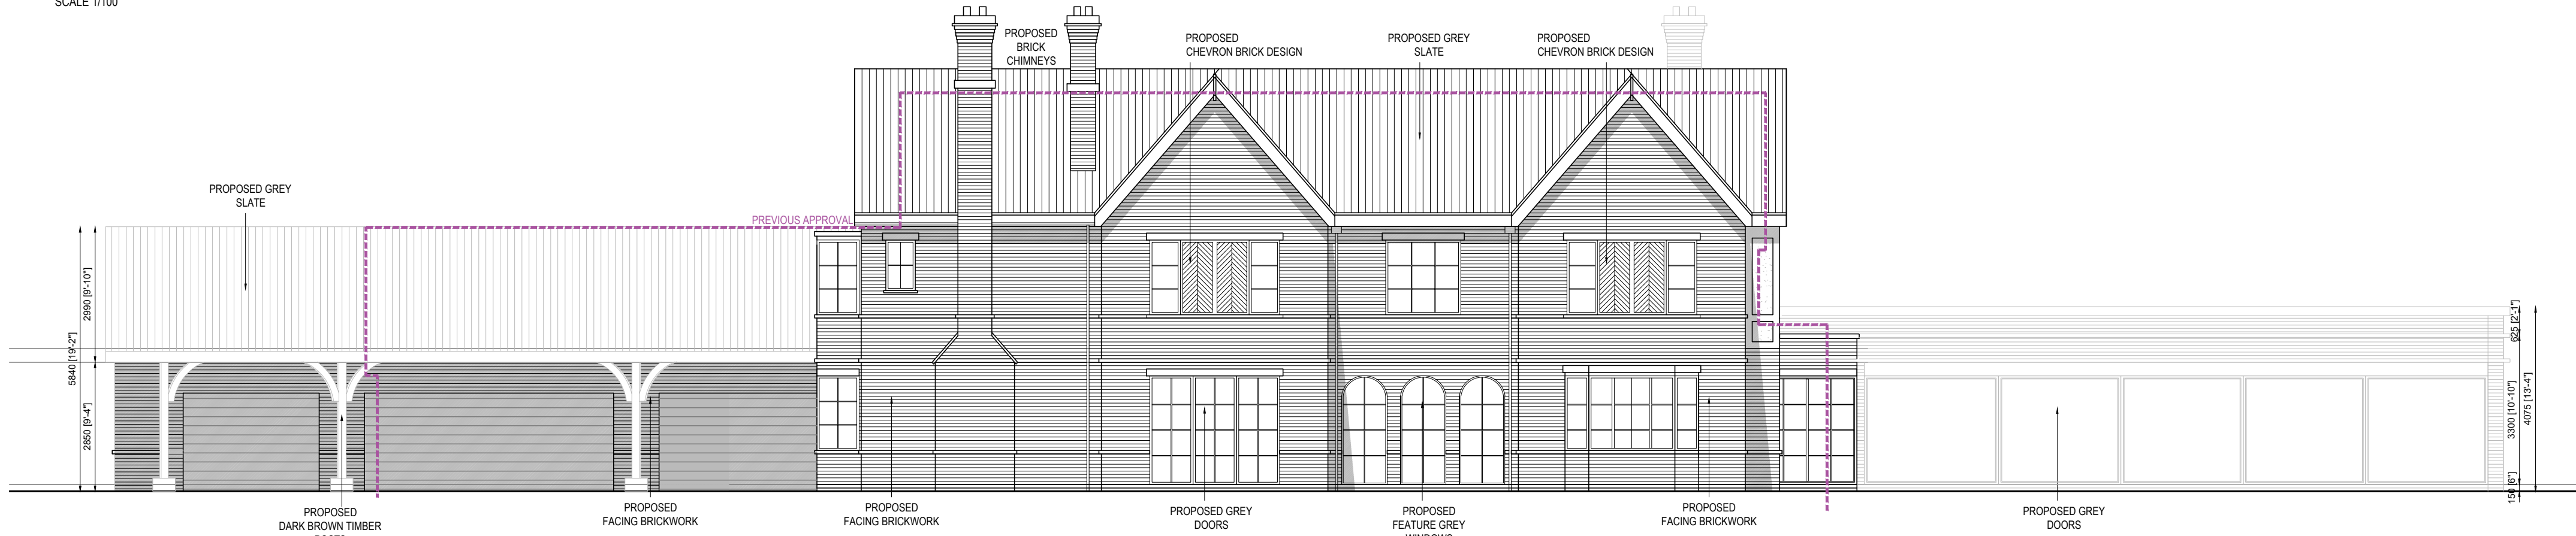


PROPOSED SIDE ELEVATION -B-B
SCALE 1/100

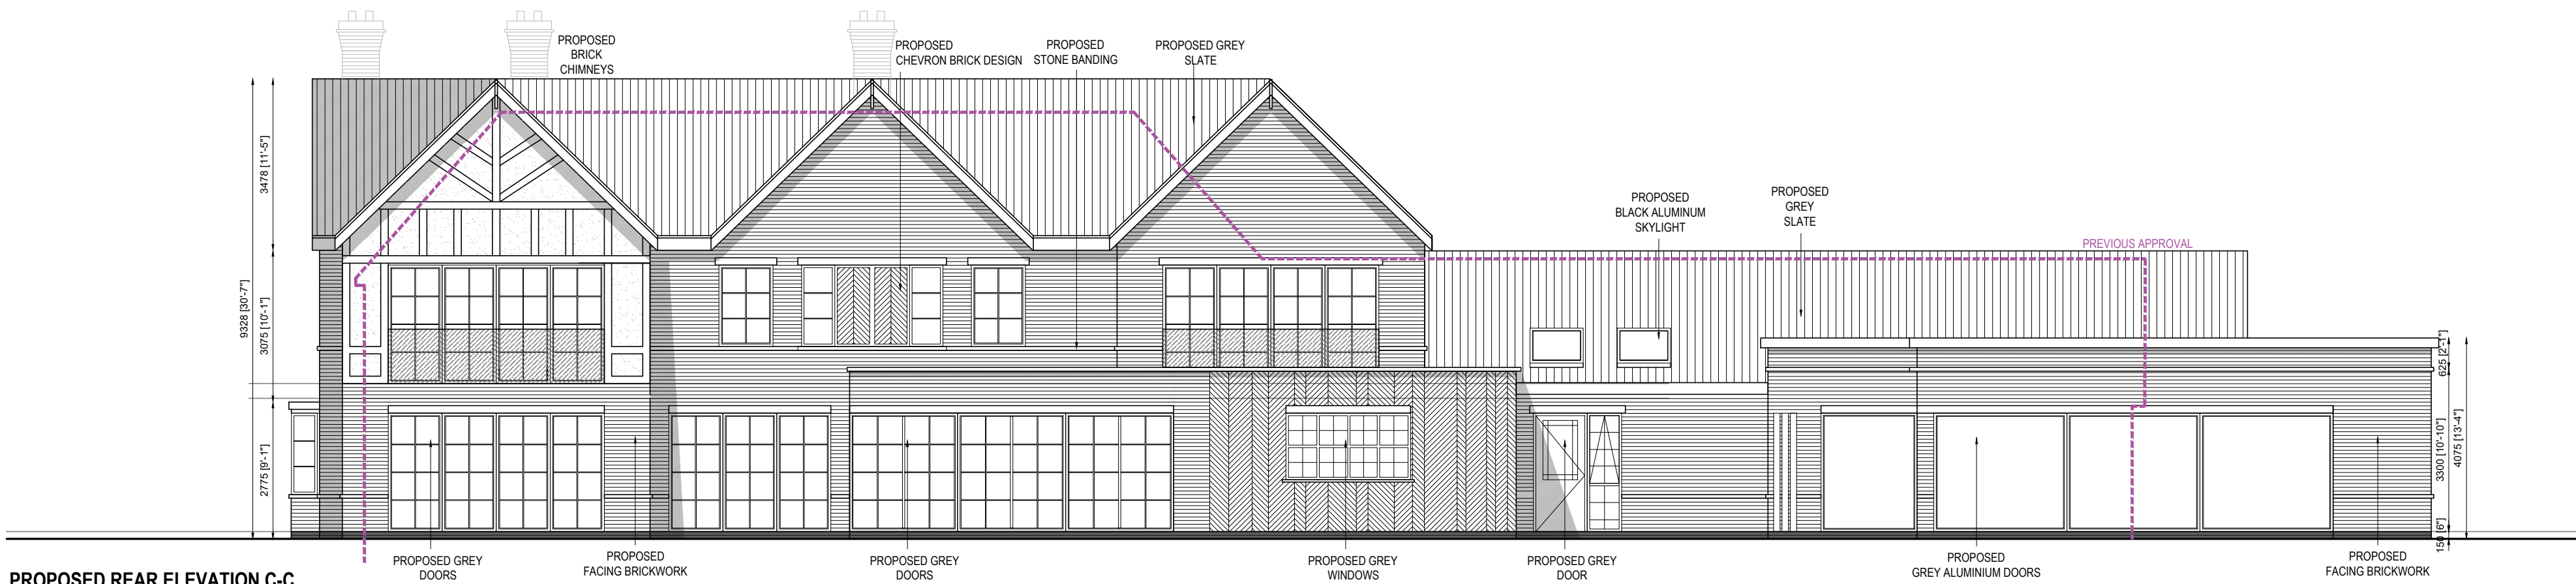

PROPOSED REAR ELEVATION C-C
SCALE 1/100

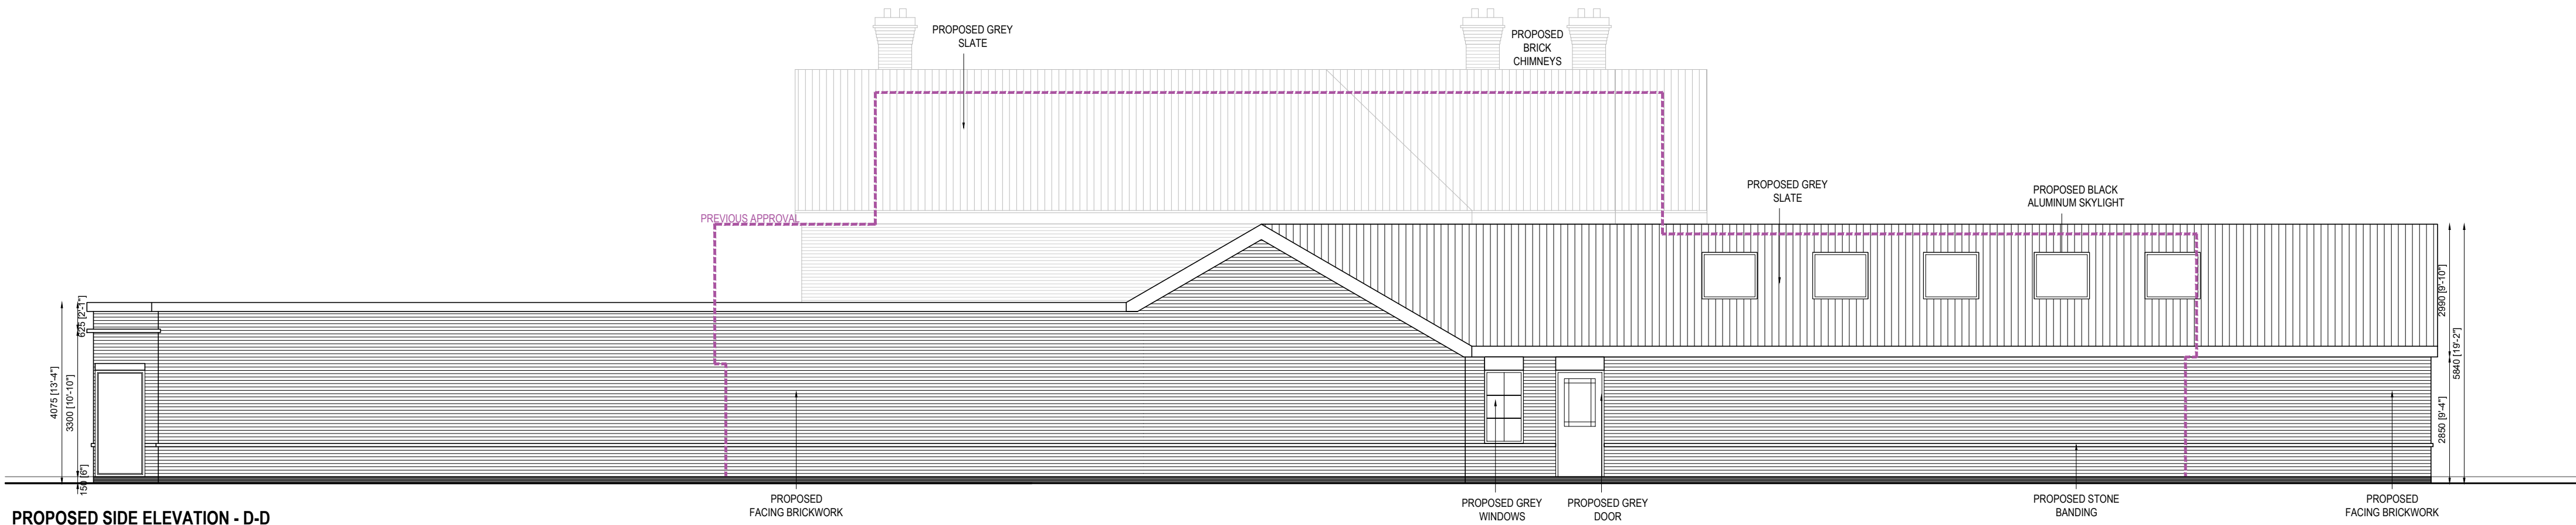

PROPOSED SIDE ELEVATION - D-D
SCALE 1/100

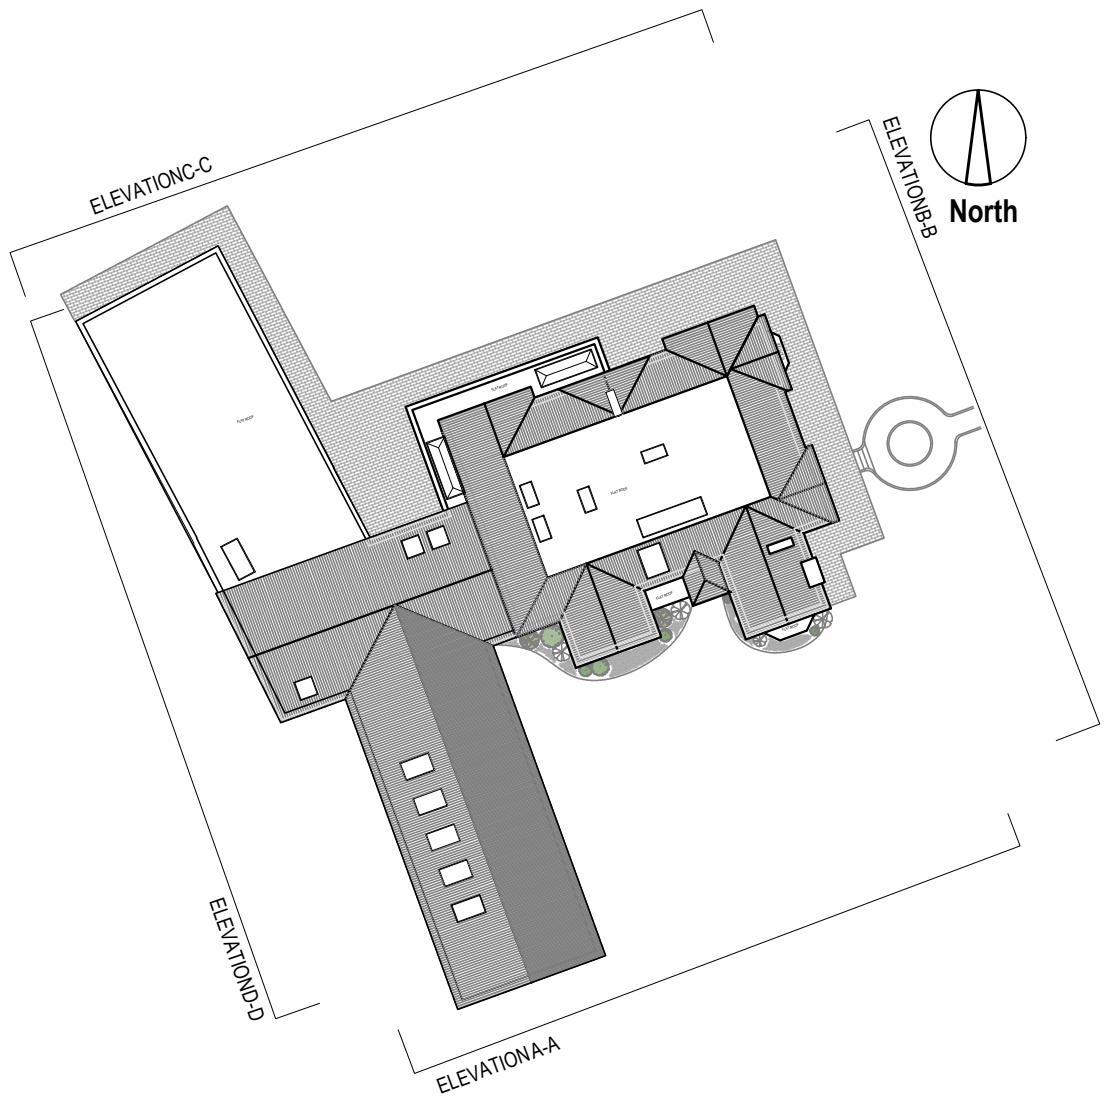

PROPOSED ELEVATIONS' KEY INFORMATION MAP
SCALE 1/500

Revision: M - 28.11.24 - PF - Previous Approval Outline
Revision: L - 19.08.24 - PF - Client Updates
Revision: K - 05.08.24 - PF - Client Updates
Revision: J - 21.08.24 - PF - Client Updates
Revision: I - 16.05.24 - PF - Client Updates
Revision: H - 03.05.24 - PF - Client Updates
Revision: G - 28.04.24 - PF - Client Updates
Revision: F - 22.04.24 - PF - Client Updates
Revision: E - 15.02.23 - PF - Proposed outline
Revision: D - 15.02.23 - PF - Client updates
Revision: C - 16.02.23 - MK - Scale ruler added
Revision: B - 16.02.23 - MK - Preparing for planning



Regent House,
7 Upper King Street,
Leicester LE1 6XB
Tel: 0116 251 0606
E: info@ds-a.co.uk
W: www.ds-a.co.uk



Drawing Stage		
FEASIBILITY	TENDER	
PLANNING	CONSTRUCTION	
BUILDING REGULATIONS	AS BUILT	

Project: 20128 - Manor Lodge, 13 Station Road, LE9 9FN
Client: Mr S
Sheet Title: Planning Application Information - Elevations
Ref: DSA-20128-ELE-03-M
Scale: 1:100 @ A1
Date: 02-12-2022
Drawn: M.K. Checked: K.S.

THIS DRAWING IS ISSUED FOR THE SOLE AND EXCLUSIVE USE OF THE NAMED RECIPIENT. DISTRIBUTION TO ANY THIRD PARTY IS ON THE STRICT UNDERSTANDING THAT NO LIABILITY IS ACCEPTED BY DESIGN STUDIO ARCHITECTS LTD FOR ANY DISCREPANCIES, ERRORS OR OMISSIONS THAT MAY BE PRESENT AND NO GUARANTEE IS OFFERED AS TO THE ACCURACY OF THE INFORMATION SHOWN. THIS DRAWING IS FOR REFERENCE ONLY. PLEASE REPORT ANY DISCREPANCIES TO THE DESIGNER BEFORE ANY WORKS COMMENCE. ALL DIMENSIONS TO BE CHECKED ON SITE BEFORE ANY WORKS COMMENCE. DESIGN STUDIO ARCHITECTS LTD. 2013. COPYRIGHT RESERVED.

