
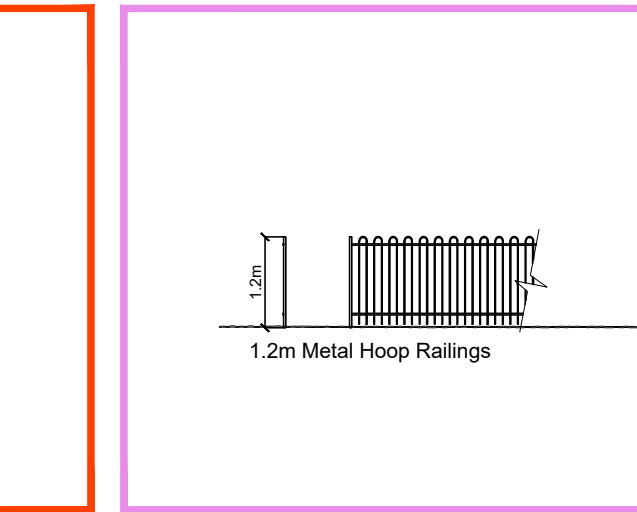
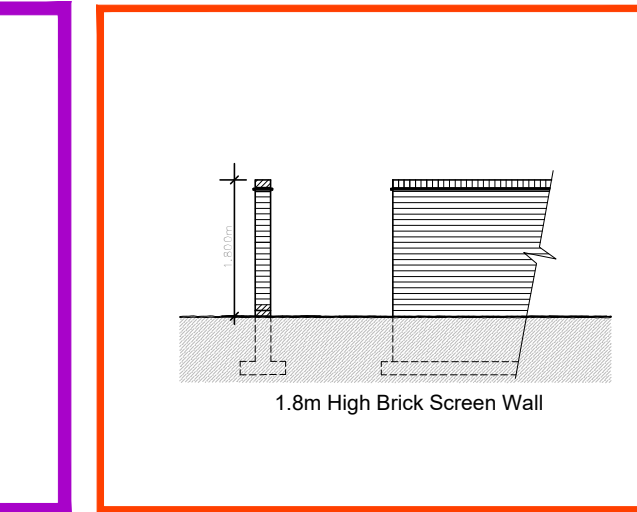
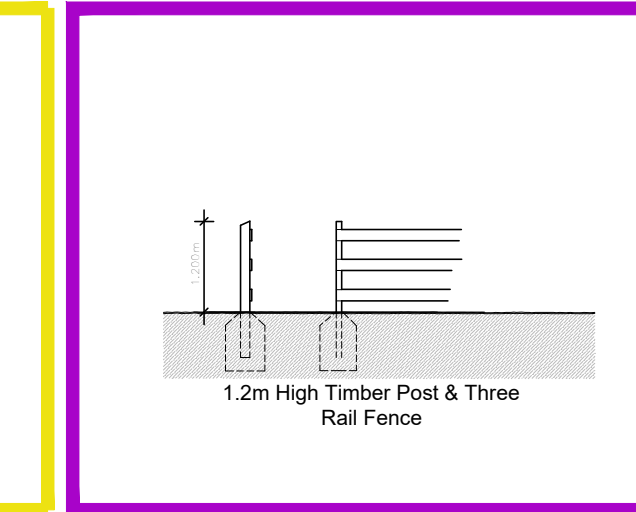
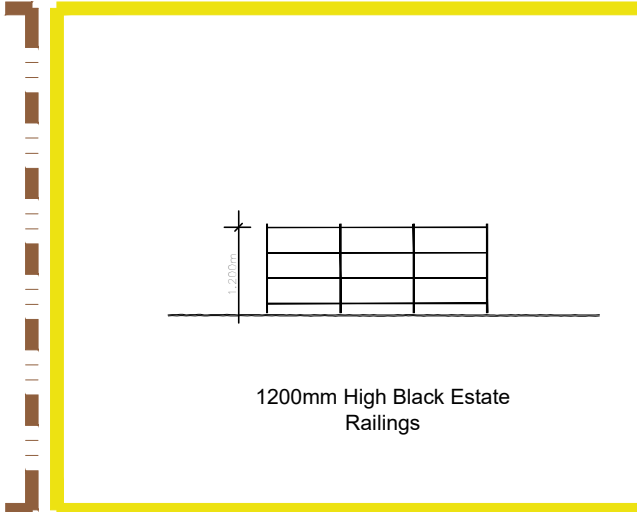
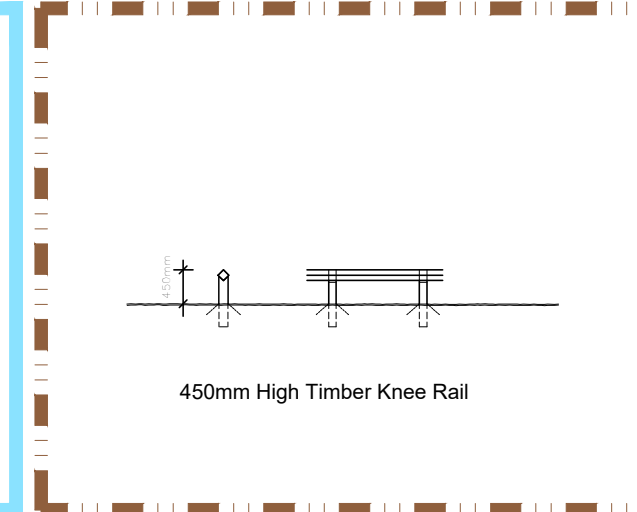
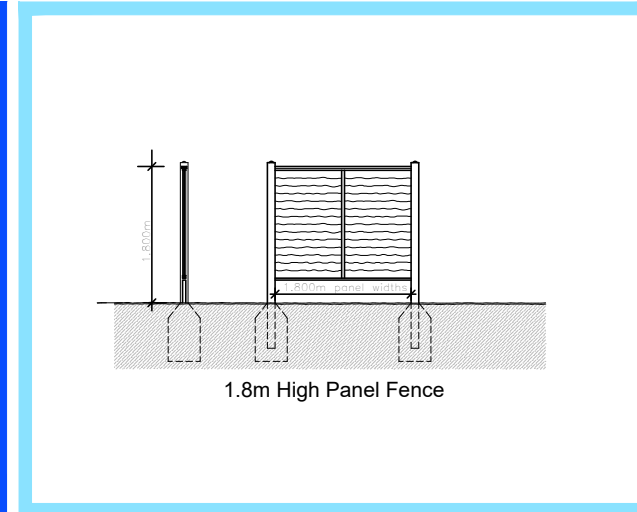


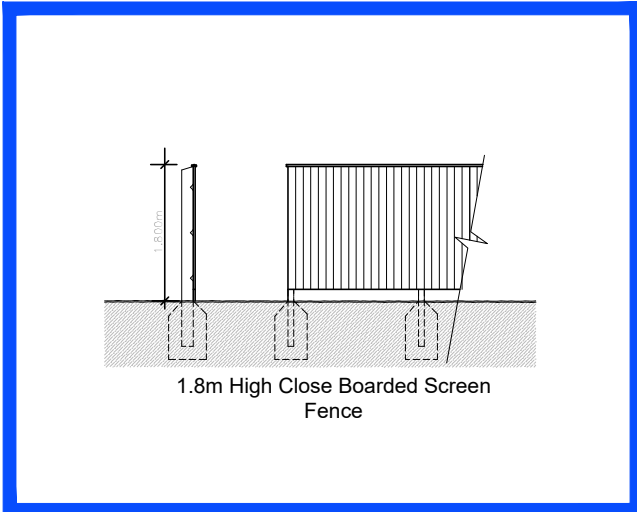


J.S BLOOR SERVICES LIMITED
BLOOR ROAD, MEDWAM, SHROPSHIRE, SY5 2JF
TELEPHONE 0151 275 275
FAX 0151 275 275
THIS DRAWING AND THE BUILDING WORKS DEPICTED ARE THE COPYRIGHT OF J.S BLOOR SERVICES LIMITED AND MAY NOT BE REPRODUCED OR AMENDED WITHOUT THE WRITTEN PERMISSION. NO LIABILITY WILL BE ACCEPTED FOR AMENDMENTS MADE BY OTHER PERSONS.
DO NOT SCALE THIS DRAWING. USE FIGURED DIMENSIONS ONLY. IF IN DOUBT ASK.
THIS DRAWING IS TO BE USED IN CONJUNCTION WITH SEPARATE GROUP 1 SITE SPECIFIC CONSTRUCTION NOTES AND MATERIALS SPECIFICATION.

BOUNDARY TREATMENTS

- 1.8m HIGH CLOSE BOARD FENCE
- 1.8m HIGH PANEL FENCE
- KNEE RAIL
- 1.2m BLACK ESTATE RAILINGS
- 1.2m HIGH TIMBER POST & THREE RAIL FENCE
- 1.8m High Brick Screen Wall
- 1.2m ESTATE RAILING GATE
- 1.2m METAL HOOP RAILINGS

Notes

- Screen walls to be built in matching brick to the dwelling it is attached to.

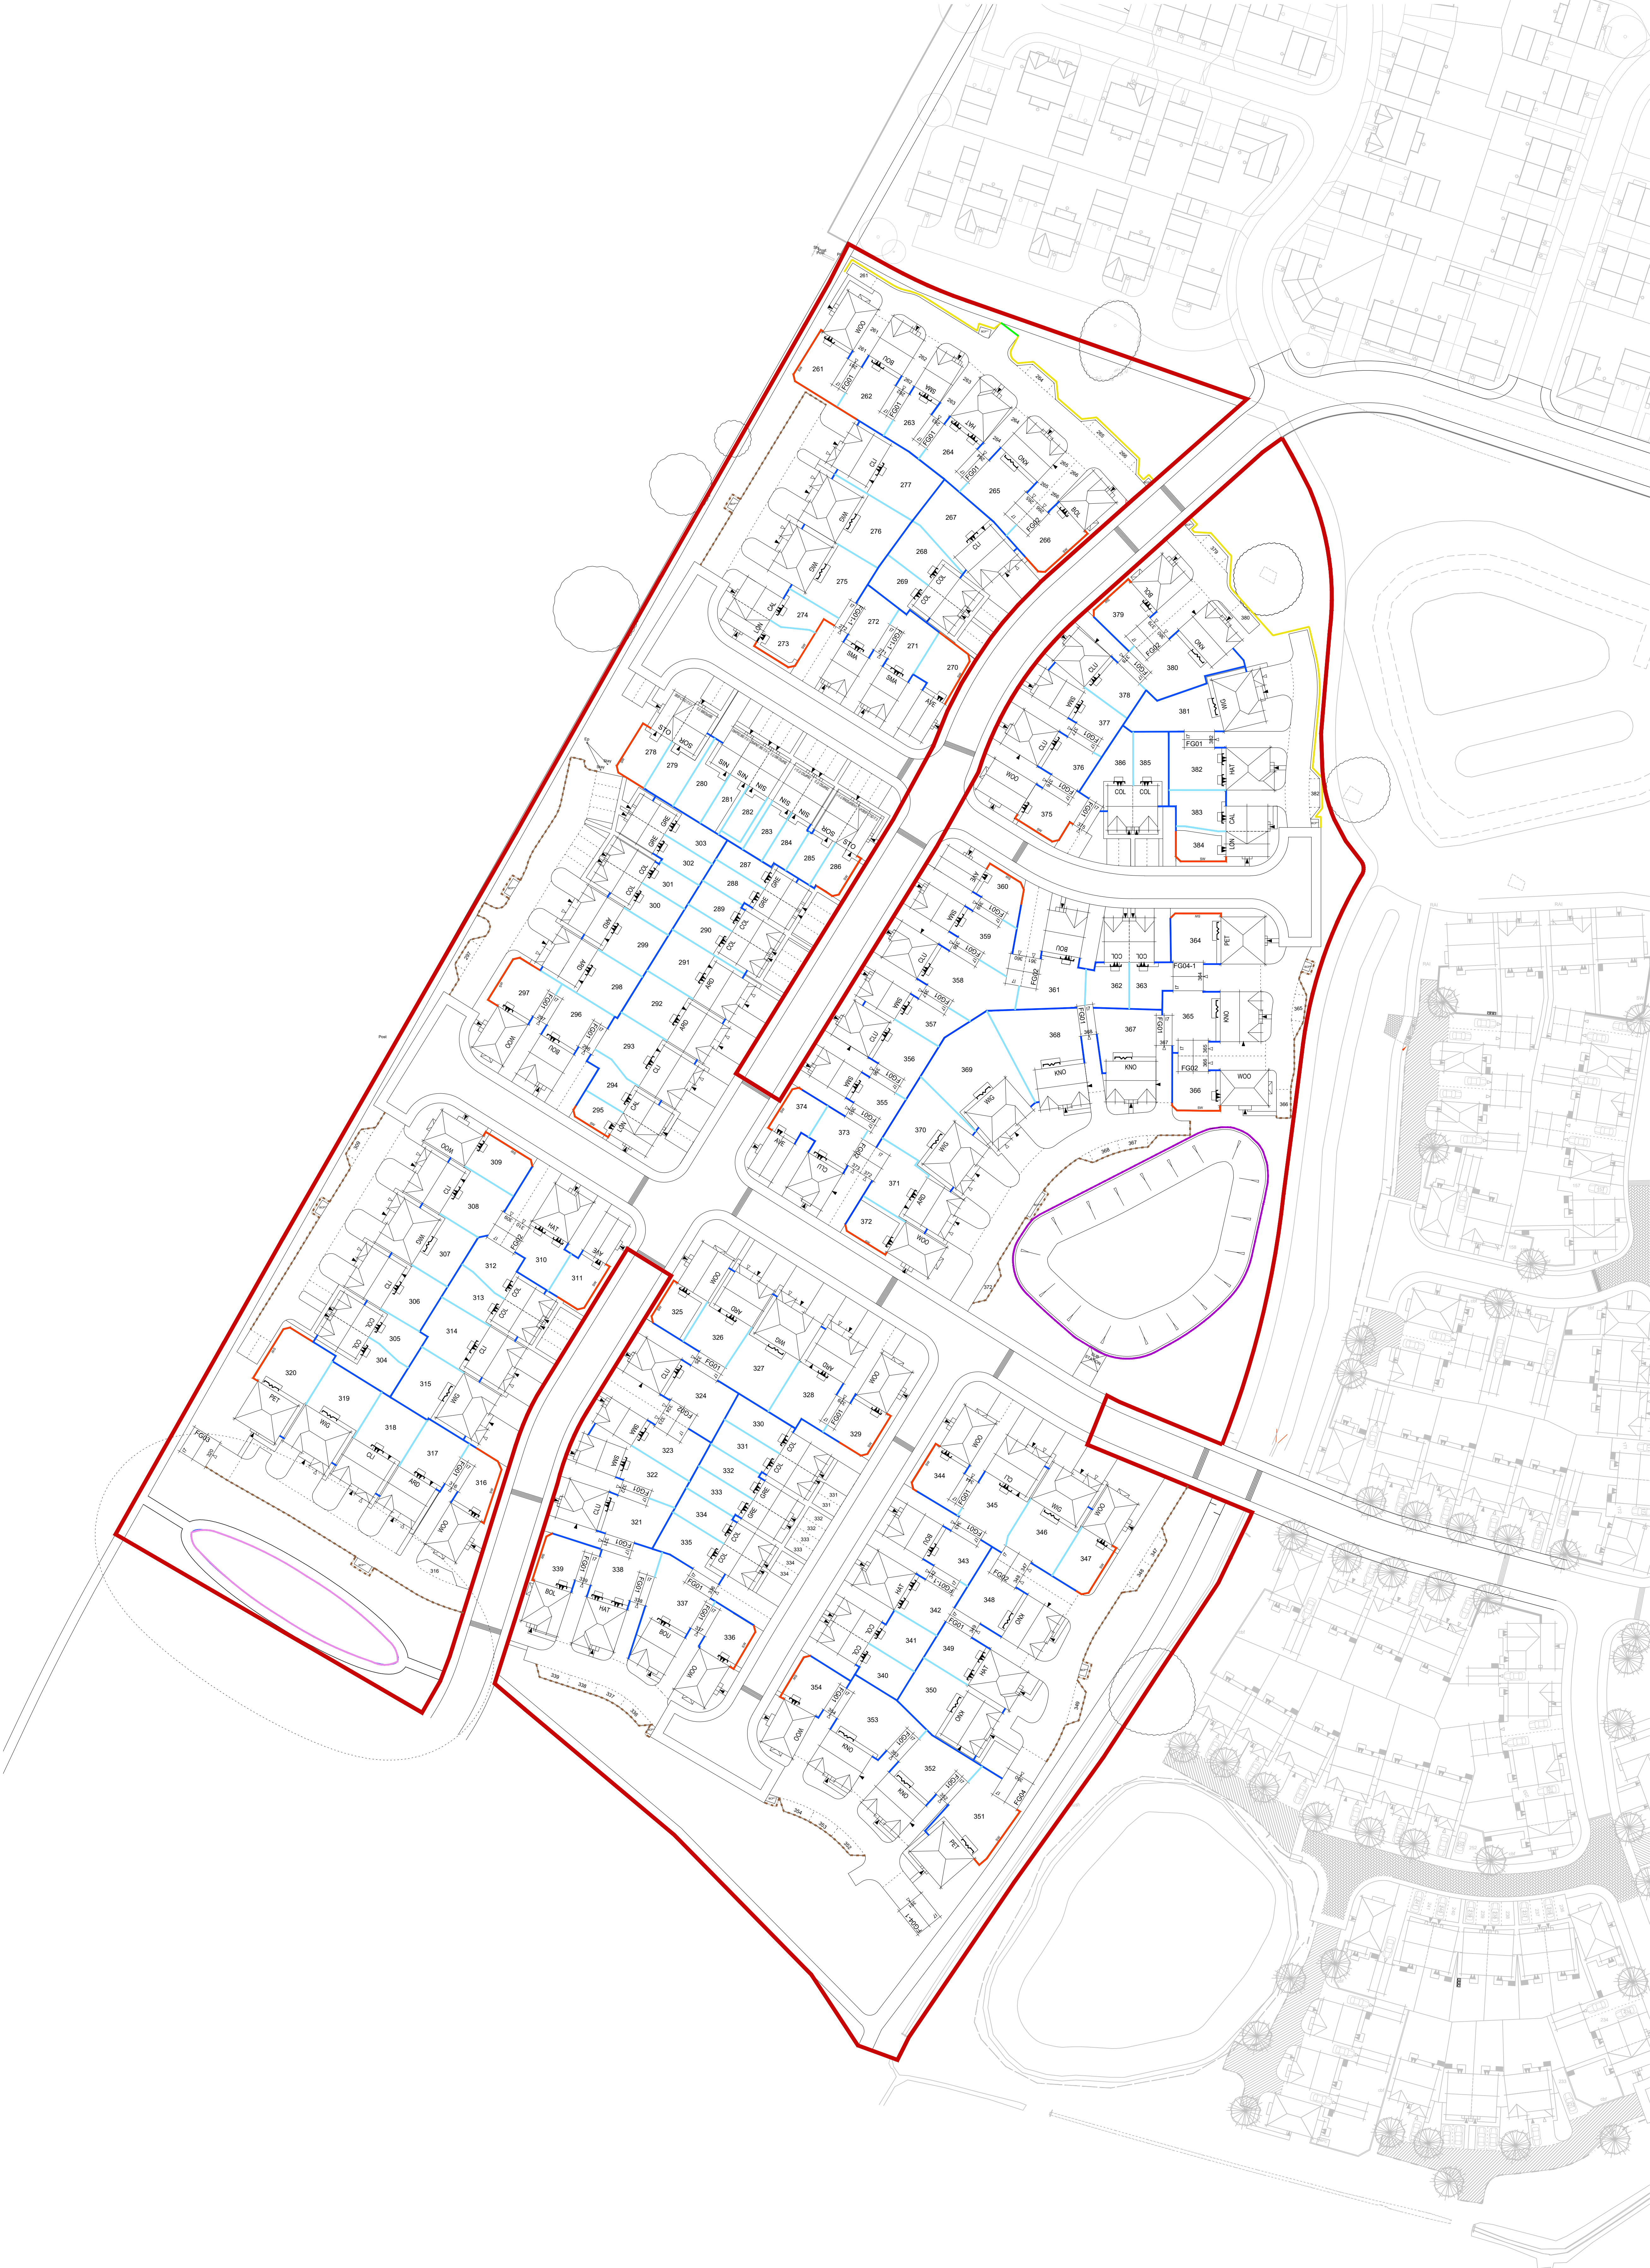

Revision		
A	Changed red line boundary to include raised beds due to planning.	07.07.25 GK
B	Handled plots 316, 317, 318, 326, 327, 328, 365, 366, 367, 368, 369 at request of engineers to avoid retaining walls.	14.07.25 GK
C	Updated to the new re-plan layout.	02.10.25 GK
D	Updated to the new re-plan layout.	23.10.25 AL
E	Updated in line with planning teams comments.	30.10.25 AL
F	Updated to new site layout. BW have been moved in a meter. Parking court has been removed.	04.11.25 GK
G	Updated knee rail around the bin collection points also added landscaping to the layout to show where hedges are a boundary treatment. Estate railing gate added for turning facility.	05.11.25 GK
H	Updated to show the sub station in the as built position.	29.01.26 GK
J	Updated to most recent site layout changing plot 320 garage.	05.02.26 GK
K	Updated to add knee rail on the private drives. Now showing rail around the LEAP.	27.02.26 GK


NORMANDY FIELDS
HINCKLEY
PHASE 7

Means of Enclosure

DATE: MAY 25
SCALE: 1:500 @ A0
DRAWN: GK
CHECKED: JE



Drawing No. EM136-SL-004K

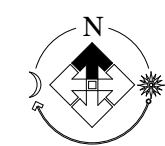

Normandy Fields, Hinckley - Phase 7