



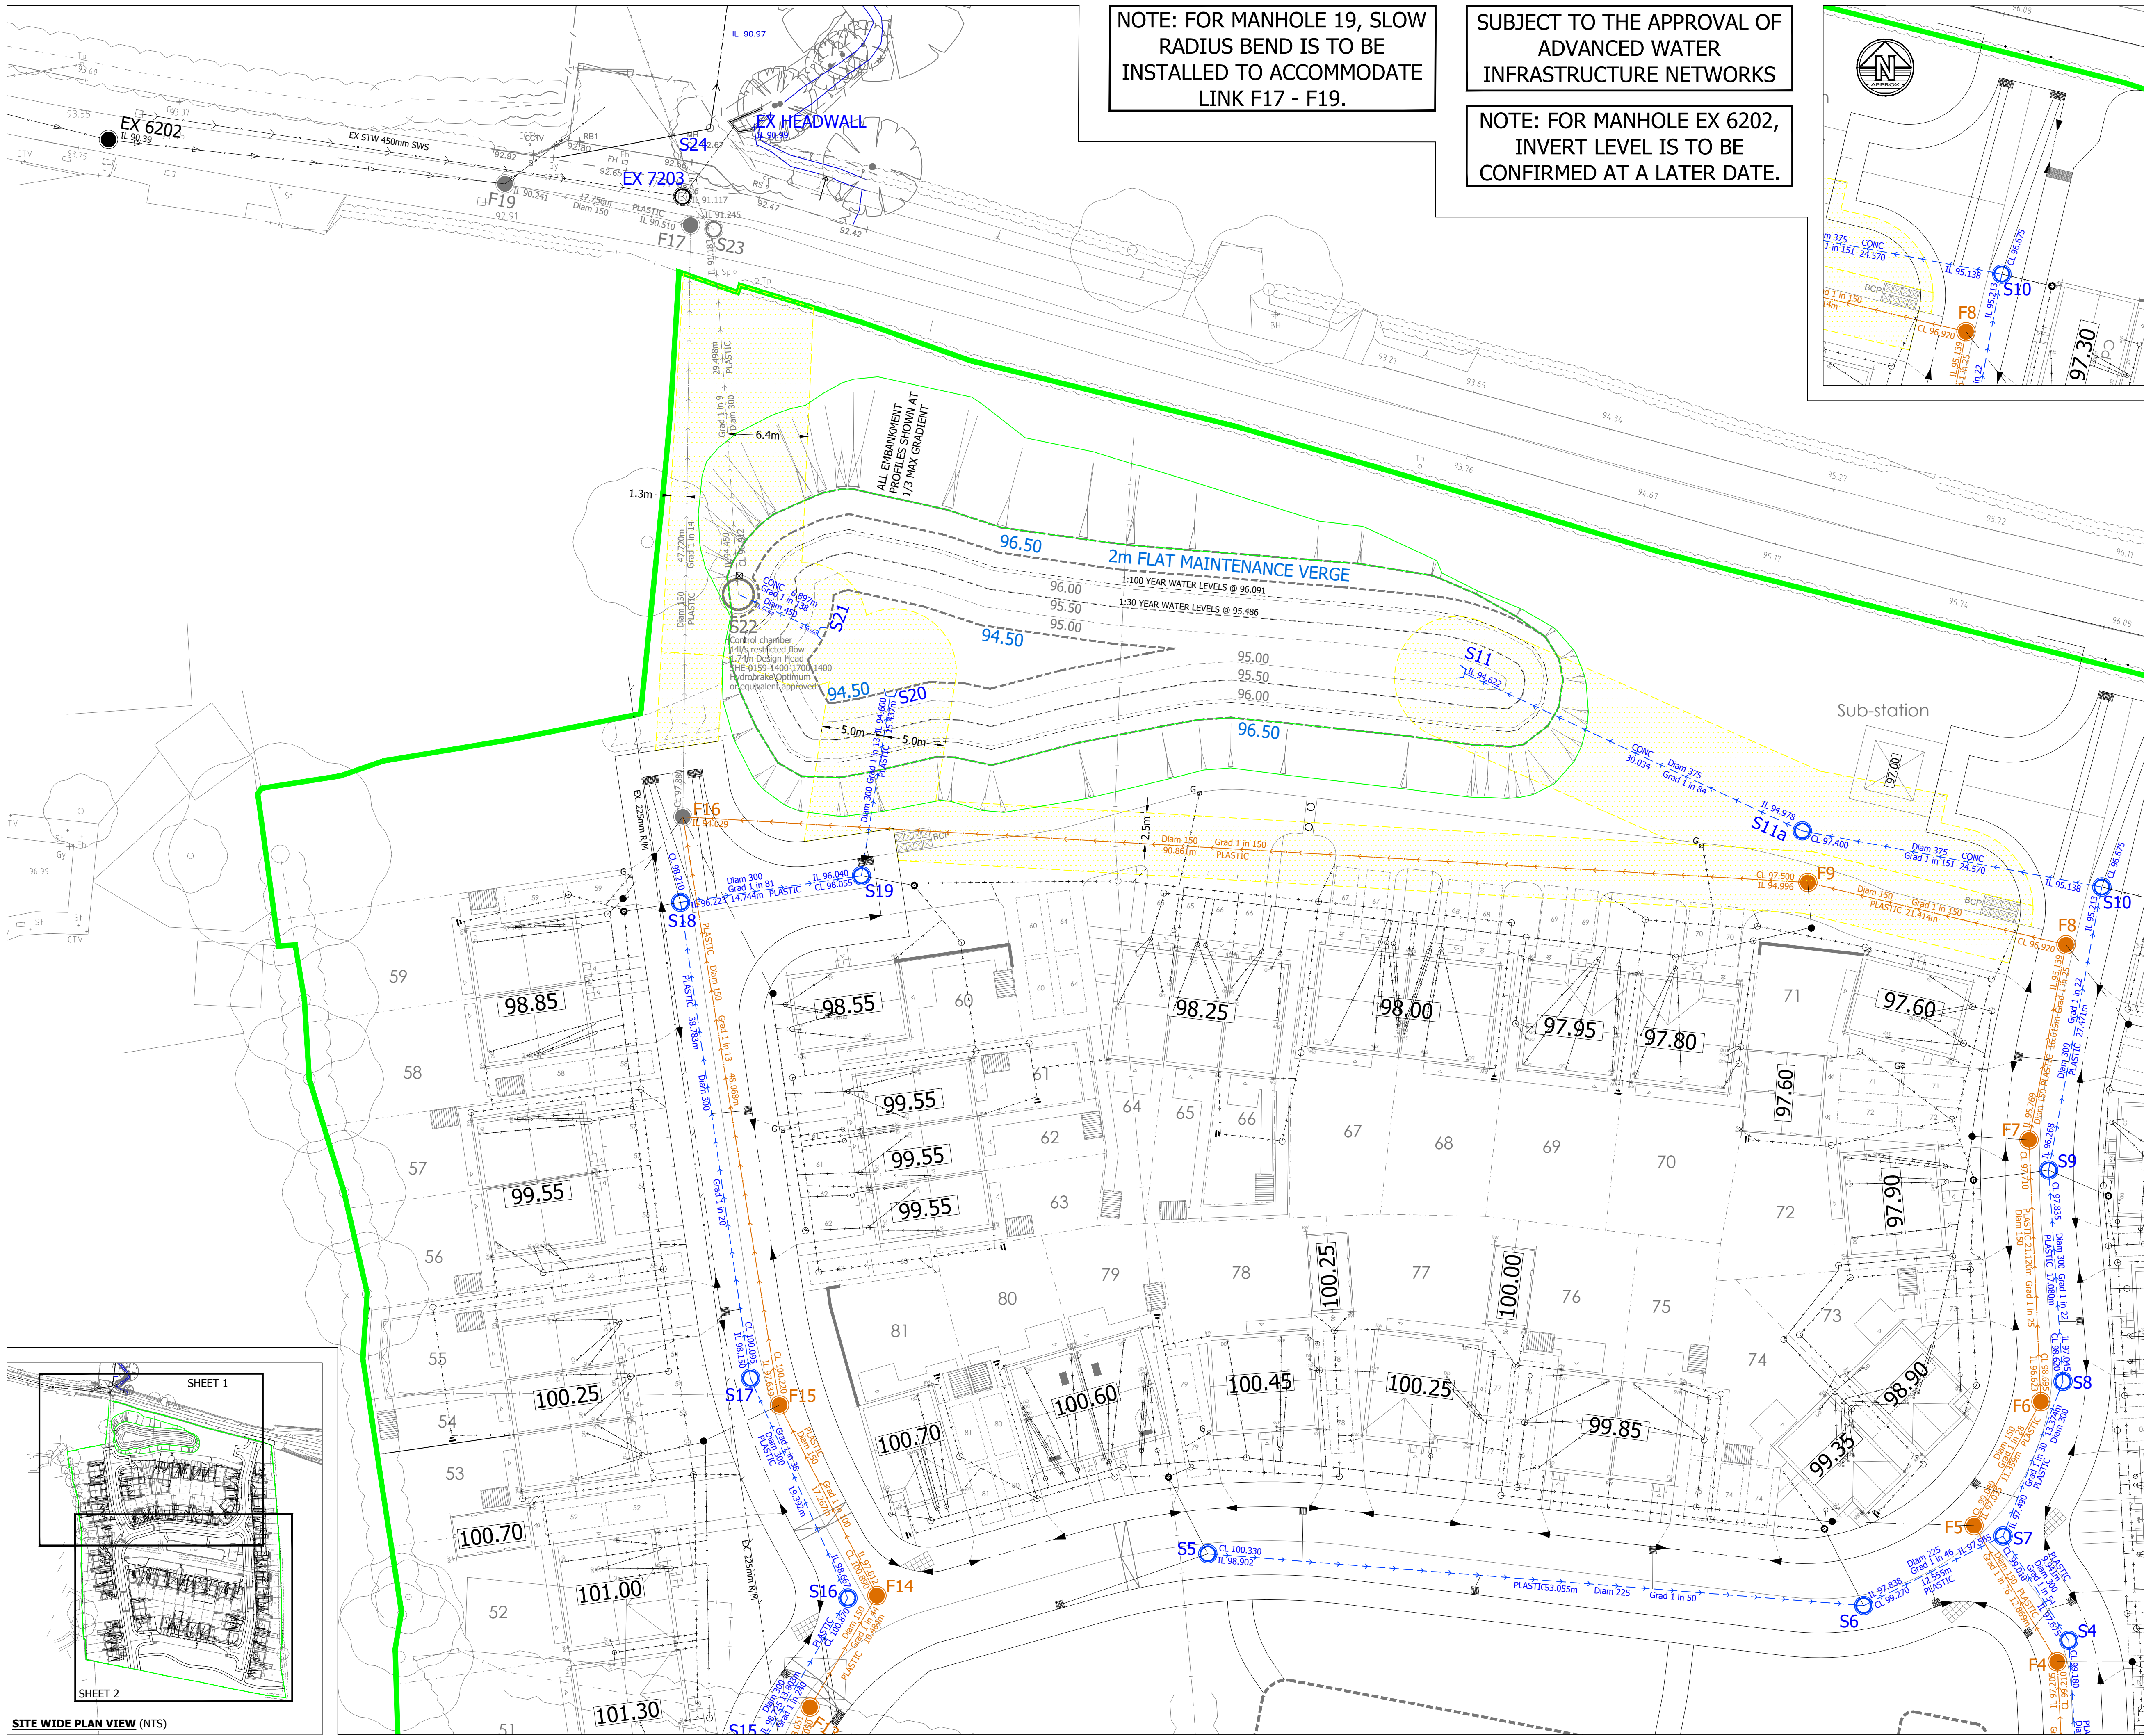

NOTE: FOR MANHOLE 19, SLOW RADIUS BEND IS TO BE INSTALLED TO ACCOMMODATE LINK F17 - F19.

SUBJECT TO THE APPROVAL OF ADVANCED WATER INFRASTRUCTURE NETWORKS

NOTE: FOR MANHOLE EX 6202, INVERT LEVEL IS TO BE CONFIRMED AT A LATER DATE.

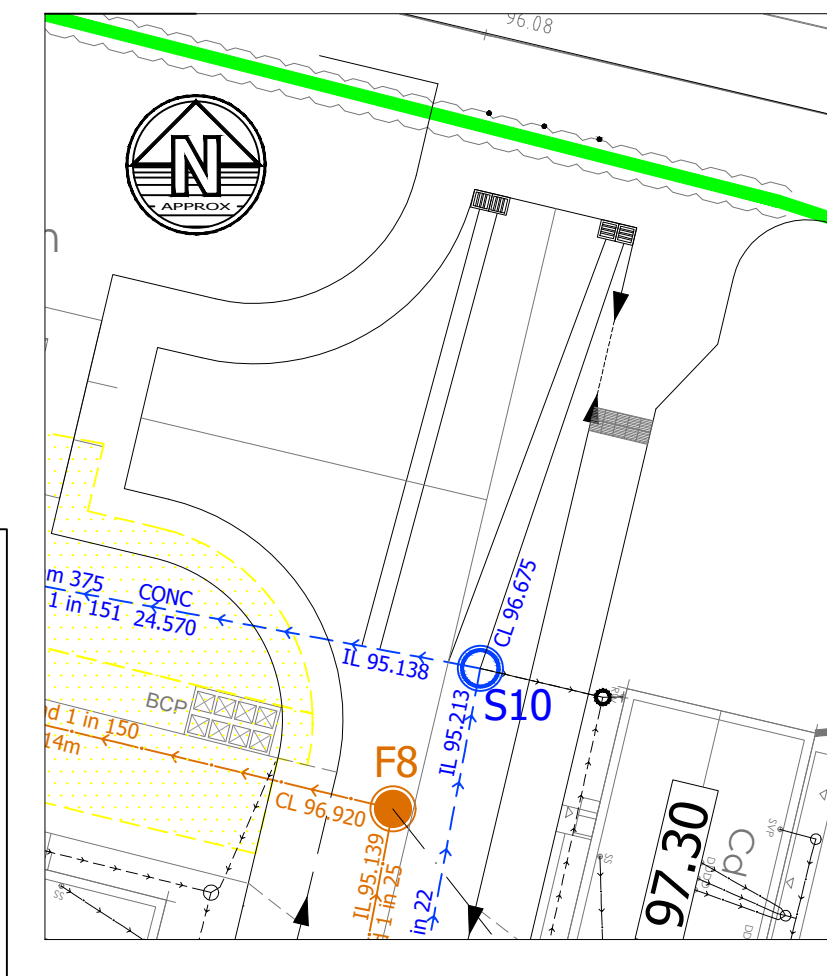

1. DO NOT SCALE FROM THIS DRAWING. IF IN DOUBT CONTACT TRAVIS BAKER LIMITED.
2. ALL DIMENSIONS ARE IN METRES UNLESS OTHERWISE NOTED.
3. THIS DRAWING IS TO BE READ IN CONJUNCTION WITH ALL OTHER RELEVANT DRAWINGS RELATING TO THIS PROJECT.
4. ALL DIMENSIONS SHOULD BE CHECKED ON SITE PRIOR TO CONSTRUCTION. ANY DISCREPANCIES SHOULD BE IMMEDIATELY NOTIFIED IN WRITING TO TRAVIS BAKER LIMITED.
5. THE CONTRACTOR SHALL PRIOR TO CONSTRUCTION CHECK AND VERIFY THAT THE DETAILS SHOWN ON THIS DRAWING ARE FULLY COMPATIBLE WITH ANY AS CONSTRUCTED DIMENSIONS OR LEVELS. ANY DISCREPANCIES TO BE REPORTED IMMEDIATELY IN WRITING TO TRAVIS BAKER LIMITED.
6. THIS DRAWING HAS BEEN PREPARED FOR THE EXCLUSIVE USE OF THE COMMISSIONING PARTY AND UNLESS AGREED IN WRITING BY TRAVIS BAKER LIMITED NO OTHER PARTY MAY USE OR RELY ON ITS CONTENTS. NO LIABILITY IS ACCEPTED BY TRAVIS BAKER LIMITED FOR ANY USE OF THIS DRAWING OTHER THAN FOR THE PURPOSE FOR WHICH IT WAS ORIGINALLY PREPARED.
7. IT SHOULD BE NOTED THAT THIS DRAWING MAY INCLUDE DATA PROVIDED BY THIRD PARTIES. NO LIABILITY IS ACCEPTED BY TRAVIS BAKER LIMITED AS TO THE ACCURACY OF THIS DATA.
8. THIS DRAWING SHALL NOT BE REPRODUCED IN ANY WAY WITHOUT THE WRITTEN PERMISSION OF TRAVIS BAKER LIMITED.

- KEY**
- ADOPTABLE STORM SEWER
 - ADOPTABLE FOUL SEWER
 - COVER LEVEL
 - INVERT LEVEL
 - AS BUILT STORM SEWER
 - AS BUILT FOUL SEWER
 - S185 SEWER DIVERSION
 - FOUL LATERAL
 - STORM LATERAL
 - HIGHWAY GULLY
 - EXISTING FW SEWER
 - EXISTING SW SEWER
 - EXISTING RISING MAIN
 - S104 EASEMENT
 - SITE BOUNDARY

R	AS BUILT MANHOLES SHOWN.	25.07.25	KG	TW
Q	SW OUTFALL LEVELS / CONTROL CHAMBER DETAILS ADDED.	07.05.25	KG	TW
P	S11, S20 & S21 HAVE MOVED POSITIONS. ALSO, BASIN DESIGN HAS BEEN ALTERED.	26.11.24	KG	TW
N	S11 & S20 MOVED POSITIONS. PERMANENT POND HAS BEEN REMOVED.	08.11.24	KG	TW
M	S11A MOVED & COVER LEVELS UPDATED.	31.10.24	KG	TW
L	COVER LEVELS ADDED.	24.10.24	KG	TW
K	PRIVATE DRAINAGE ADDED / BYPASS DELETED	21.10.24	KG	TW
J	S17 LATERAL REMOVED.	12.09.24	KG	TW
H	GULLIES G1A & G2A ADDED.	05.09.24	KG	TW
G	MANHOLE F19 REMOVED & MANHOLES F17 MOVED POSITIONS - NOTE REFERRING TO RISING MAIN ADDED.	08.08.24	KG	TW
F	MANHOLE POSITIONS CHANGED AND CP1 & CP2 ADDED.	20.06.24	ON	TW
E	BYPASS INVERT LEVELS ADDED.	10.05.24	KG	TW
D	EXISTING RISING MAIN SHOWN.	07.05.24	KG	TW
C	UPDATED TO SUIT NEW SITE LAYOUT.	19.10.23	ON	TW
B	POND REVISED.	03.03.22	GR	TW
A	REVISED TO SUIT NEW ROAD AND SITE LAYOUT.	07.02.22	GR	TW

Travis Baker
39 Storey Street
Lace Market
Nottingham
NG1 1LX

Transport Planning
Flood Risk and Drainage
Geo-Environmental
Civil and Structural Engineering

Nottingham Telephone:
0115 896 6655
info@travisbaker.co.uk
www.travisbaker.co.uk

PROJECT
THURLASTON LANE,
EARL SHILTON

TITLE
S104 DRAINAGE LAYOUT -
SHEET 1 OF 2

DRAWN GR	AUTHORISED TW	SCALE 1:250@A1	DATE 13.01.22
-------------	------------------	-------------------	------------------

PROJECT NO. 21246	DRAWING NO. 103	REV R
----------------------	--------------------	----------

STATUS.
PRELIMINARY

COPYRIGHT TRAVIS BAKER LIMITED. ALL RIGHTS RESERVED.