


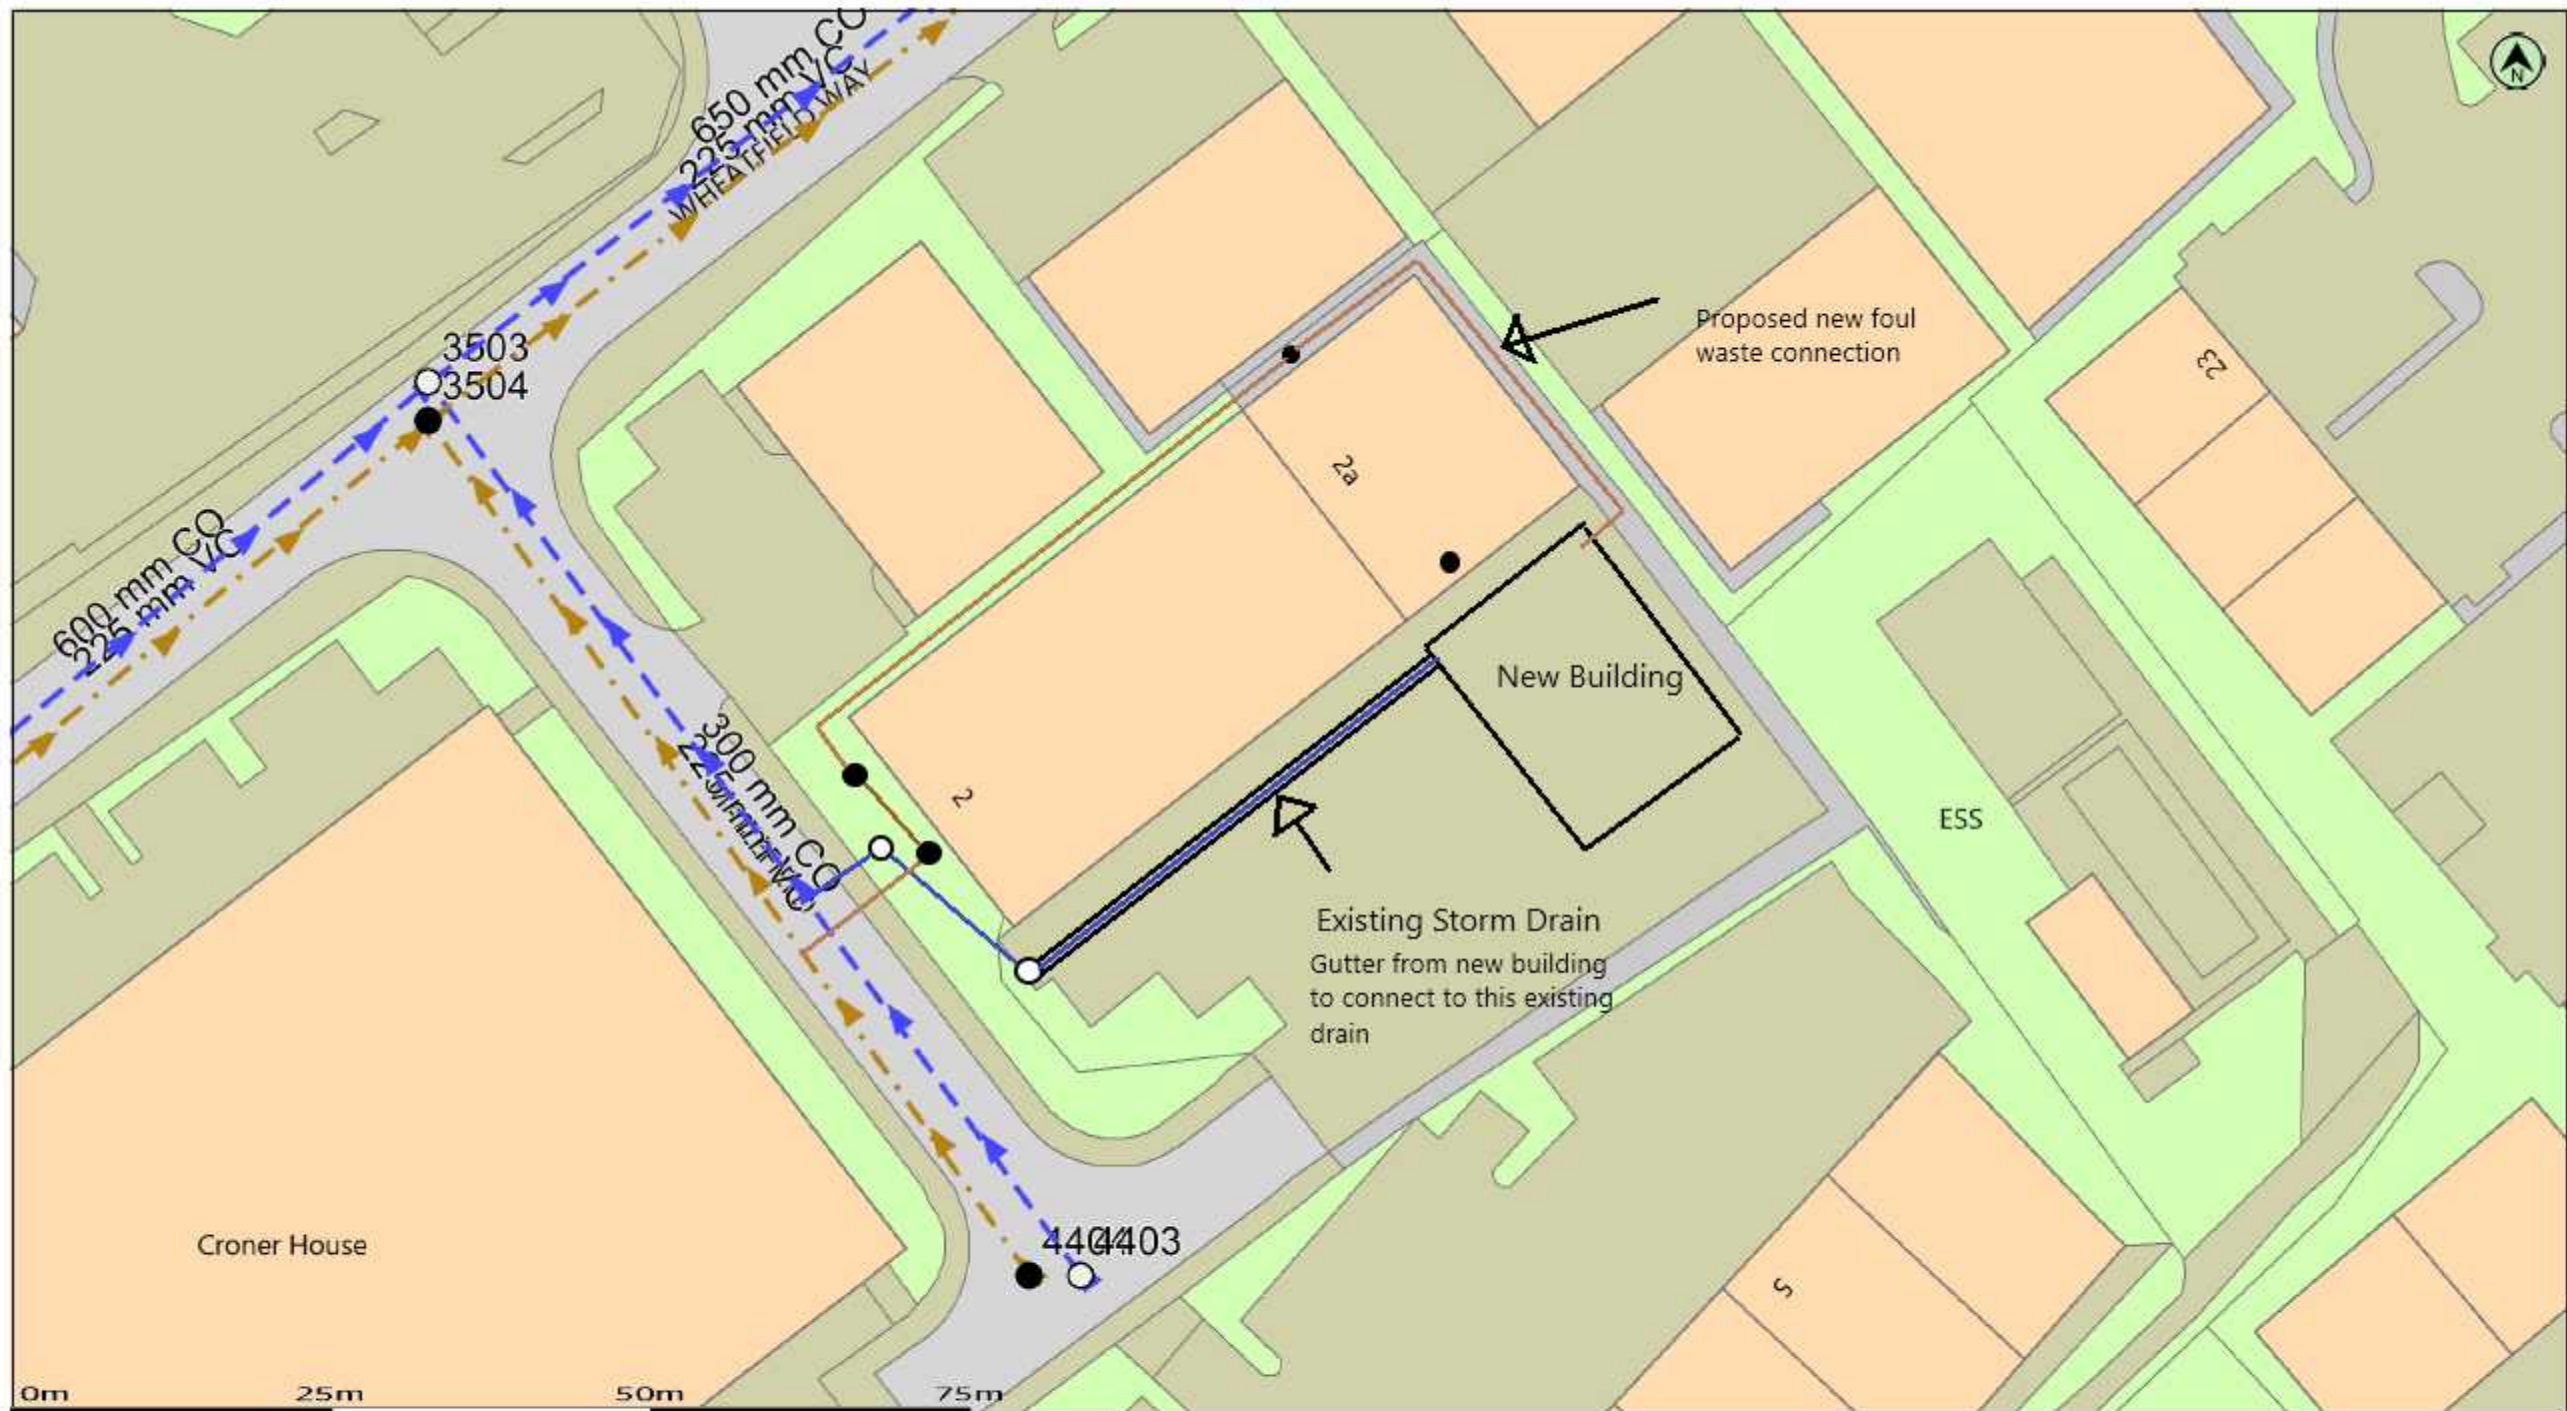

(c) Crown copyright and database rights 2025 Ordnance Survey AC0000808122

Date: 09/01/25

Scale: 1:500

Map Centre: 442449,295538

Data updated: 14/12/24

Our Ref: 1656076 - 3

Wastewater Plan A3
Powered by digdat

Do not scale off this map. The plan and any information supplied with it is furnished as a general guide, is only valid at the date of issue and no warranty as to its correctness is given or implied. In particular this plan and any information shown on it must not be relied upon in the event of any development or works (including but not limited to excavations) in the vicinity of SEVERN TRENT WATER assets or for the purposes of determining the suitability of a point of connection to the sewerage or distribution systems. Reproduction by permission of Ordnance Survey on behalf of HMSO. © Crown Copyright and database rights 2025. All rights reserved. Ordnance Survey licence number AC0000808122. Document users other than SEVERN TRENT WATER business users are advised that this document is provided for reference purpose only and is subject to copyright, therefore, no further copies should be made from it.

Public Foul Gravity/Lateral Drain
Public Combined Gravity/Lateral Drain
Public Surface Water Gravity/Lateral Drain
Pressure Foul
Pressure Combined
Pressure Surface Water

Highway Drain
Overflow Pipe
Disposal Pipe
Culverted Water Course
Pumping Station
Fitting

Manhole Foul
Manhole Surface
Abandoned Pipe
Chamber

Section 154 sewers are shown in green
Private sewers are shown in magenta

jake@mpengineering.co.uk

MP ENGINEERING UK LT

SEVERN
TRENT