
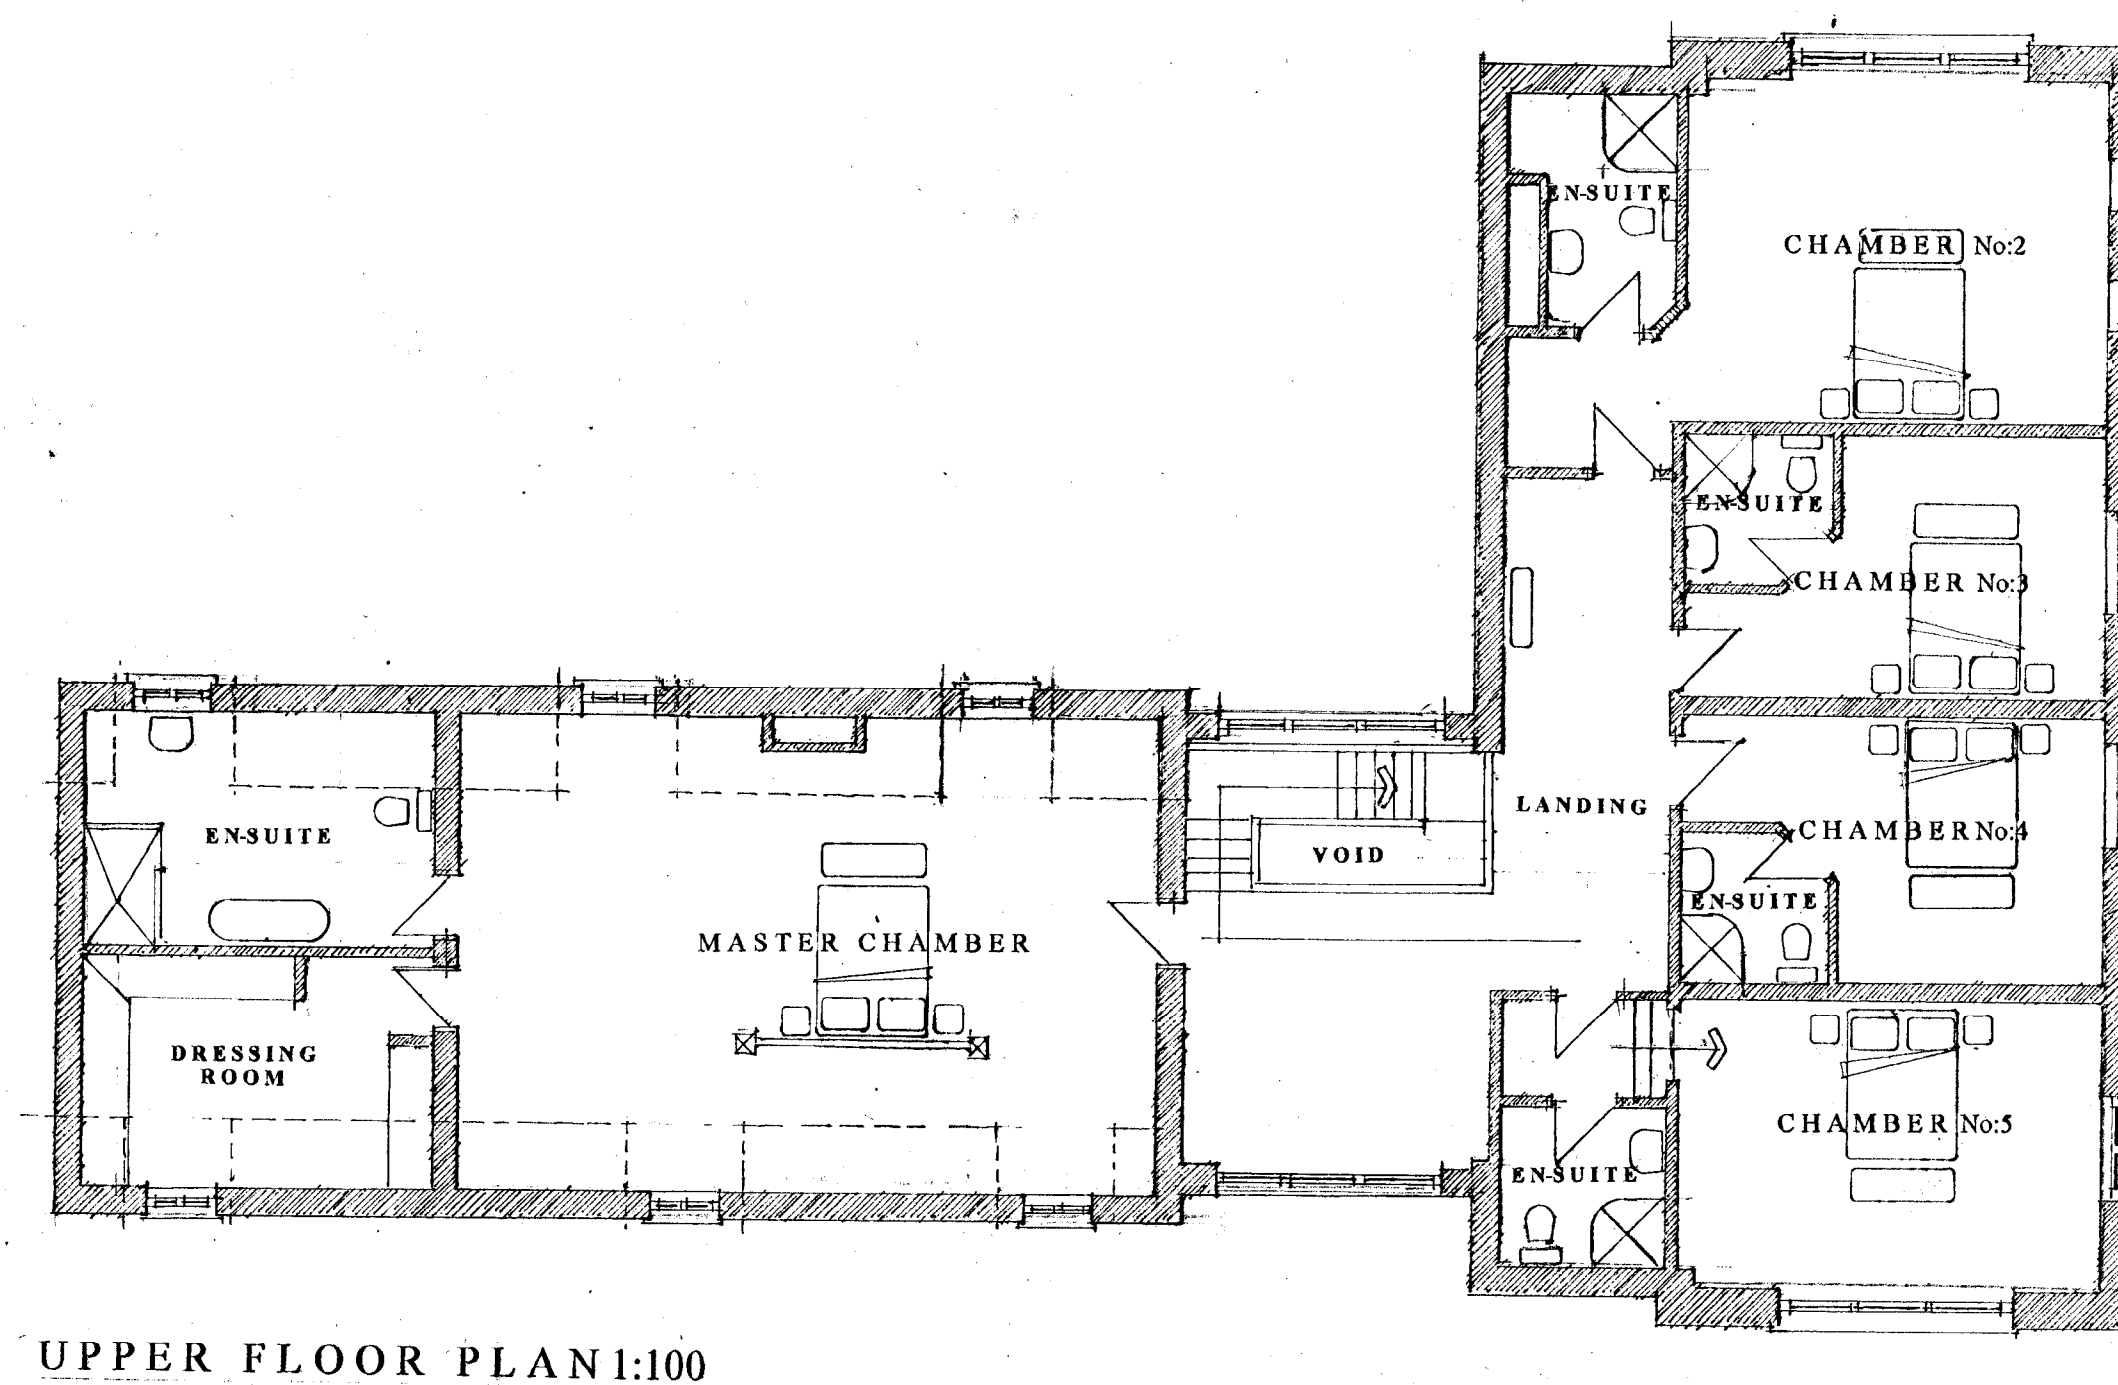
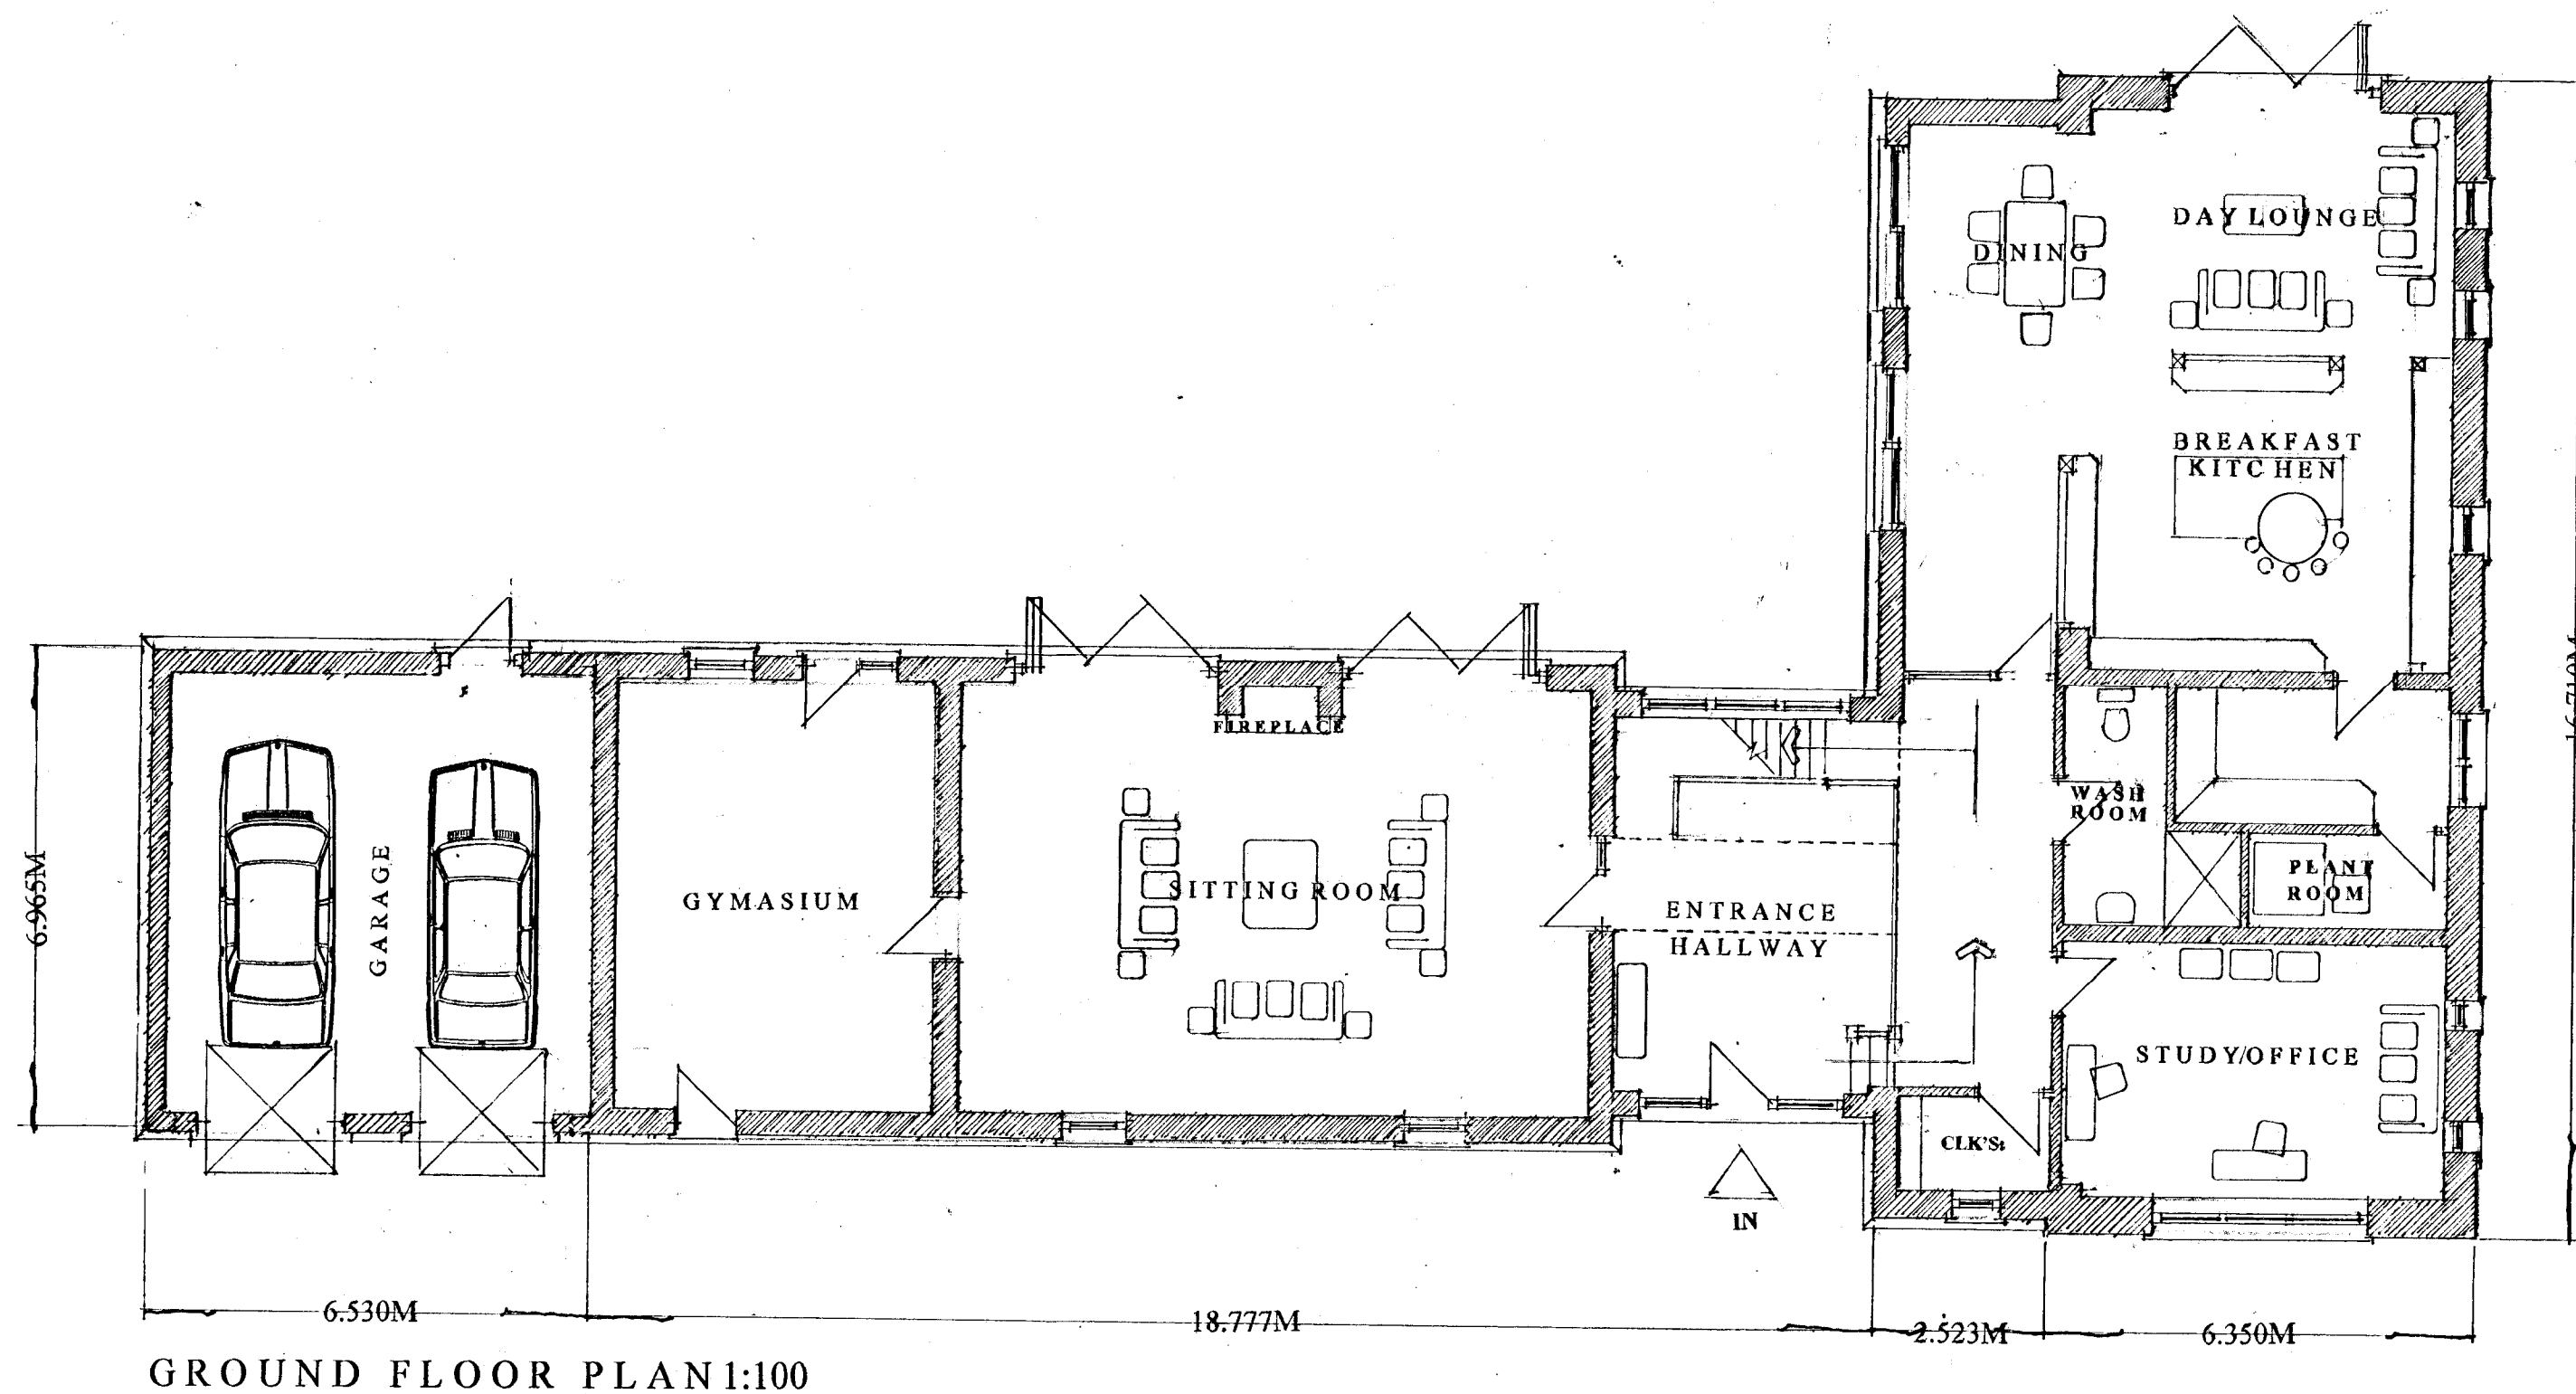
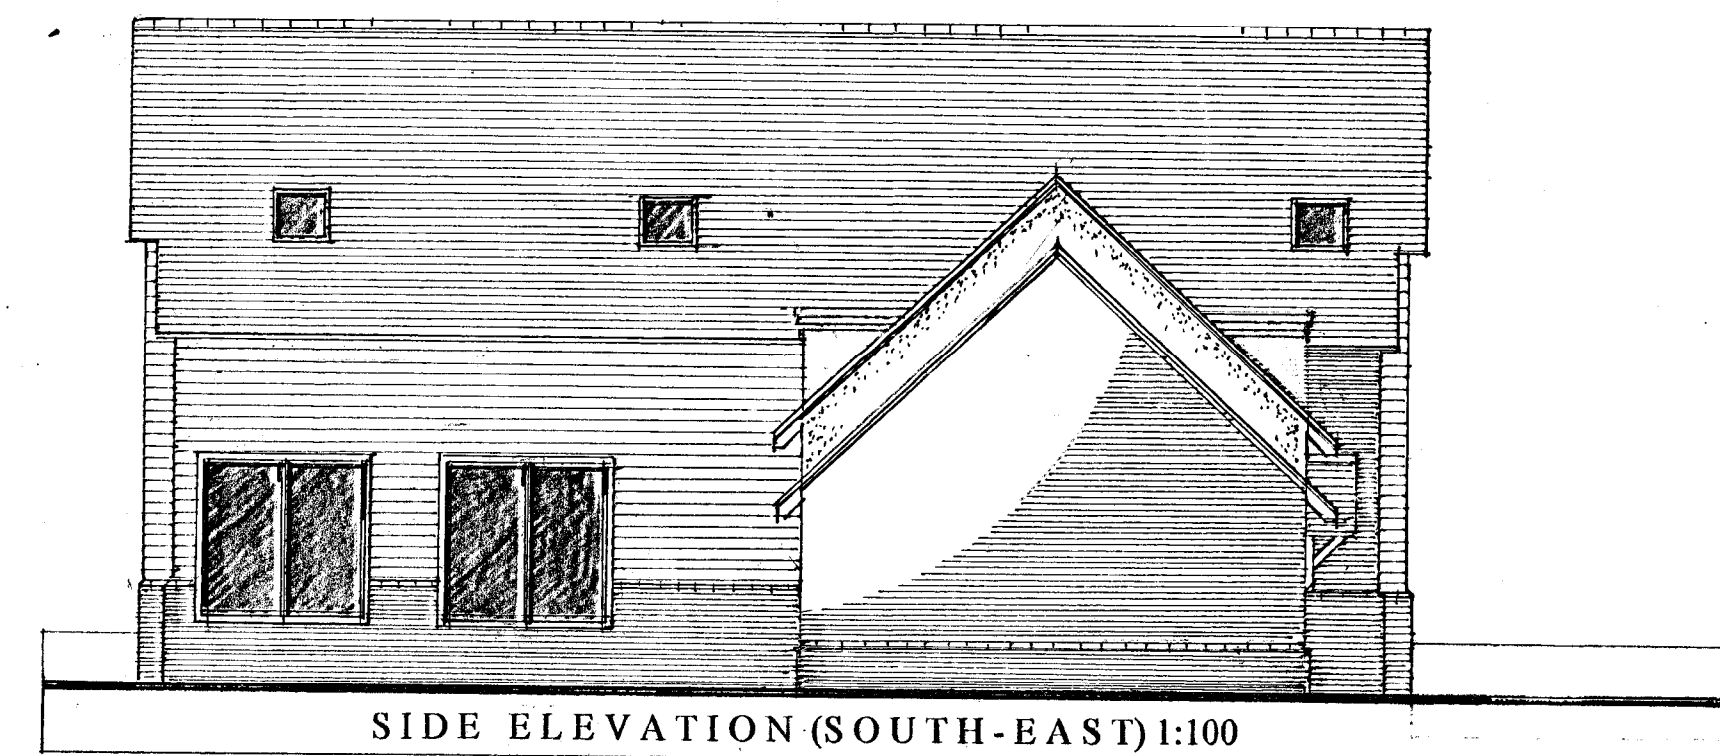
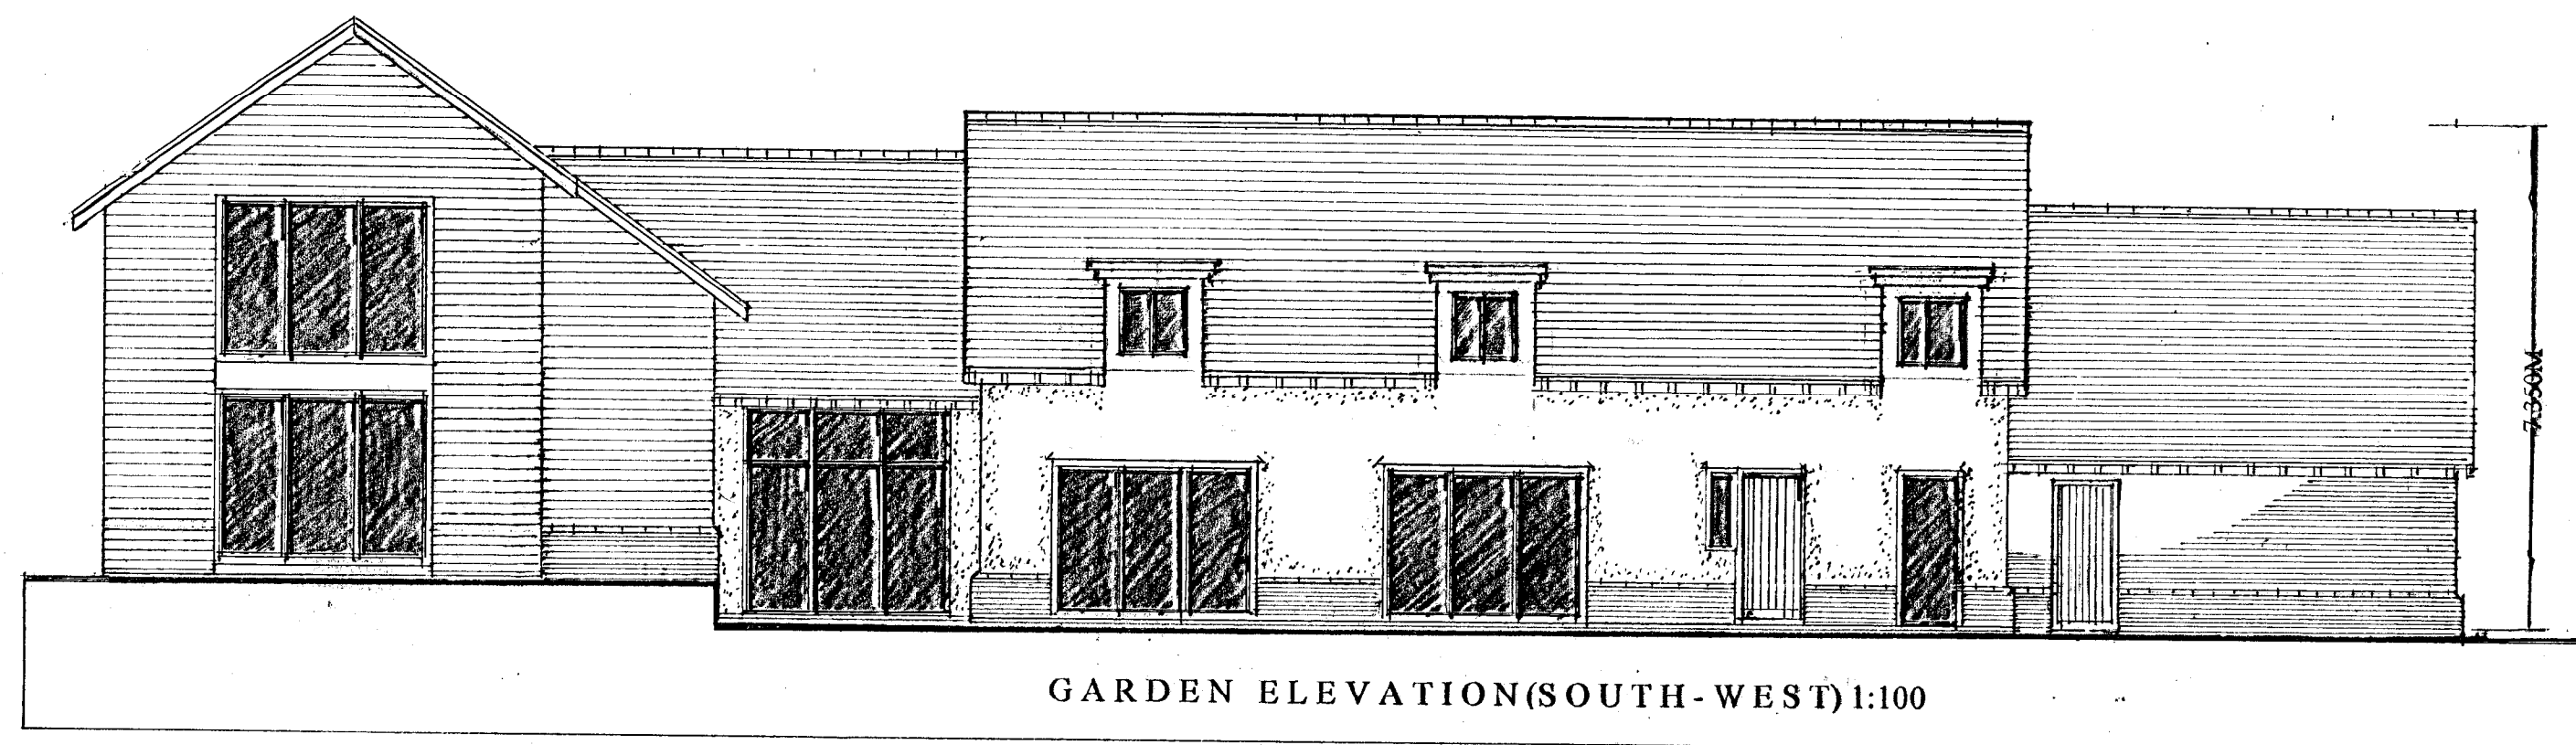
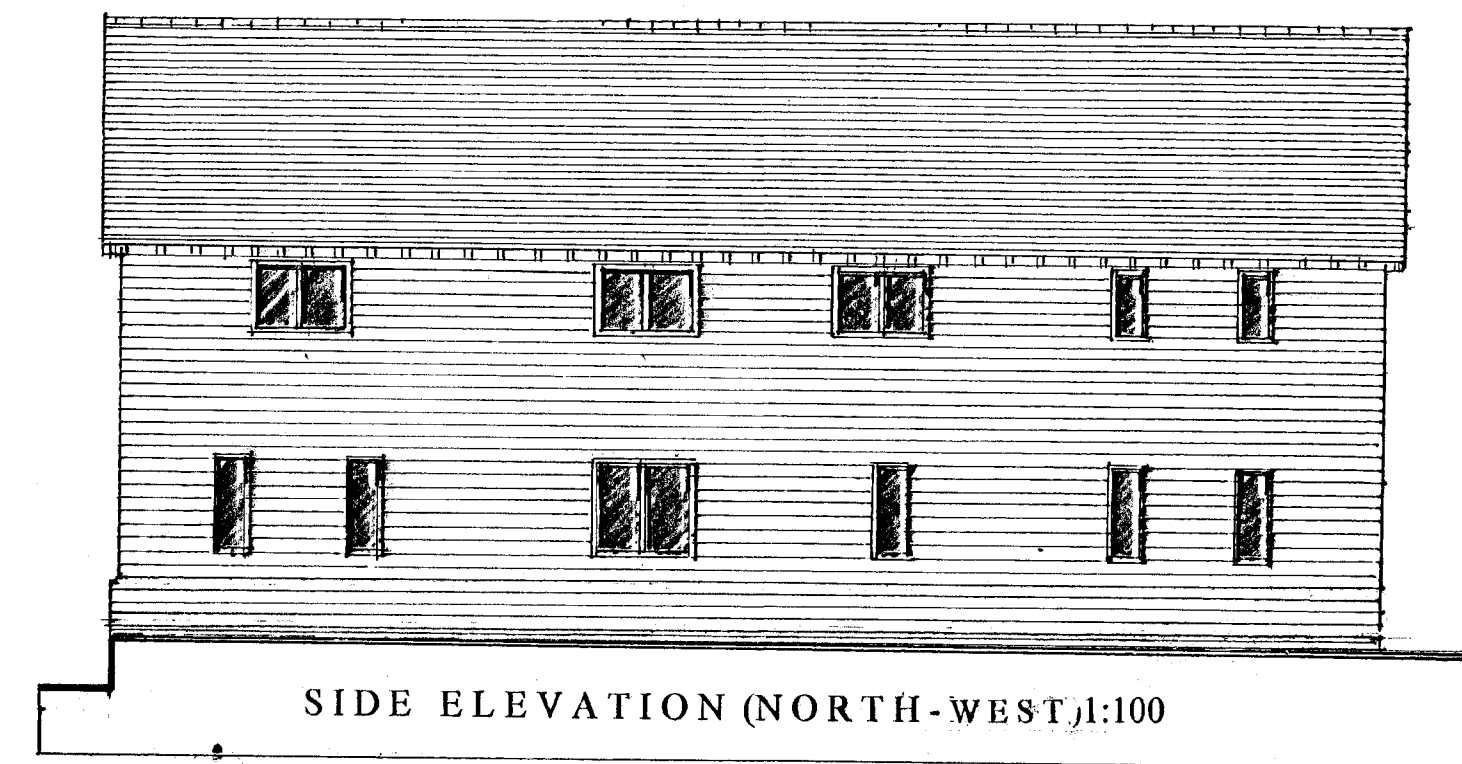


NOTE: PLEASE TAKE STATED DIMENSIONS IN PREFERENCE
OVER SCALED DIMENSIONS AS DISCREPANCIES MAY OCCUR
VIA THE ELECTRONIC SCANNING & PRINTING PROCEDURE.

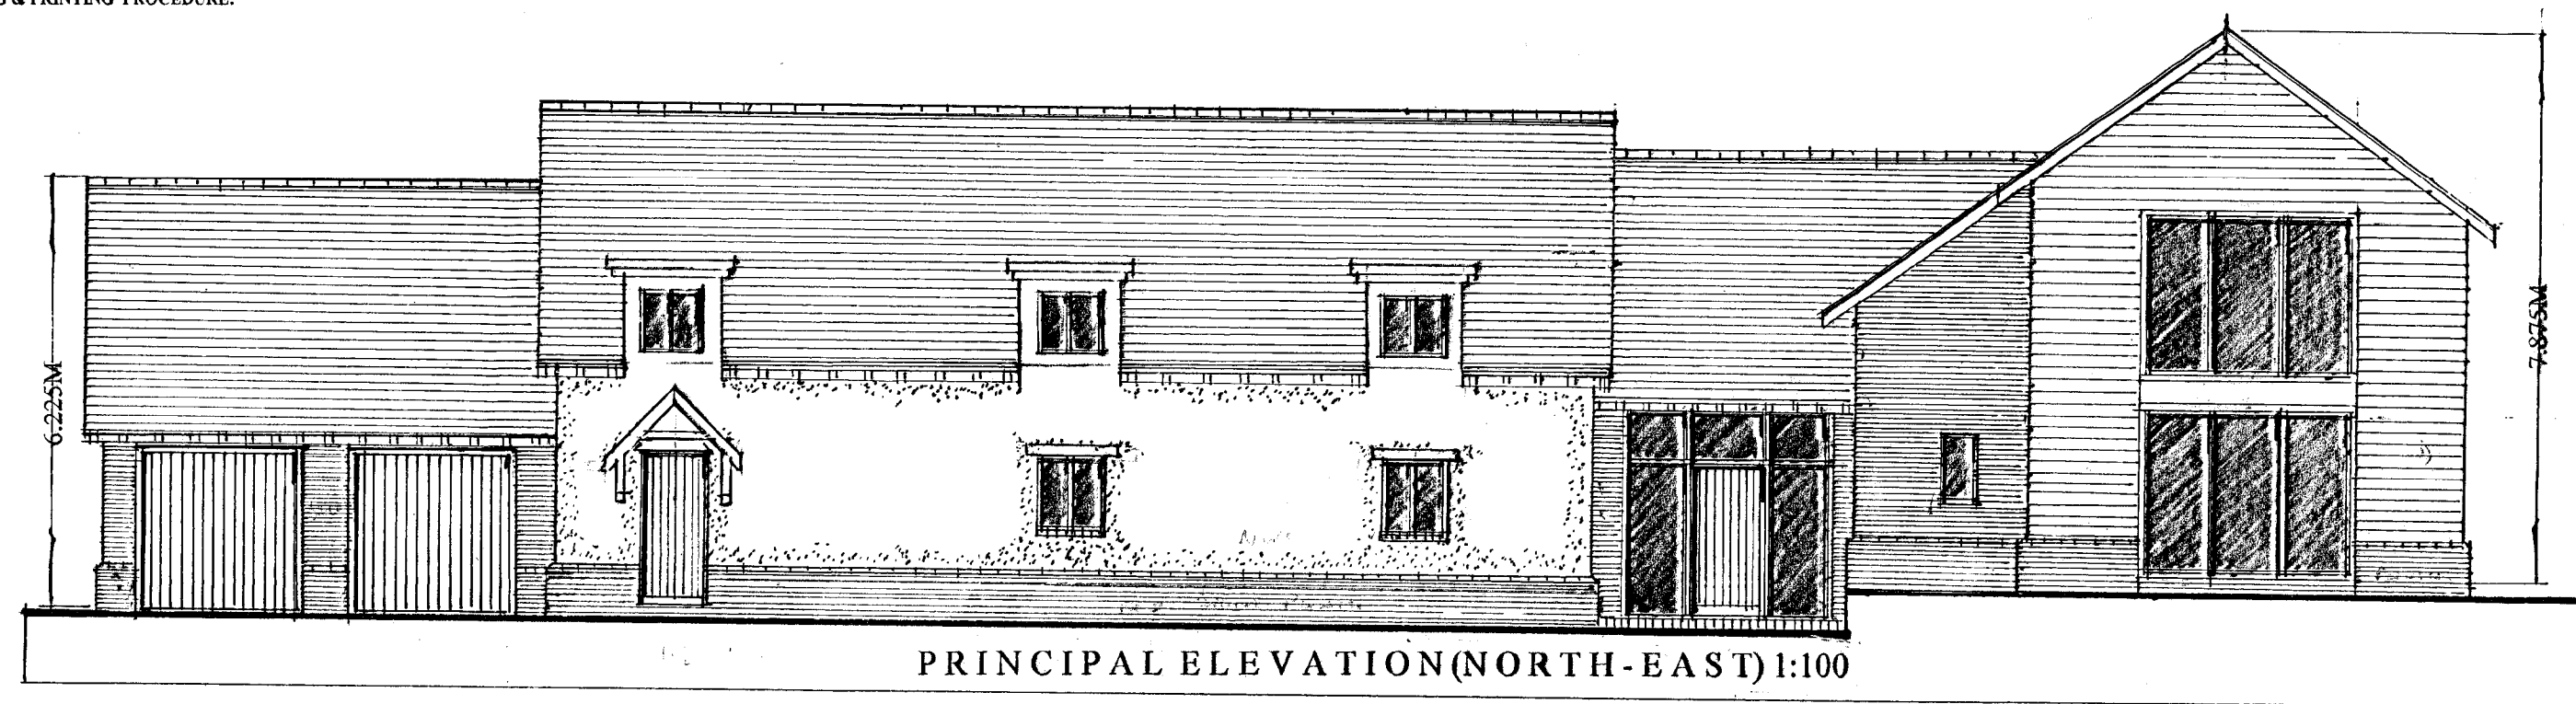

CLIENT:
Singular Homes Ltd.

PROJECT:
Retention of As-Built Residential
Conversion Scheme.(Unit No:4)
Hall Farm,
Orton-on-the-Hill,
Leicestershire.

DRAWING TITLE:
Existing Floor Plans & Elevations.

SCALE: 1:100 DATE: Aug'2025
DRWG.No: HMD/PD/0592/03.
© Copyright HMD/2025

HOUSEMARTIN
DESIGNS



© Copyright HMD.
(The Copyright, Designs & Patents Act 1988 - as amended)