






EXISTING SOUTH WEST ELEVATION
SCALE 1:100

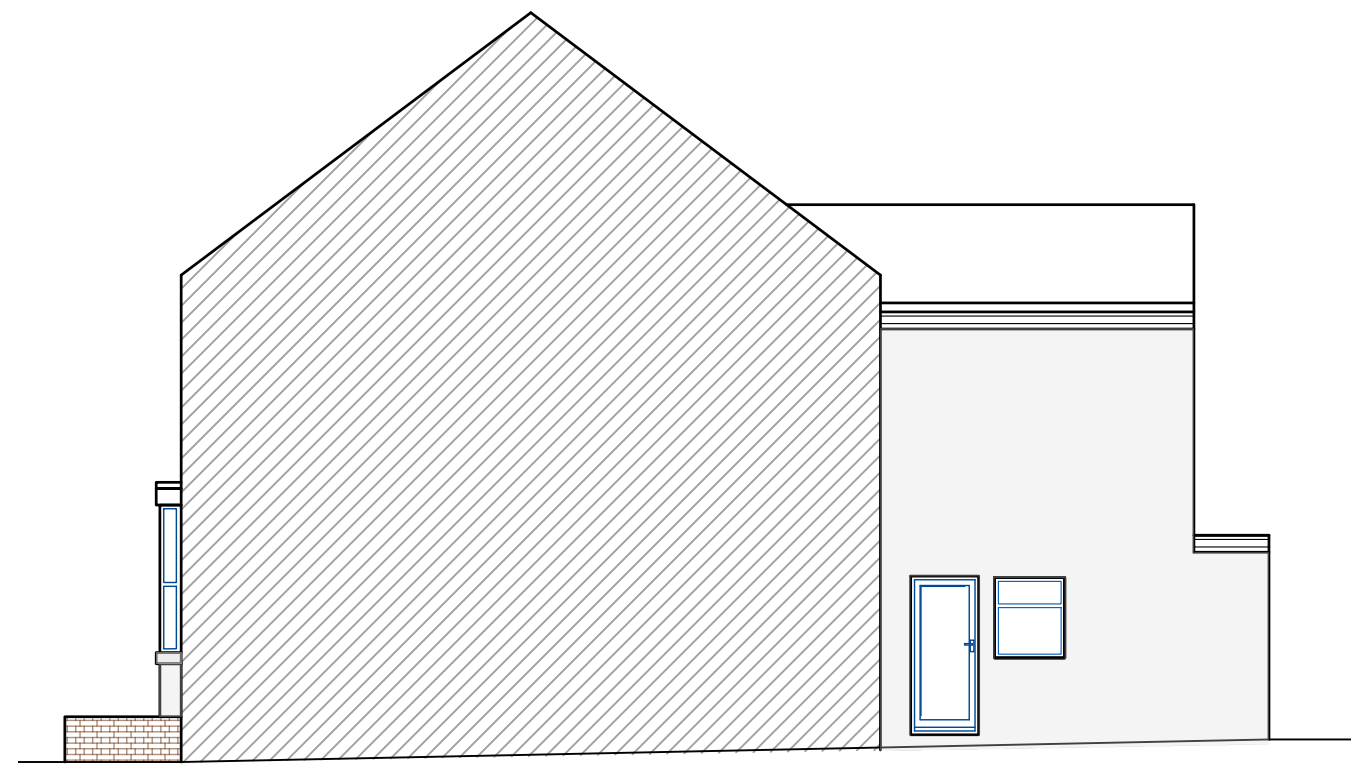


EXISTING NORTH EAST ELEVATION
SCALE 1:100

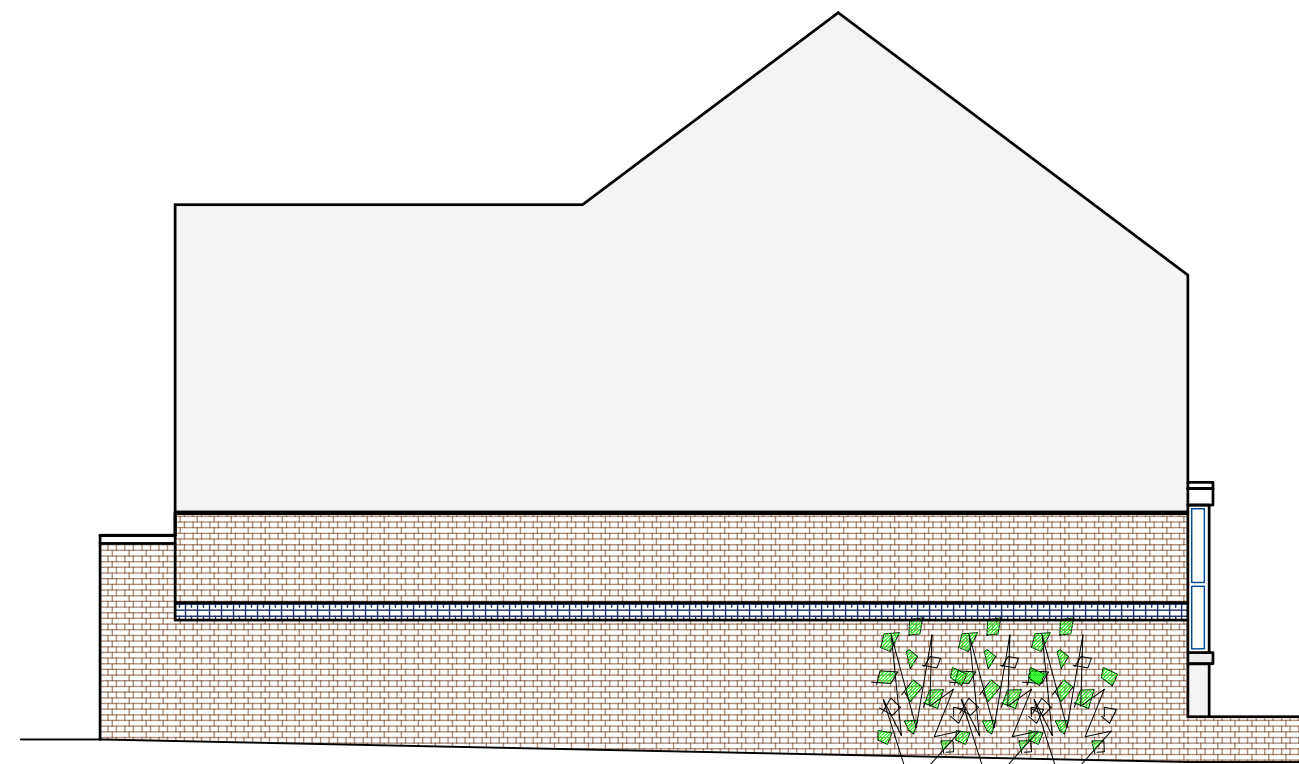


EXISTING REAR ELEVATION
SCALE 1:100

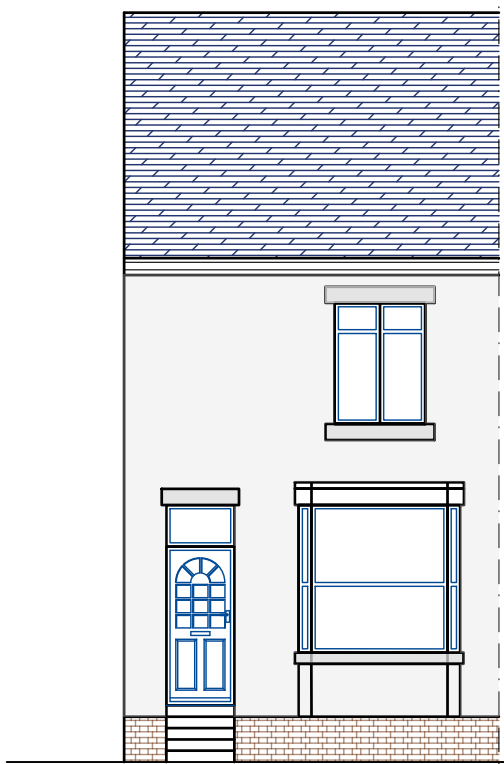


EXISTING FRONT ELEVATION
SCALE 1:100

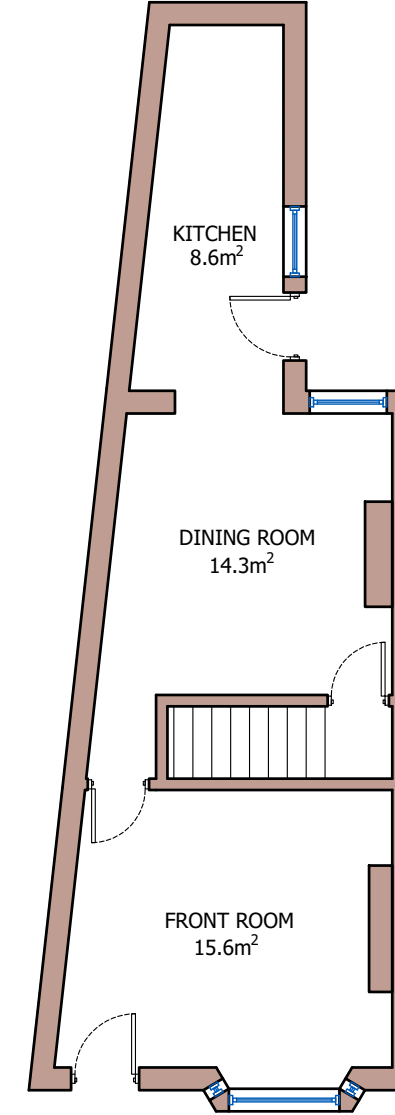


EXISTING GROUND FLOOR PLAN
SCALE 1:100

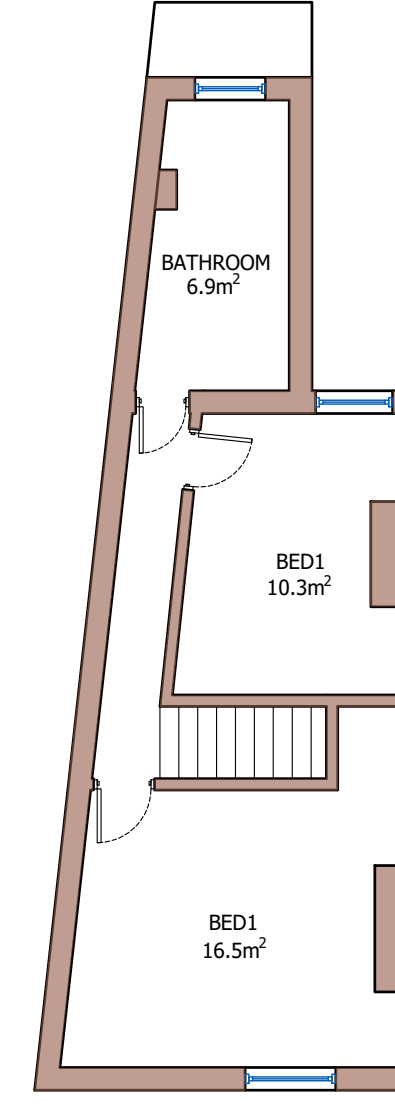


EXISTING FIRST FLOOR PLAN
SCALE 1:100

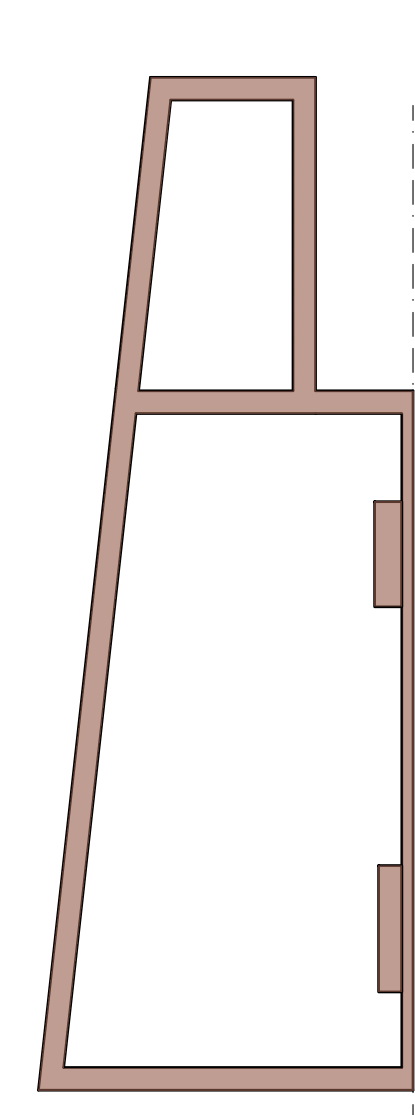


EXISTING LOFT PLAN
SCALE 1:100

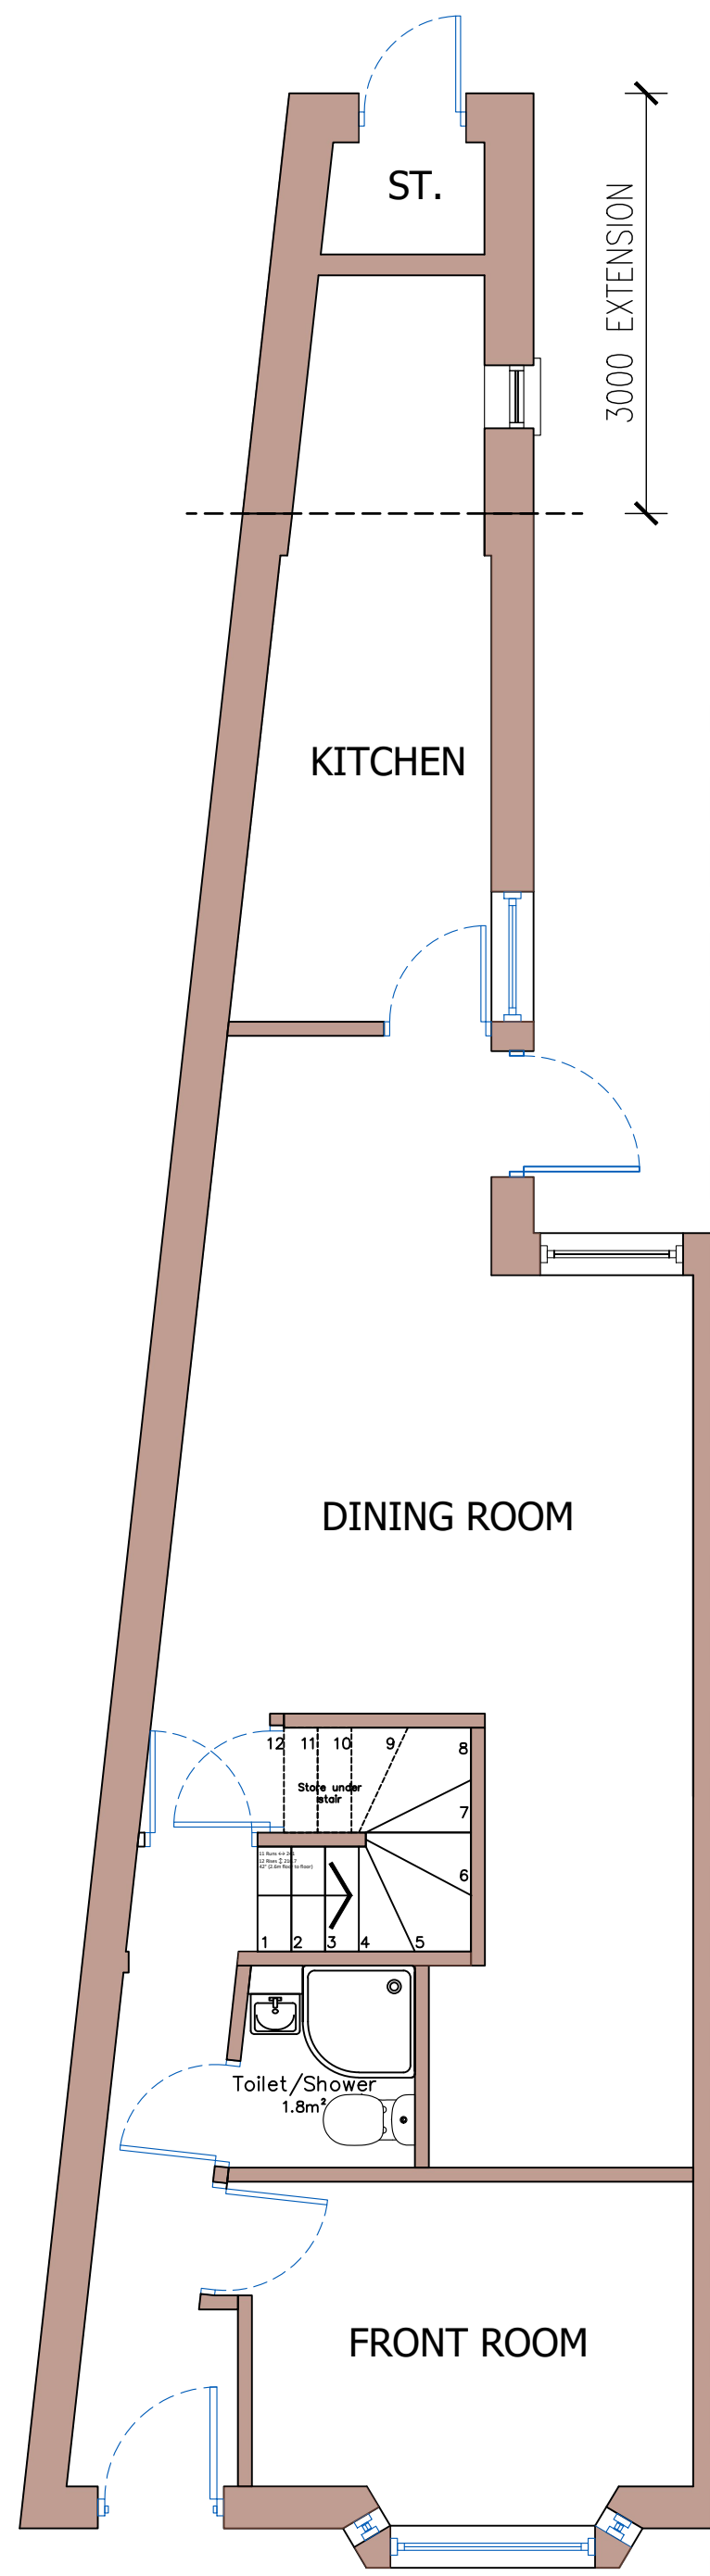


AS-BUILT GROUND FLOOR PLAN
SCALE 1:50

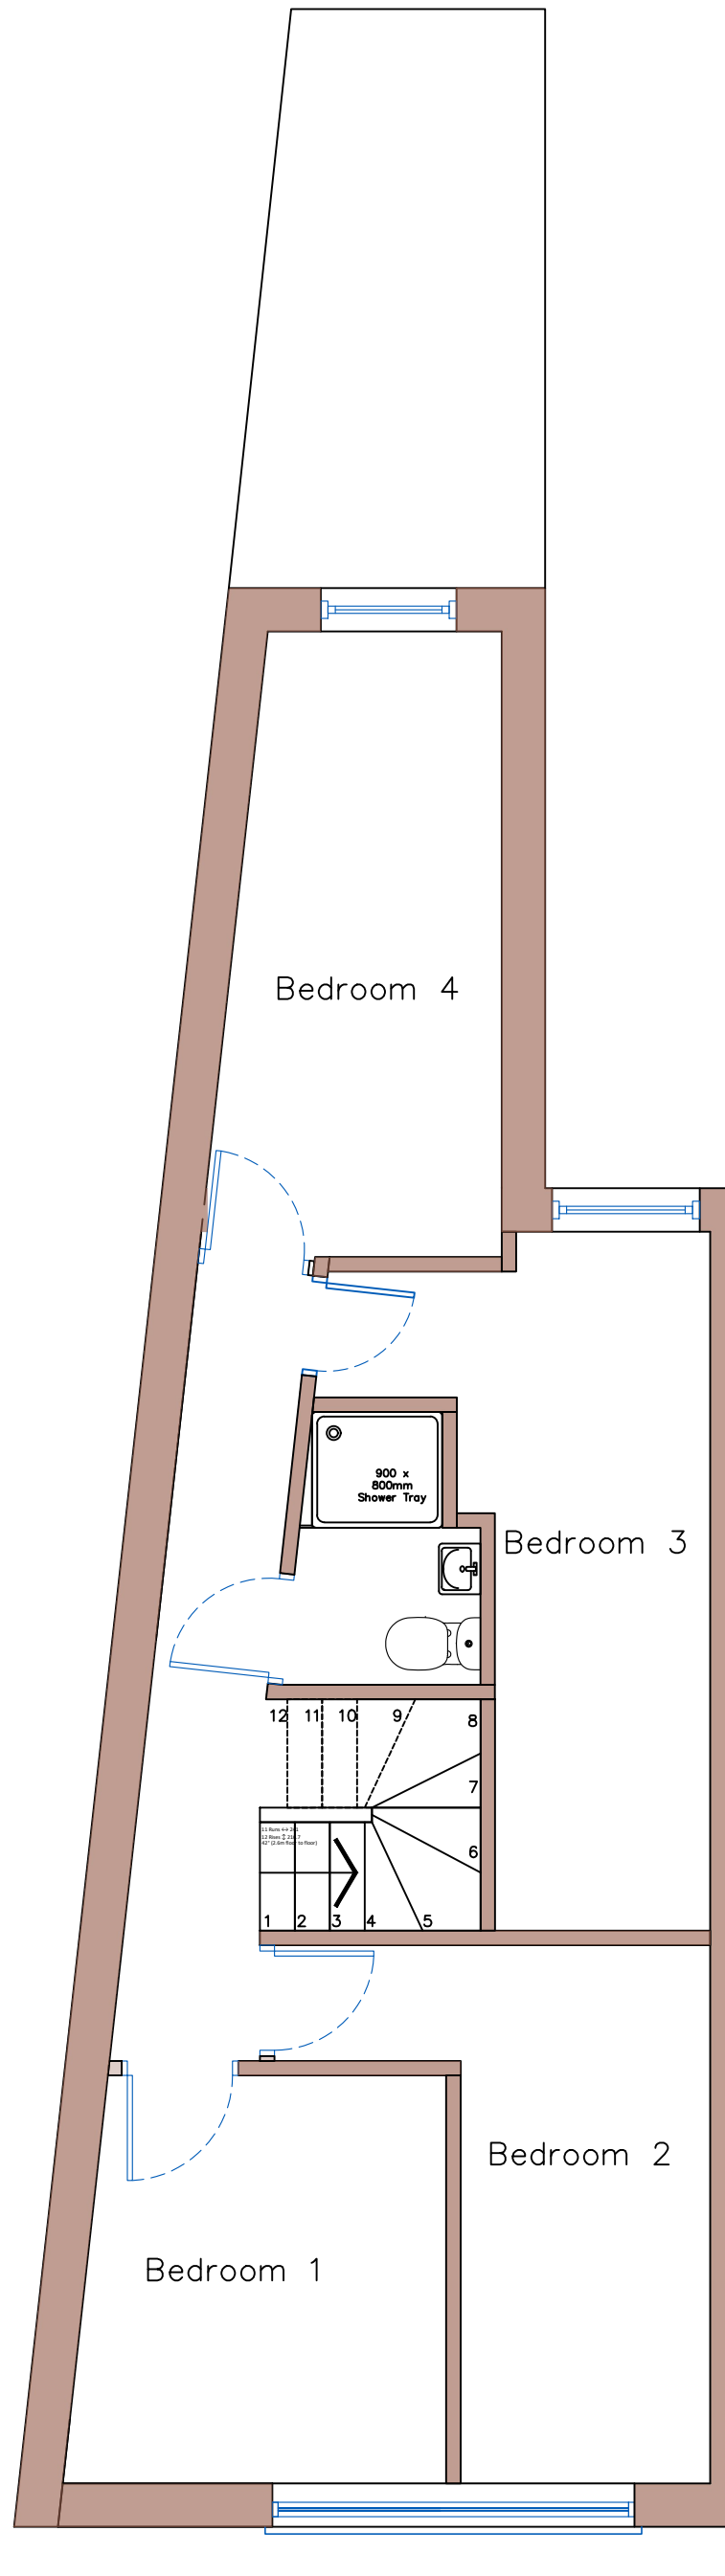


AS-BUILT FIRST FLOOR PLAN
SCALE 1:50

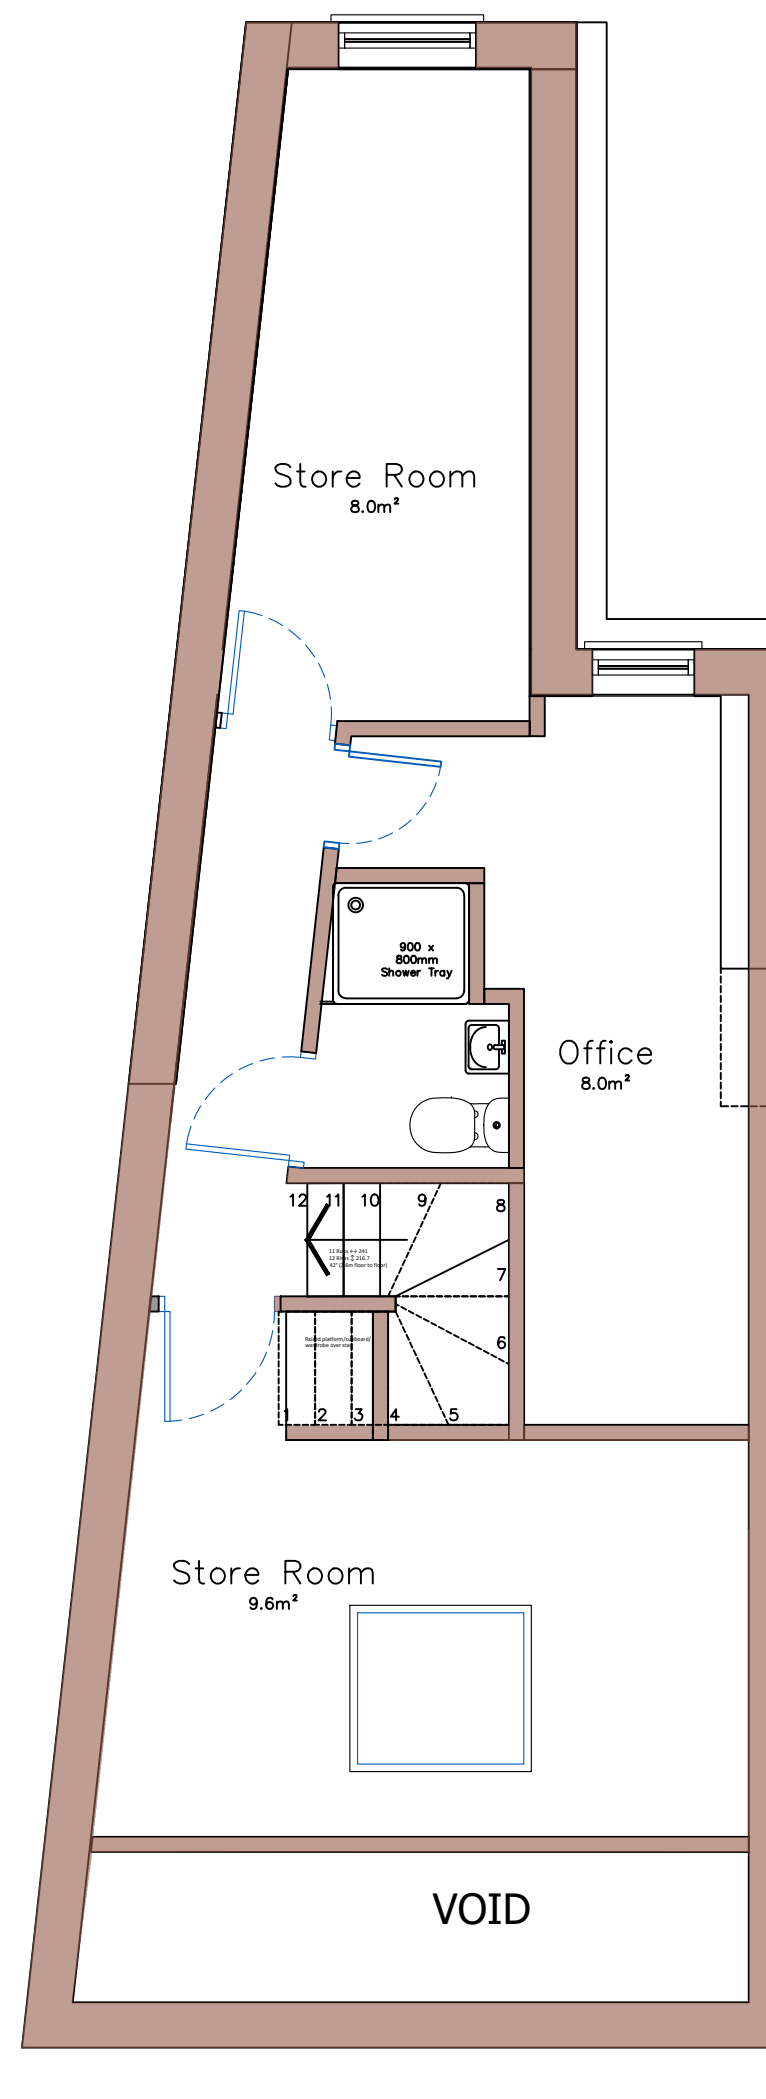


AS-BUILT SECOND FLOOR PLAN
SCALE 1:50

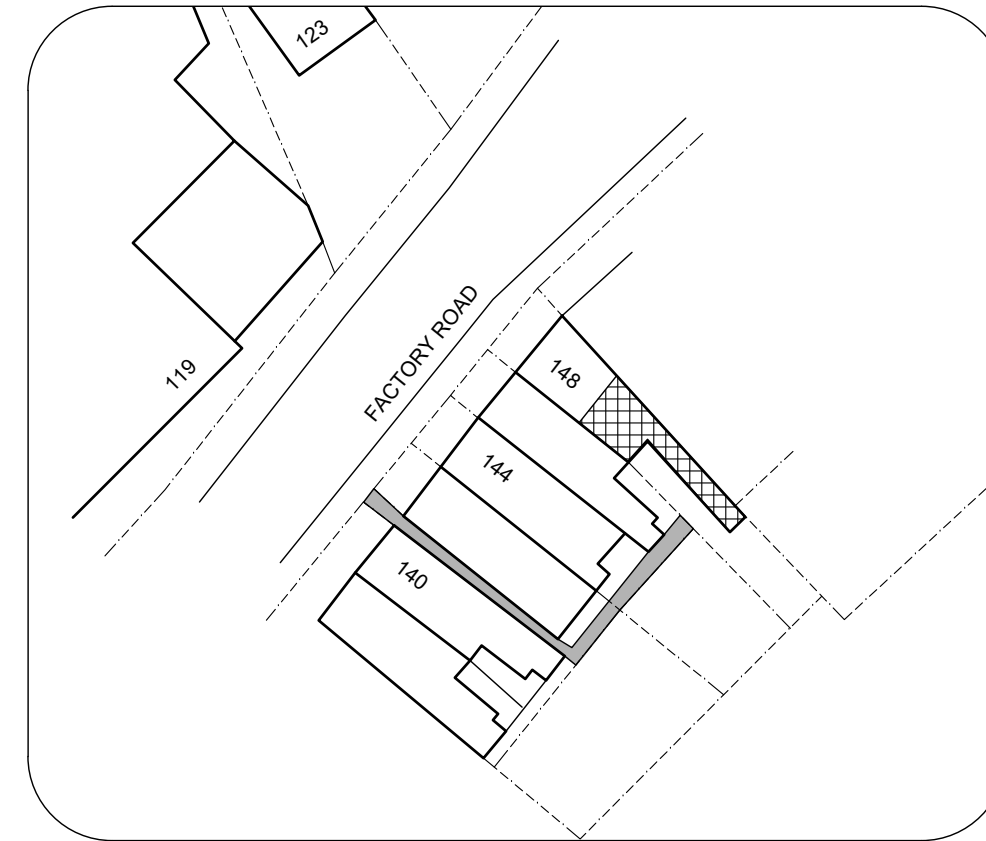

PROPOSED SITE LOCATION
(SCALE 1:500)
PROPOSAL SHOWN HATCHED

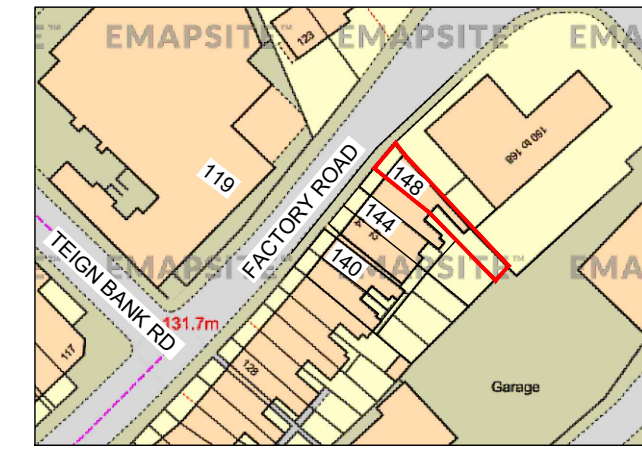

EXISTING AREA LOCATION
(SCALE 1:1250)

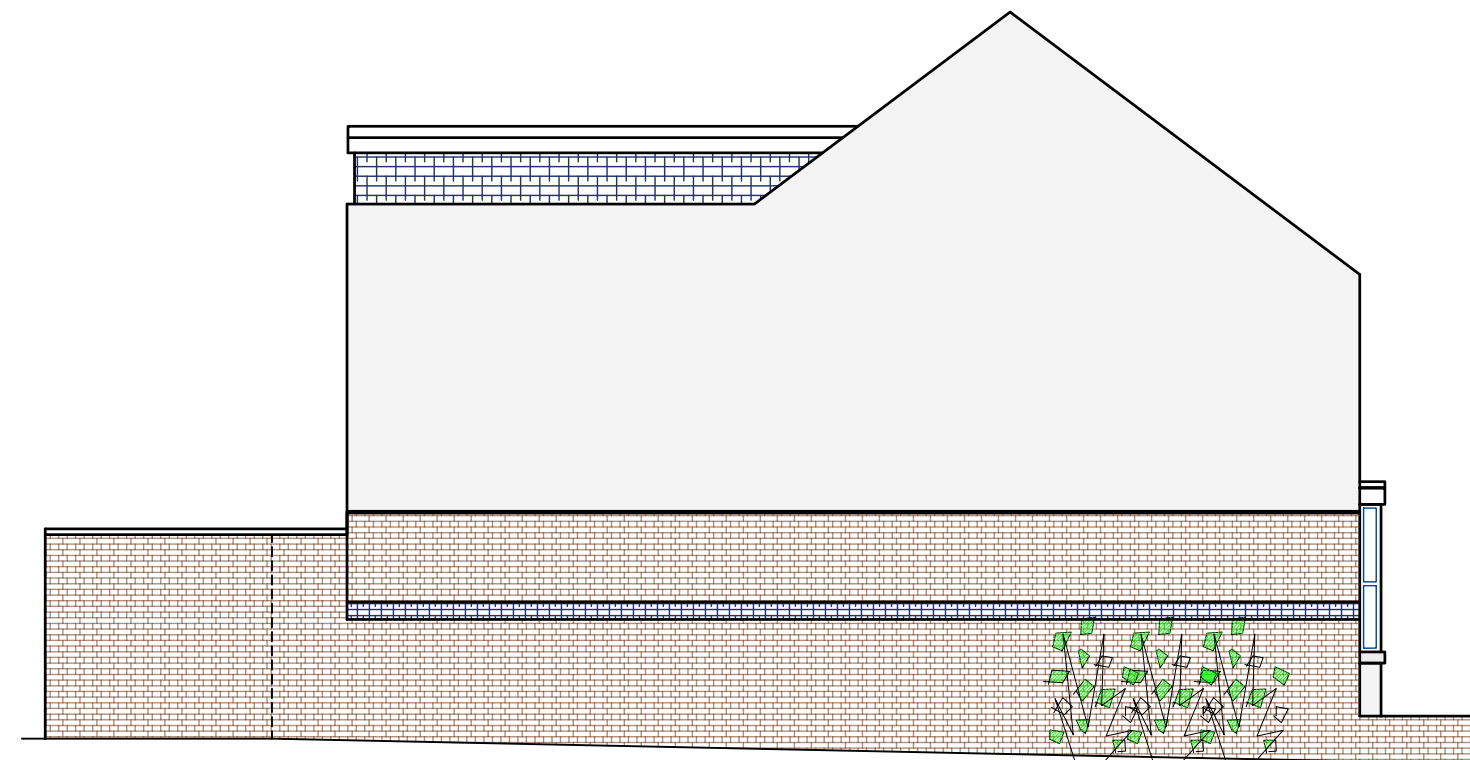


AS-BUILT NORTH EAST ELEVATION



AS-BUILT REAR ELEVATION



AS-BUILT FRONT ELEVATION
SCALE 1:100

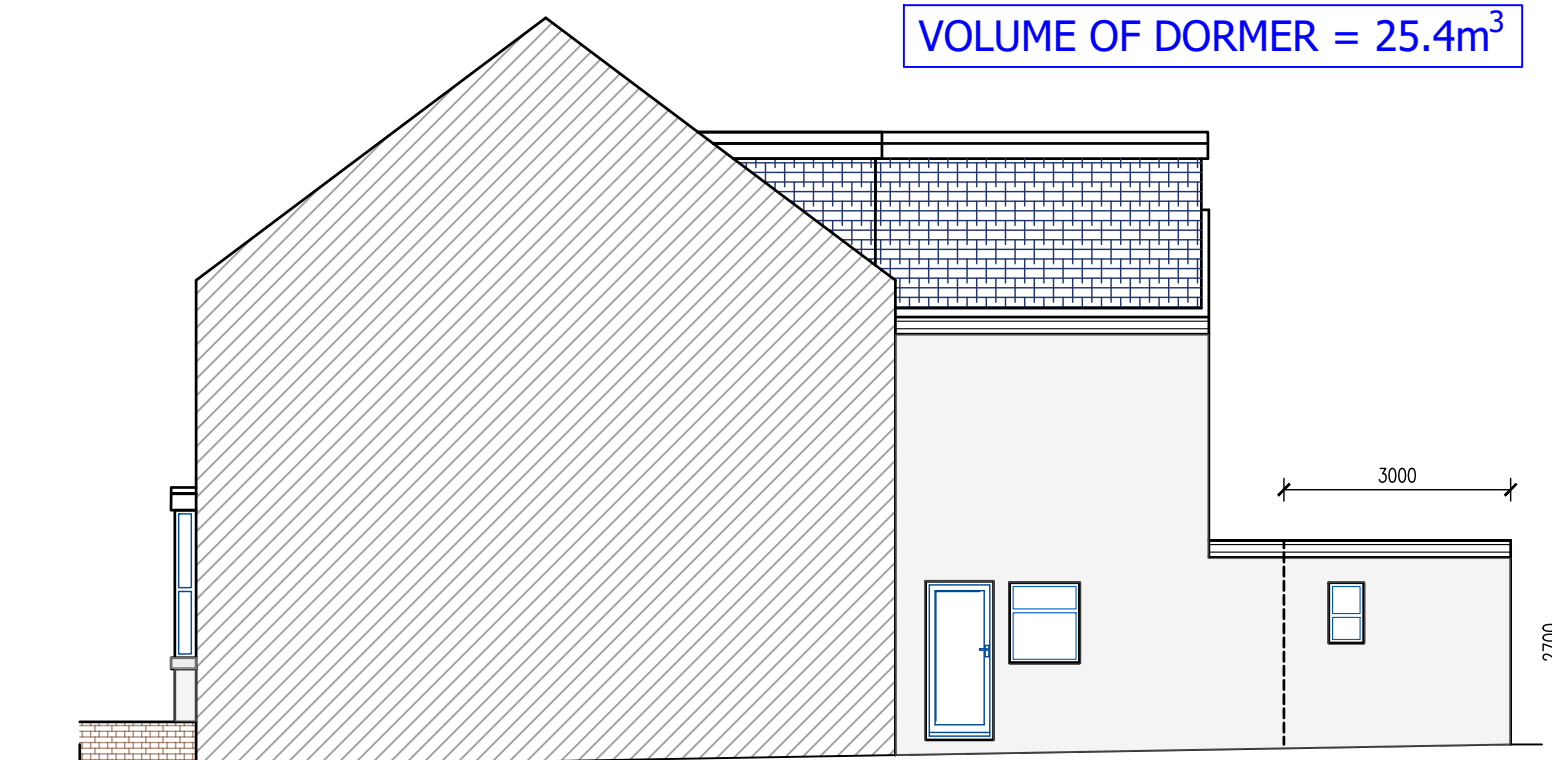

AS-BUILT SOUTH WEST ELEVATION

EXISTING USE: LAWFUL DEVELOPMENT CERTIFICATE

--	--	
