

Client:

Mr & Mrs Butler-Milbourne

4 Desford Lane,

Kirkby Mallory,

Leicestershire.

LE9 7QF

Project:

101-MCL-19-RBM

4 Desford Lane, Roof Extension

Drawing Title:


Proposed FF Plan Markup

Revision: 2.0

Date: 01/08/23

Scale:

1:100 @ A3

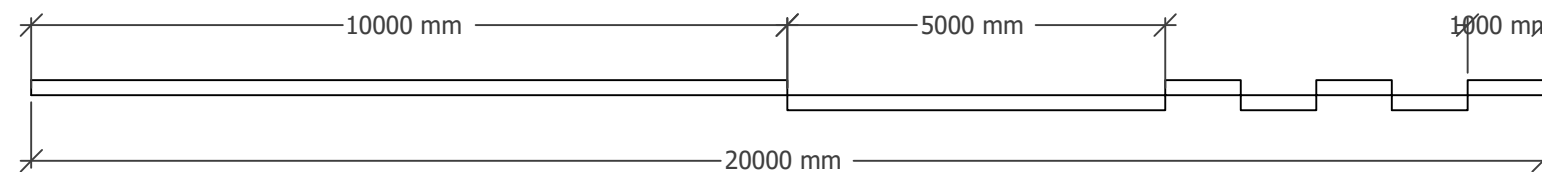

Hatching demarcates extent of amendment

