




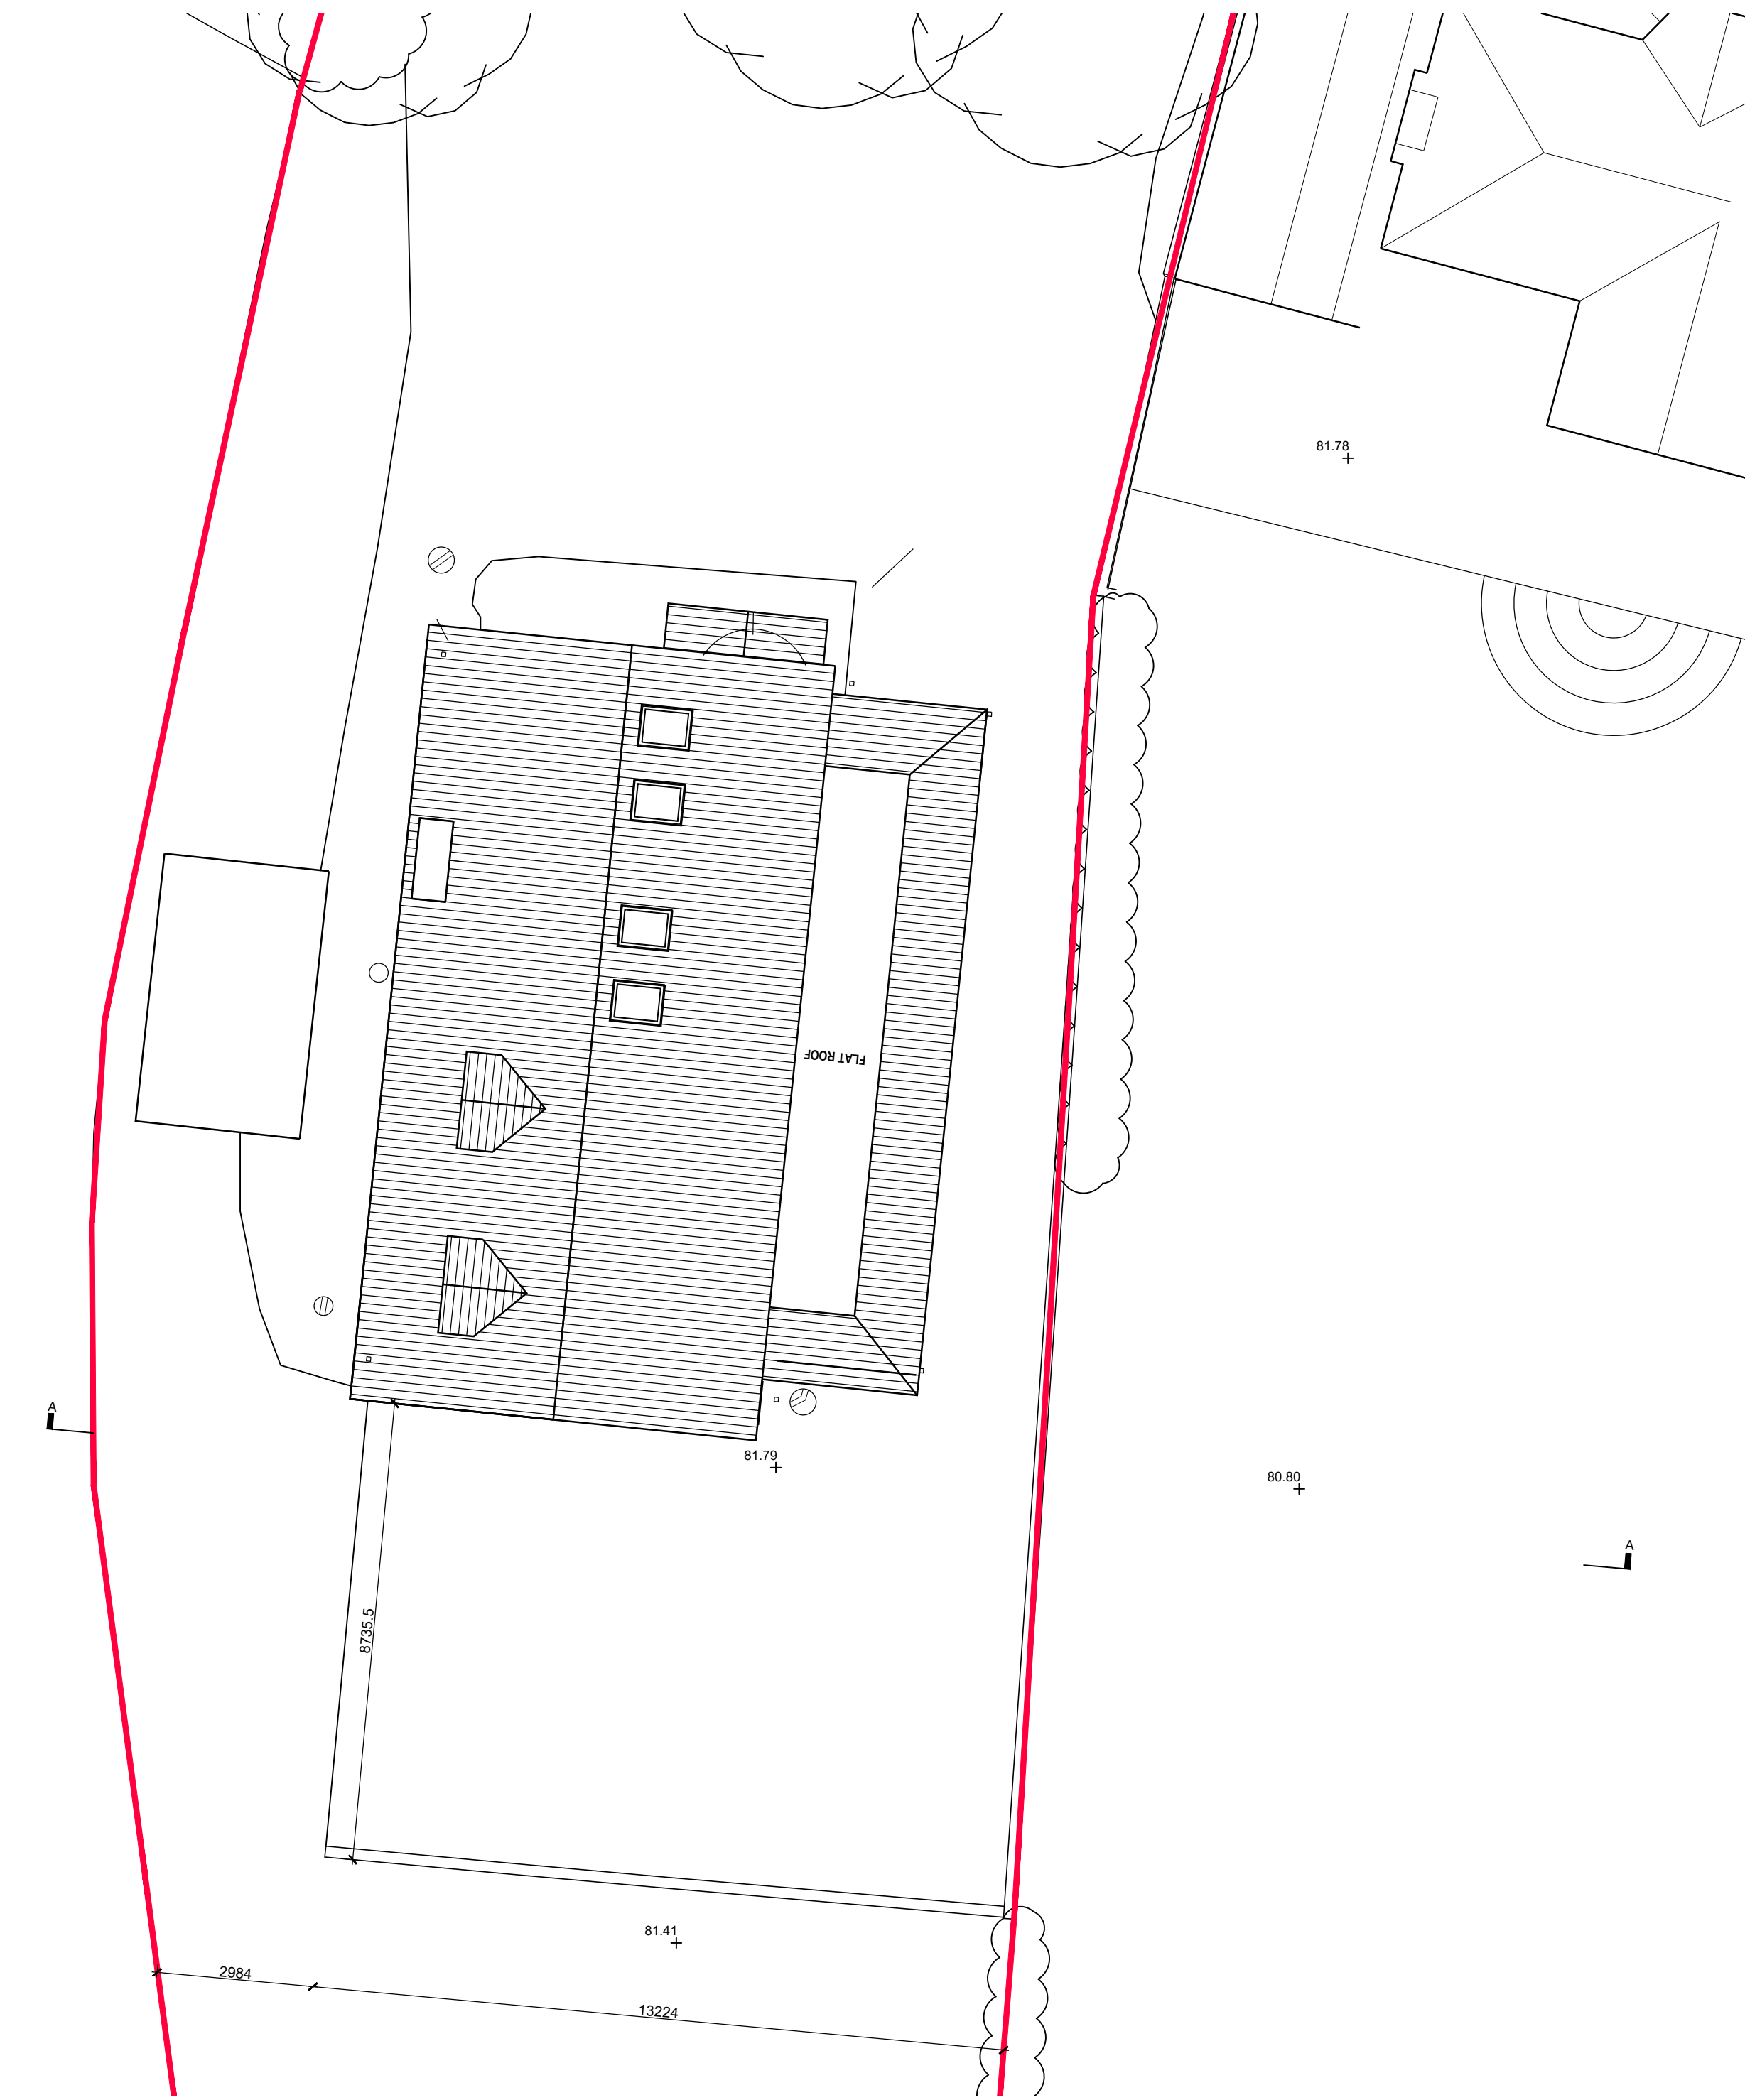

06 AS BUILT ON SITE
Scale 1:100

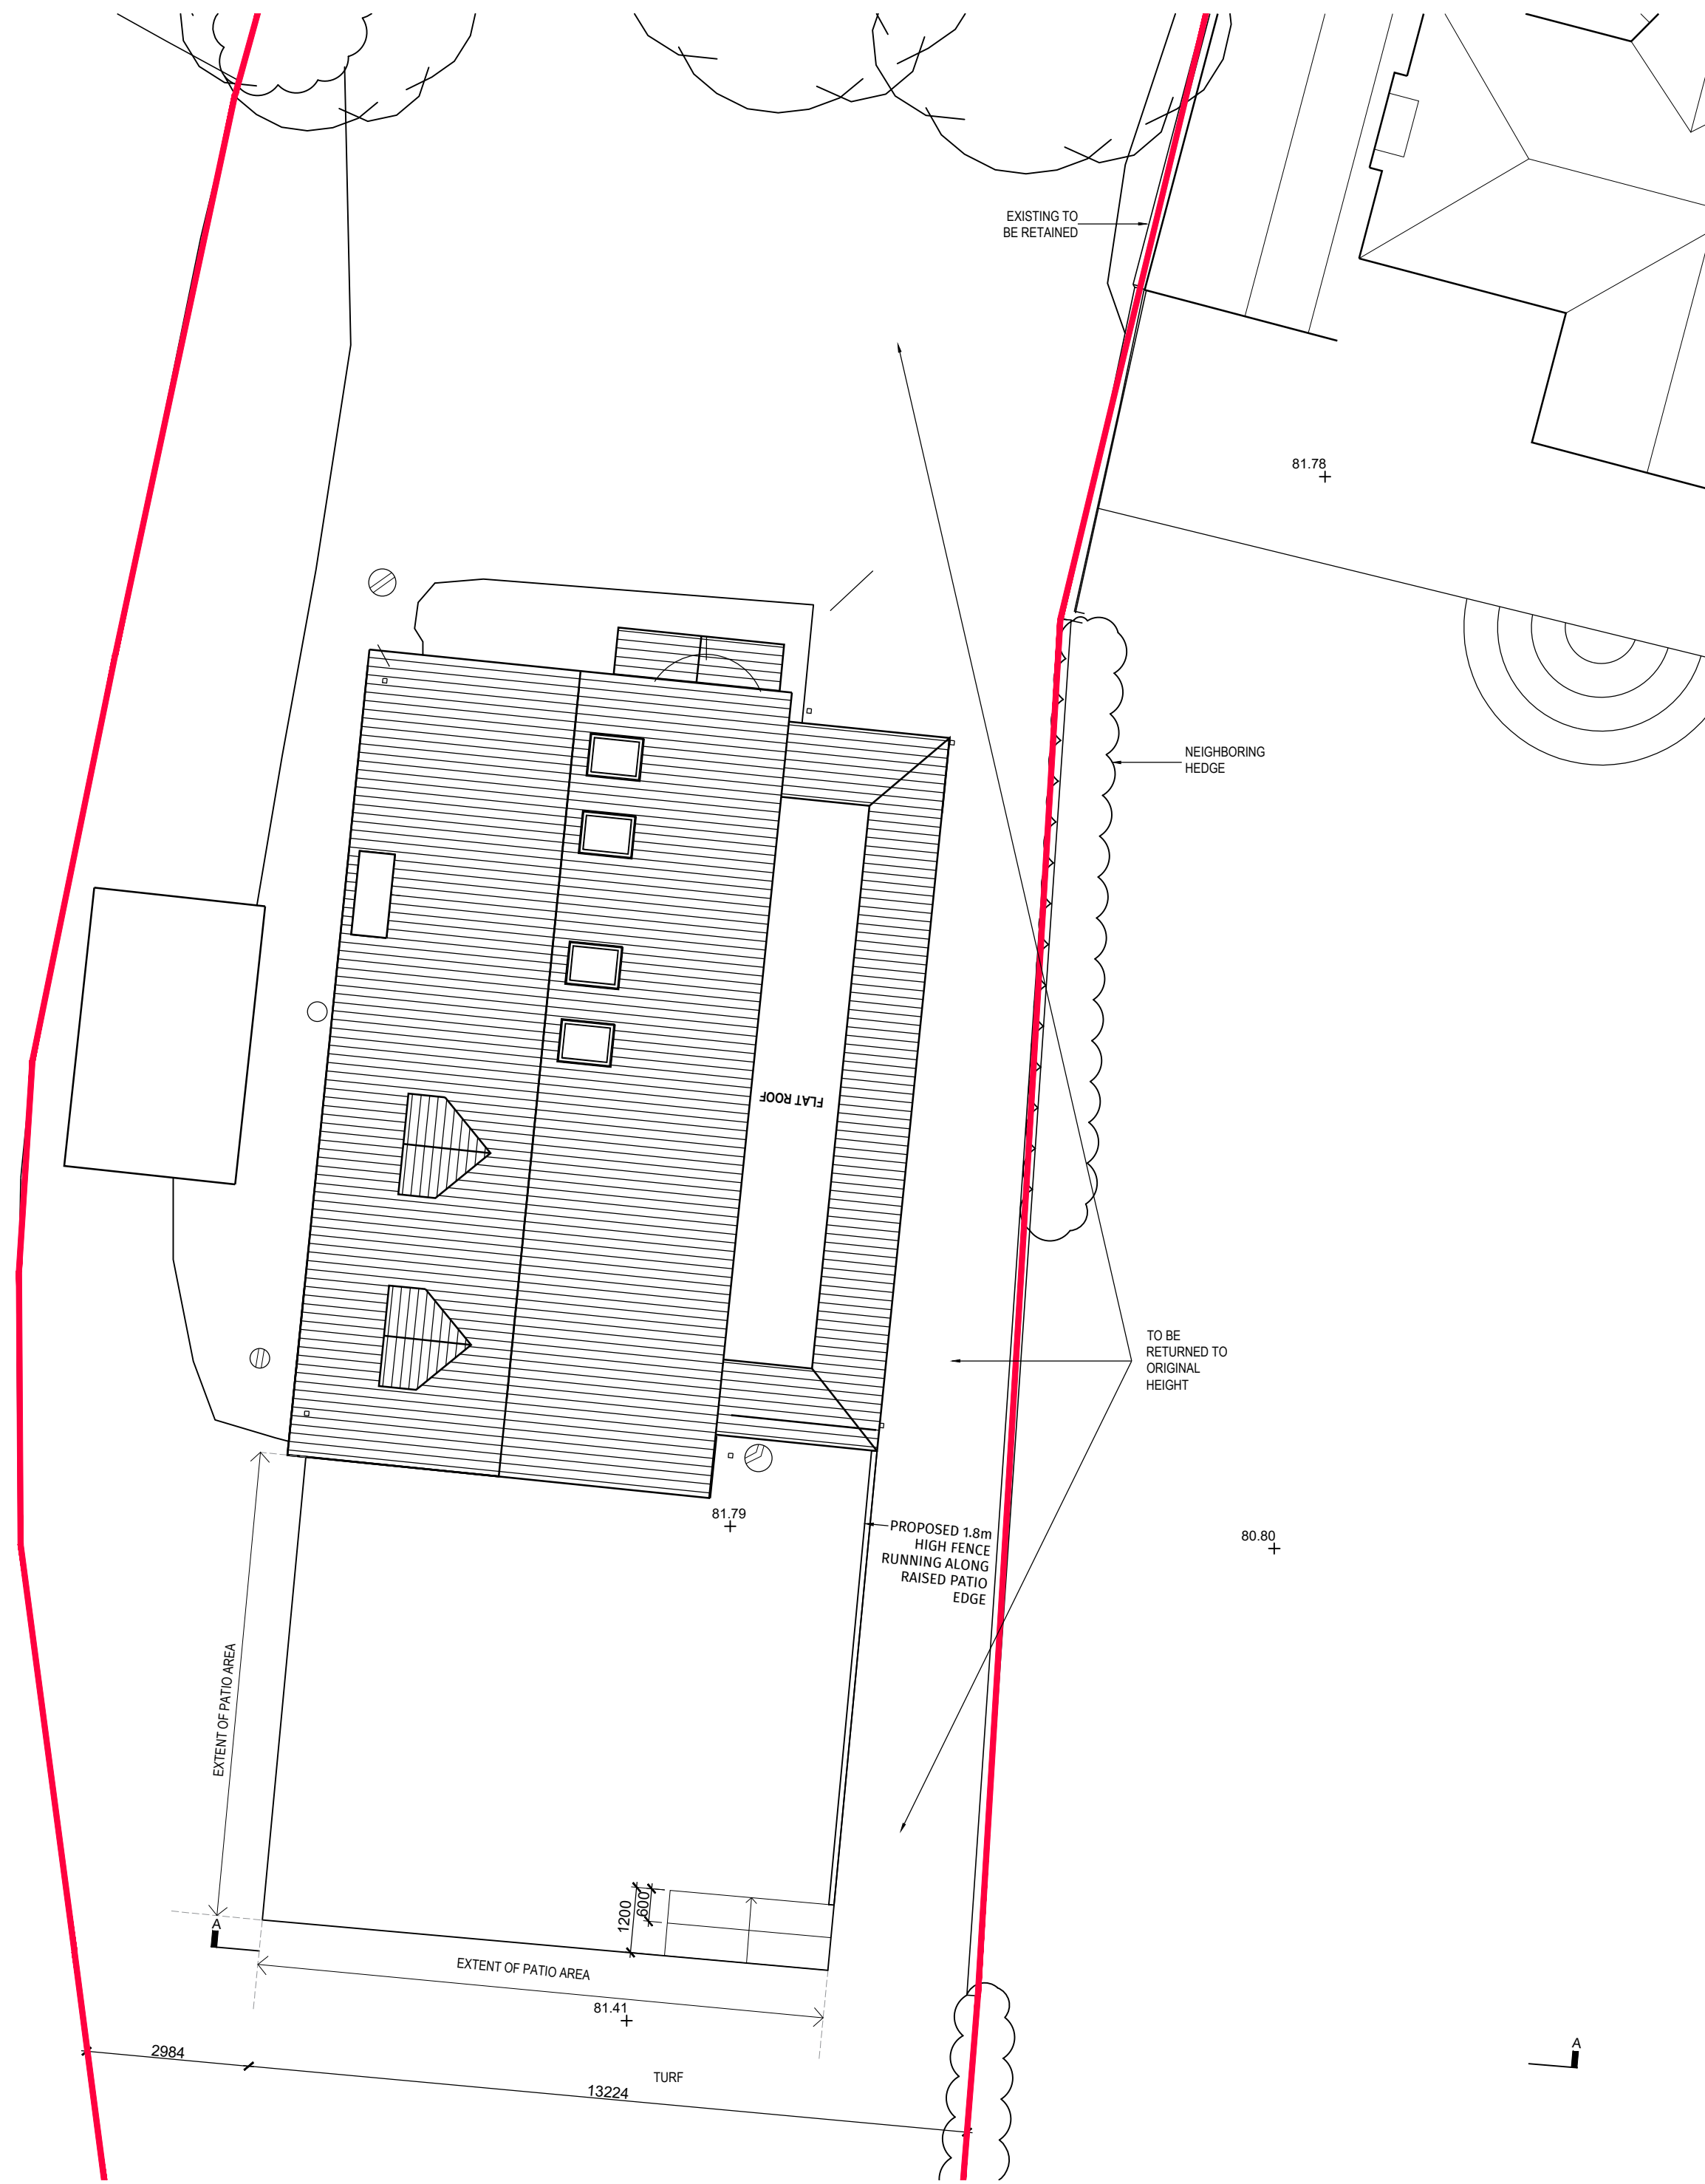


07 PROPOSED
Scale 1:100

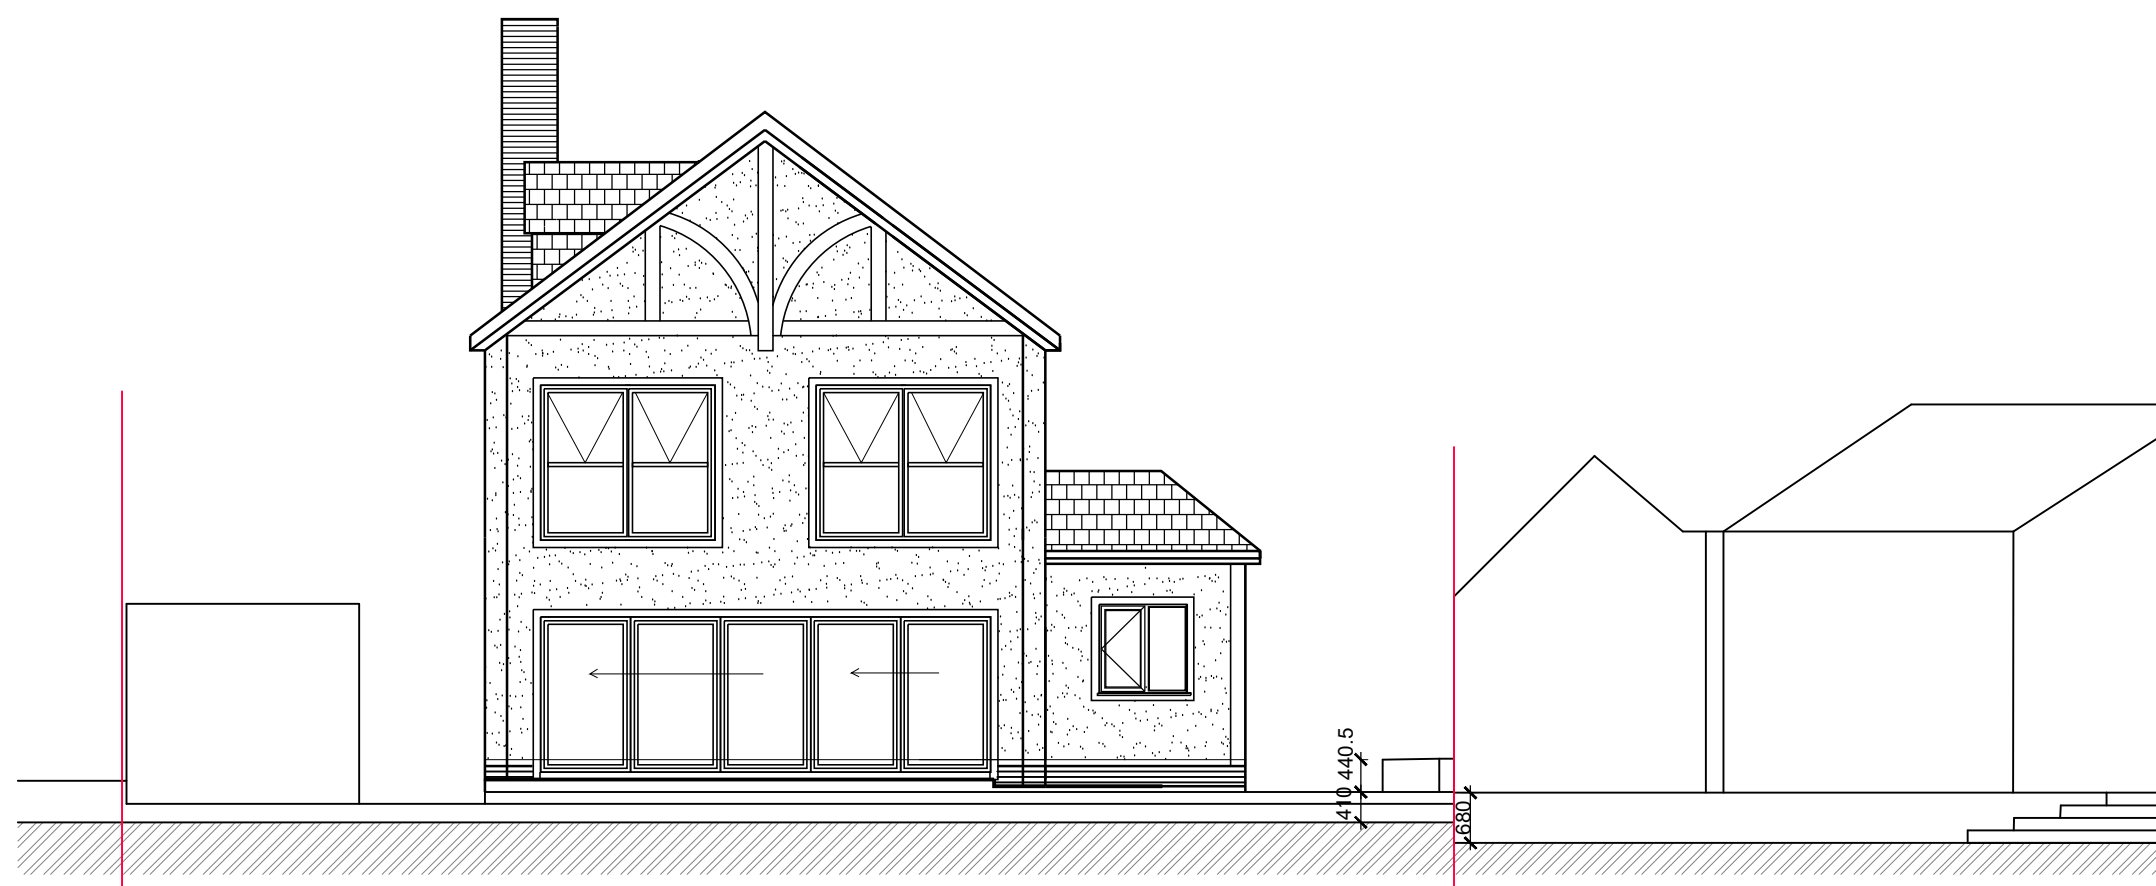

08 SITE SECTION AS BUILT ON SITE
Scale 1:100




09 SITE SECTION PROPOSED
Scale 1:100

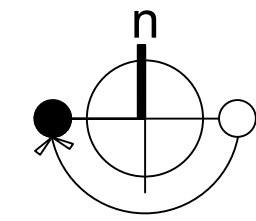


THIS DRAWING IS ISSUED FOR THE SOLE AND EXCLUSIVE USE OF THE NAMED RECIPIENT. DISTRIBUTION TO ANY THIRD PARTY IS ON THE STRICT UNDERSTANDING THAT NO LIABILITY IS ACCEPTED BY DESIGN STUDIO ARCHITECTS LTD FOR ANY DISCREPANCIES, ERRORS OR OMISSIONS THAT MAY BE PRESENT AND NO GUARANTEE IS OFFERED AS TO THE ACCURACY OF THE INFORMATION SHOWN. THIS DRAWING IS FOR REFERENCE ONLY. PLEASE REPORT ANY DISCREPANCIES TO THE DESIGNER BEFORE ANY WORKS COMMENCE. ALL DIMENSIONS TO BE CHECKED ON SITE BEFORE ANY WORKS COMMENCE. DESIGN STUDIO ARCHITECTS LTD. COPYRIGHT RESERVED.

Rev.	Description	Drwn	Chk.	Date
P01	FIRST ISSUE	CC	KS	19.11.2025
P02	UPDATED FOLLOWING COMMENT FROM PLANNING OFFICER	CC	KS	24.02.2026
P03	PATIO STEPS	CC	KS	04.03.2026
P04	UPDATED AFTER CLIENT COMMENT	CC	KS	19.03.2026
P05	UPDATED FOLLOWING COMMENT FROM PLANNING OFFICER	CC	KS	09.04.2026
P06	UPDATED FOLLOWING COMMENT FROM PLANNING OFFICER	CC	KS	10.04.2026

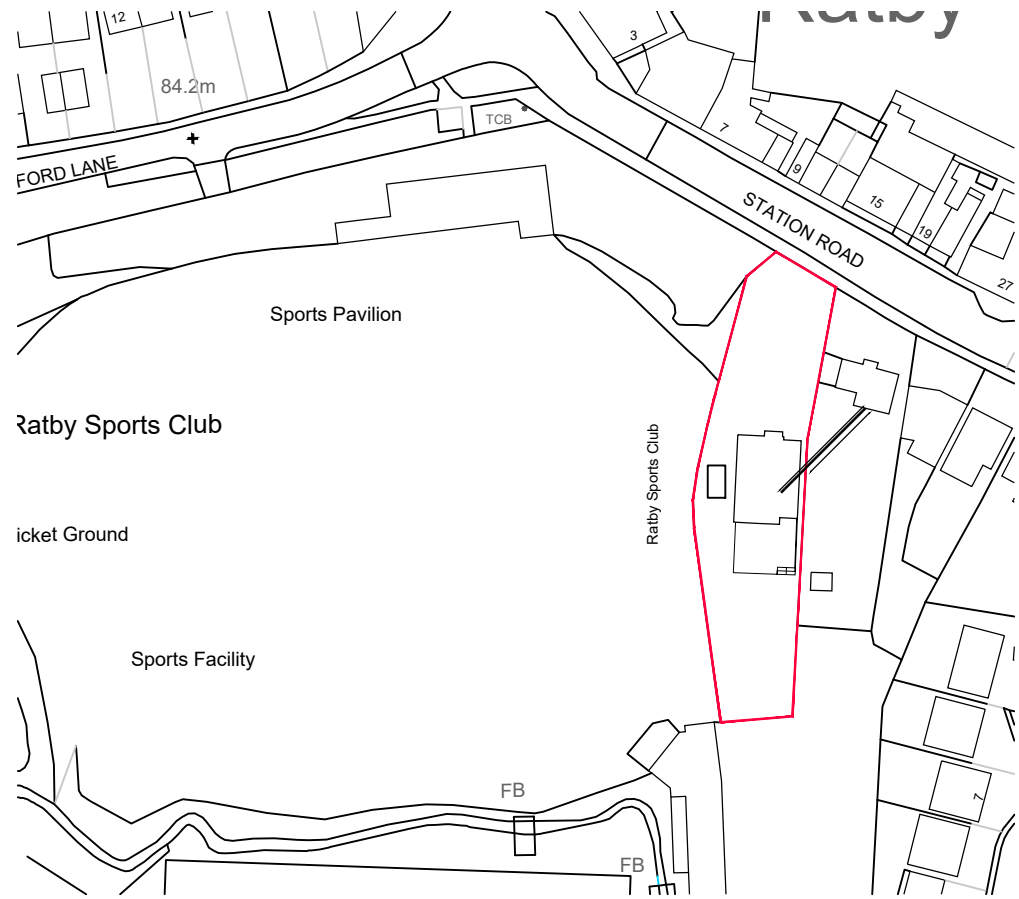

10 SITE/ BLOCK PLAN
Scale 1:1250

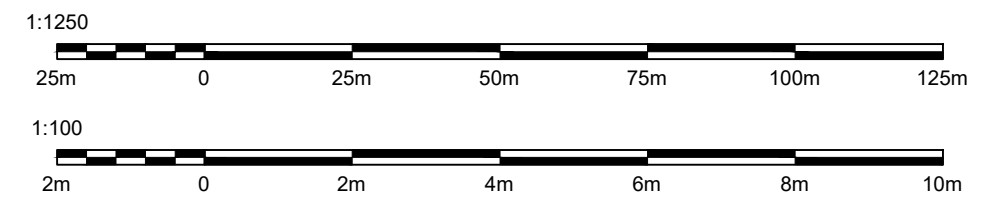

Regent House, 7 Upper King Street
Leicester, LE1 6XB
t:0116 251 0606 | w:ds-a.co.uk | e:info@ds-a.co.uk

Project Details:

Lukbinder Bath
14 Station Road
Ratby
Leicester
LE6 0JN

Drawing Name:
21116

Drawing Stage: SKETCH SCHEME

Drawn: CC Check: KS Date: 18/11/2025 Scale: 1:100 & 1:1250

Drawing Number:

21116 DSA ZZ XX DR A 301 P06

PROJECT CODE ORIGIN ZONE LEVEL TYPE ROLE NUMBER REVISION

