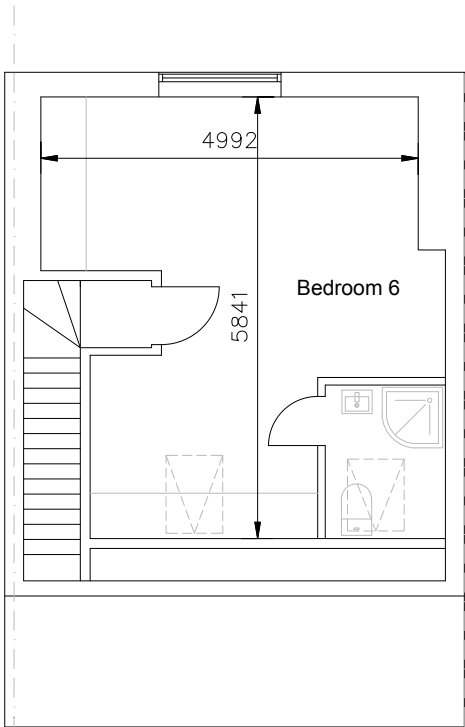
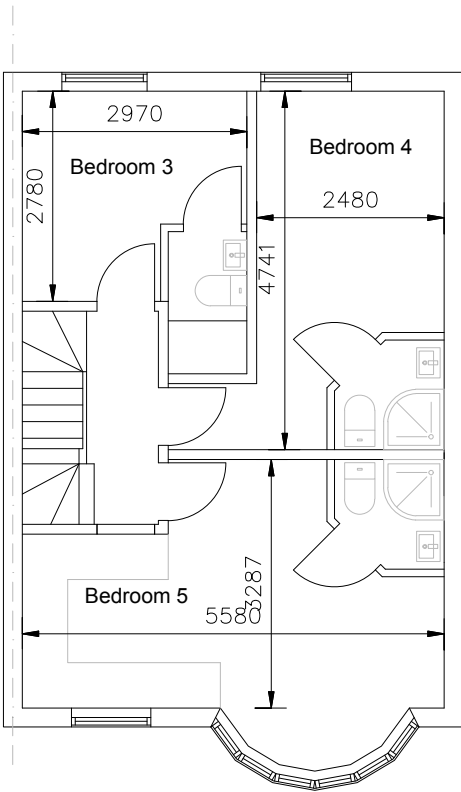
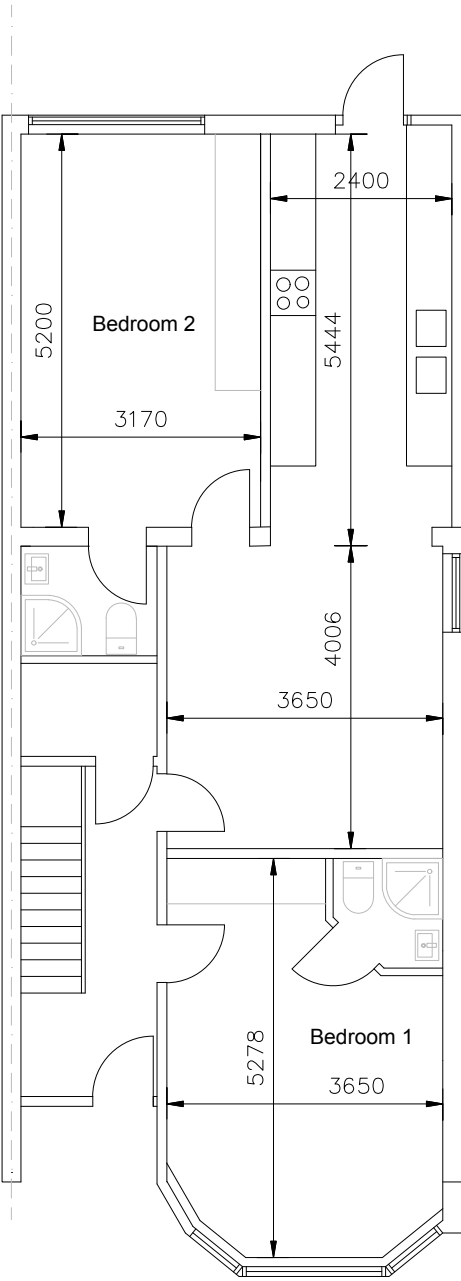


Rev	Description	Date	chkd	Project: 7 Queen's Road Hinckley England LE10 1ED			
 ANJUM DESIGN Anjum Design Limited, Suite 104, 123 Stratford Road, Shirley, Solihull B90 3ND TEL: 0121 364 7650 E: info@anjumdesign.co.uk				Scale: As shown @ A3	Drawn by: RM	Date: Mar 2026	Status:
				Title: As-built Floor Plans			
				Drg. No. PL03			Rev: