


Dimensions of existing roof
to be checked on site

Drawings based on Anjum
design architects scheme

Blue hatched area shows
extent of extra floor area
added to side of development,
following omission of floor spaces
from the basement area
Area of basement floor
space omitted
(shown in green cross
hatched basement floor plan)
= 39sqm
Area of extra floor area
added (shown in blue hatch)=
35sqm

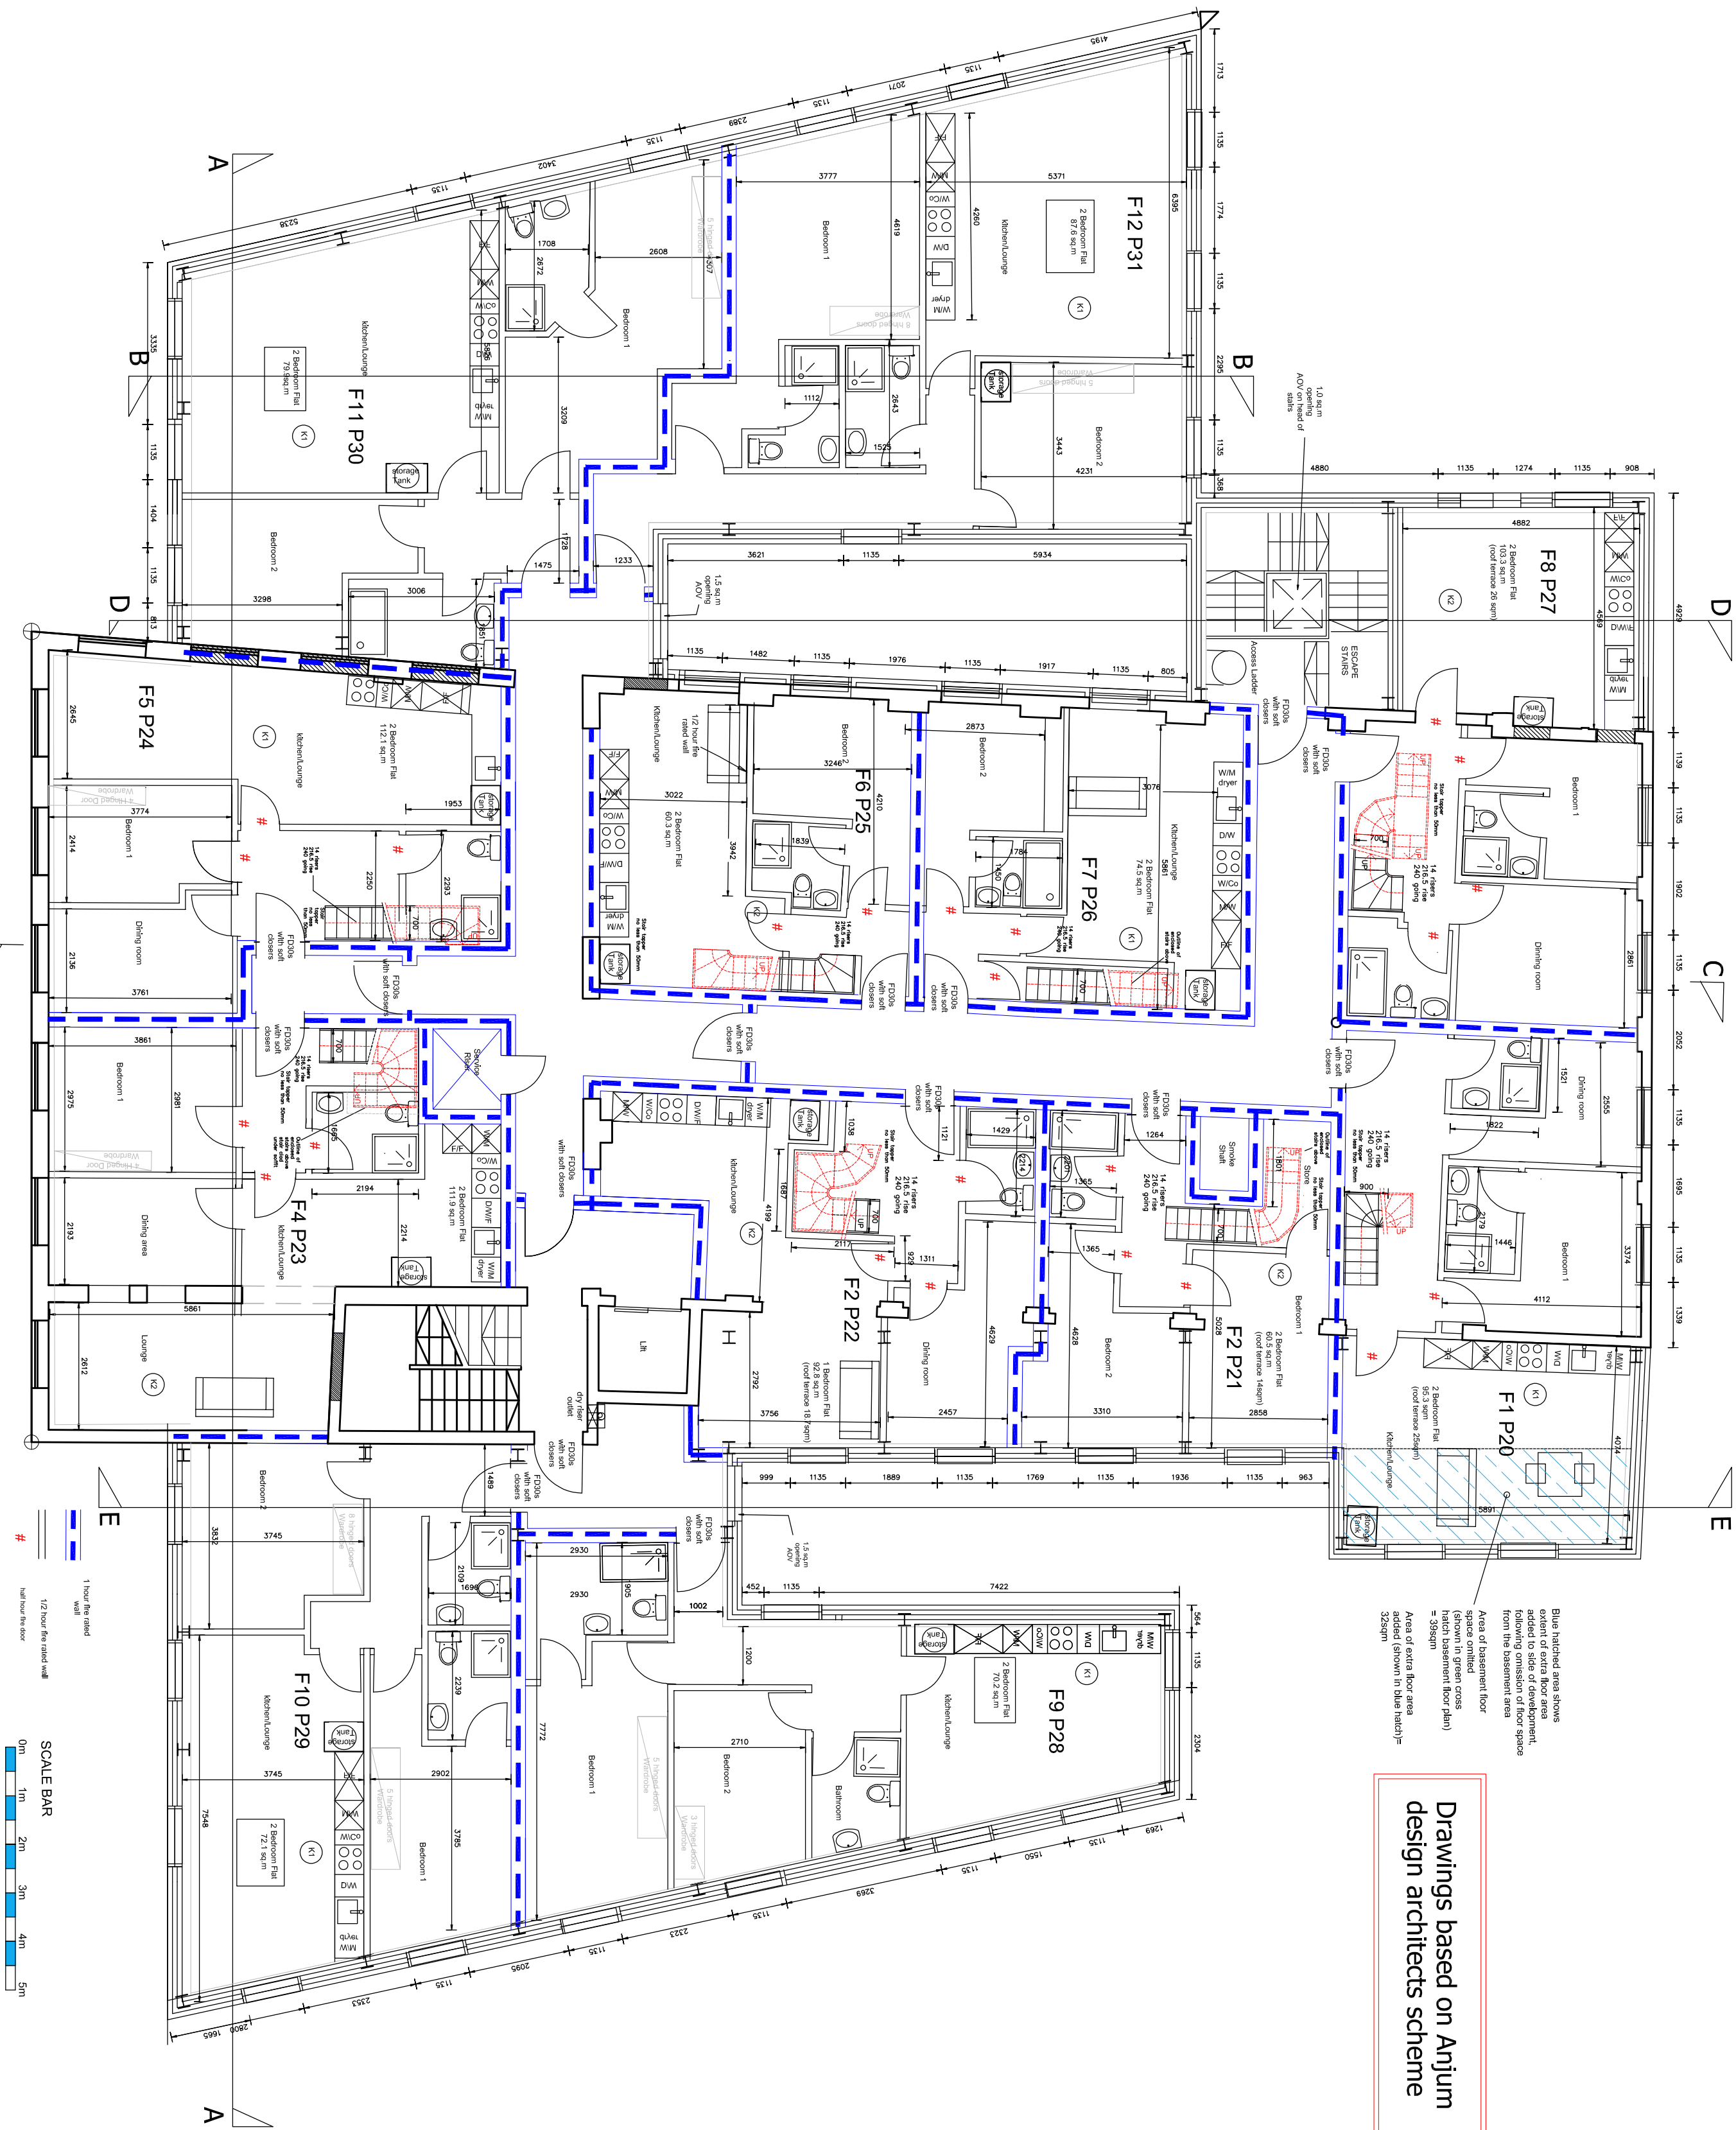

DRAFT

Rev	Date	description	by	chk
A	12.05.23	Layout changes	RD	ZM
B	12.05.23	DR20 stairs altered	RD	ZM
C	08.06.23	Door fire ratings altered	RD	ZM
D	25.08.23	Stairs to BR 16 and 18 altered window to BR 12 moved BR20 and 21 stairs altered	RD	ZM
E	30.10.23	Layout Changes	MS	ZM
F	19.12.23	Layout Changes	MS	ZM
G	27.03.24	Layout Changes	RD	ZM
H	24.04.24	Layout Changes	RD	ZM
I	07.06.24	Layout Changes	RD	ZM

hayward
ARCHITECTS LTD

19 Station Road
Hinckley
Leicestershire
LE10 1AW
Tel: 01455 635 665
Fax: 01455 618 971
www.hayward-architects.co.uk

Ahmad

Project Title
**56 Upper Bond
Street
LE10 1RS**

Drawing Title
Second floor revised to allow for duplex floor
above

Scale 1:100	Date 18.04.23	Sheet A2
Author RD	Checked by ZM	

Job No. 23-11	Drawing No. 201
-------------------------	---------------------------

Status
COMMENT

Second floor plan (altered to allow for upper mezz floor stairs)

Scale 1:100

THE COPYRIGHT OF THIS DRAWING IS VESTED IN HAYWARD ARCHITECTS LTD.
REPRODUCTION IN ANY FORM, EITHER IN WHOLE OR IN PART IS CONSIDERED WITHOUT
THE FIRM'S AND ONLY FIGURED DIMENSIONS ARE TO BE USED