


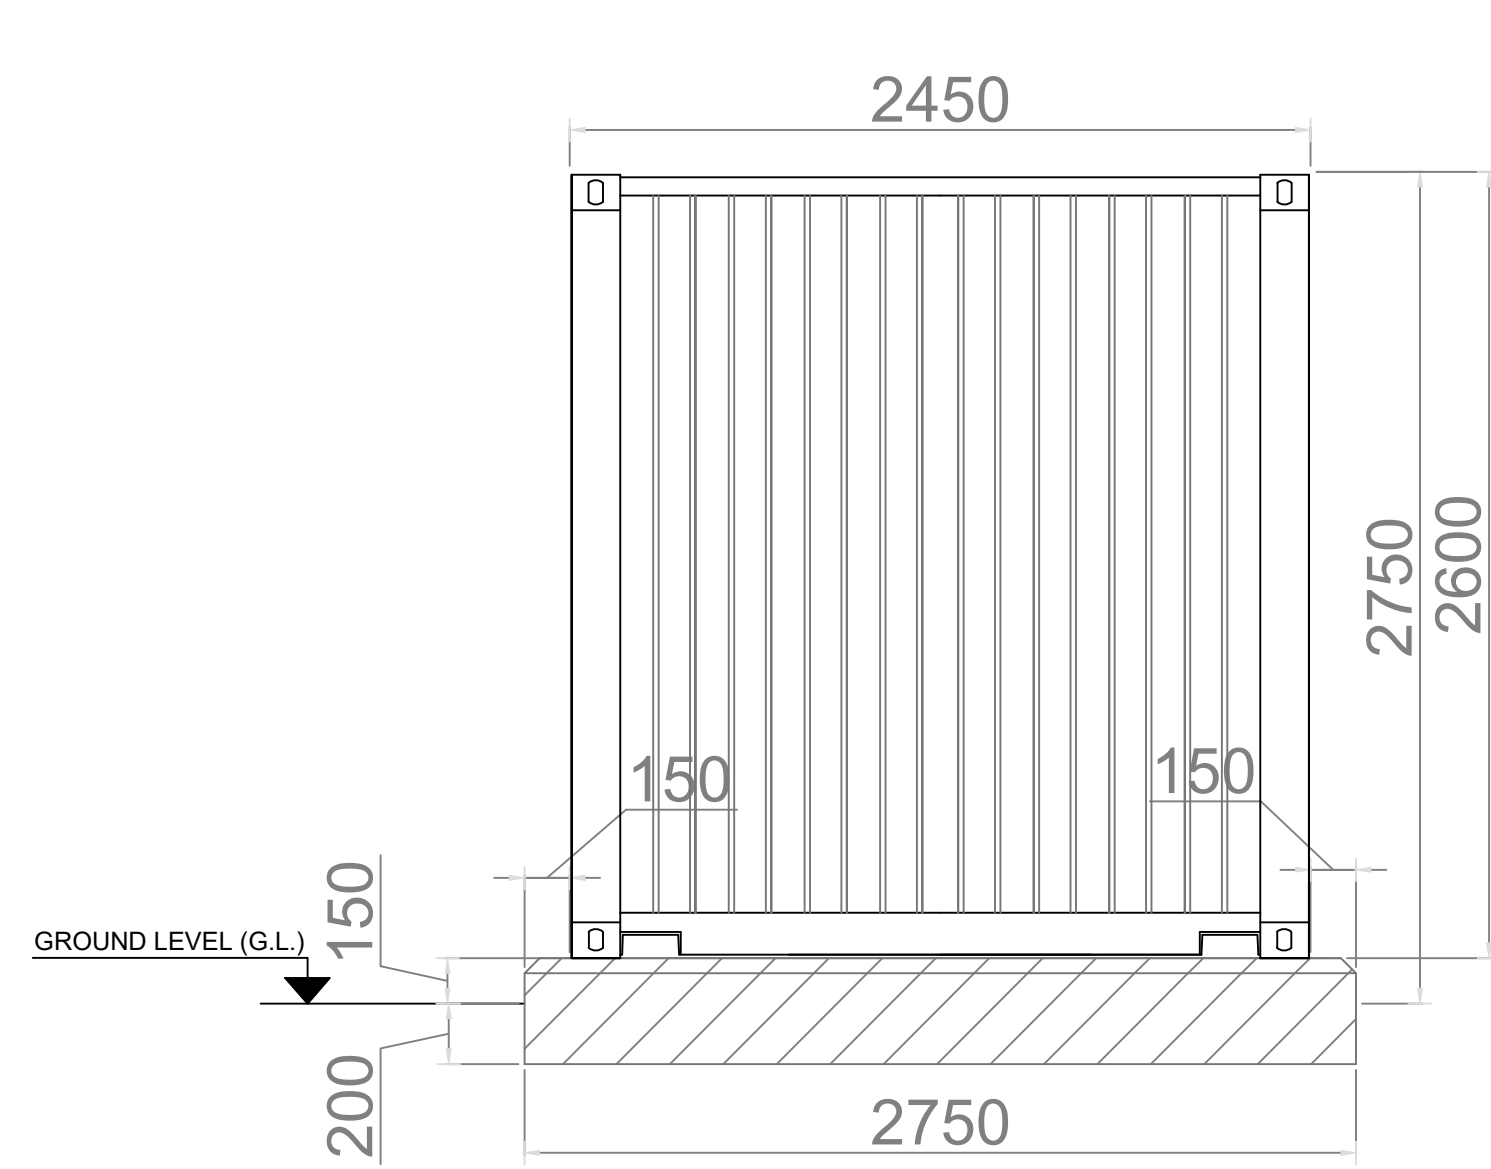


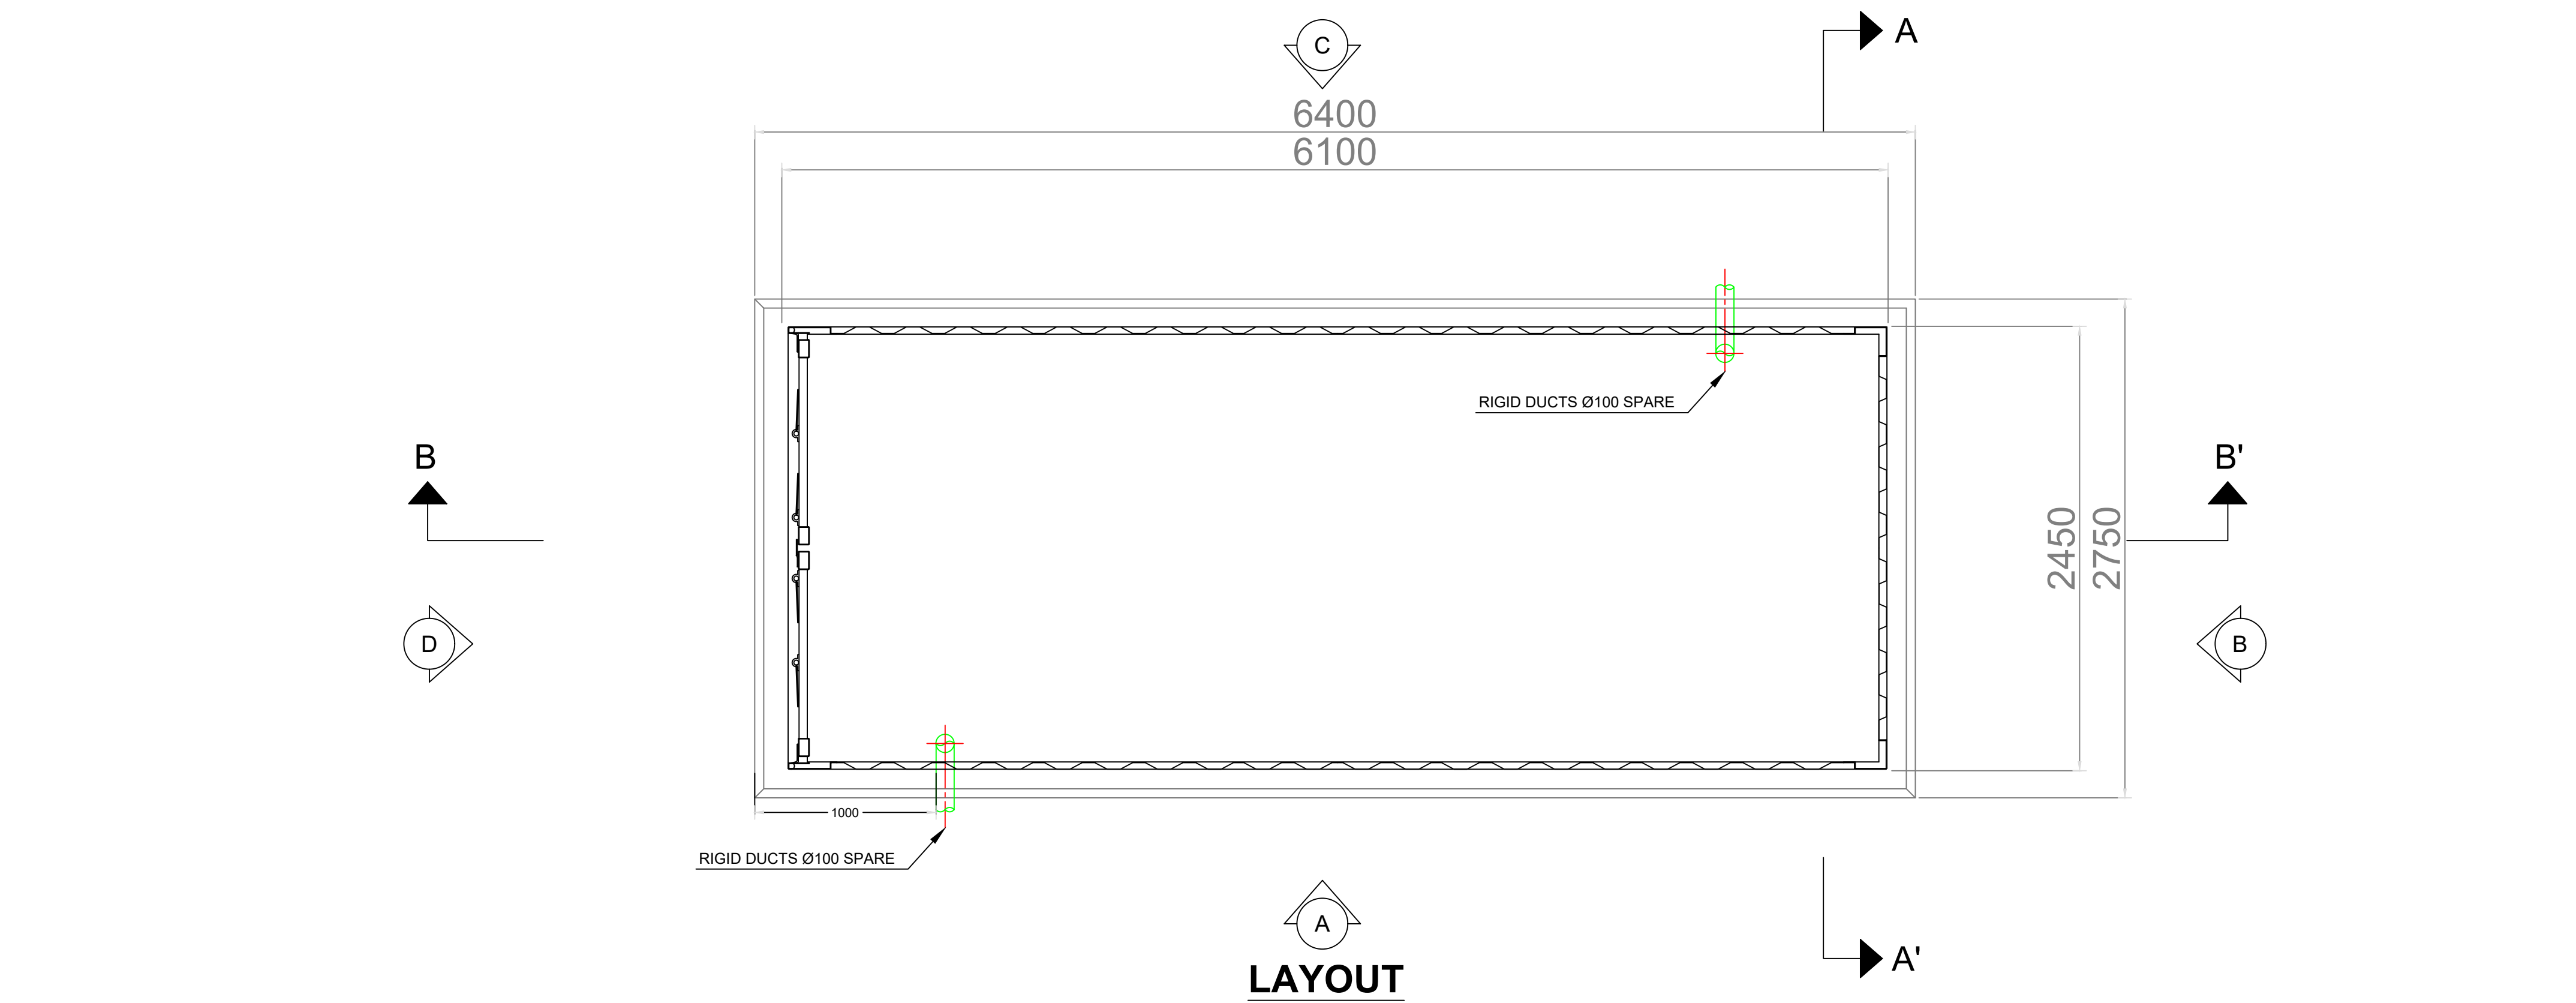


SIDE B

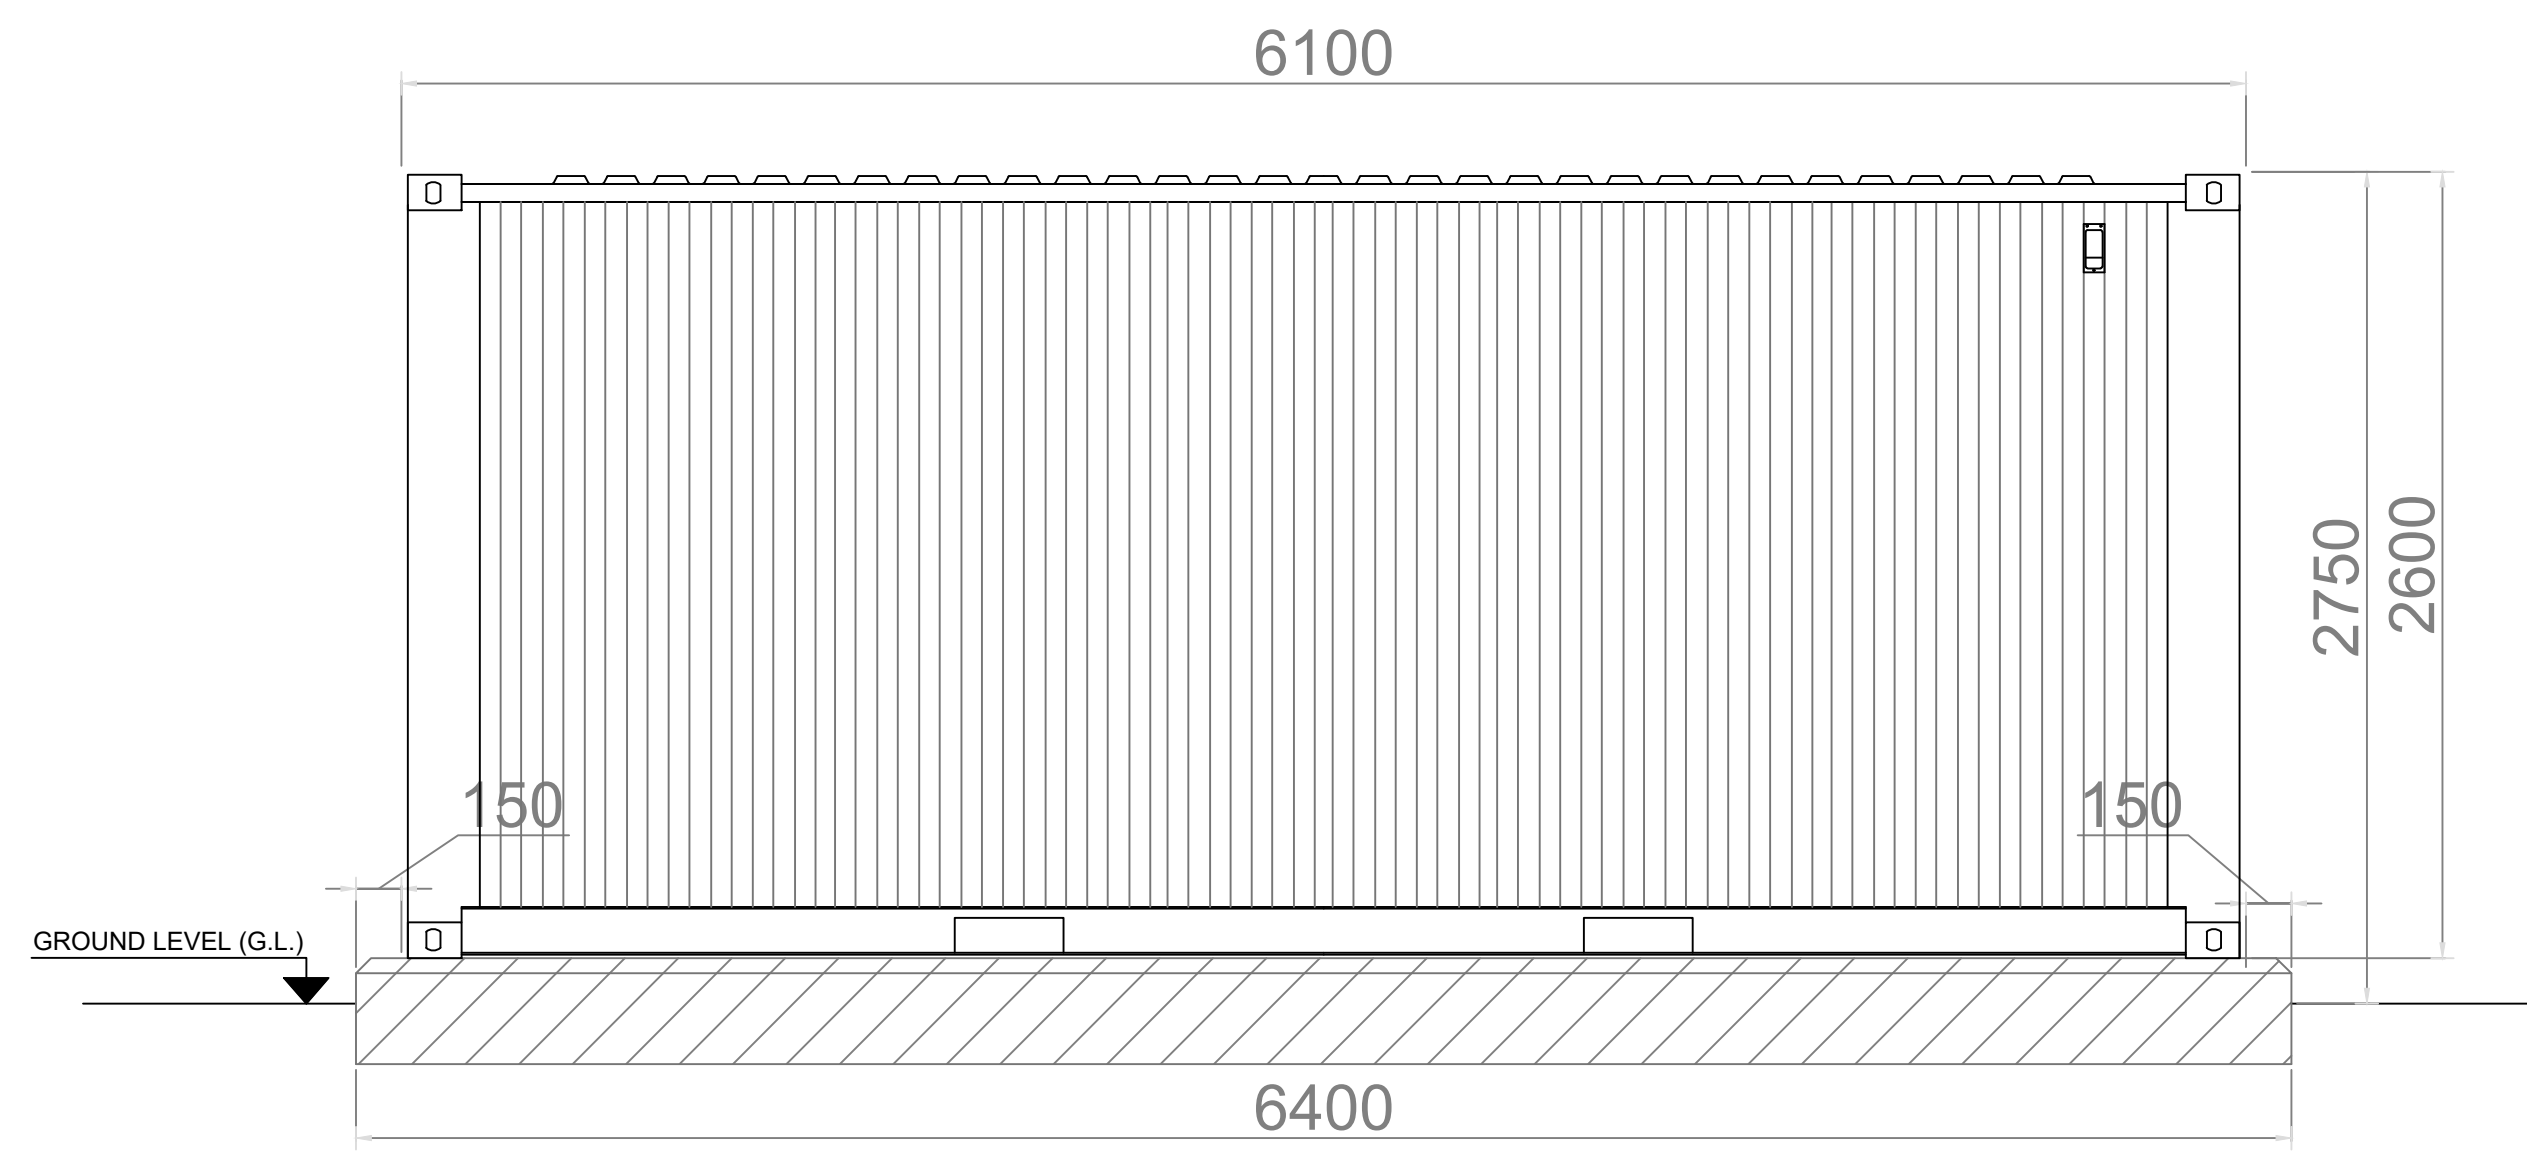


SIDE A

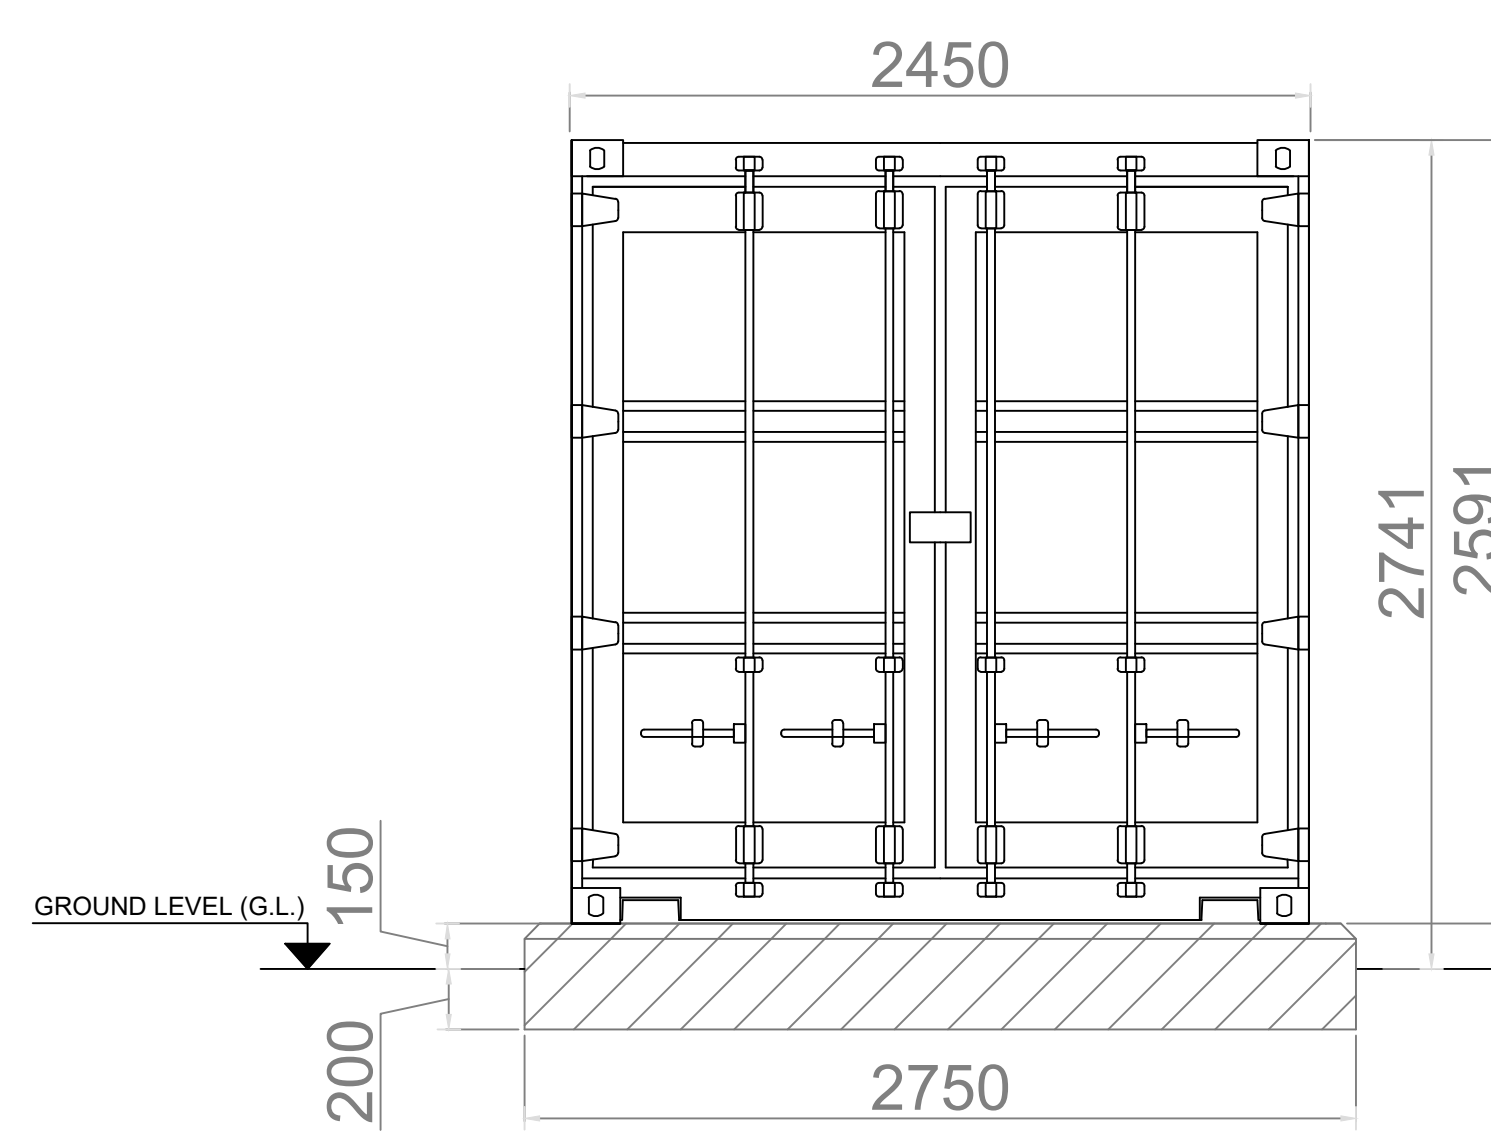


SIDE D

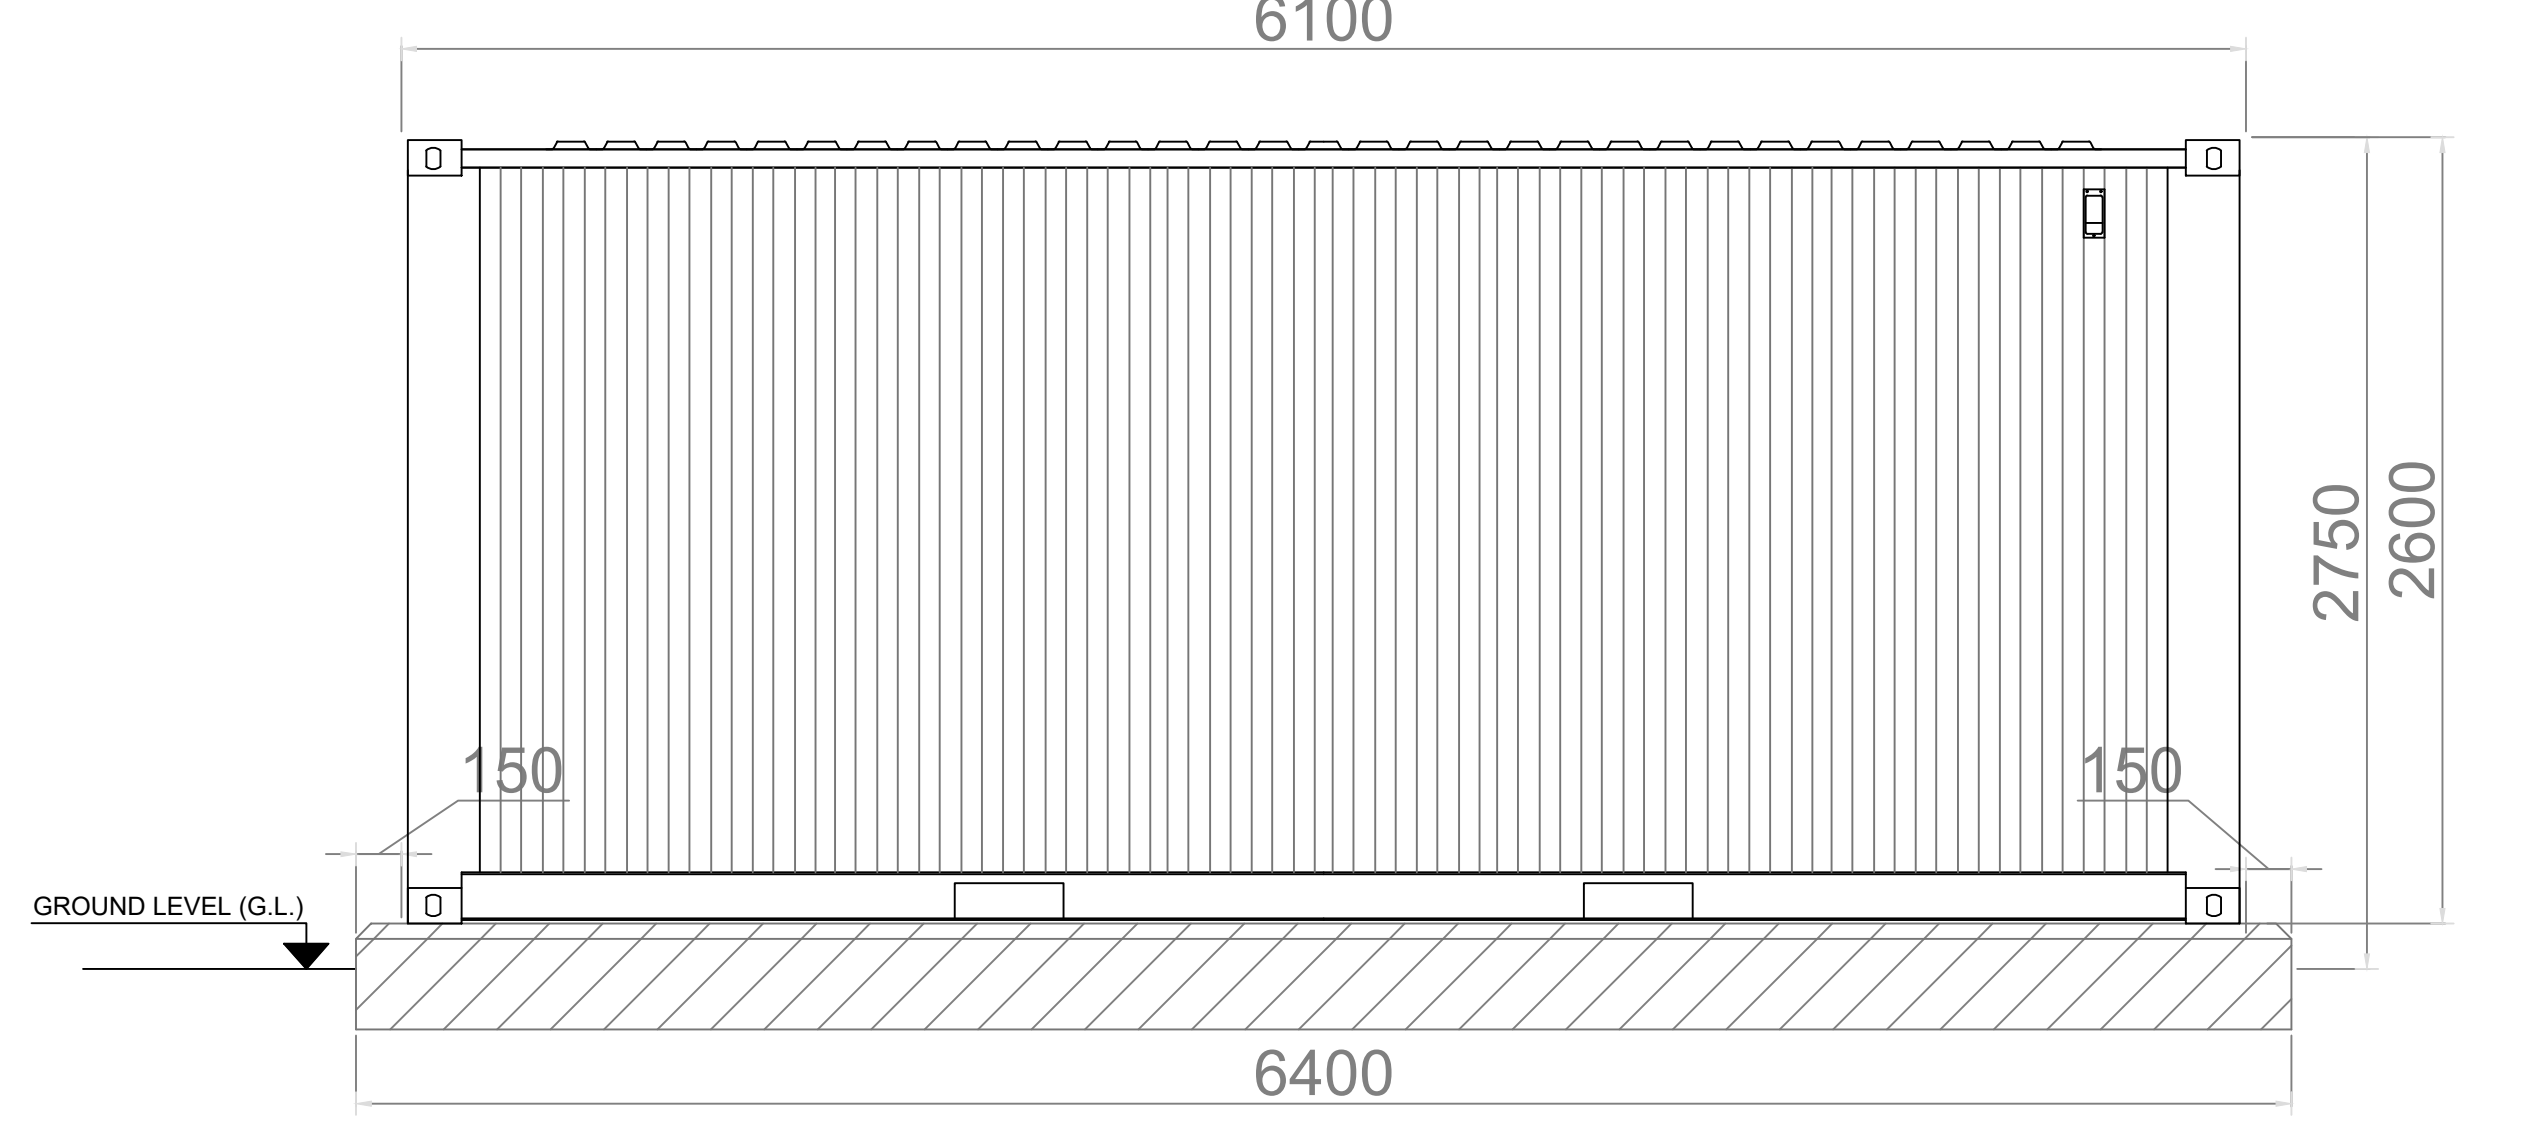

SIDE C

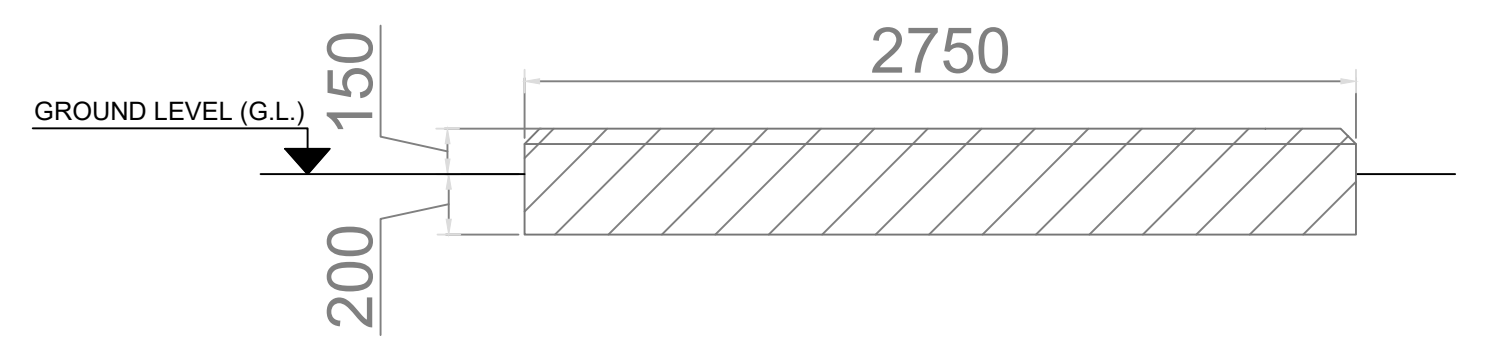

SECTION A-A'

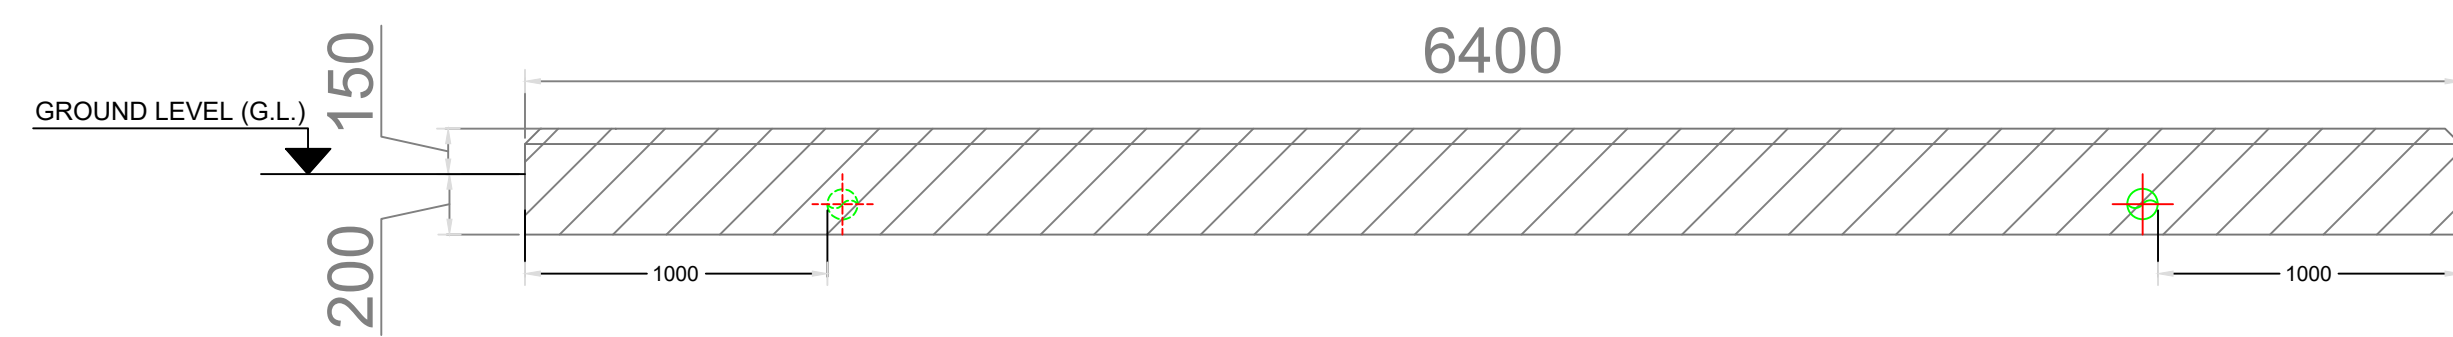

SECTION B-B'

NOTE

THE COLOR OF THE SUBSTATION IS MOSS GREEN
(RAL 6005)

2	15/04/20	COLOR REFERENCE	N.K.	S.O.	V.T.
1	13/09/19	AS BUILT	N.K.	S.O.	V.T.
REVISION	DATE	DESCRIPTION	PREPARED	CHECKED	APPROVED
OWNER			DESIGNER		
			 393 LORDSHIP LANE, N17 6AE, LONDON, UK		
ISSUED FOR PLANT PROJECT		HALL FARM PHASE II SOLAR PLANT			
DWG TITLE					DWG NUMBER
SPARE PART'S CONTAINER LAYOUT					HLF-D-10
DESIGN PHASE					
AS BUILT					
			FILE NAME	CLASSIFICATION	SHEET
DATE	PREPARED	CHECKED	APPROVED		A0
SEP 2019	N.K.	S.O.	V.T.		
SIGNATURES & STAMPS				SCALE	1:25