





LEGEND

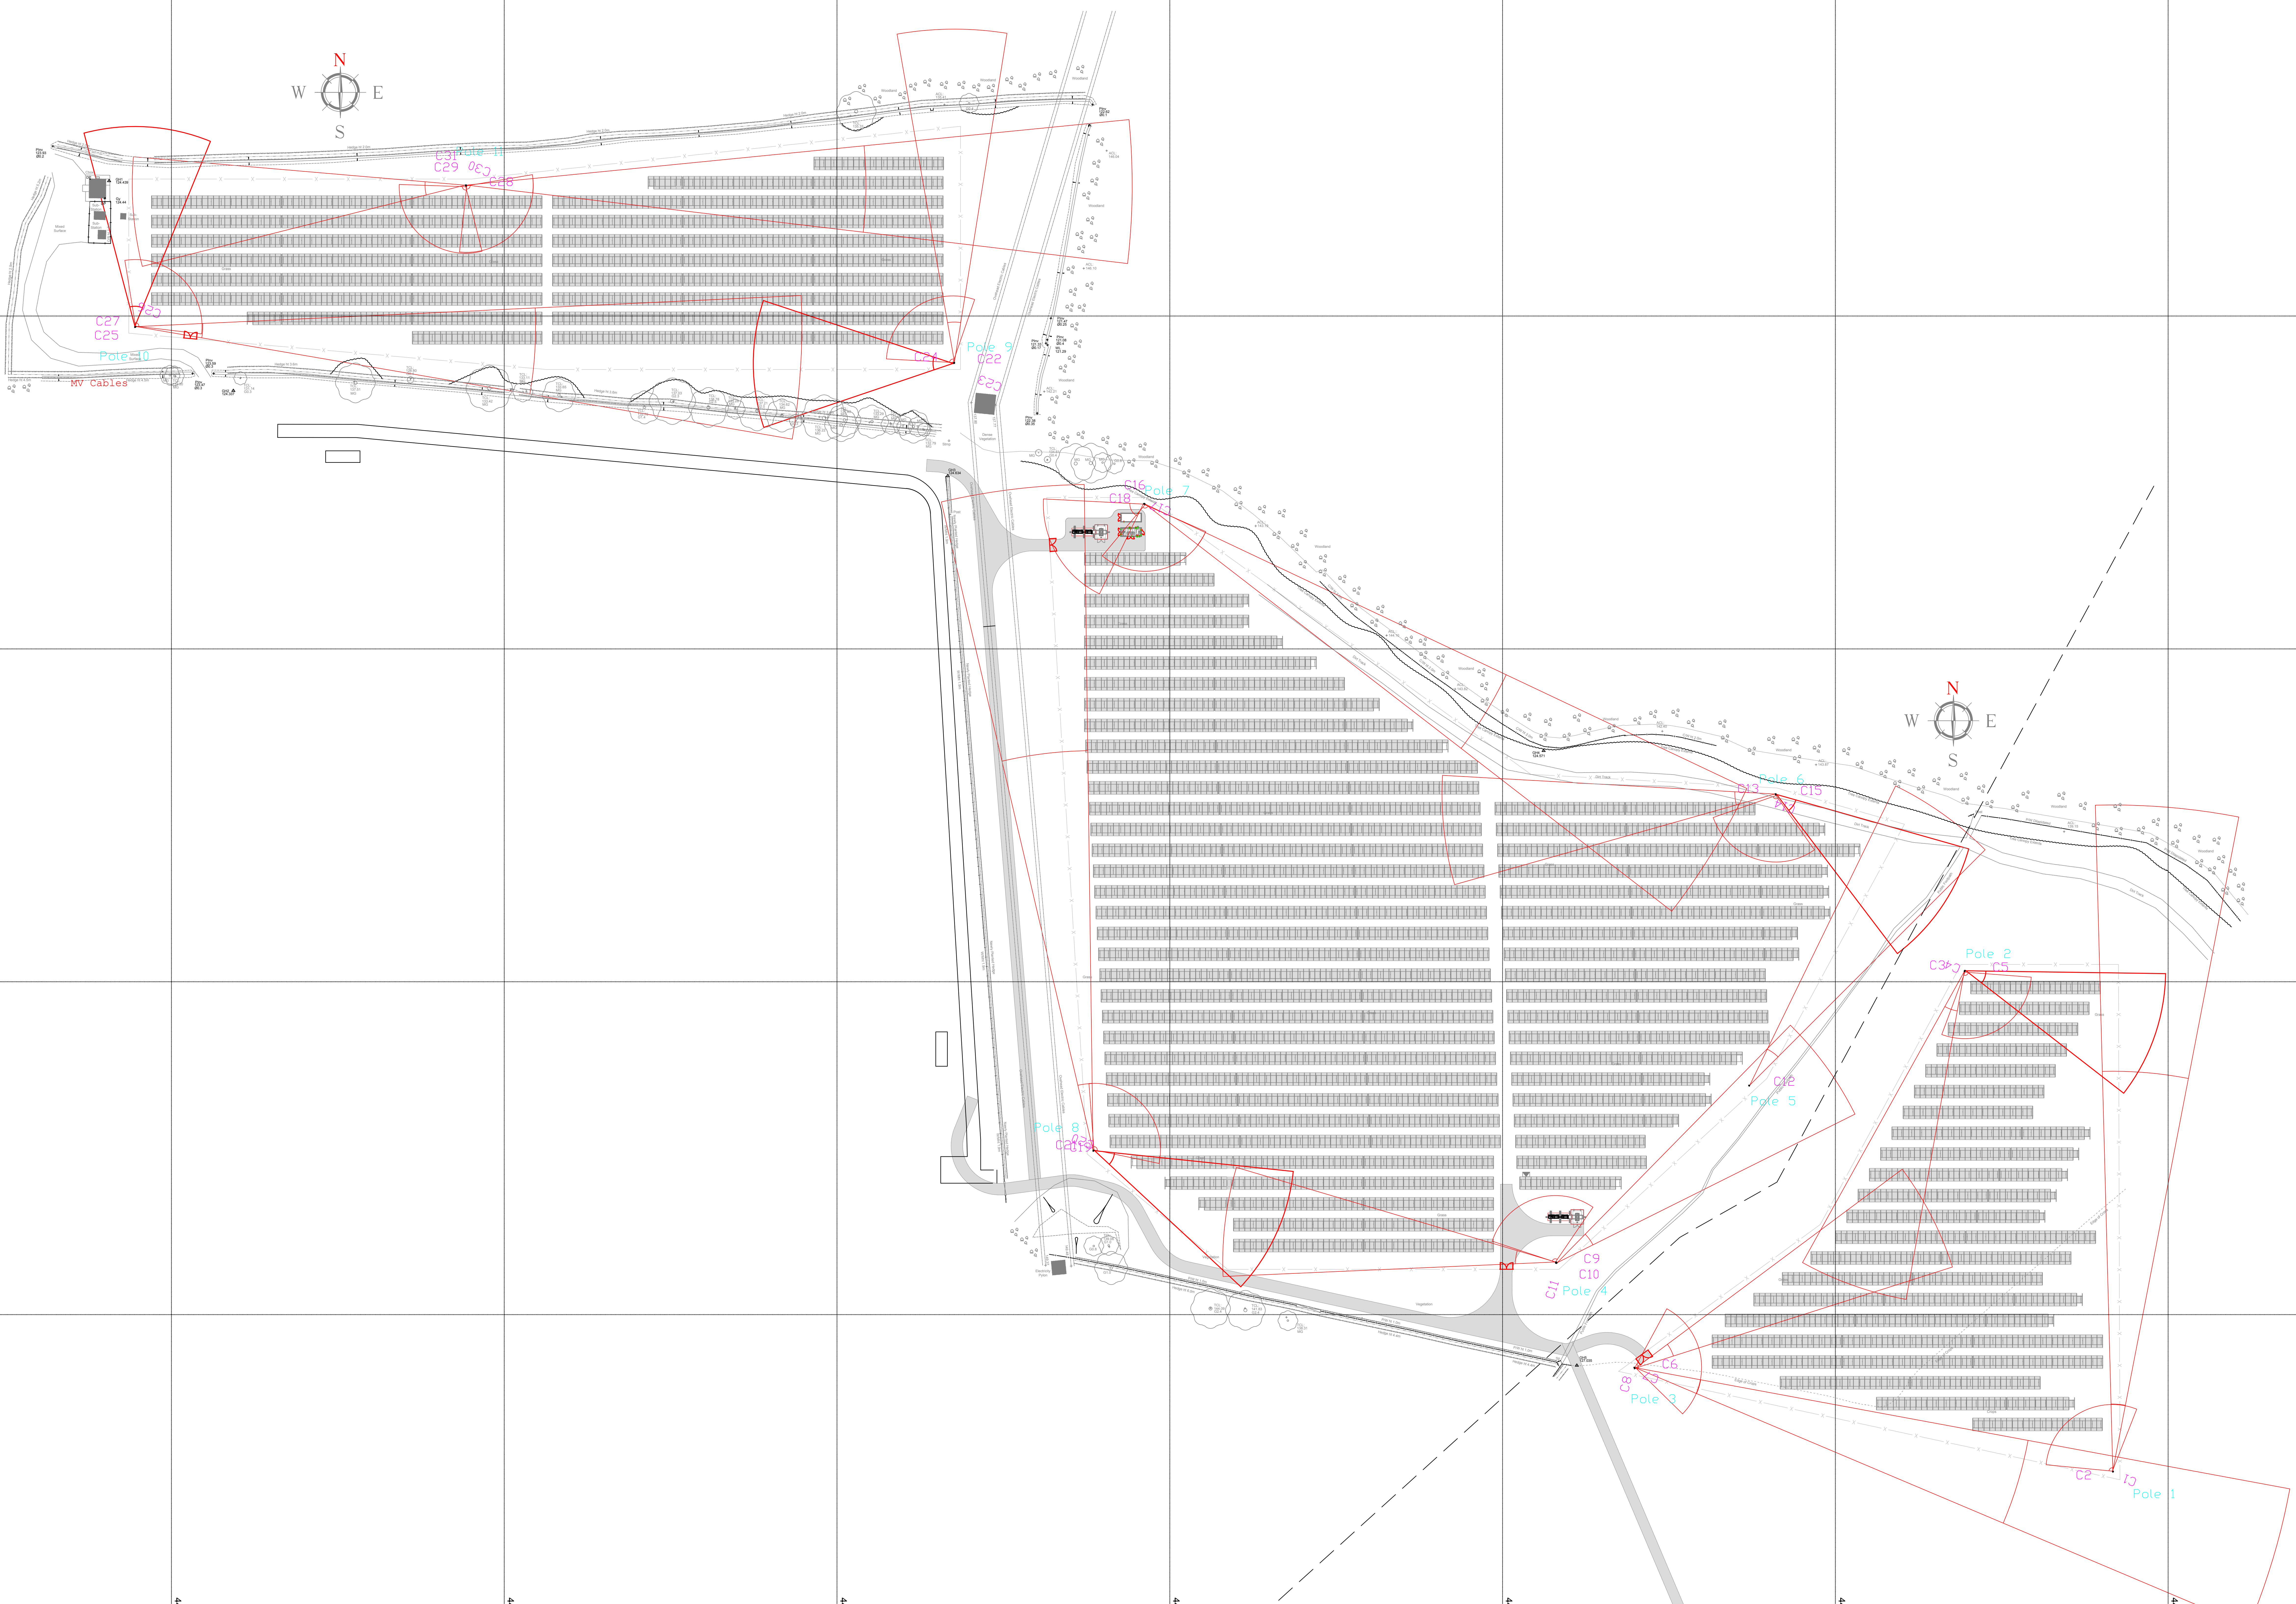

2MP WDR IR BULLET NETWORK CAMERA

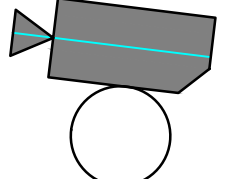

CAMERA COVERAGE

1	13/09/19	AS BUILT	N.K.	S.O.	V.T.
A	01/03/19	FIRST ISSUE	N.K.	S.O.	V.T.
REVISION	DATE	DESCRIPTION	PREPARED	CHECKED	APPROVED
OWNER			DESIGNER		
			 393 LORDSHIP LANE, W7 6AE, LONDON, UK		
ISSUED FOR PLANT PROJECT		HALL FARM PHASE II SOLAR PLANT			
DWG TITLE				DWG NUMBER	
SECURITY SYSTEM LAYOUT				HLF-CS-02	
DESIGN PHASE AS BUILT					
DATE	PREPARED	CHECKED	APPROVED	FILE NAME	CLASSIFICATION
SEP 2019	N.K.	S.O.	V.T.		
SIGNATURES & STAMPS				SHEET	SCALE
				A0+	1:500