
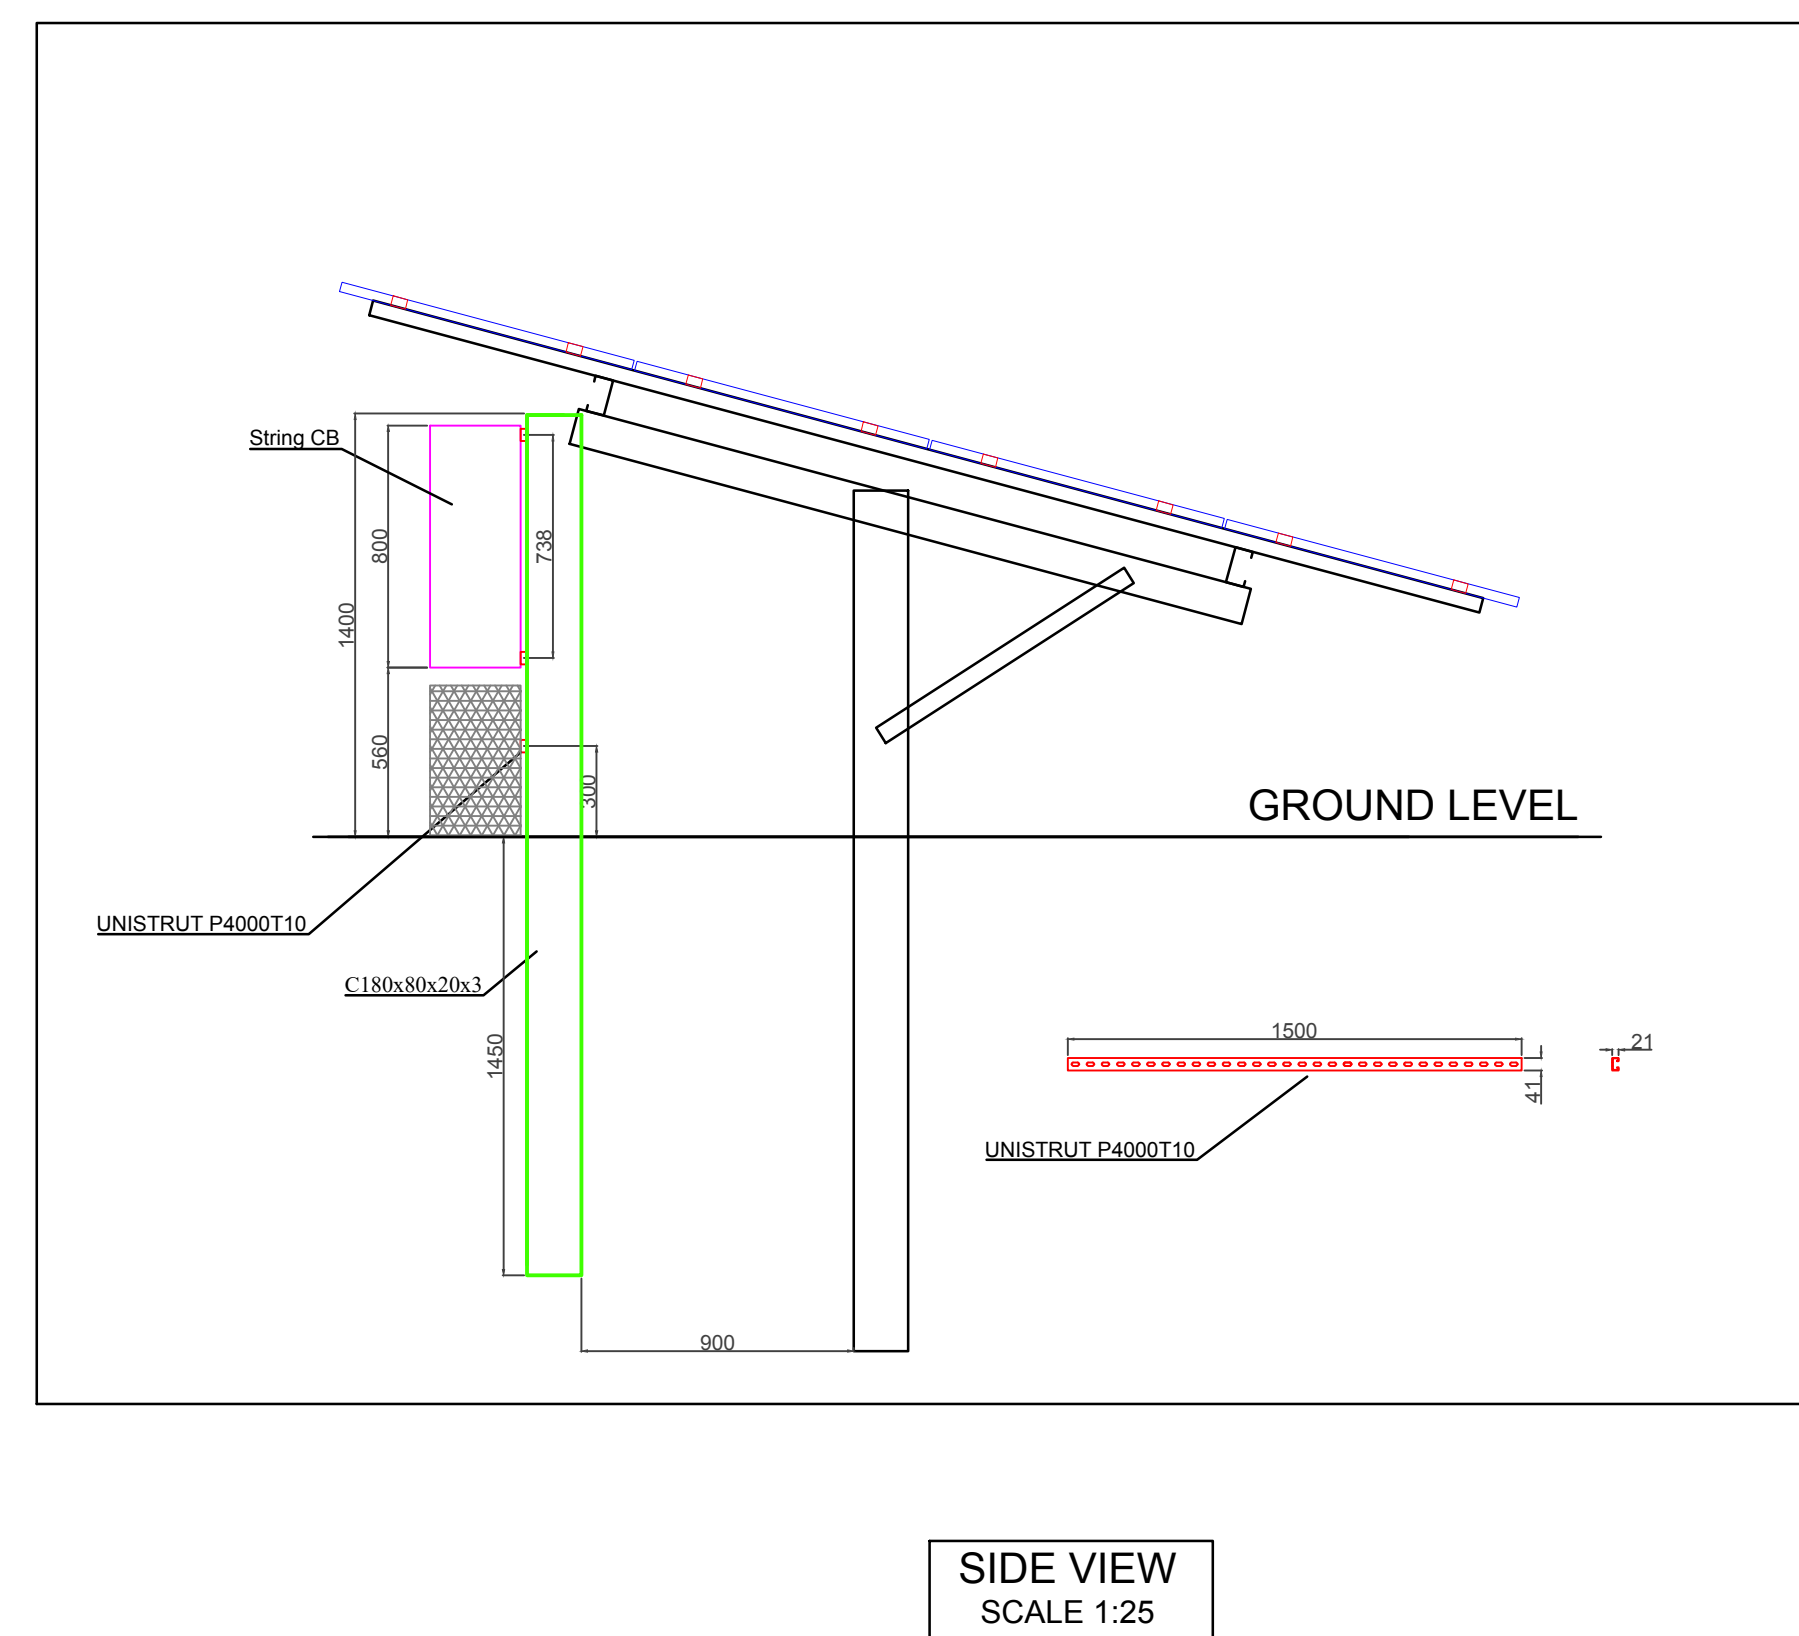
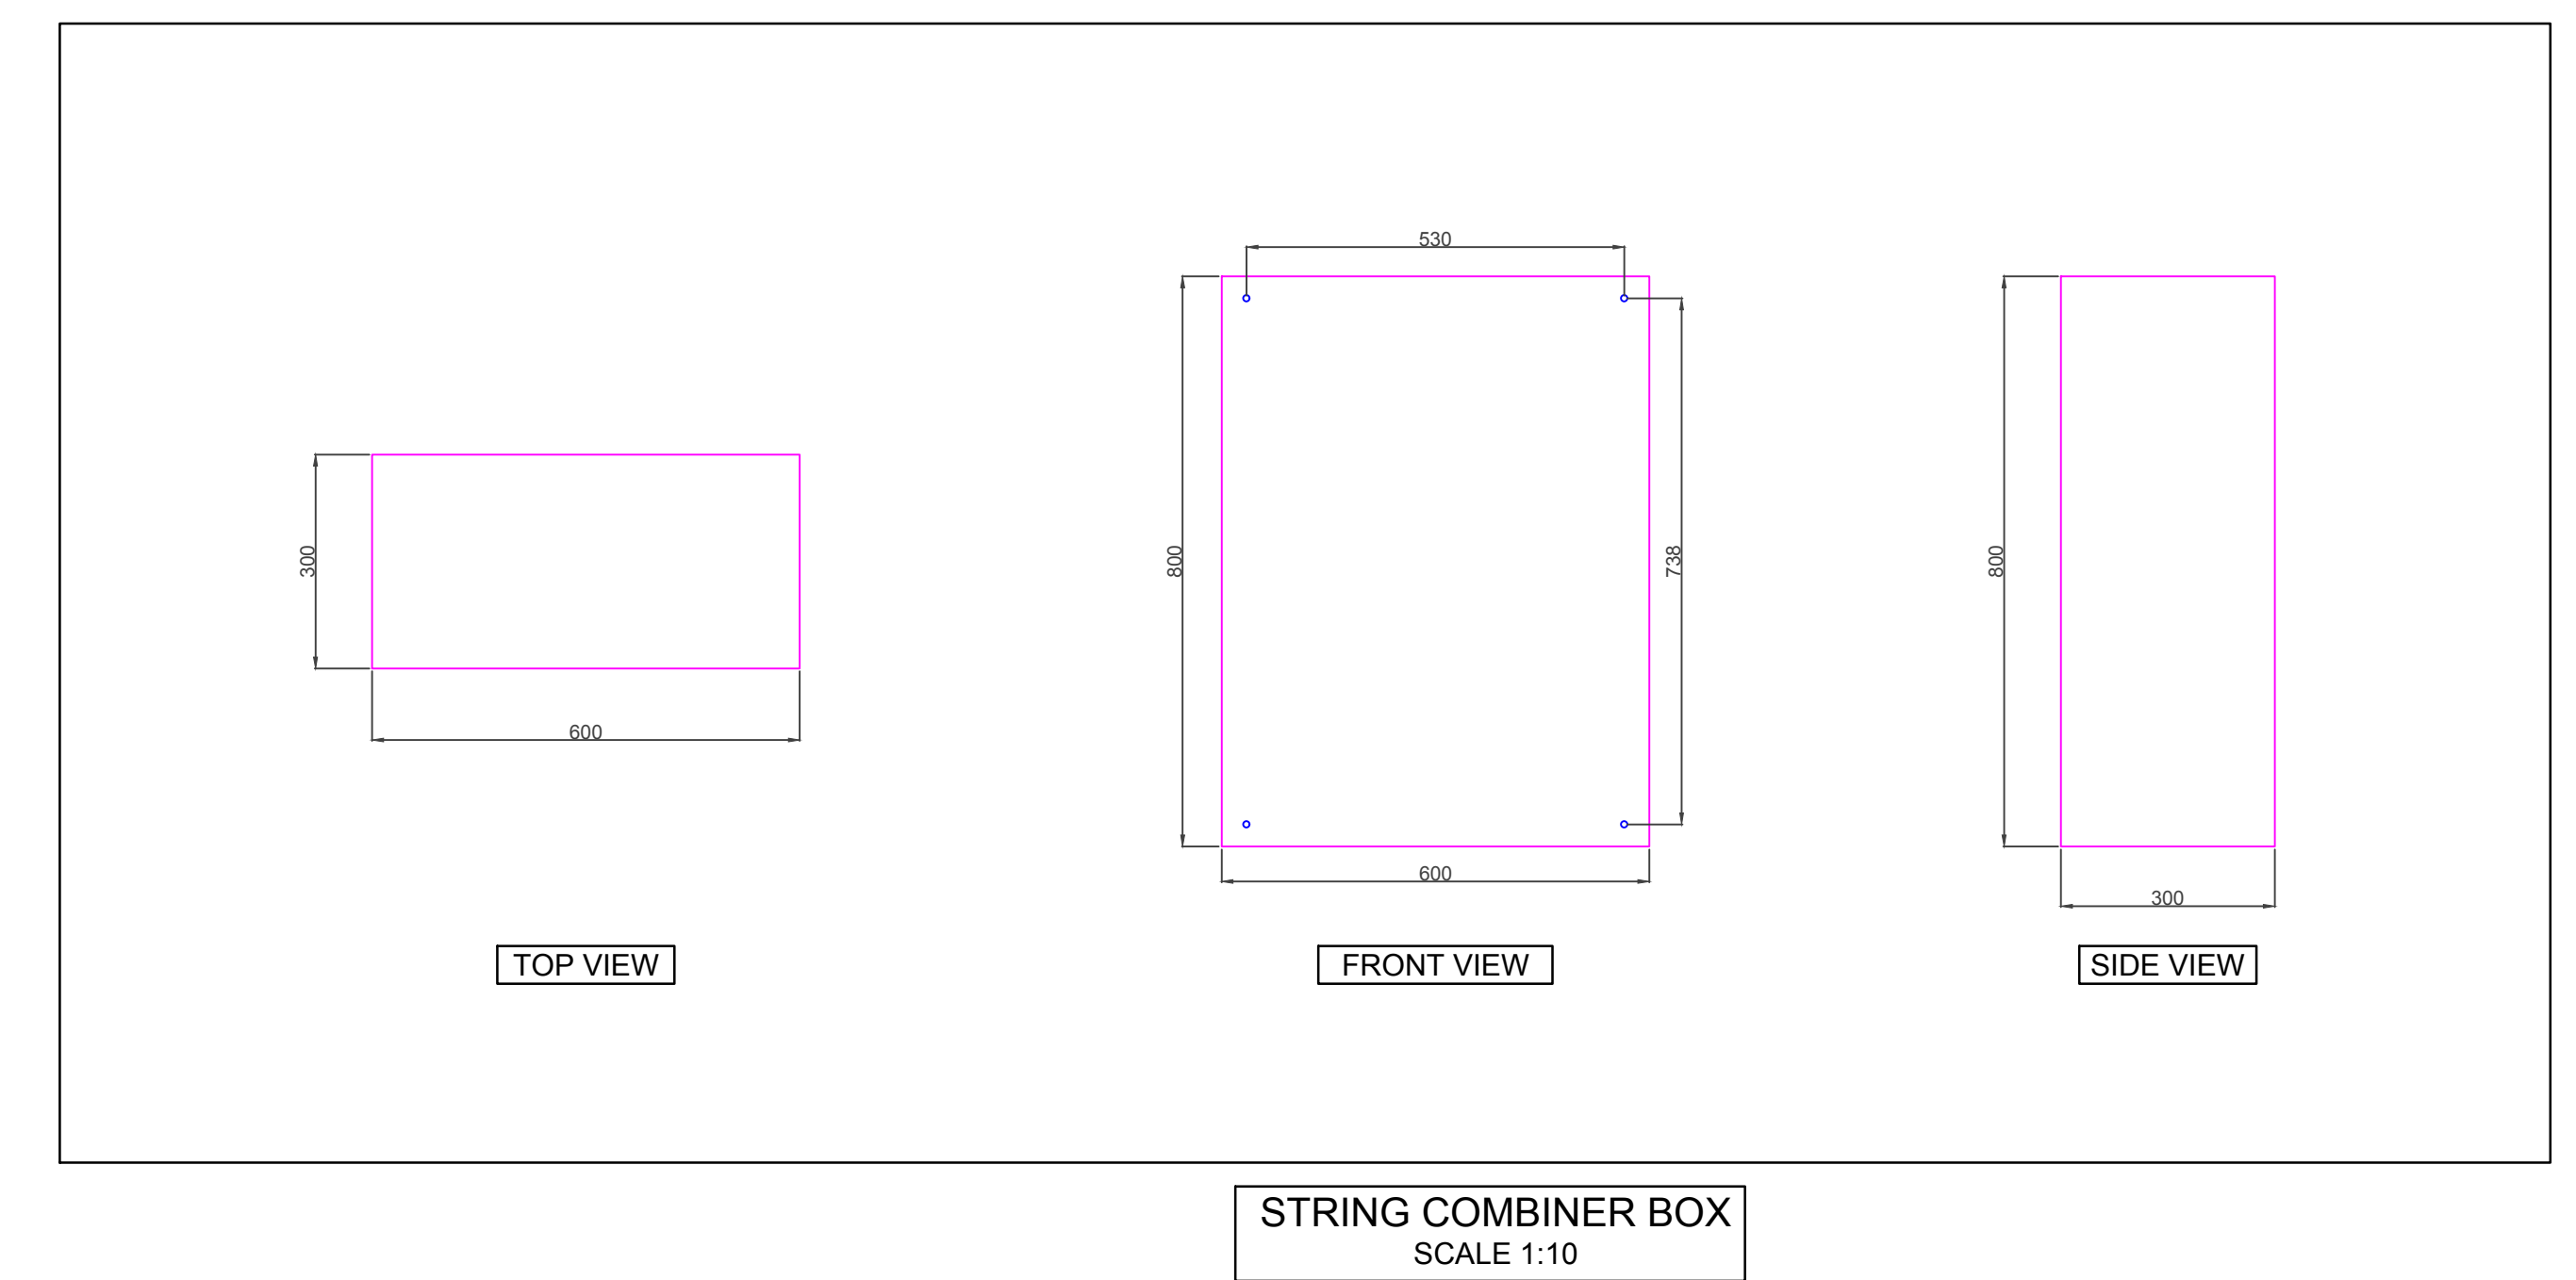
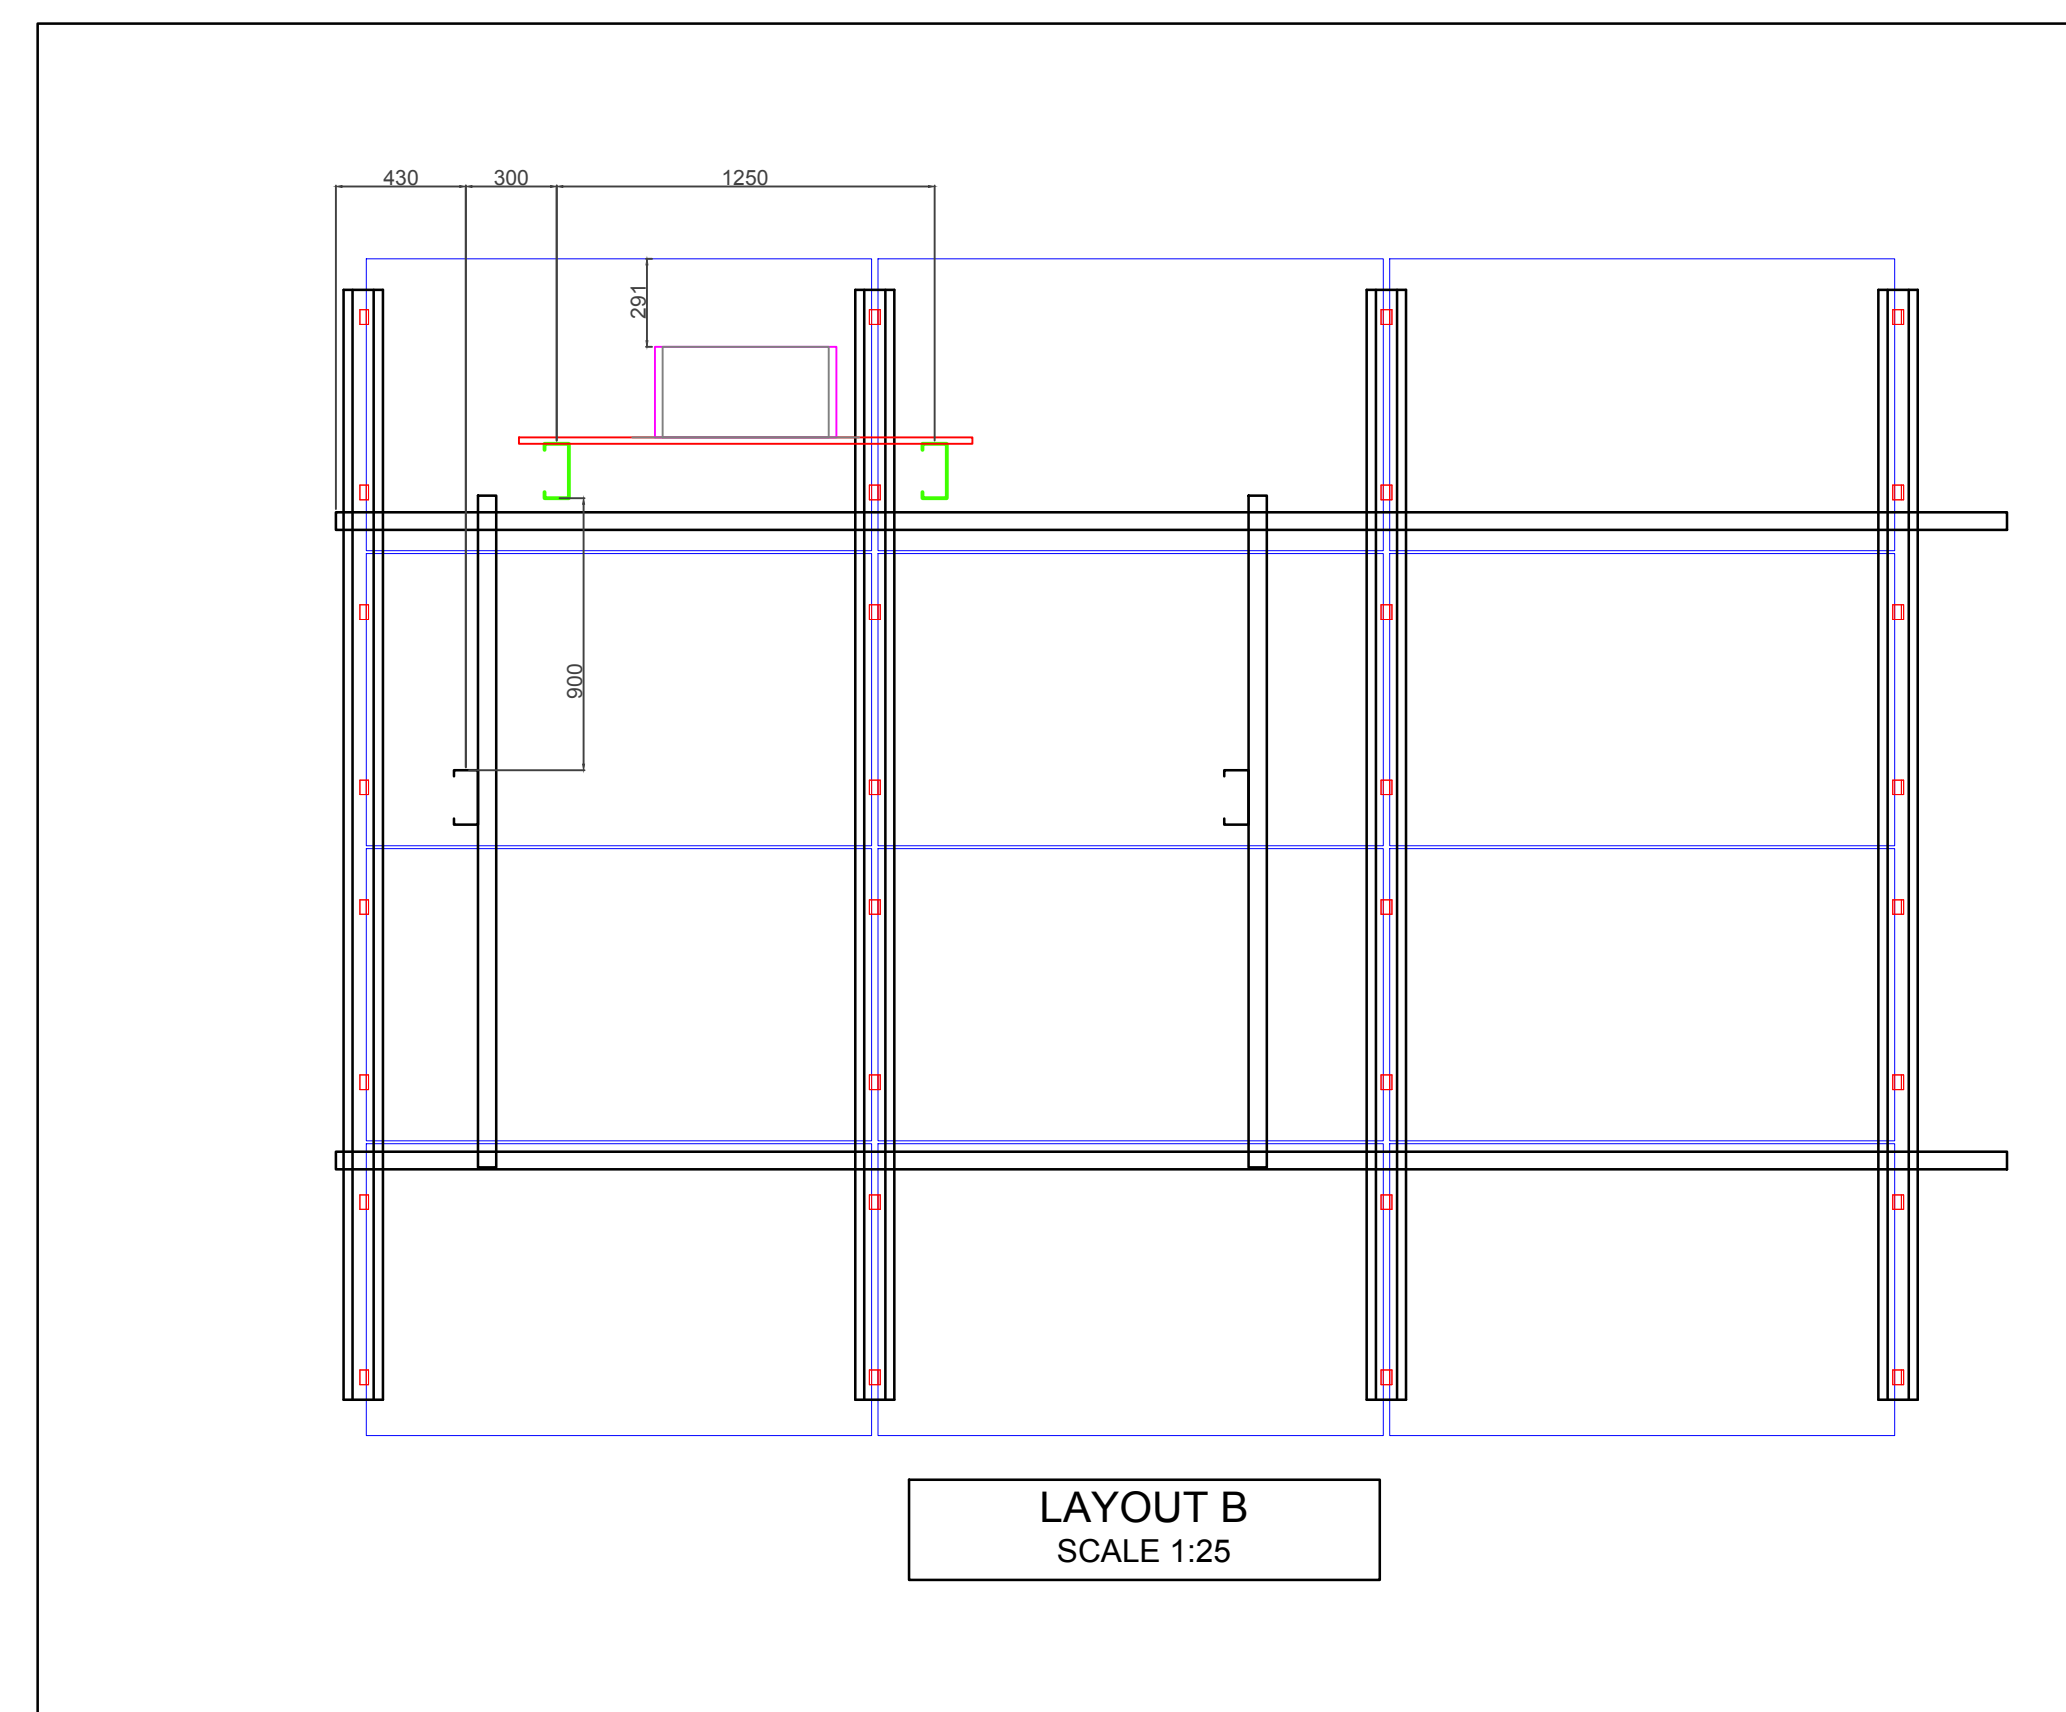


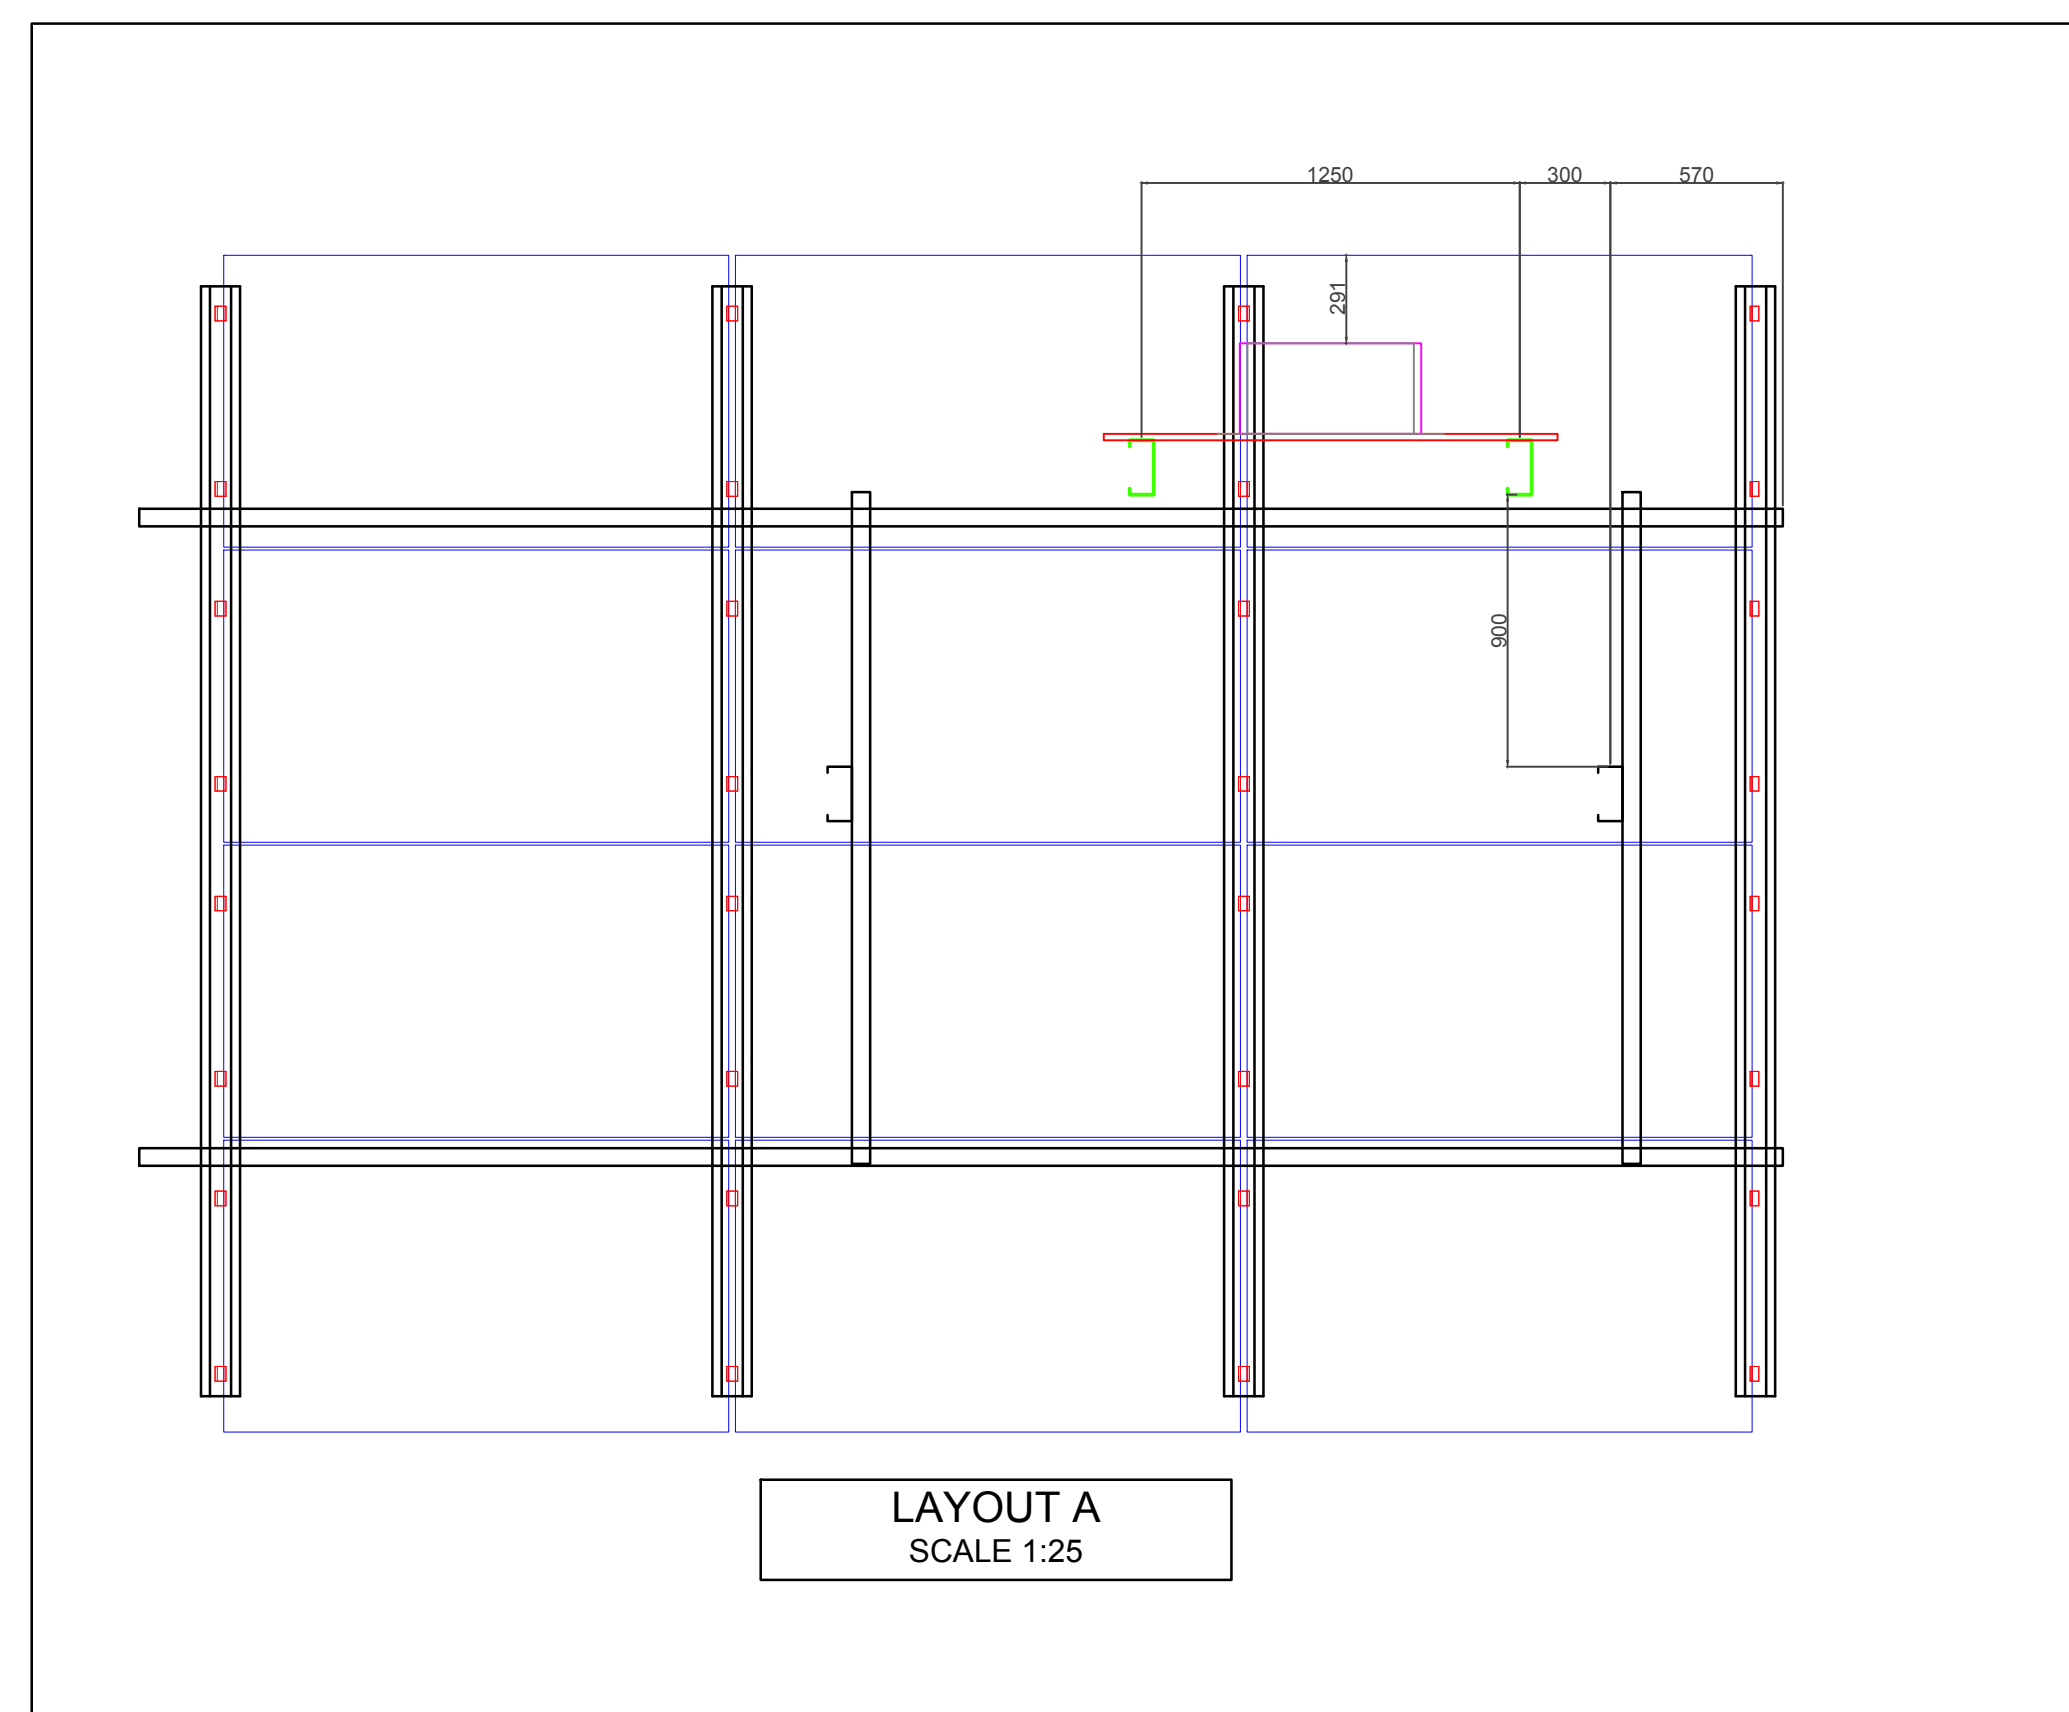

1	13/09/19	AS BUILT				N.K.	S.O.	V.T.	
A	31/01/19	FIRST ISSUE				N.K.	S.O.	V.T.	
REVISION	DATE	DESCRIPTION				PREPARED	CHECKED	APPROVED	
OWNER						DESIGNER			
						 Geometrical Engineering Mechanical Electrical Construction 393 LORDSHIP LANE, N7 6AE, LONDON, UK			
ISSUED FOR PLANT PROJECT		HALL FARM PHASE II SOLAR PLANT							
DWG TITLE						DWG NUMBER			
COMBINER BOX MOUNTING DETAIL						HLF-ME-02			
AS BUILT									
				FILE NAME	CLASSIFICATION	SHEET	SCALE		
DATE	PREPARED	CHECKED	APPROVED			A1	1:25		
SEP 2019	N.K.	S.O.	V.T.						
SIGNATURES & STAMPS									