


Former Boundary Elevation looking North
Scale 1:200



Proposed Boundary Elevation (as-built) looking North
Scale 1:200

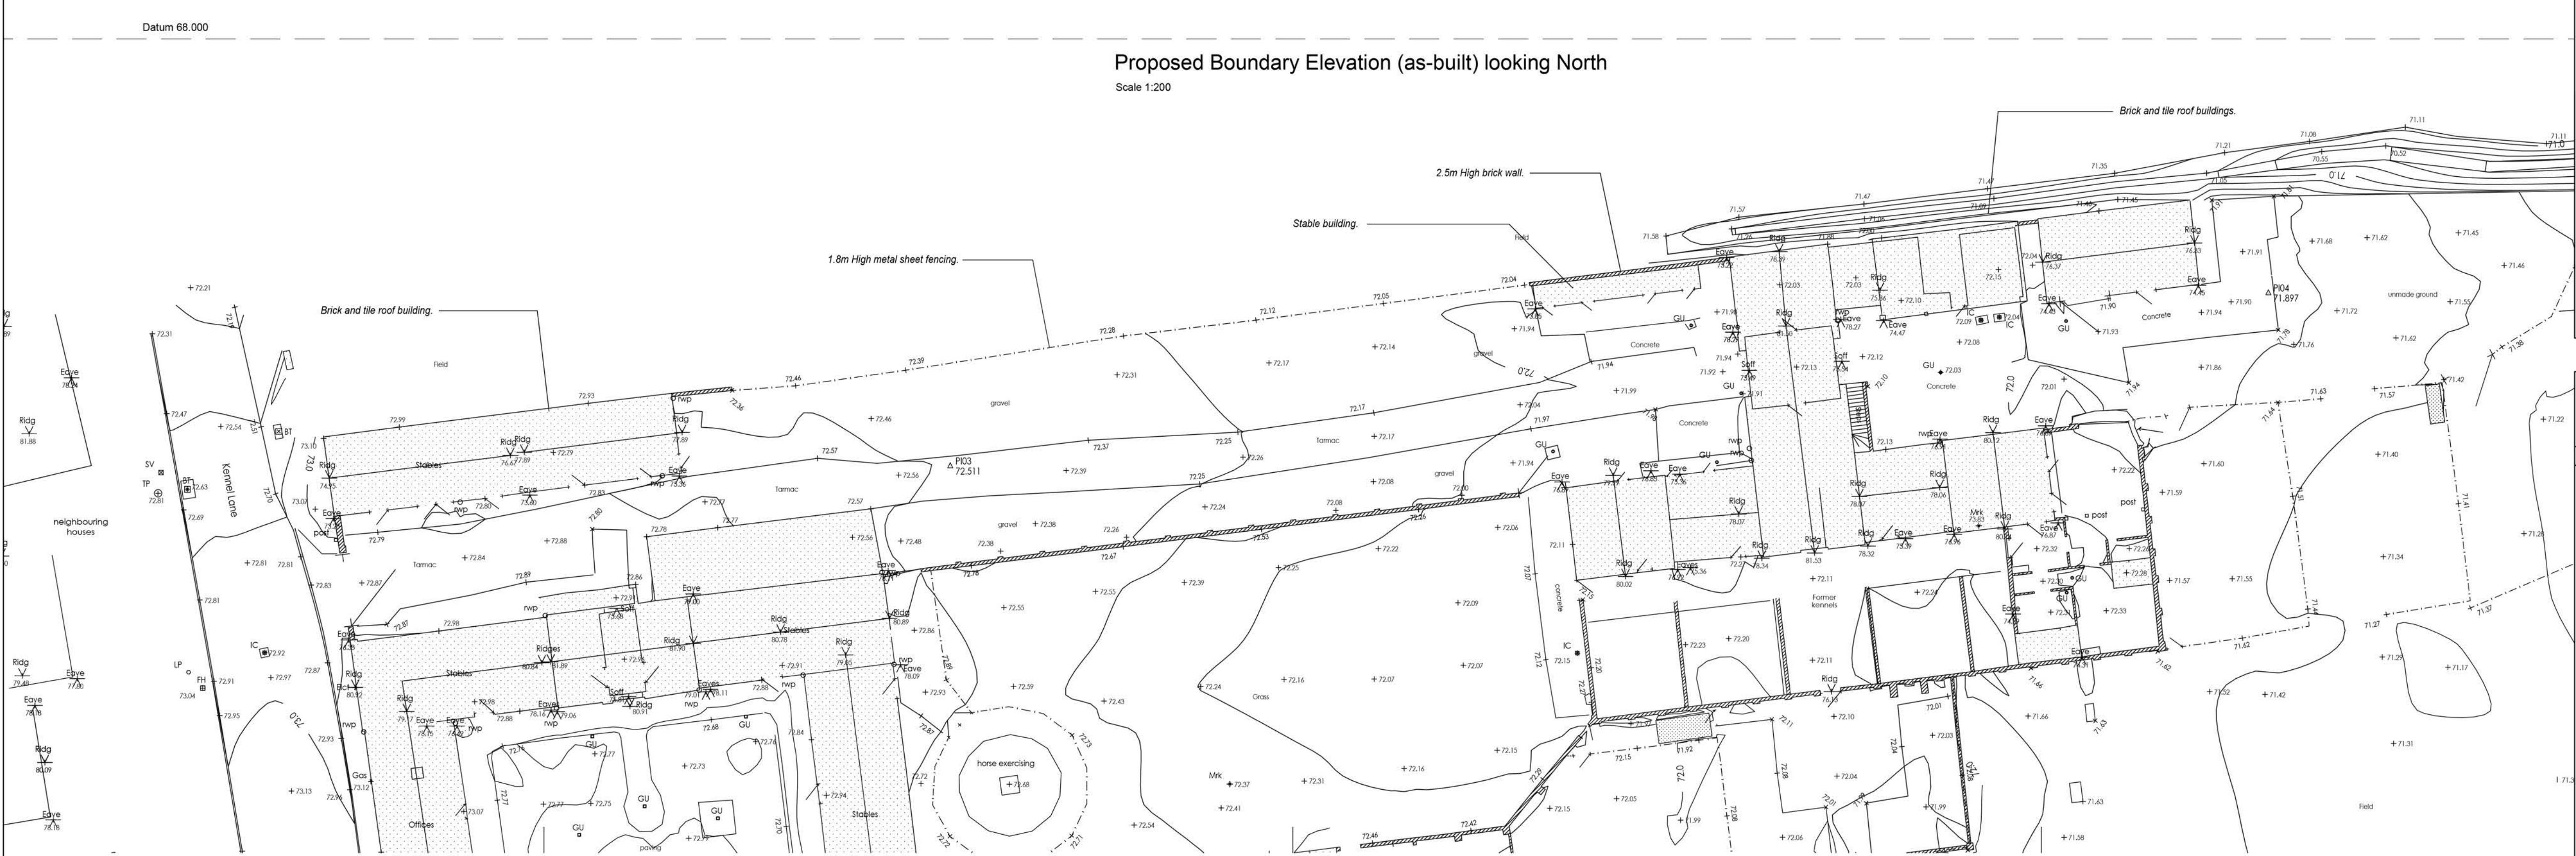

Site Extract
Showing former Northern Boundary Condition
Scale 1:250



Evidential Photographs

The Builder is to check and verify all buildings and site dimensions, levels and sewer invert levels prior to commencement of work.
Do not scale off this drawing, work to figured dimensions only.
This drawing must be read and checked with all structural and relevant specialist drawings.
The Builder is to comply in all respects with the current Building Regulations and latest Codes of Practice.

revisions		
No.	Description	Date
1		

BAILEY DESIGN LIMITED
ARCHITECTURAL, PLANNING & DEVELOPMENT CONSULTANTS
43a MITCHELLS COURT LOWER GUNGATE TAMWORTH
STAFFORDSHIRE B79 7AS
Email tim@baileysdesign.ltd.uk
Tel: 01827 314962

**RESIDENTIAL RE-DEVELOPMENT AT
FORMER KENNELS, KENNEL LANE,
WITHERLEY.**

Northern Boundary Condition			
SCALE	DATE	DRAWN	JOB No.
As Noted @ A1	Jun 24	ae	9754.123

Copyright of this drawing and of work executed from it remain the property of BD Ltd.