
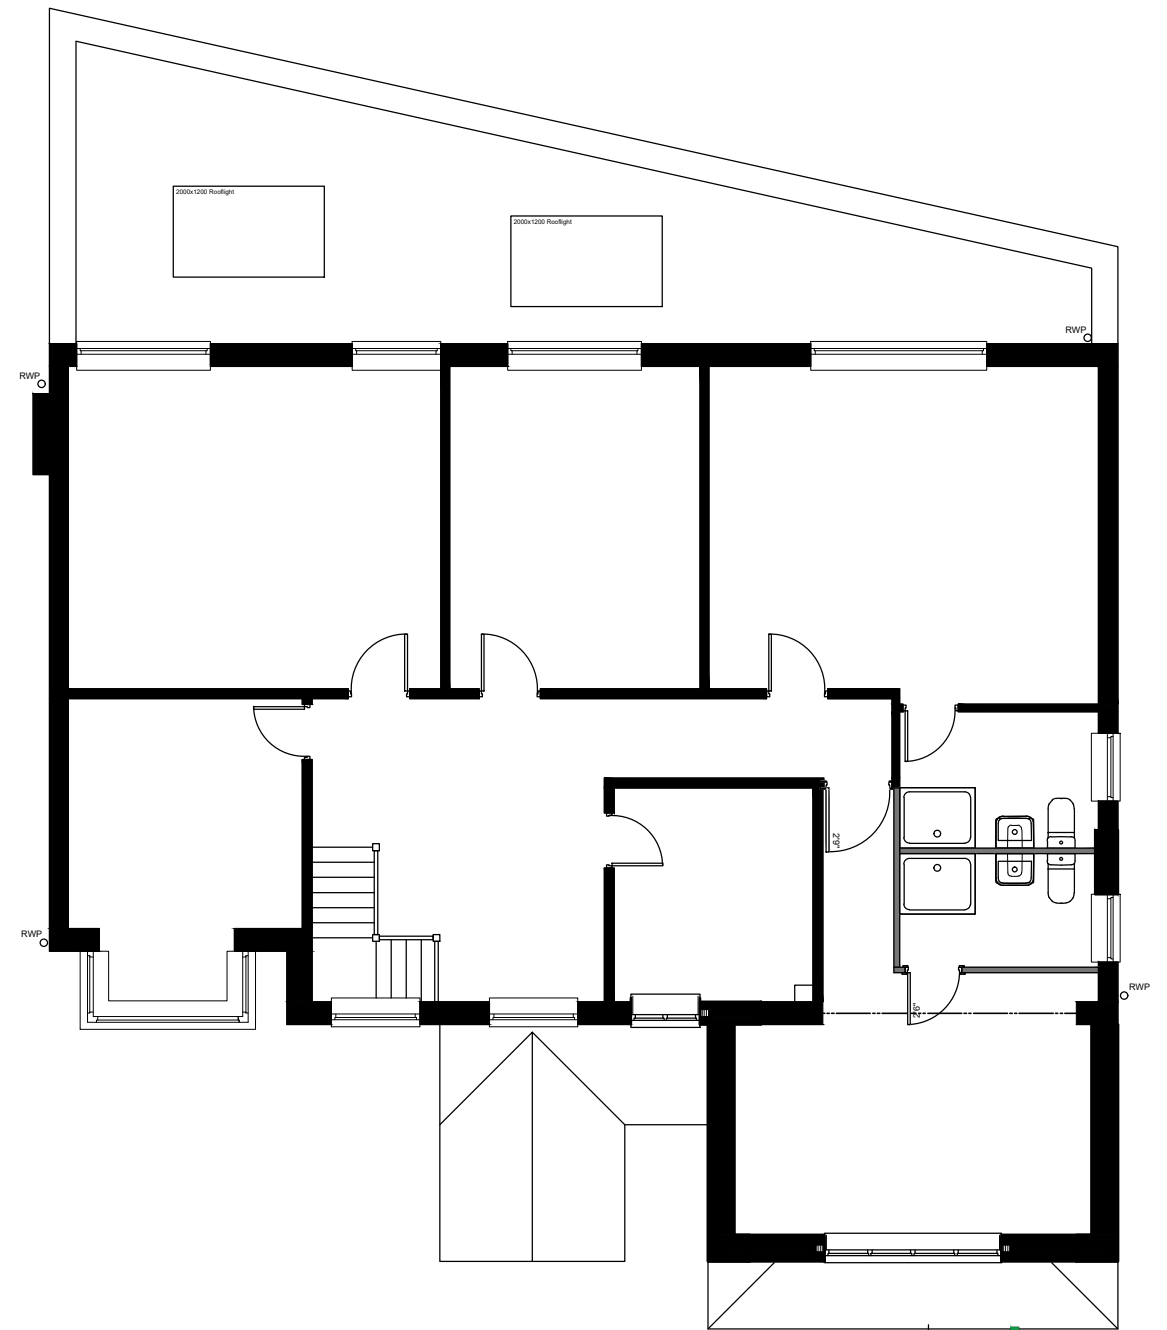


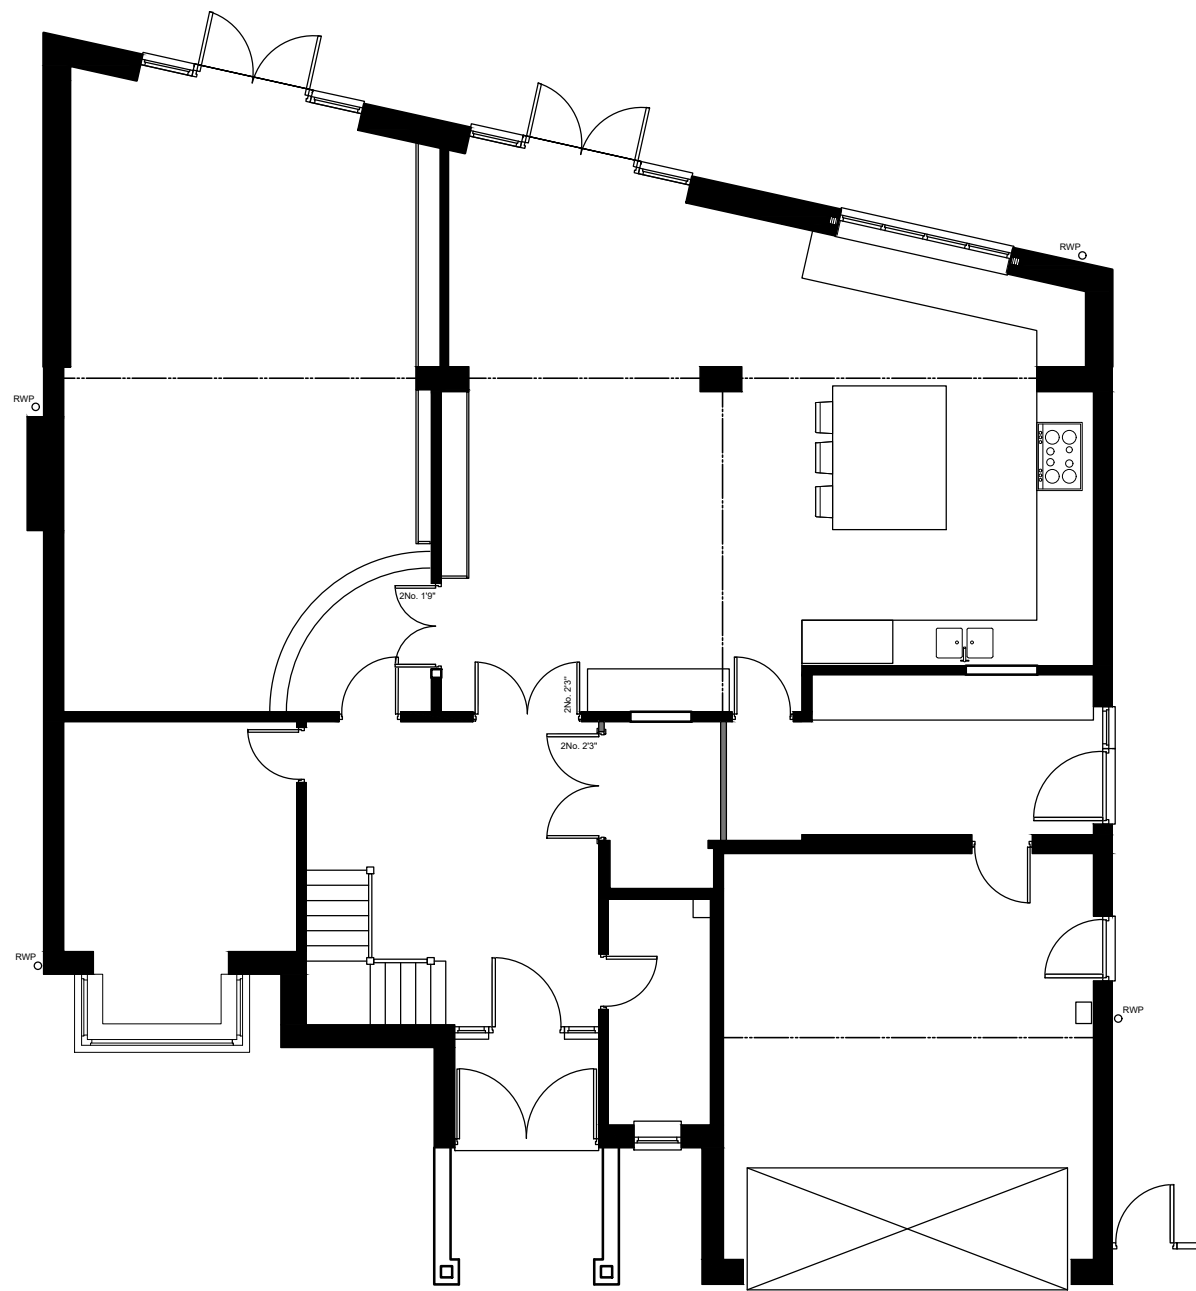

Drawing Status:		PLANNING
Revision Notes:		Rev.A - 30.06.2025 - As-built information added.
Client:		Mr & Mrs Forster-Smith
Project:		3 Cambourne Road, Burbage. LE10 2BG
Drawing Title:		Existing Floor Plans
Drawing Number:	Revision:	
Forster-Smith-001	A	
Scale:	Date:	
1:100@A3	July 2024	
Drawn By:	Checked By:	
Igb	Igb	

Drawings are for L.A. approval only and do not constitute construction drawings.
All dimensions to be checked on site before works commence. Agent to be advised of any discrepancies.

Existing Floor Plans

0 500 1000 2000
SCALE: 1:100 @ A3