
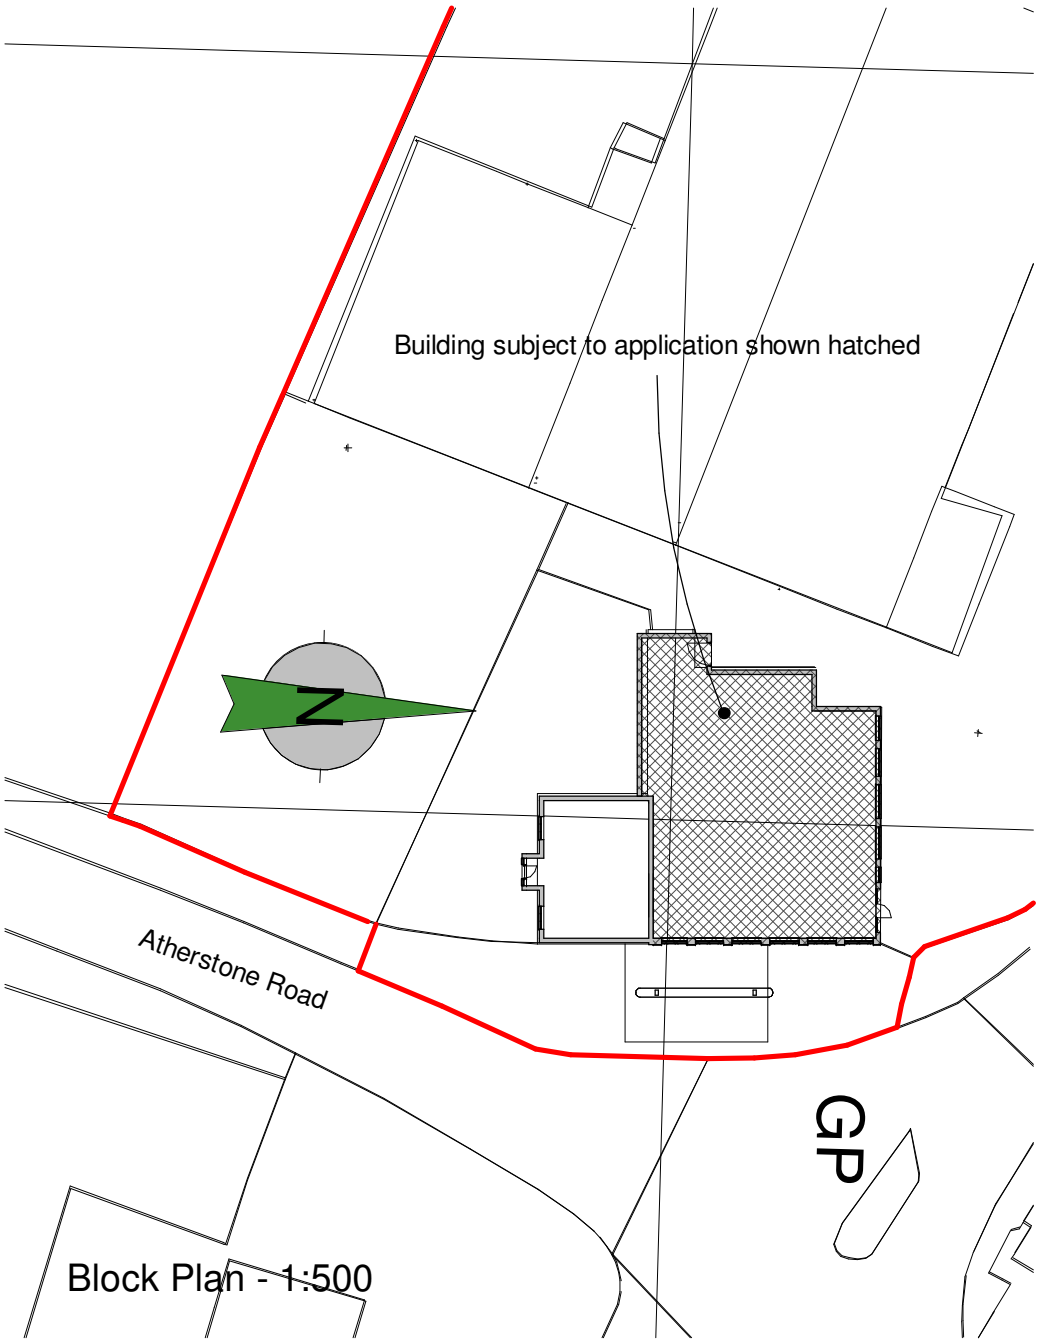


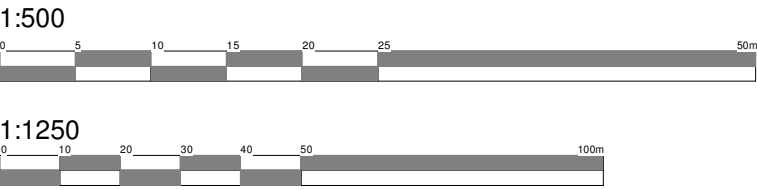

Site Location Plan - 1:1250

Client MAC Developments				hayward ARCHITECTS LTD	
Project As-Built Atherstone Road Pinwall	Scale 1:500 & 1:1250	Sheet A3	Job No. 23/27	19 Station Road Hinckley Leicestershire LE10 1AW Tel: 01455 635 665 Fax: 01455 618 971 www.hayward-architects.co.uk	
	Date Dec 24	Drawing No. 14			
Drawing Site Plans	Author LJW	Checked by -	Drawing Status PLANNING		

THE COPYRIGHT OF THIS DRAWING IS VESTED IN HAYWARD ARCHITECTS LTD.
REPRODUCTION IN ANY FORM, EITHER IN WHOLE OR IN PART IS FORBIDDEN WITHOUT THE PRIOR WRITTEN PERMISSION
OF THE COPYRIGHT HOLDER. DO NOT SCALE FROM DRAWING AND ONLY FIGURED DIMENSIONS ARE TO BE USED