





Front Elevation

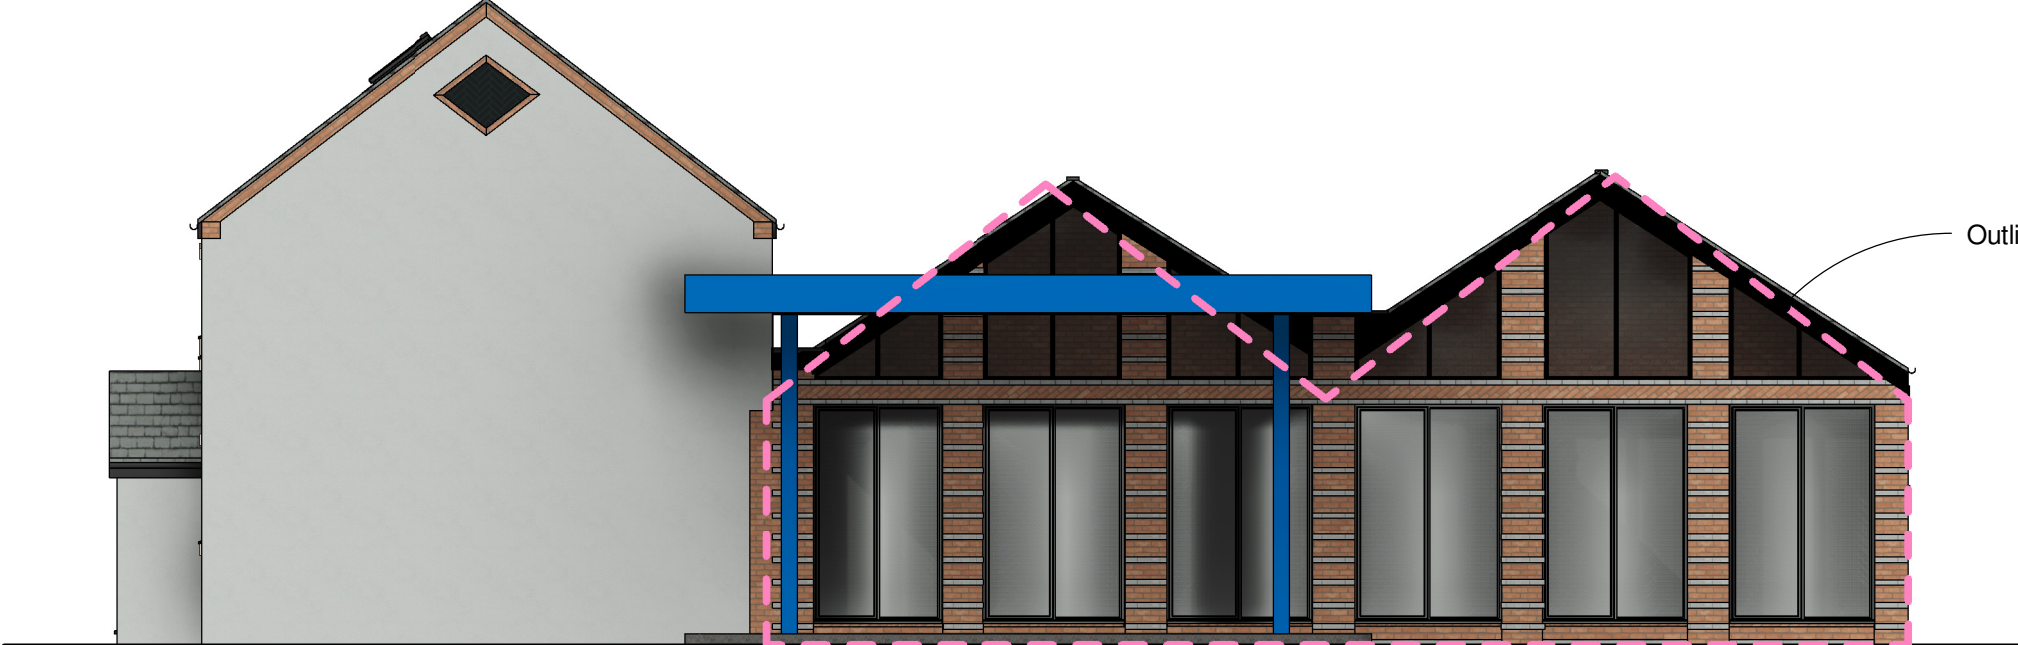

Partial Side Elevation

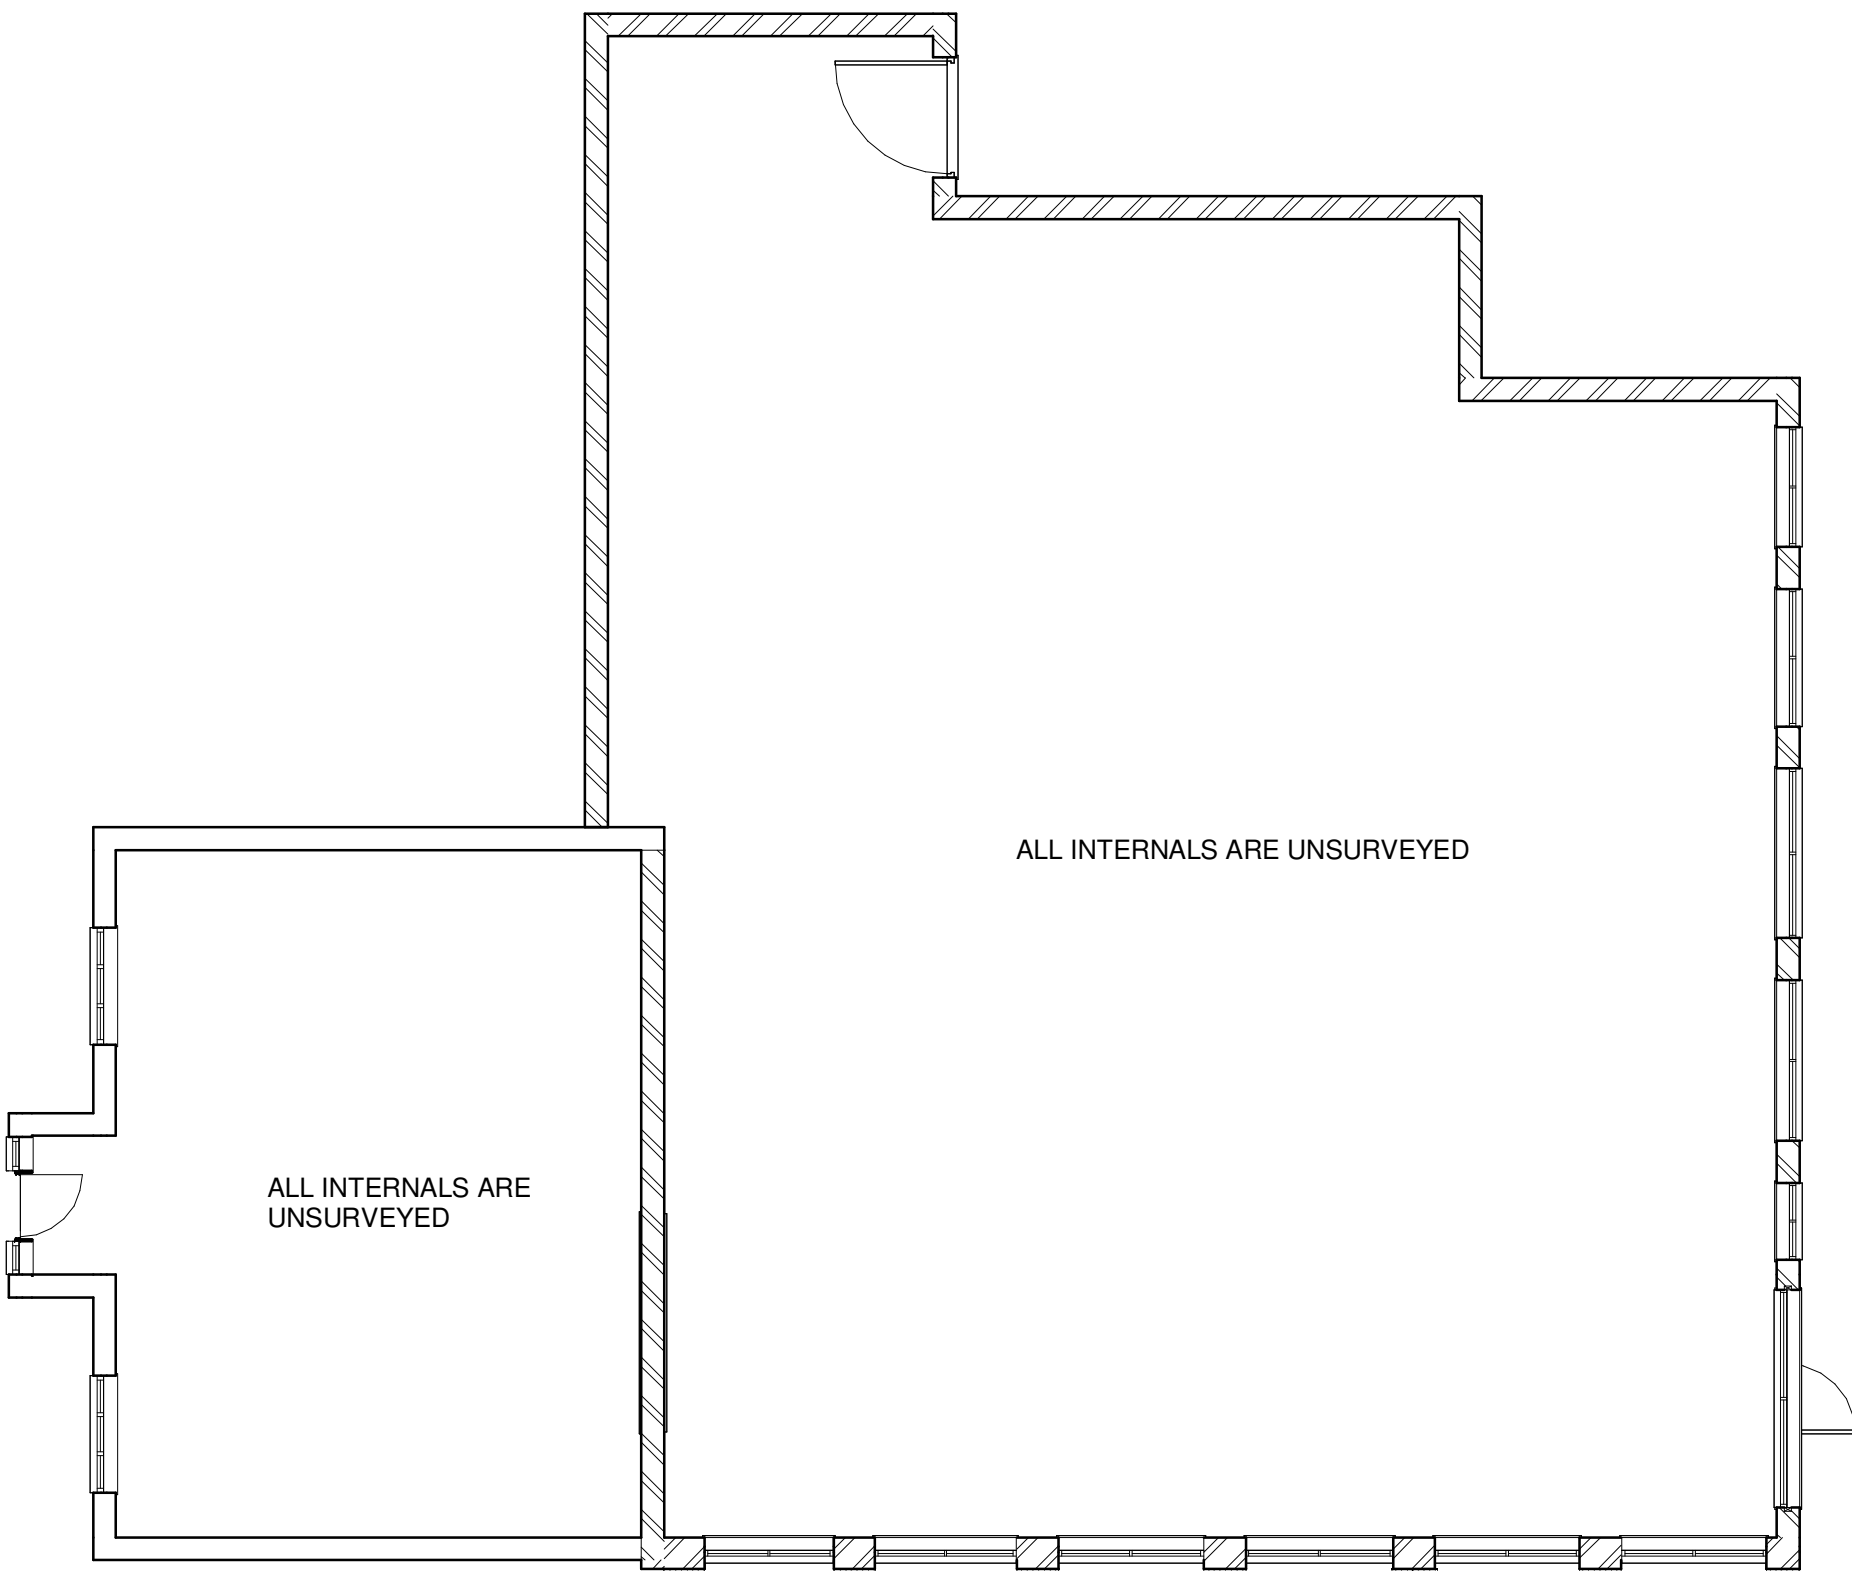

Site Plan



Partial Side Elevation



3D View

01234510m

Client
MAC Developments

Project Title
As-Built
Atherstone Road/Sheepy Rd
Pinwall

Drawing Title
As-Built

Scale
1:100

Date
Dec 2024

Sheet
A2

Author
MEG

Checked by
LJW

Job No.
23/27

Drawing No.
15

Status
PLANNING

hayward
ARCHITECTS LTD

19 Station Road
Hinckley
Leicestershire
LE10 1AW

Tel: 01455 635 665
Fax: 01455 618 971
www.hayward-architects.co.uk

THE COPYRIGHT OF THIS DRAWING IS VESTED IN HAYWARD ARCHITECTS LTD.
REPRODUCTION IN ANY FORM, EITHER IN WHOLE OR IN PART, IS FORBIDDEN WITHOUT THE PRIOR WRITTEN PERMISSION
OF THE COPYRIGHT HOLDER. DO NOT SCALE FROM DRAWING AND ONLY FIGURED DIMENSIONS ARE TO BE USED