


07/01075/FUL
14 SEP 2007
INDEXED

Original Ground Floor Plan

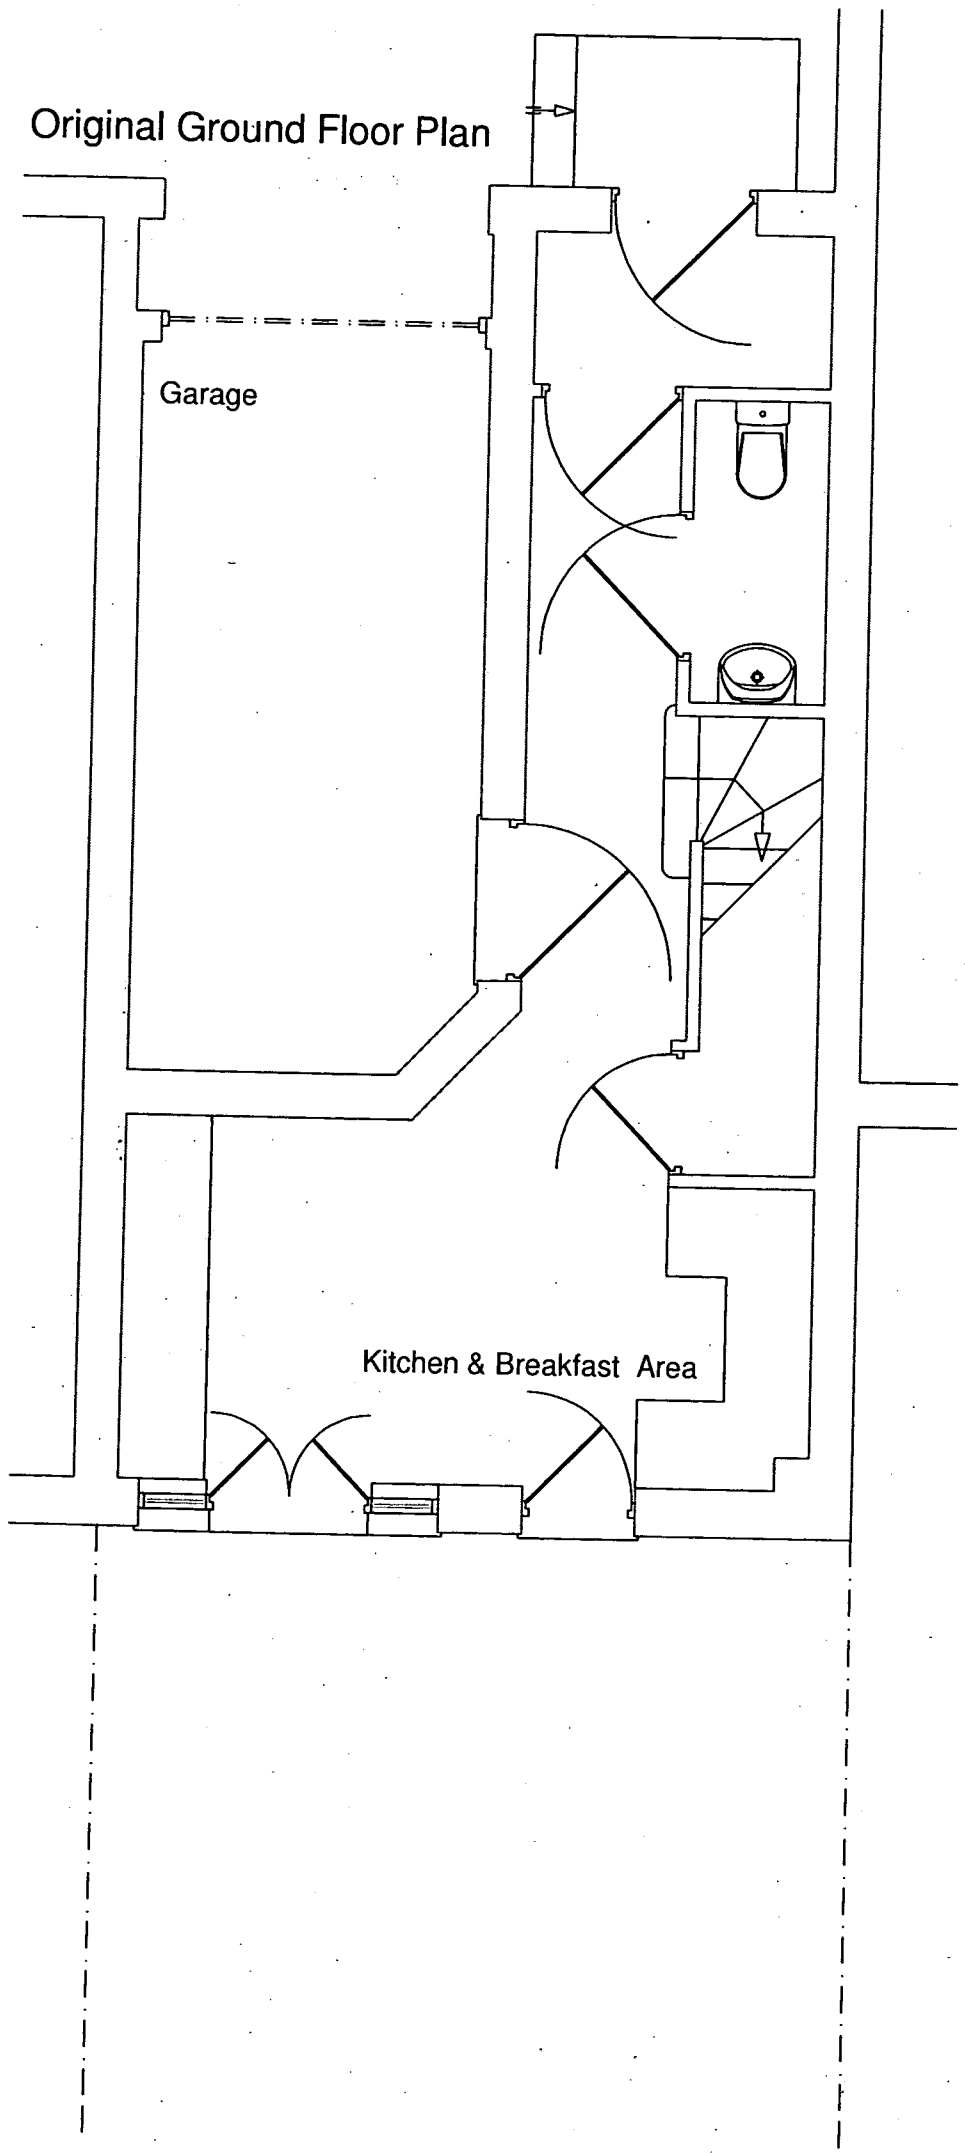

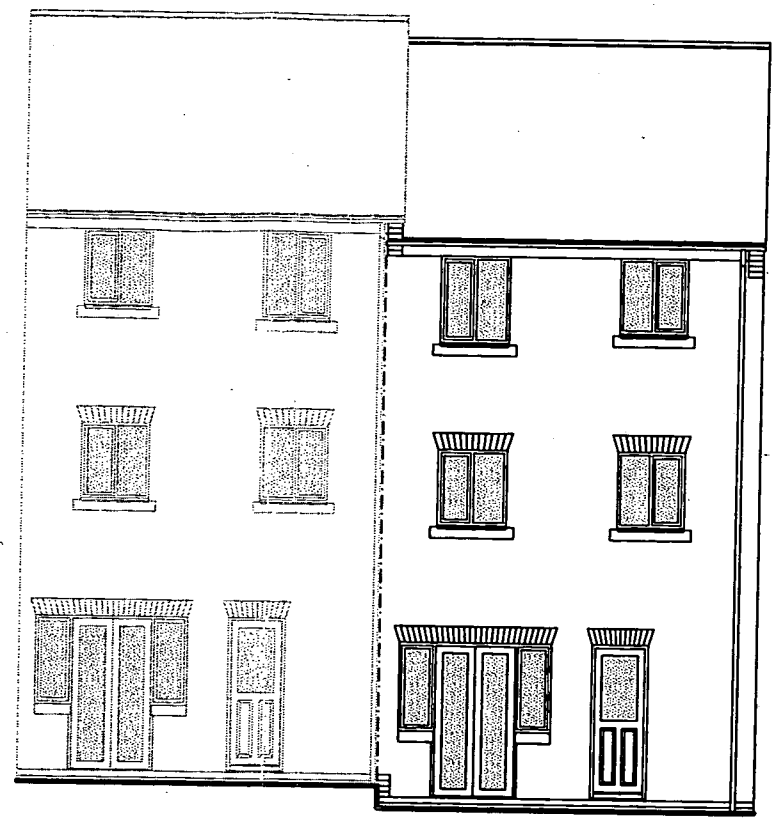

Original Rear Elevation

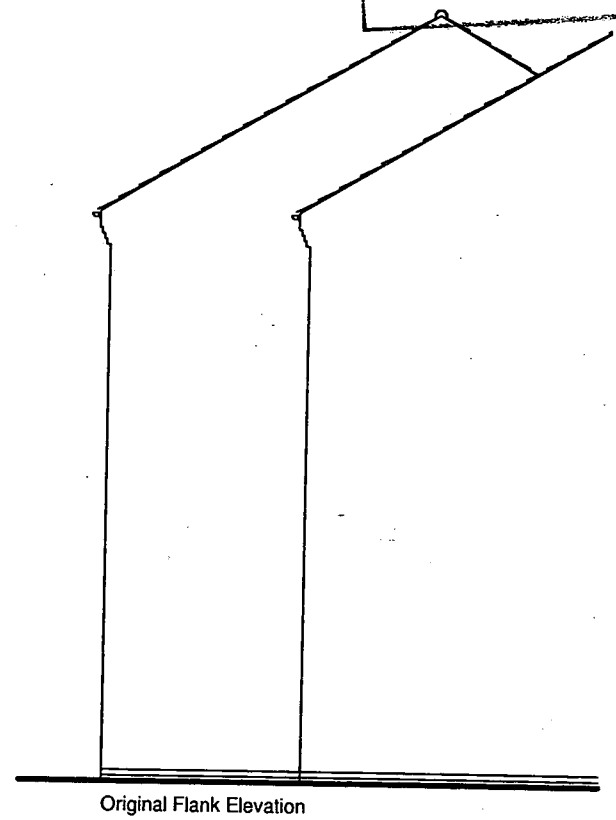

Original Flank Elevation

DO NOT SCALE FROM THIS DRAWING.
COPYRIGHT REMAINS PROPERTY OF MALCOLM A. GOODALL.
NO COPIES OF DRAWING TO BE TAKEN WITHOUT PERMISSION.

IT IS THE RESPONSIBILITY OF THE CLIENT TO CHECK THAT THE PLAN DOES NOT CONTRAVENE OR AFFECT COVENANTS OR ENCROACH ANY BOUNDARIES. IT IS NOT THE RESPONSIBILTY OF 'THE DRAWING ROOM' TO CHECK ANY MATTERS RELATING TO LAND TITLE.

IT IS THE RESPONSIBILITY OF THE CLIENT TO ENSURE THAT ANY ISSUES RELATING TO THE PARTY WALL ACT ARE IMPLEMENTED AT THE RELEVANT STAGES

DEVELOPMENT SERVICES
14 SEP 2007
RECEIVED

© The DRAWING ROOM
(ARCHITECTS) Ltd
Director MALCOLM A. GOODALL.
130 Moat Street, Wigston, Leicester. LE18 2GE.
tel:-(0116) 288 0111. fax:-(0116) 288 0222.
e-mail:- info@tdrarchitects.co.uk
web site:- www.tdrarchitects.co.uk

Job Title:-
RETROSPECTIVE PLANNING APPLICATION FOR CONSERVATORY. 10 ARGUILE PLACE HINCKLEY. LE10 0GH

Client:-
EVERSHEDS LLP


Scale:- 1:50 & 1:100


Date:- SEPTEMBER 2007

Drawing Title:-	Drawing No.	Rev	Checked
ORIGINAL PLAN & ELEVATIONS	1273-01-A3		


07/01075/FUL
INDEXED
14 SEP 2007

As Built Ground Floor Plan

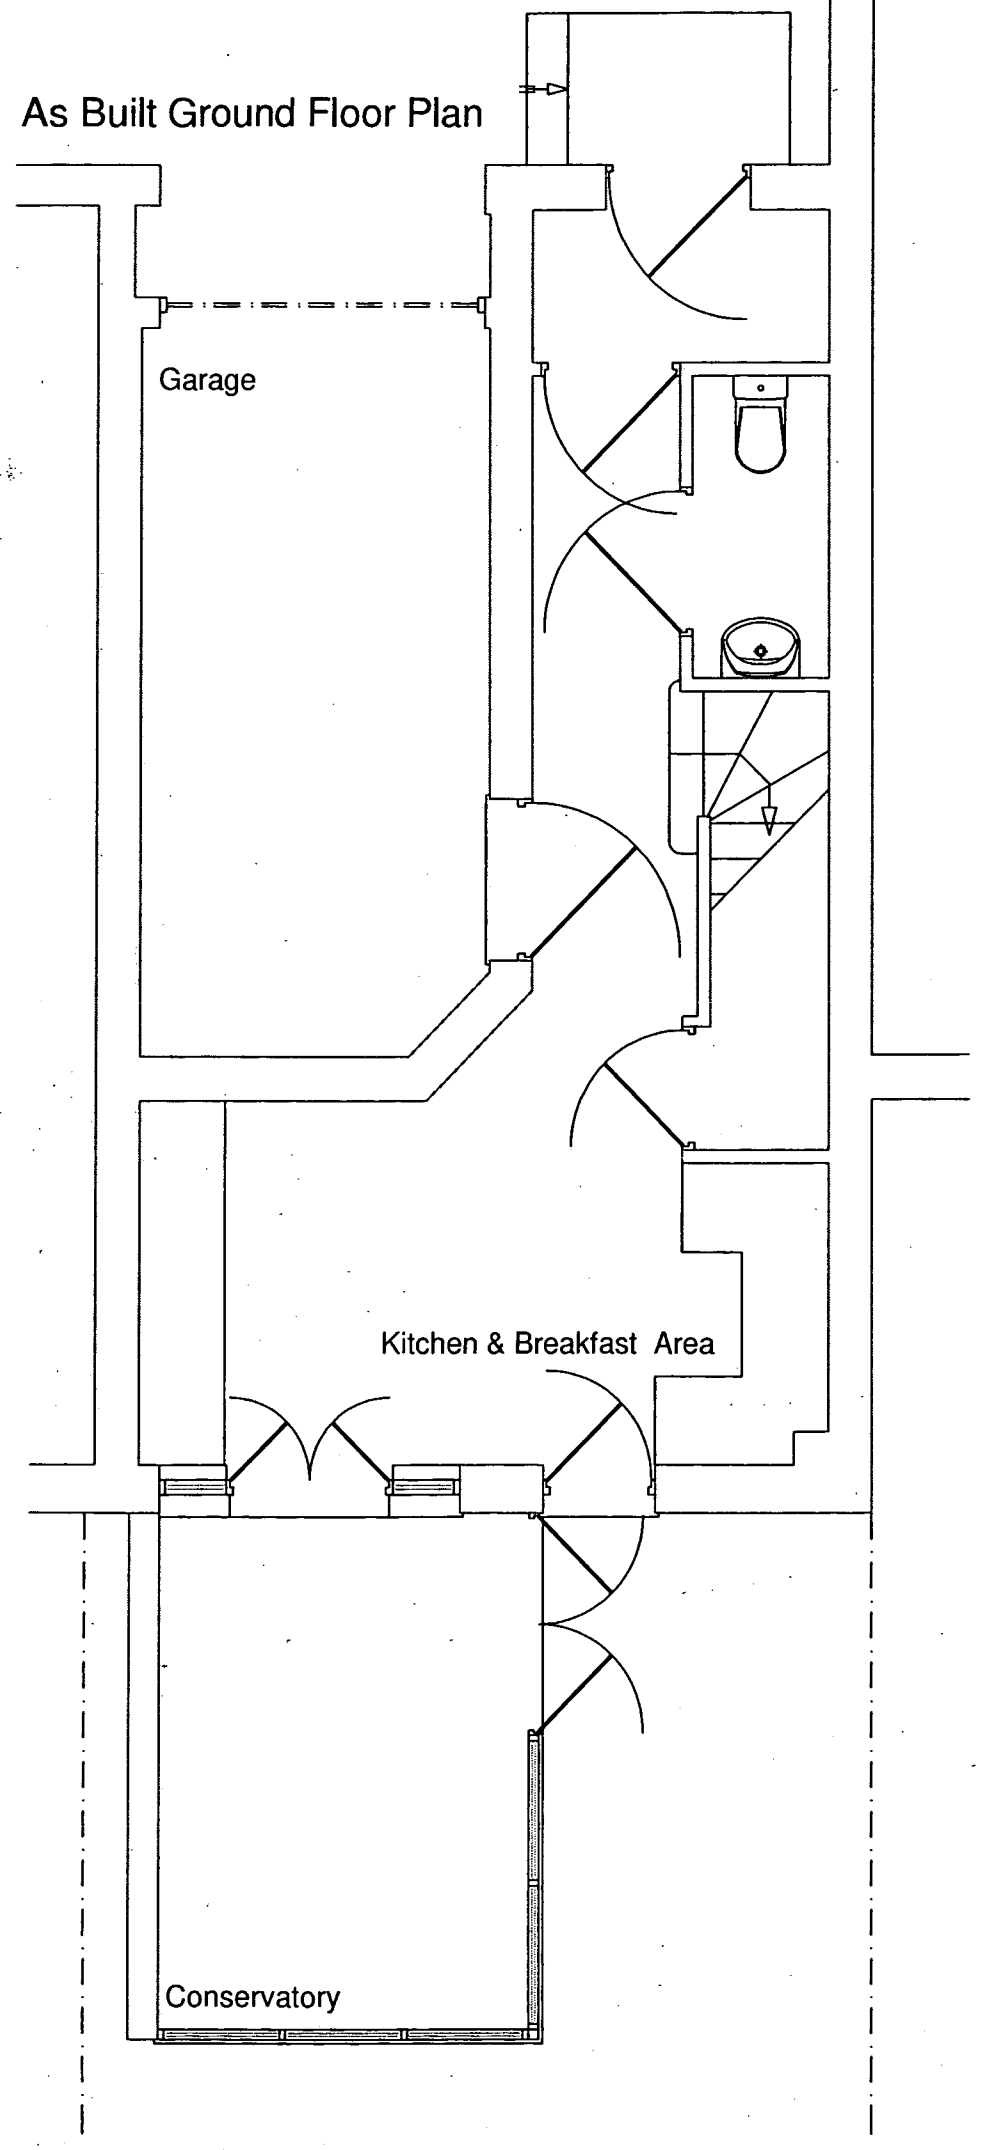


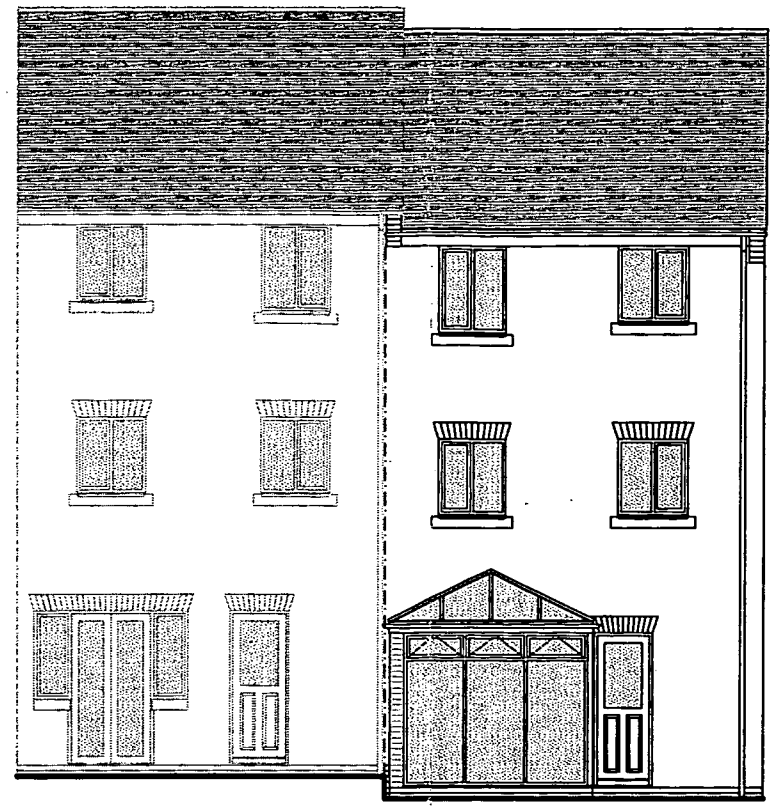

As Built Rear Elevation

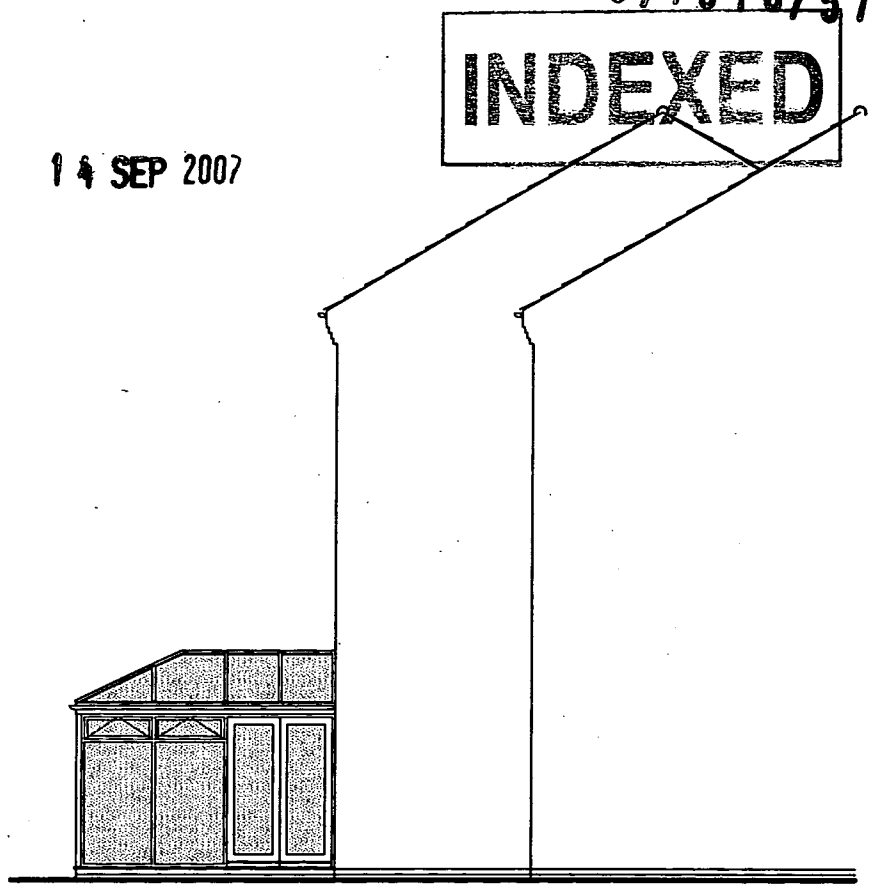

As Built Flank Elevation

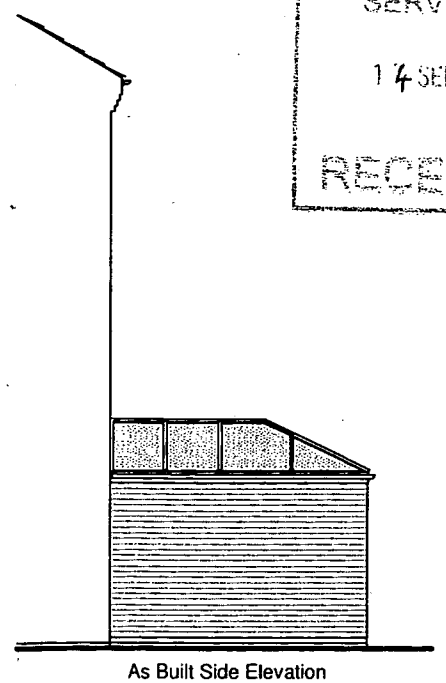

As Built Side Elevation

DEVELOPMENT SERVICES
14 SEP 2007
RECEIVED

DO NOT SCALE FROM THIS DRAWING.
COPYRIGHT REMAINS PROPERTY OF MALCOLM A. GOODALL.
NO COPIES OF DRAWING TO BE TAKEN WITHOUT PERMISSION.

IT IS THE RESPONSIBILITY OF THE CLIENT TO CHECK THAT THE PLAN DOES NOT CONTRAVENE OR AFFECT COVENANTS OR ENCROACH ANY BOUNDARIES. IT IS NOT THE RESPONSIBILTY OF 'THE DRAWING ROOM' TO CHECK ANY MATTERS RELATING TO LAND TITLE.

IT IS THE RESPONSIBILITY OF THE CLIENT TO ENSURE THAT ANY ISSUES RELATING TO THE PARTY WALL ACT ARE IMPLEMENTED AT THE RELEVANT STAGES

© The DRAWING ROOM
(ARCHITECTS) Ltd
Director MALCOLM A. GOODALL.
130 Moat Street, Wigston, Leicester. LE18 2GE.
tel:-(0116) 288 0111. fax:-(0116) 288 0222.
e-mail:- info@tdrarchitects.co.uk
web site:- www.tdrarchitects.co.uk

Job Title:-
RETROSPECTIVE PLANNING APPLICATION FOR CONSERVATORY. 10 ARGUILE PLACE HINCKLEY. LE10 0GH

Client:-
EVERSHEDS LLP

Scale:- 1:50 & 1:100

Date:- SEPTEMBER 2007

Drawing Title:-	Drawing No.	Rev	Checked
AS BUILT PLAN & ELEVATIONS	1273-02-A3		