

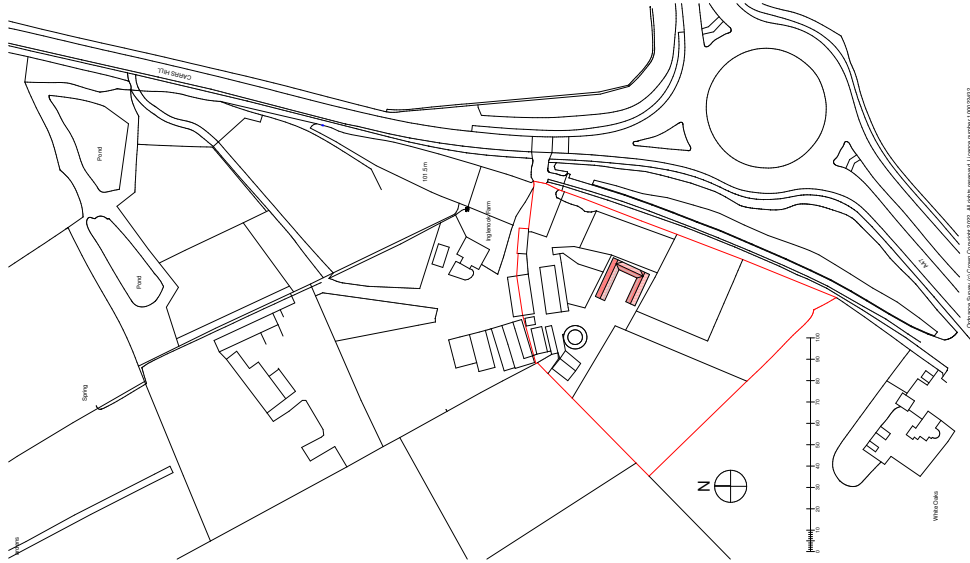


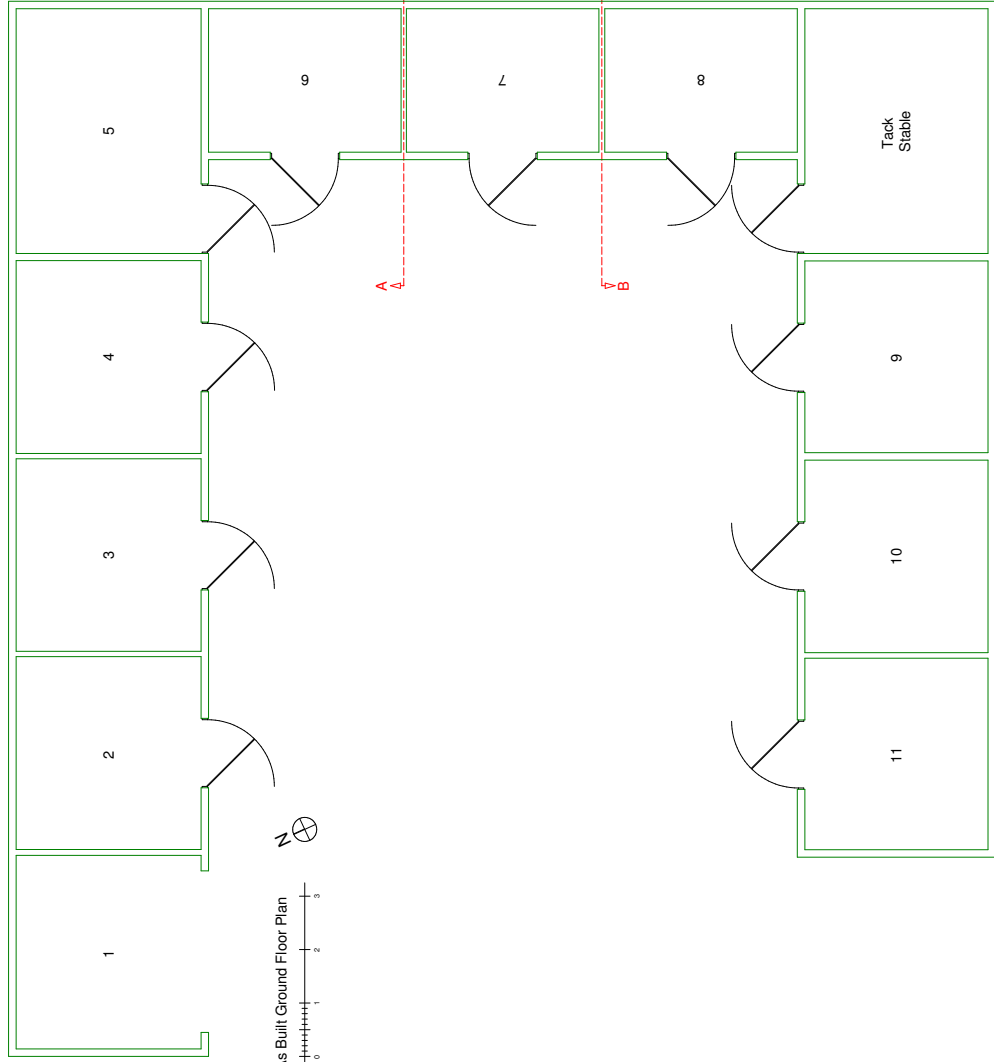

DRAWING MAY BE CALLED FOR PLANNING PURPOSES ONLY. COPYRIGHT REMAINS PROPERTY OF THE DRAWING ROOM ARCHITECTS LIMITED. ALL RIGHTS RESERVED. NO PART OF THIS DRAWING MAY BE REPRODUCED OR TRANSMITTED IN ANY FORM OR BY ANY MEANS, ELECTRONIC OR MECHANICAL, WITHOUT PERMISSION IN WRITING FROM THE DRAWING ROOM ARCHITECTS LIMITED.	
PERMISSION IS NOT GRANTED FOR THESE DRAWINGS TO BE USED FOR ANY OTHER PURPOSES WITHOUT THE WRITTEN APPROVAL OF THE DRAWING ROOM ARCHITECTS LIMITED. BY LOCAL AUTHORITY	
IT IS THE RESPONSIBILITY OF THE CLIENT TO CHECK THAT THE DRAWING ROOM ARCHITECTS LIMITED HAS BEEN ADVISED OF ALL ENCROACHMENT AND ADJACENT BUILDINGS. IT IS NOT THE RESPONSIBILITY OF THE DRAWING ROOM ARCHITECTS LIMITED TO CHECK ANY MATTERS RELATING TO LAND TITLE OR BOUNDARIES OF THE DRAWING.	
IT IS THE RESPONSIBILITY OF THE CLIENT TO ENSURE THAT ANY ISSUES RELATING TO THE PARTY WALL ACT ARE IMPLEMENTED AT THE RELEVANT STAGES	
ALL DRAWINGS ARE BASED UPON MEASURED SURVEYS ONLY.	
IT IS THE CLIENT'S RESPONSIBILITY TO OBTAIN ALL NECESSARY CONSENTS AND APPROVALS FROM THE LOCAL AUTHORITY AND SPECIFICALLY FROM THE LOCAL AUTHORITY FOR THE PROPOSED WORK AND ALL ALTERATIONS TO THE EXISTING STRUCTURE. THE DRAWING ROOM ARCHITECTS LIMITED IS NOT RESPONSIBLE FOR ANY STRUCTURAL ELEMENTS.	
IT IS THE CLIENT'S RESPONSIBILITY OF THE DRAWING ROOM ARCHITECTS LIMITED TO ADMINISTER ANY AGREEMENTS WITH OTHERS IN ACTION RELATING TO THE PROPOSED WORK. THE DRAWING ROOM ARCHITECTS LIMITED IS NOT RESPONSIBLE FOR ANY OTHER MATTERS CONCERNING THE PROPOSED WORK. NO RESPONSIBILITY IS ACCEPTED FOR THE PROPOSED WORK.	
The Drawing Room (Architects) Ltd	
130 Moat Street, Wigston Leicester, LE18 2GE. 0116 288 0111 info@drawingroom.co.uk www.drawingroom.co.uk	
Job Title: Development at: Davidson Equine, Inglesbrook Farm, Barwell, United Kingdom, LE19 8BD	
Dwg Title: As Built Plans & Elevations	
Date: March 2024	Rev
Scale: 1:50 1:100 1:1250	
Dwg No: 4070 - 01	Size: A1

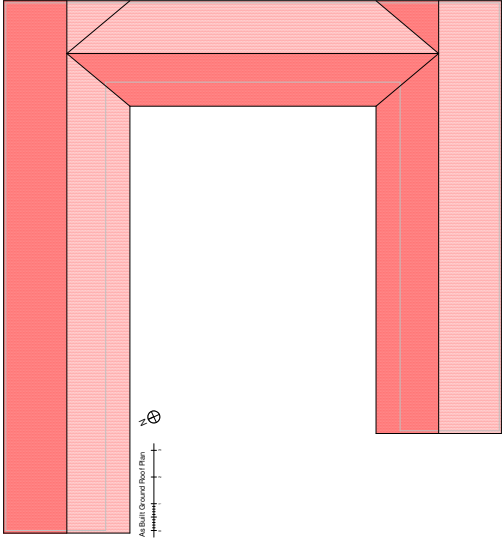