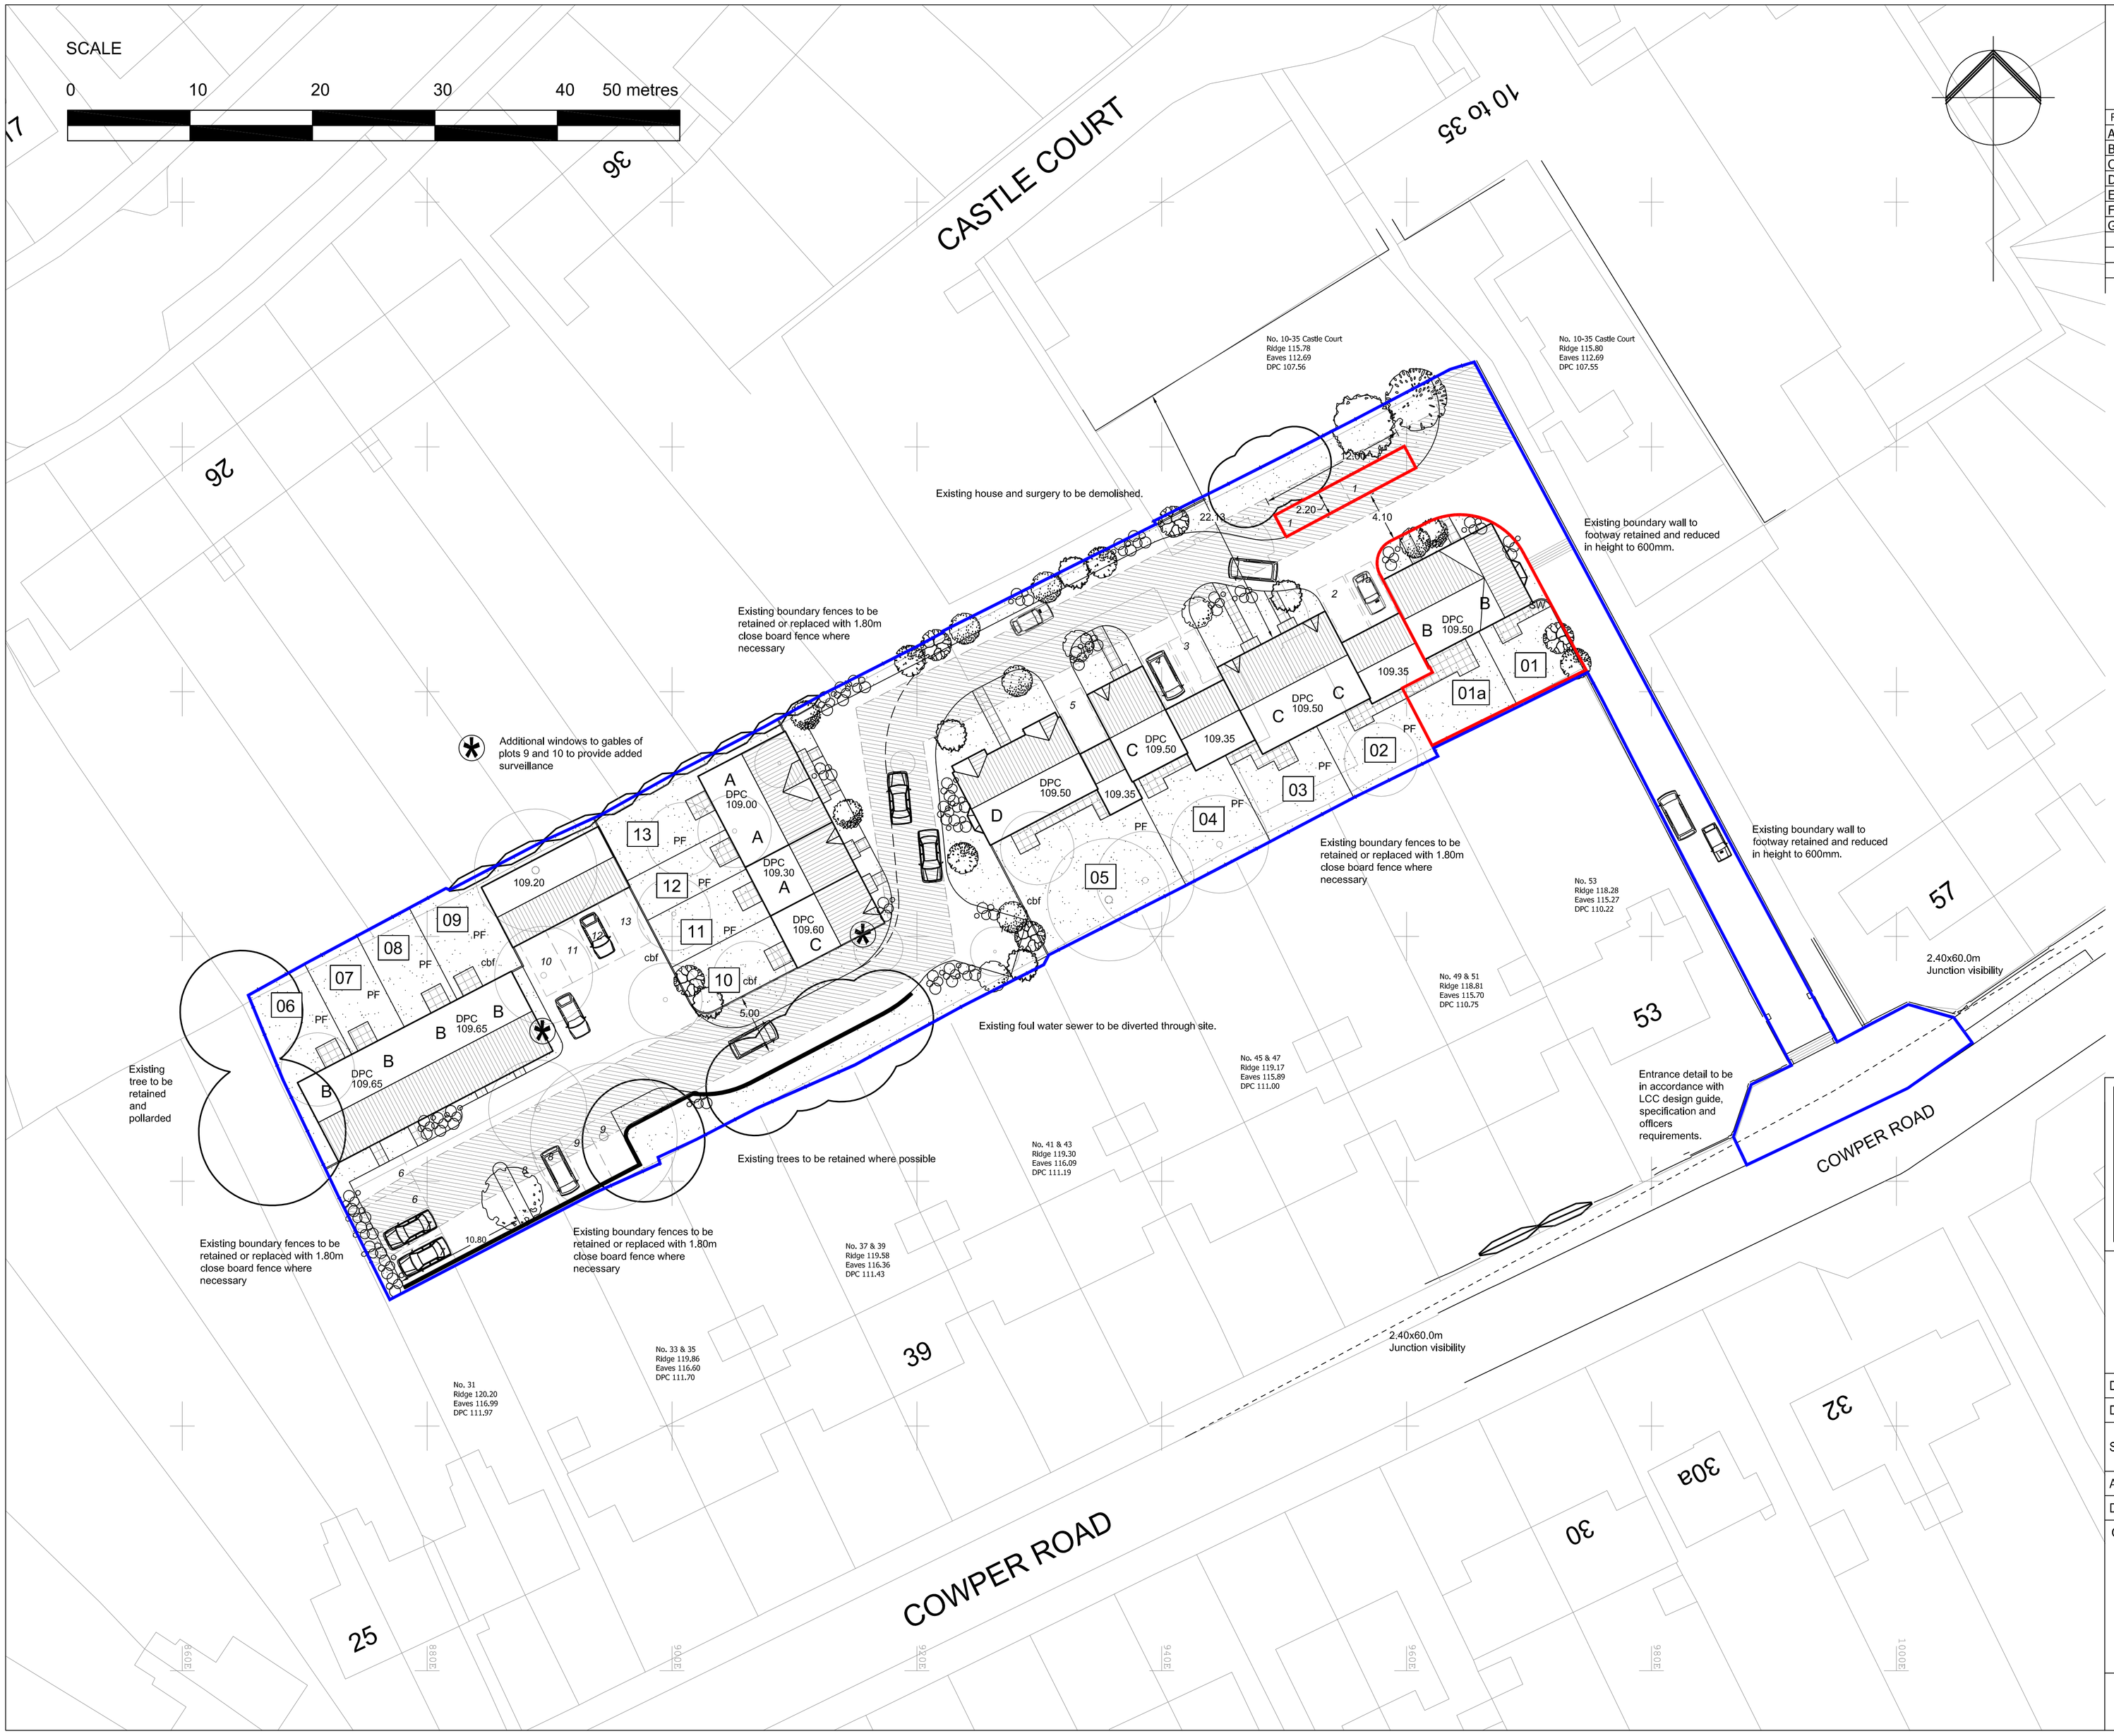

THIS DRAWING MUST NOT BE SCALED.
PRIOR TO THE COMMENCEMENT OF ANY WORKS, THE BUILDER IS TO CHECK AND/OR DETERMINE ALL CONSTRUCTION DETAILS, INCLUDING CHECKING EXISTING SITE LEVELS AND DIMENSIONS. THE DRAWING IS TO BE READ IN CONJUNCTION WITH ALL OTHER PROJECT DRAWINGS, CONSTRUCTION NOTES AND/OR PROJECT SPECIFICATION. ALL DISCREPANCIES SHOULD BE REPORTED IMMEDIATELY.

Rev.	Date	Details	Drawn
A	21.03.08	Pl 5 garage relocated, pl's 10-13 moved and pl13's parking amended	SCH
B	31.03.08	Red line amended to coincide with original outline plan.	SCH
C	05.06.08	Plots 10-12 rearranged.	SCH
D	09.06.08	Boundary fence / wall and entrance detail notes added.	SCH
E	24.06.08	Plot 10 handed. Plot 10-13 garage roof changed to gable.	SCH
F	26.11.08	Plot 10 handed. Plot 10-13 garage roof changed to gable.	SCH
G	08.01.09	Plots 1and 1 A resited and bay added to plot 1	pnh

Key:

- Existing trees to be removed
- Existing trees retained
- Indicative new landscaping
- Parking allocation
- 11 Plot number
- CBF Close boarded fence
- PF Panel fence
- SW Screen wall
- RA Railings
- Bollards
- Tree grills

Schedule of Accommodation

"A" Type	2 Bed house	3
"B" Type	2 Bed house	6
"C" Type	3 Bed house	4
"D" Type	3 Bed house	1
	Total	14

cadsquare
Cadsquare Midlands Ltd
The Stables
Woodbury Lane
Norton
Worcestershire
WR5 2PT
t: 01905 761580
f: 01905 764051
www.cadsquare.co.uk
ARCHITECTURAL AND URBAN DESIGN

Site Address: COWPER ROAD BURBAGE LEICESTERSHIRE

Description: PLANNING LAYOUT

Drawing Number: 07-055 / 02 Rev G

Date: JAN 2008 Scale: 1:250 @ A1

Status: PLANNING

AutoCAD Reference: N.A.

Drawn: pnh Checked: sch

Client: ASPECTS ...a better aspect of home building

THIS DRAWING IS THE COPYRIGHT OF CADSQUARE MIDLANDS LTD AND MUST NOT BE USED IN CONJUNCTION WITH ANY OTHER PROJECT WITHOUT CADSQUARE MIDLANDS LTD WRITTEN CONSENT