


Side Elevation

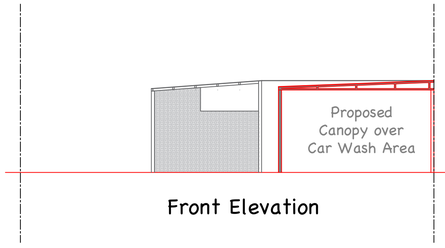


Front Elevation

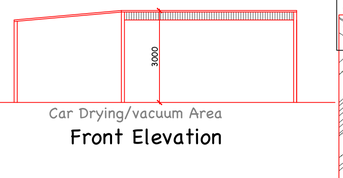


Front Elevation

1:5 = 25cm 1:200 = 10m
1:10 = 50cm 1:250 = 12.5m
1:20 = 100cm 1:500 = 25m
1:50 = 2.5m 1:1250 = 62.5m
1:100 = 5m 1:2500 = 125m

Note:
This drawing & design is the copyright of **Design**Formula and must not be reproduced in part or in whole without prior written consent.
All Dimensions are in millimeters and are approximate.

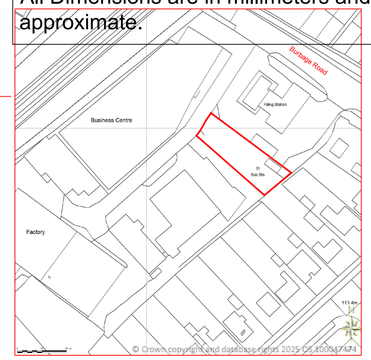


Site Location Plan
scale 1:1250



Proposed Canopy over
Car Wash Area
Rear Elevation



Car Drying/vacuum Area
Front Elevation




Block Plan
scale 1:500

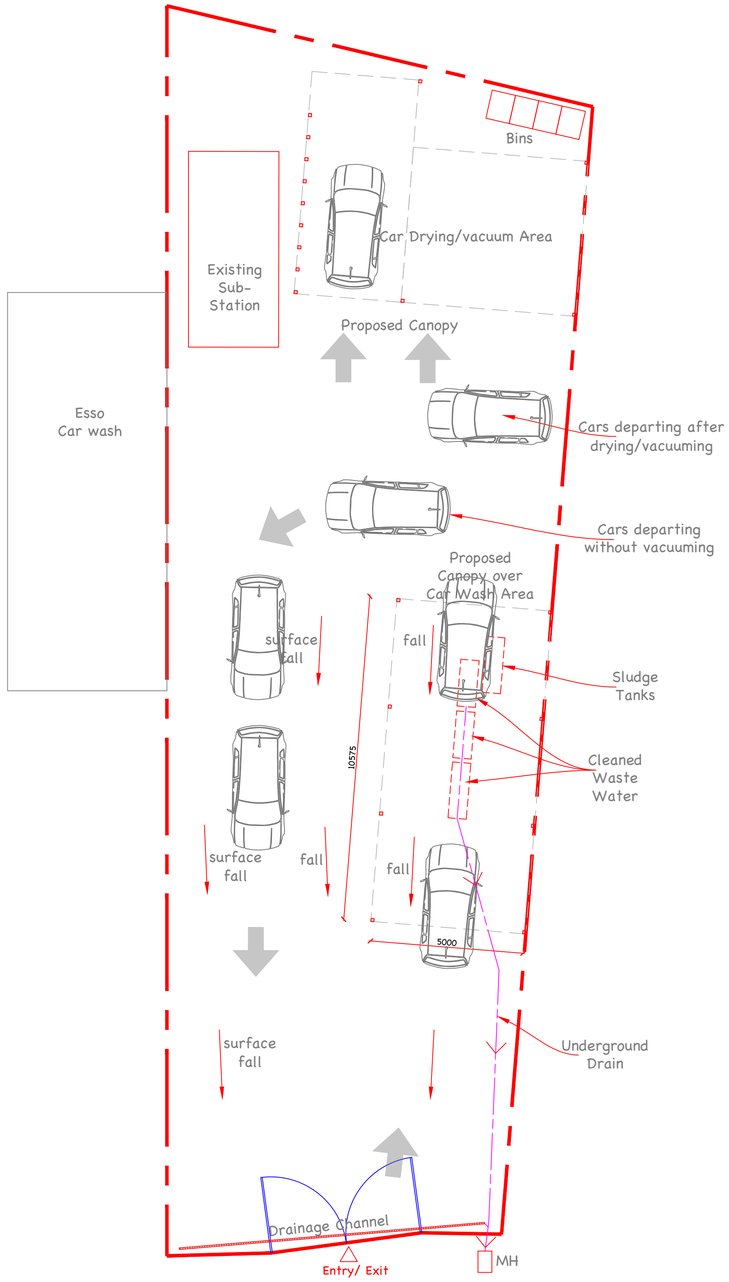


As-Built/Proposed Site Plan

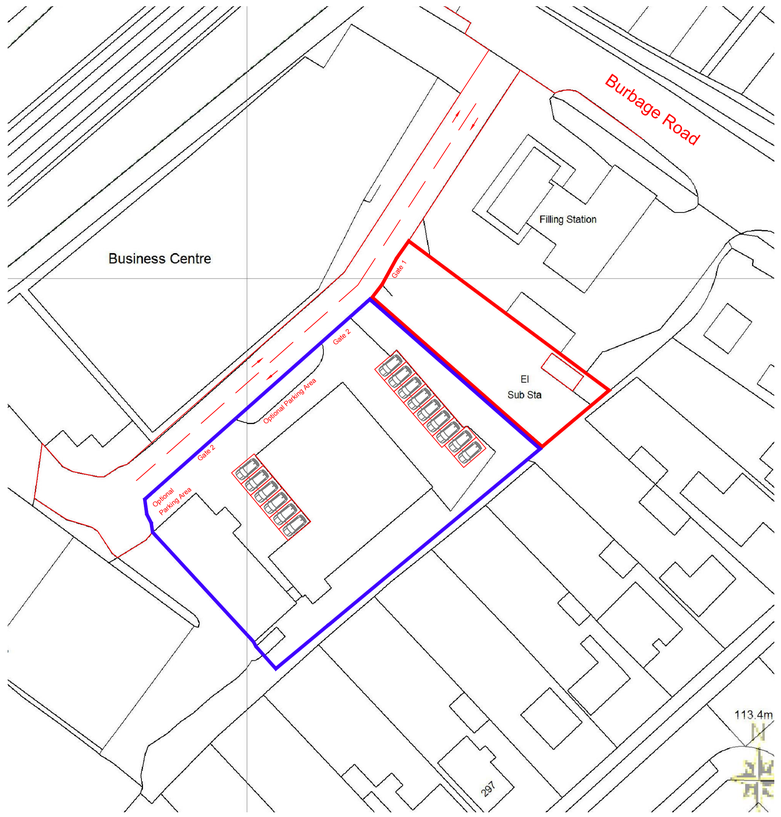


Existing Site Plan
scale 1:500

Rev C - Existing Site Plan added which shows the existing parking
Rev B - Canopy photos added
Rev A - Redline highlighted in Red

Note:
-All Dimensions are in millimeters and are approximate.
-New Extension in Render & Timber Cladding.
-New windows to match existing.
-New RWP drains to be connected to existing.

**DESIGN**FORMULA
07814262723

| | |
|---|---|
| Project Title: | Automatic Engineers<br>Hinckley Limited<br>Burbage Road, Hinckley |
| Details: | Retrospective Application<br>Approval of Erected Canopies,<br>Car Wash Use And<br>Associated external works<br>including concrete hard surface |
| Drawing: | Existing & Proposed<br>Plans-Elevations PLANNING |

| Scale: | Date: | Drg No: |
|---|---|---|
| 1:100 & as noted @ A1 | Feb 2025 | 5107-200Rev C |