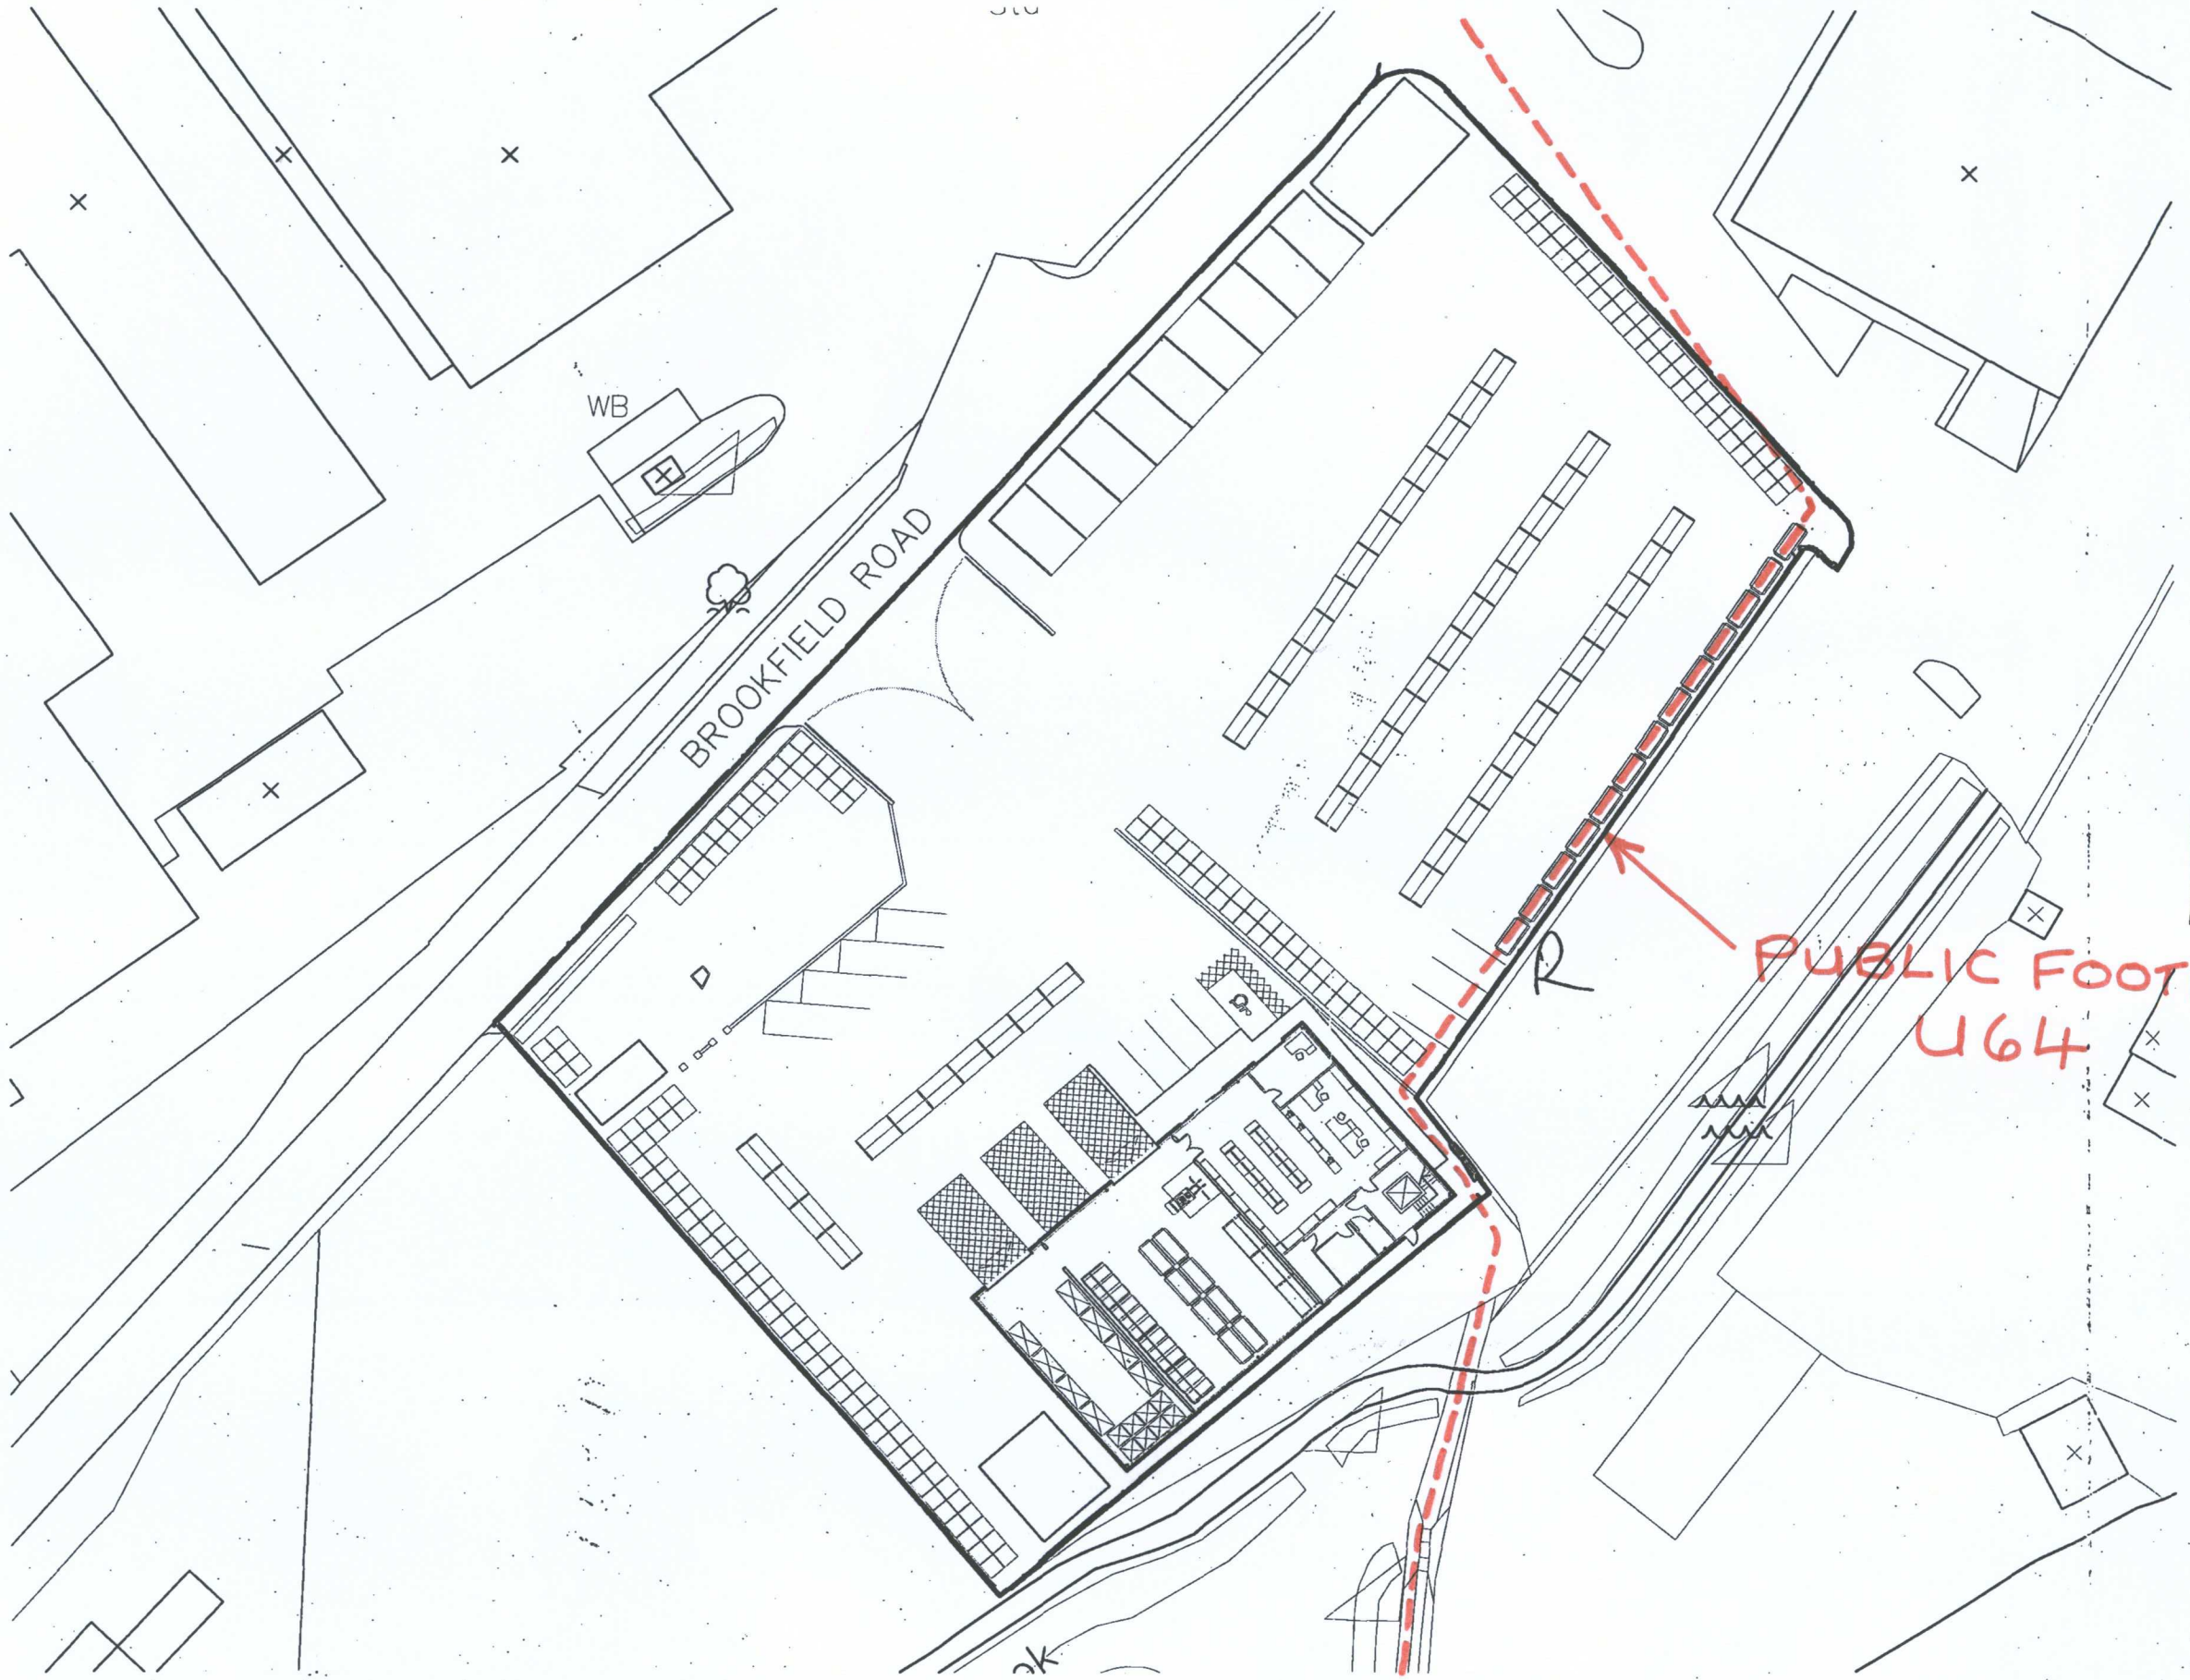

DEVELOPMENT SERVICES

24 NOV 2008

RECEIVED

Rev	Description	Date	By	Chk

Status: Purpose for Issue

Planning ■ Tender ☐

Construction ☐ As Built ☐

Client
TRAVIS PERKINS

Contract
KEYLINE
BROOKFIELD ROAD
HINCKLEY

Drawing
PROPOSED SITE PLAN

BATE AND TAYLOR ARCHITECTS

Royal Exchange
Cross Street
Manchester M2 7DA
Tel. 0161 832 7707
Fax. 0161 832 7708
mail@bate-taylor.co.uk
www.bate-taylor.co.uk

Drawing No. MH694-02 Revision

Scales 1:500@A3 Date AUGUST '08

Drawn PR Checked GB

This drawing is the copyright of the Architect and may not be reproduced without licence.
DO NOT scale from this drawing.

01 Proposed site plan
Scale 1:500@A3