A1 Size
Use figured dimensions only

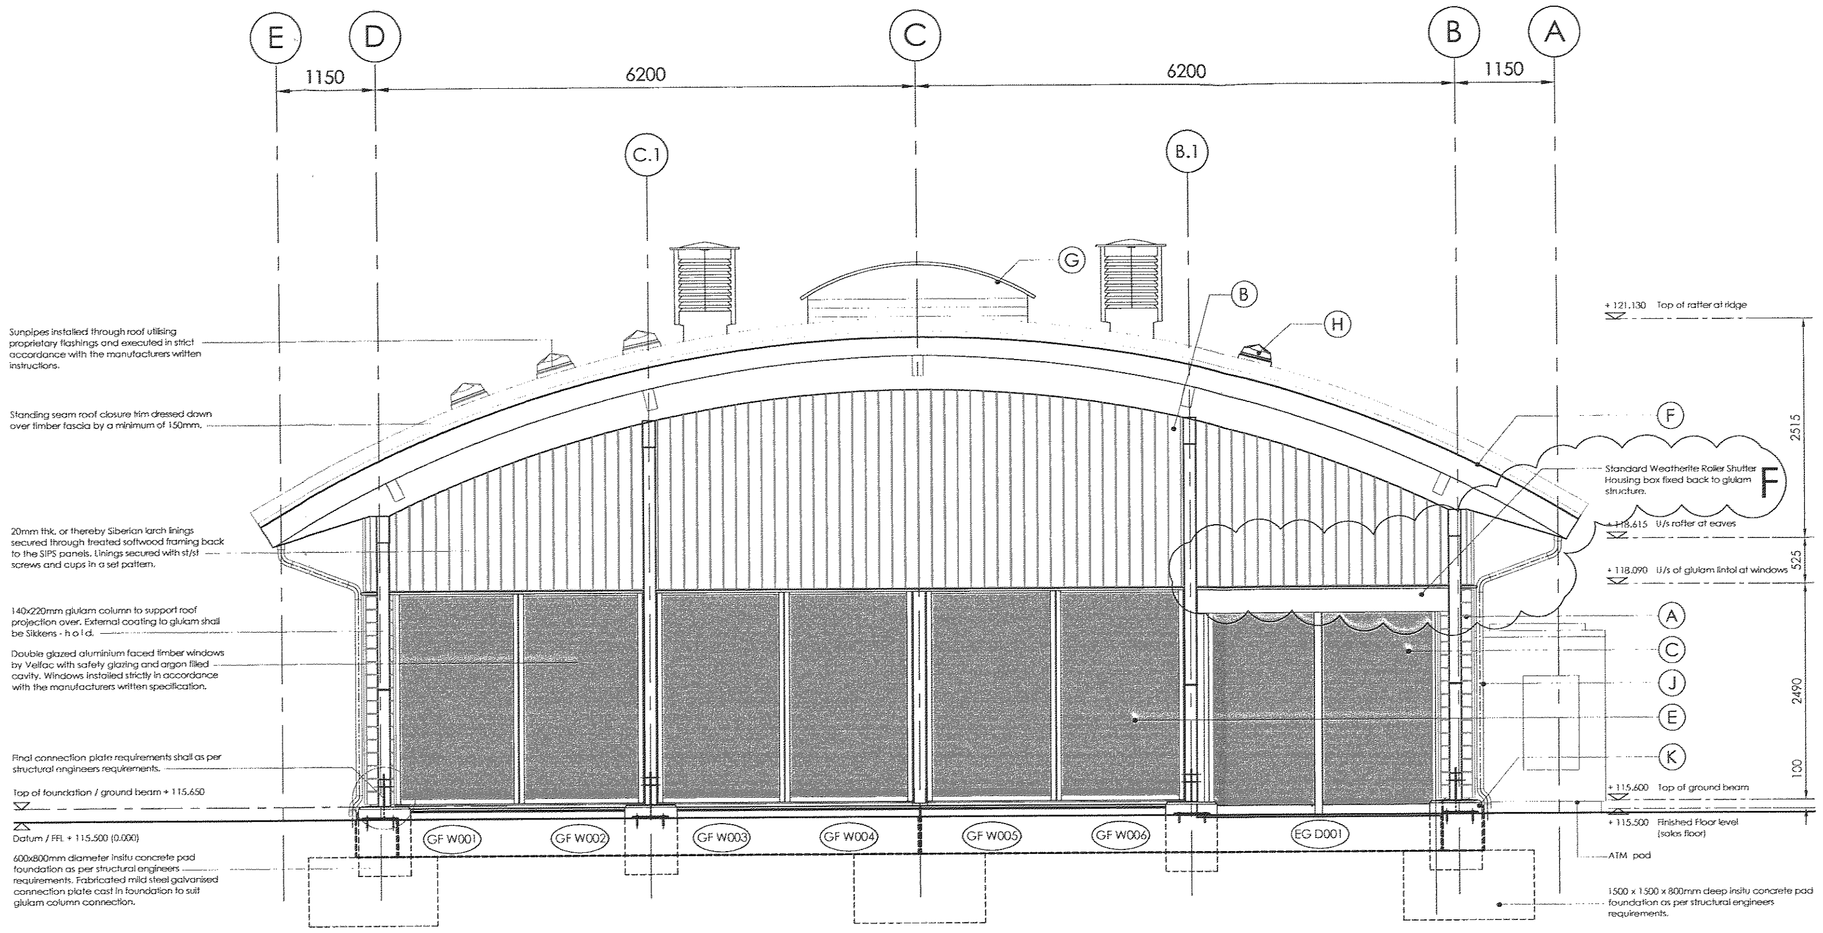

Elevation 1 - Front of Store

(Landscaping omitted for clarity)

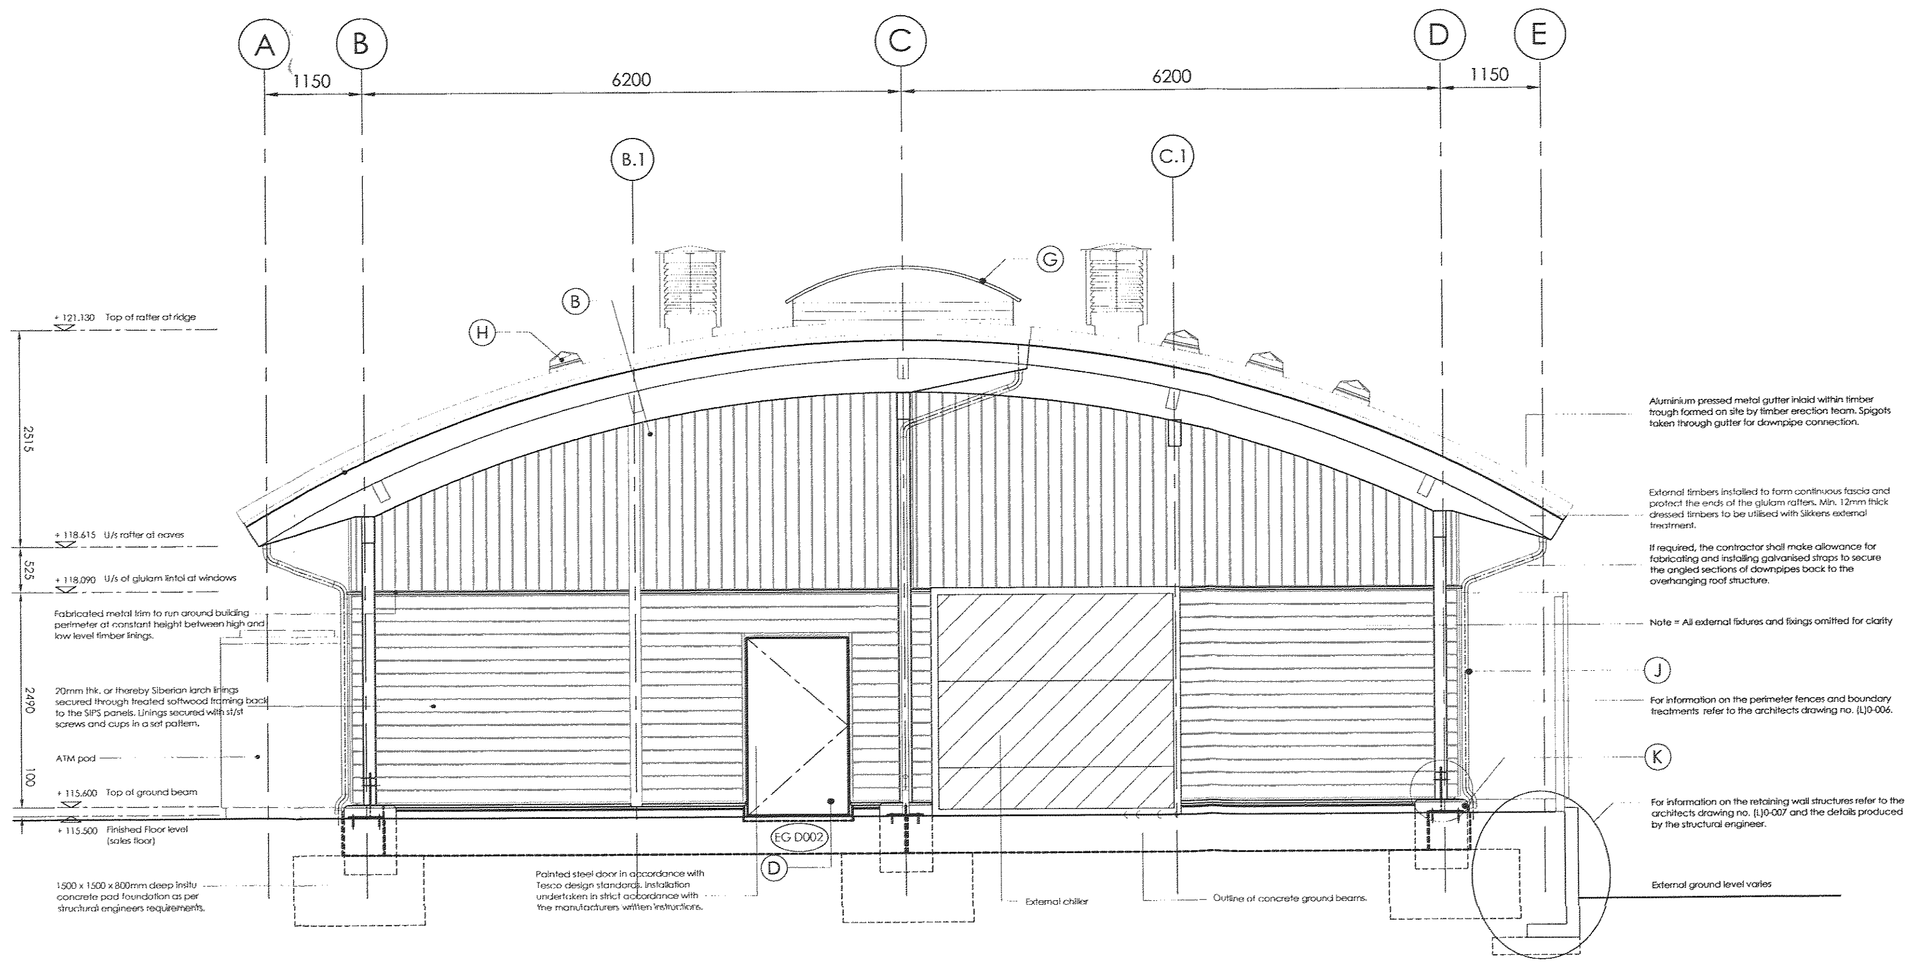

Elevation 3 - Rear of Store

Wall materials take-off

Gross area of Horizontal timber Cladding = 22m²

Gross area of vertical timber Cladding = 23m²

Building elevations

scale 1.50

Notes:

All site relevant information shall be checked by competent personnel prior to any works commencing on site.

For details of signage refer to Retail Design Solutions drawings & specifications

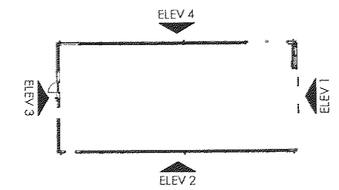

Materials schedule

- (A) Horizontal timber cladding with feature shadow gap at 4800mm centers. Timber to remain untreated.
- (B) Vertical timber cladding. Timber to remain untreated.
- (C) Glazed electronic sliding doors to store entrance.
- (D) Steel metal door in steel frame. Colour RAL 9010..
- (E) Timber framed windows with external aluminium profile fitted with argon filled double glazed units. Colour Ral 9010 - Note = All glass shall be toughened safety glass.
- (F) Roof finish, standing seams zinc roof covering.
- (G) 3 layer Texion ETFE cushion rooflight with metal framing by Vector Foiltec installed within perimeter glulam upstand
- (H) Sunpipes installed within welded metal collars into metal standing seam roof as per maunufacturers requirements.
- (J) Lindab or similar galvanized rainwater goods.
- (K) Precast concrete ground beams all in accordance with the structural engineers requirements.
- (L) Metal lined rainwater gutter system, welded outlets to underside with grid positions as installed.
- (M) Exposed Glulam timber components with external timber treatment by Sikkens. Colour Hold.

Rev	Description	Date	BY
F	Roller shutter details updated.	14/03/08	PJB
E	Roller shutter added to entrance.	14/02/08	PJB
D	Cladding revised, external ATM added	12/12/07	JS
C	ATM removed at planners request.	21/11/07	PJB
B	General update for construction.	21/08/07	KJD
A	Brick slips removed, external chiller added to rear of store, and metal rainwater outlets replaced with downpipes.	09/08/07	AD

DEVELOPMENT SERVICES
25 MAR 2008
RECEIVED

TESCO
working with
barr
construction
Heathfield House
Fairways Business Park
Livingston EH54 8AF

T 01506 441 400
F 01506 441 410

CONSTRUCTION

Client
Tesco Stores Ltd

Project Title
Express Store, London Road
Hinckley, Leicestershire

Drawing Title
General Arrangement
Elevations Sheet 1

Scale	Date	
1:50 (A1)	06/07/07	
Drawn by	Checked by	Approved by
AD	IC	KJD
Job Code.	Drawing No.	Rev.
ETH	(L)2-004	F