A1 Size
Use figured dimensions only

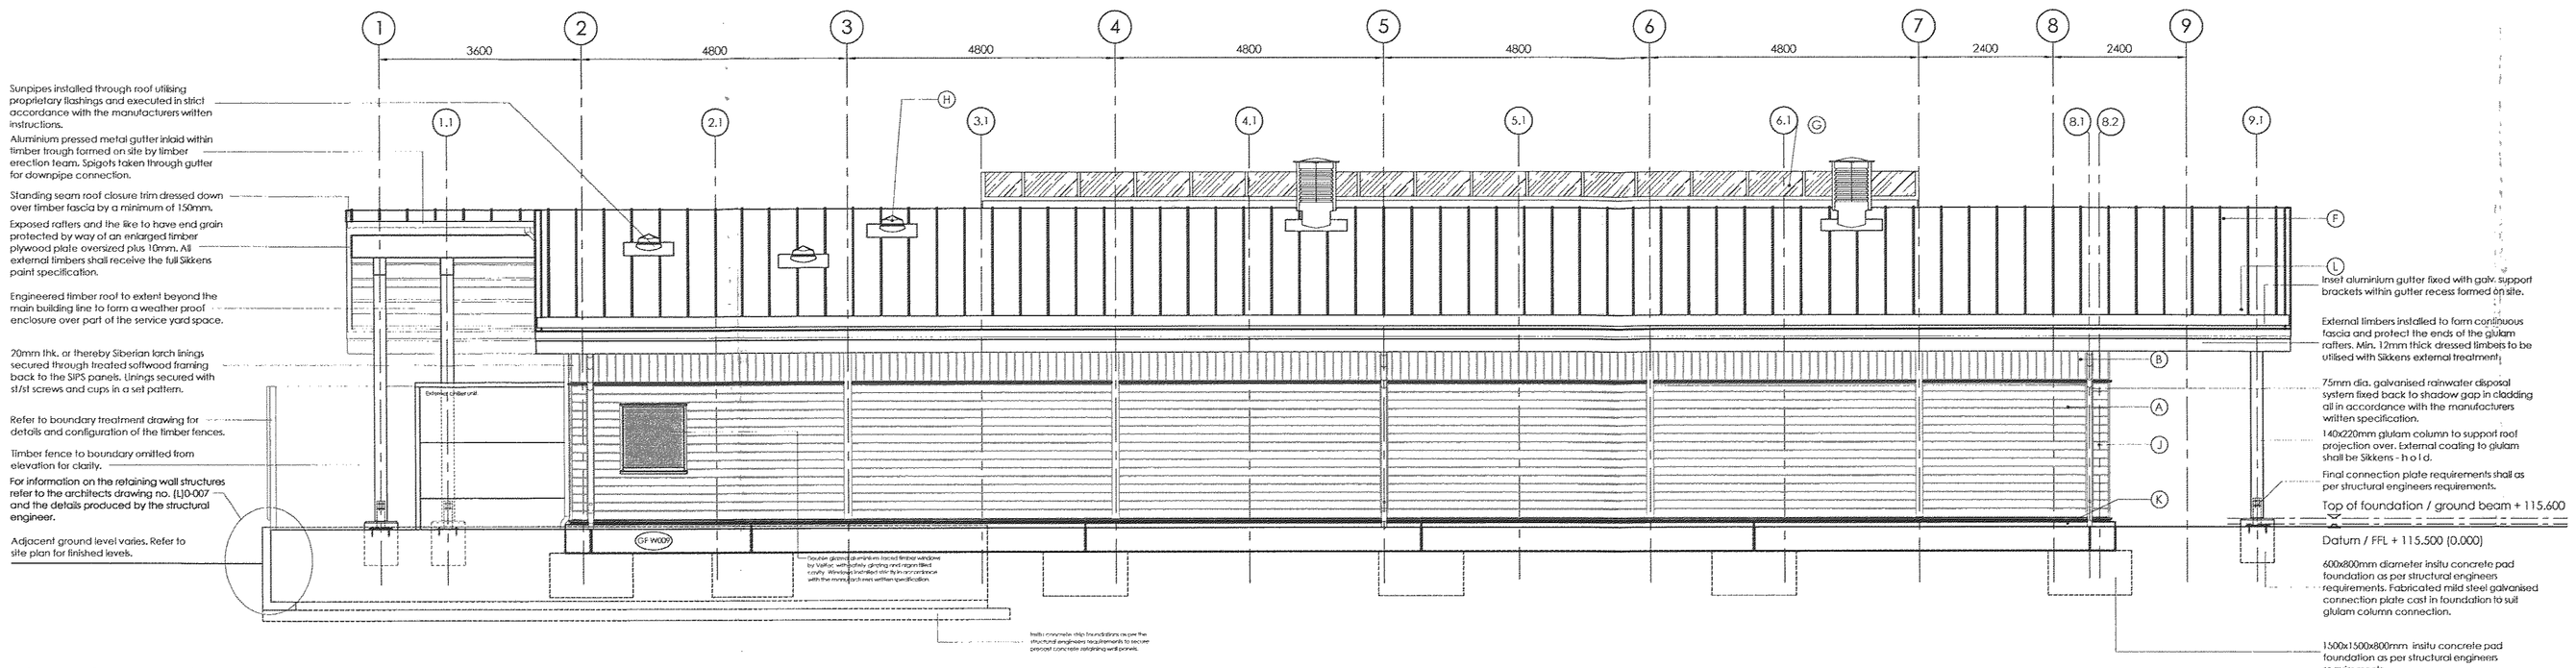

Elevation 2 - Side of Store

Wall materials take-off
Gross area of Horizontal timber Cladding = 66m²
Gross area of vertical timber Cladding = 21m²

Notes:

All information contained in these drawings is extracted from the Archer Architects planning submission. All site relevant information shall be checked by competent personnel prior to any works commencing on site.

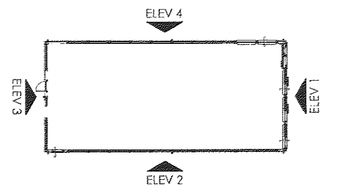

Materials schedule

- A Horizontal timber cladding with feature shadow gap at 4800mm centers. Timber to remain untreated.
- B Vertical timber cladding. Timber to remain untreated.
- C Glazed electronic sliding doors to store entrance.
- D Steel metal door in steel frame. Colour RAL 9010..
- E Timber framed windows with external aluminium profile fitted with argon filled double glazed units. Colour Ral 9010 - Note = All glass shall be toughened safety glass.
- F Roof finish, standing seams zinc roof covering.
- G 3 layer Texlon ETFE cushion rooflight with metal framing by Vector Foiltec intalled within perimeter glulam upstand
- H Sunpipes installed within welded metal collars into metal standing seam roof as per maunufacturers requirements.
- J Lindab or similar galvanized rainwater goods.
- K Precast concrete ground beams all in accordance with the structural engineers requirements.
- L Metal lined rainwater gutter system, welded outlets to underside with grid positions as installed.
- M Exposed Glulam timber components with external timber treatment by Sikkens. Colour Hold.

Rev	Description	Date	BY
F	ATM pod relocated	25/02/08	JS
E	ATM pod changed to timber cladding. Staffroom window added.	14/02/08	PJB
D	ATM door removed. ATM pod added	10/12/07	PJB
C	General update to construction	21/08/07	KJD
B	External chiller added to rear of building rainwater outlets replaced with downpipes.	09/08/07	AD
A	Timber cladding carried round to side elevations	18/07/07	GS

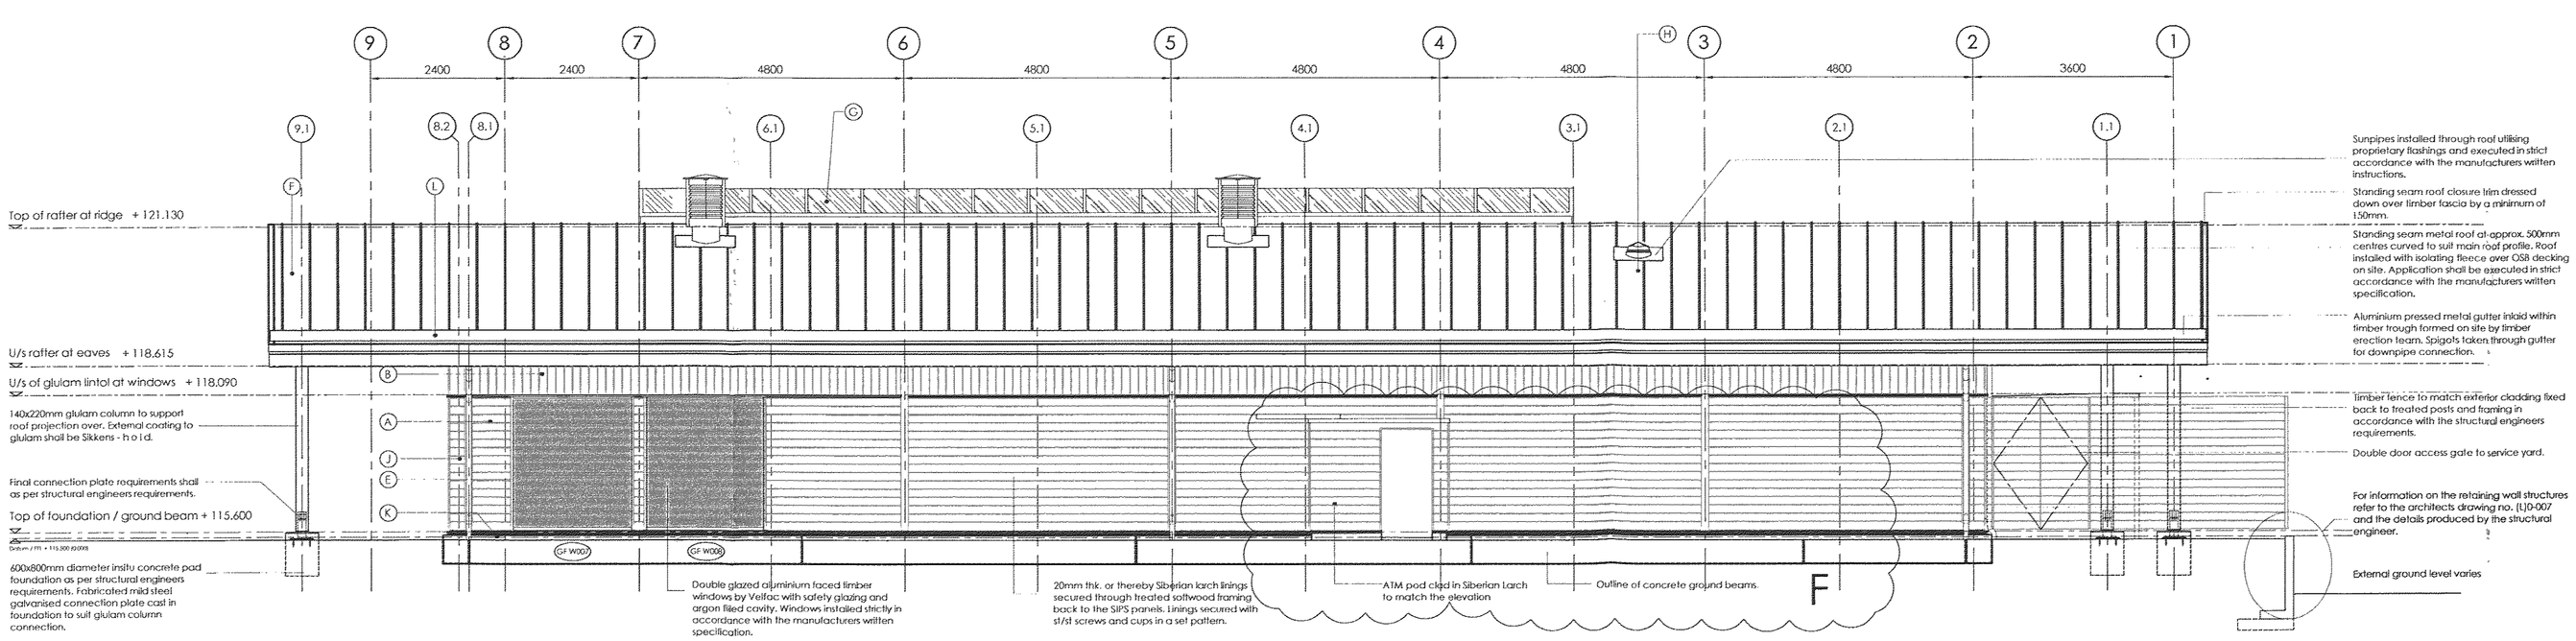

Elevation 4 - Side of Store

Wall materials take-off
Gross area of Horizontal timber Cladding = 56m²
Gross area of vertical timber Cladding = 21m²
Gross area of glazing = 10m²

DEVELOPMENT SERVICES
25 MAR 10HR
RECEIVED

Building elevations

scale 1.75

TESCO
working with
barr
construction
Heathfield House
Fairways Business Park
Livingston EH54 8AF
T 01506 441 400
F 01506 441 410

CONSTRUCTION

Client
Tesco Stores Ltd

Project Title
Express Store, London Road
Hinckley, Leicestershire

Drawing Title
General Arrangement
Elevations Sheet 2

Scale	Date
1:75 (A1)	06/07/07
Drawn by: AD	Checked by: IC / Approved by: KJD
Job Code: ETH	Drawing No.: (L)2-005 / Rev.: F