


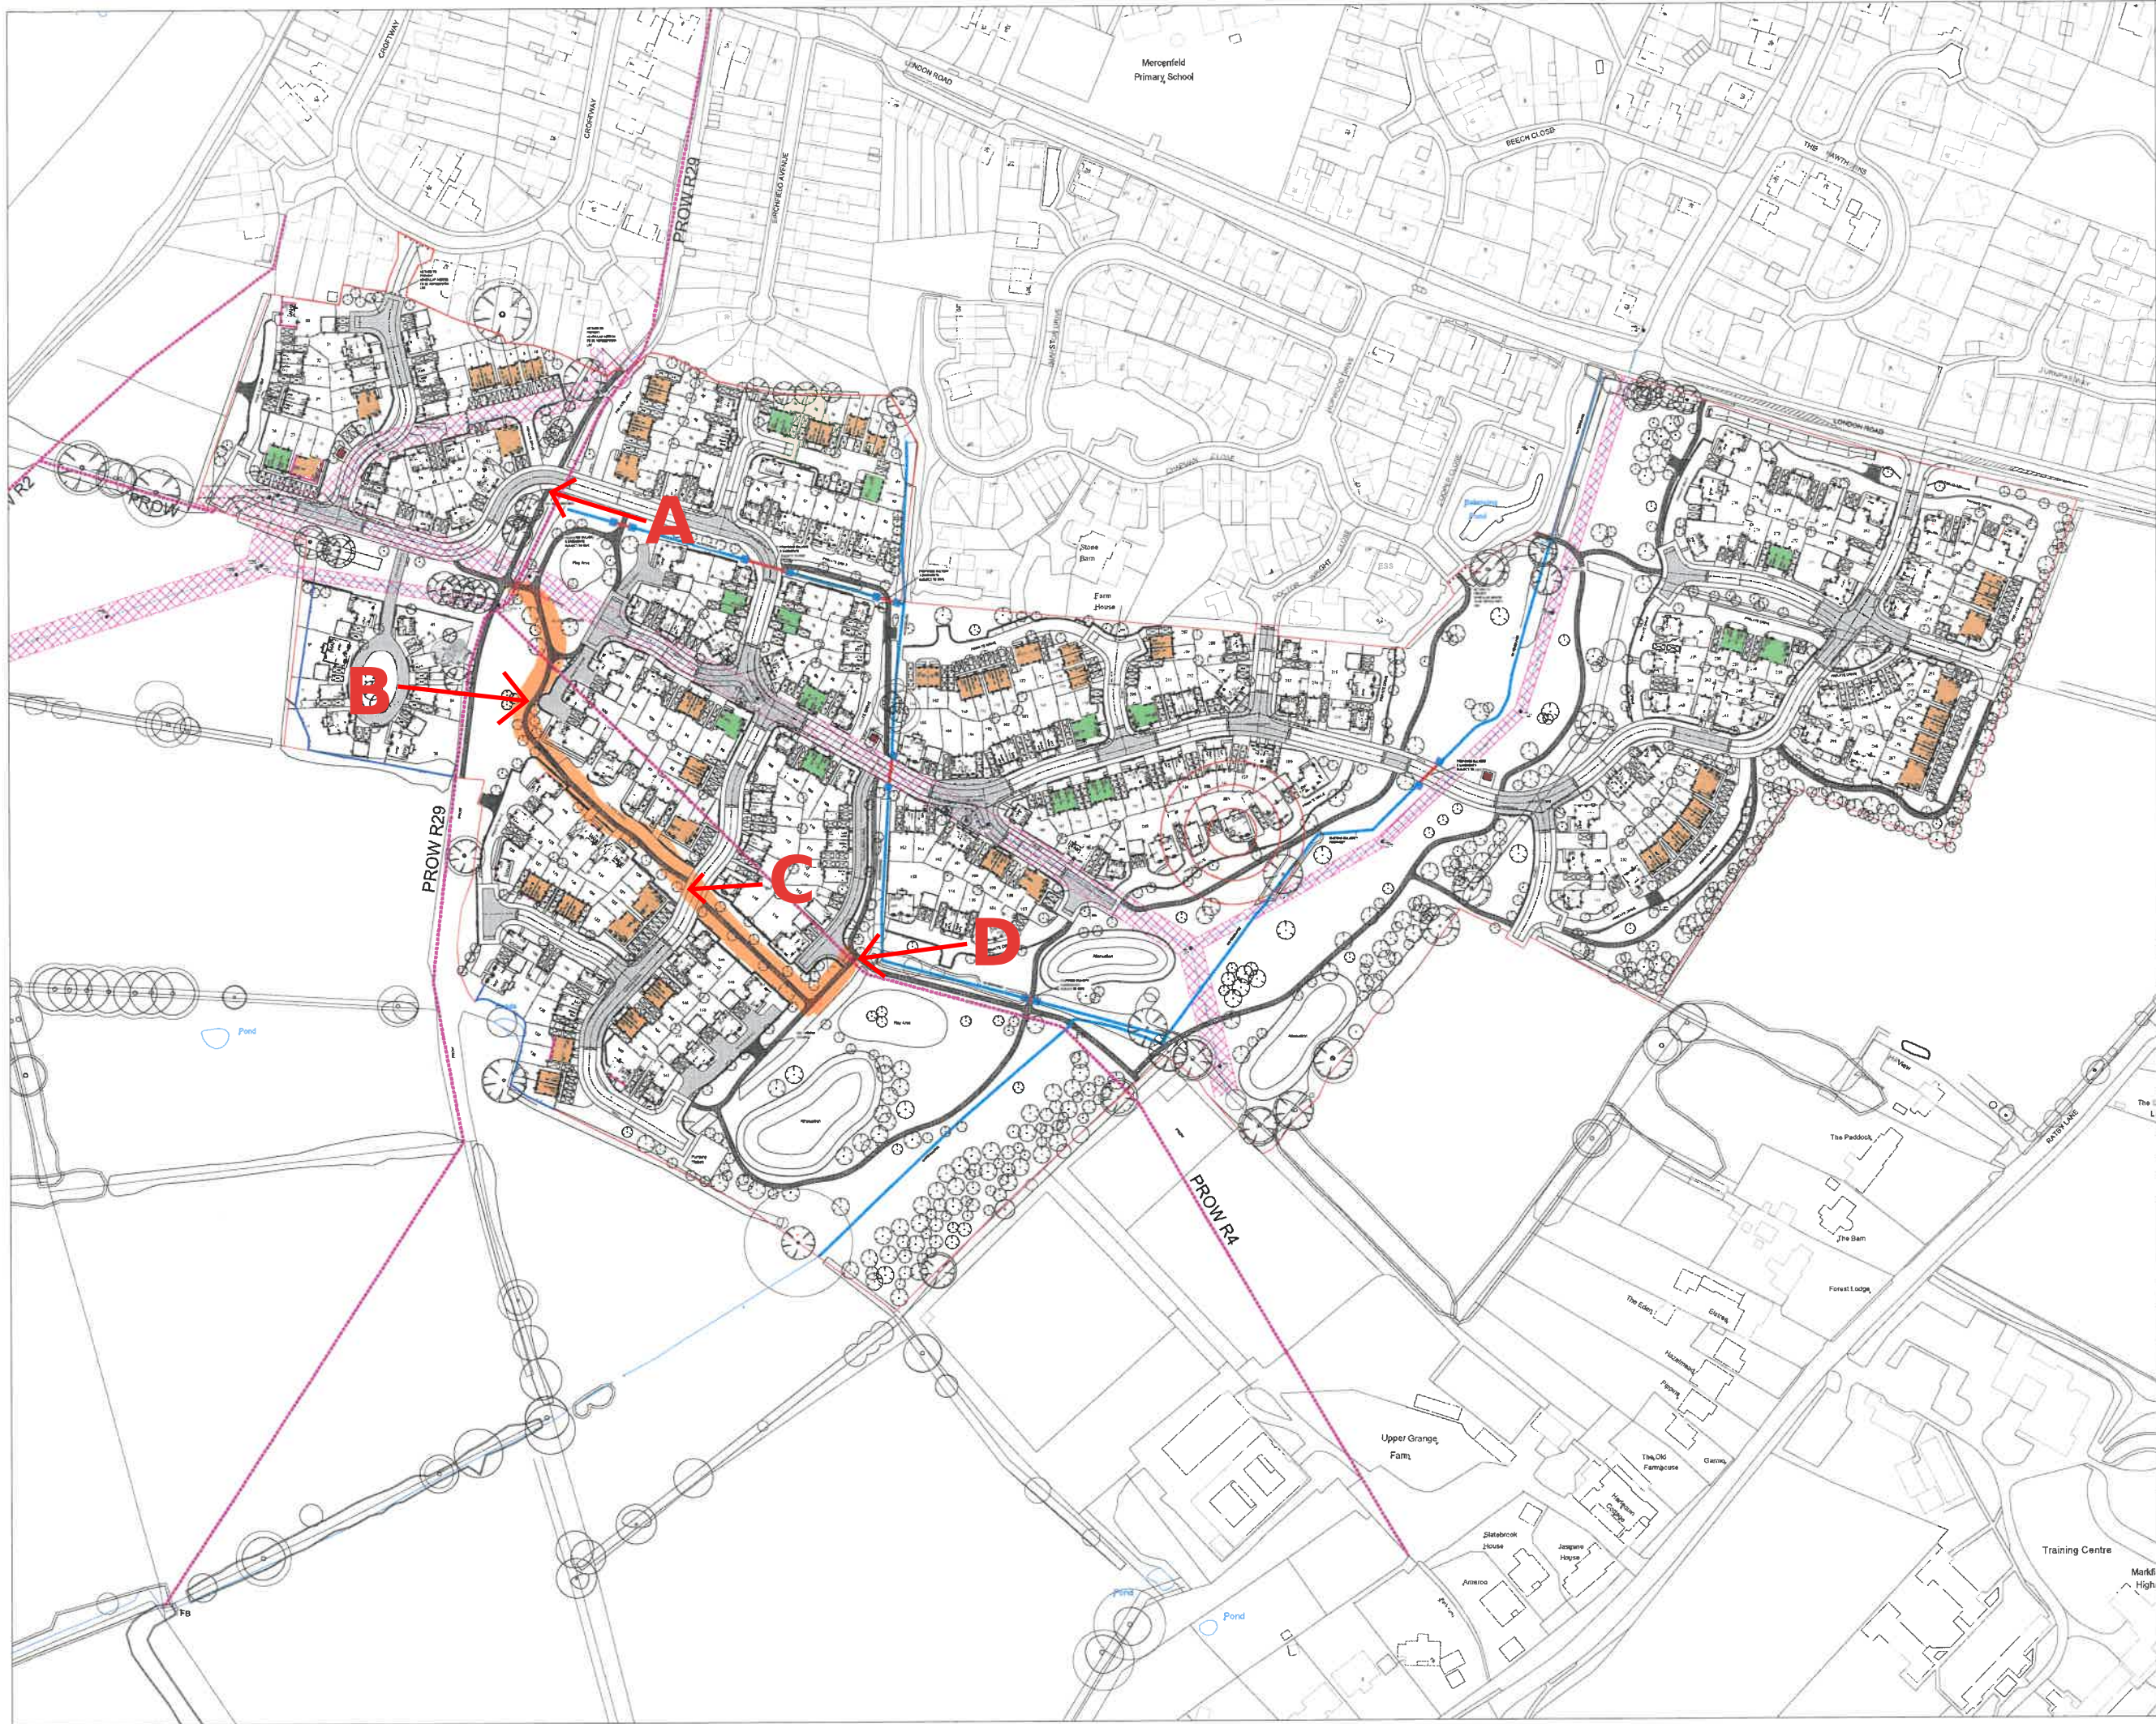

Schedule of Accommodation

Private Market		
Type	No of Beds	No of Units
JS203	2 Bed Semi Detached	40
JS318	3 Bed Semi Detached	28
JD311	3 Bed Detached	1
JD313	3 Bed Detached	6
JD315	3 Bed Detached	11
JD319	3 Bed Detached	20
JD326	3 Bed Detached	7
JD331	3 Bed Detached	28
JD401	4 Bed Detached	7
JD411	4 Bed Detached	9
JD421	4 Bed Detached	12
Sub total		169no. units

Affordable (Shared Ownership)		
Type	No of Beds	No of Units
JS203_HA	2 Bed Semi Detached	16
S304_HA	3 Bed Semi Detached	5
JS326_HA	3 Bed Semi Detached	4
JS317_HA	3 Bed Semi Detached	1
JD422_HA	4 Bed Detached	2
Sub total		28no. units

Affordable (Rented)		
Type	No of Beds	No of Units
JS110_HA	1 Bed Apartment	12
JS203_HA	2 Bed Semi Detached	42
JD203_HA	2 Bed Terraced	1
S304_HA	3 Bed Semi Detached	14
JS326_HA	3 Bed Semi Detached	13
JS317_HA	3 Bed Semi Detached	3
Sub total		85no. units

Total		282no. units
-------	--	--------------

- Badger Sett
- 10m Zone Badger Sett 10m Exclusion Zone
 - 20m Zone Badger Sett 20m Exclusion Zone
 - 30m Zone Badger Sett 30m Exclusion Zone

REV	DESCRIPTION	DATE	BY
K	Plot substitutions at Plots 7-10, 57-60 & 173-177	16.04.24	EG
J	Ditch updated at site frontage to reflect as-built survey	01.02.2024	EG
H	Fire turning revised near plots 251-258	24.06.2023	EG
G	Plot Substitutions at Plots 13, 16, 19, 20, 23, 26, 33, 43, 48, 61, 62, 80, 85, 89, 130, 131, 137, 138, 142, 147, 156, 166, 167, 172, 175, 185, 200, 210, 219, 223, 232, 240, 245 Plot 250 Garage and Boundary Moved	18.05.2023	HES
F	Substation Location and dimensions amended	20.03.2023	HES
E	Site frontage wall position amended.	02.03.2023	LM
D	Badger Sett Added	22.07.22	SPM
C	JS204-1A house type code changed to JS326-1A JS307-1A house type code changed to JS317-1A	14.01.22	JC
B	Bin collection points updated and schedule of accommodation amended.	15.11.21	JC
A	Elevation codes removed.	20.06.21	JC

PROJECT TITLE:
PROPOSED RESIDENTIAL DEVELOPMENT
LOWER GRANGE FARM
MARKFIELD
LEICESTERSHIRE

DRAWING TITLE:
PLANNING LAYOUT (OVERALL)

DRAWING SCALE:
1:1250 @ A1

DRAWN BY:
SPM

DRAWING STATUS:
FOR CONSTRUCTION

DRAWING NUMBER:
K

CHECKED BY:
K

DRAWING DATE:
16/04/2021

DRAWING REVISION:
K



JELSON LTD
370 LOUGHBOROUGH ROAD
LEICESTER
LE4 5PR
Tel: 0116 2661541 - Fax: 0116 2664589 - Web: www.jelson.co.uk