AMENDED PLAN.
17.08.09

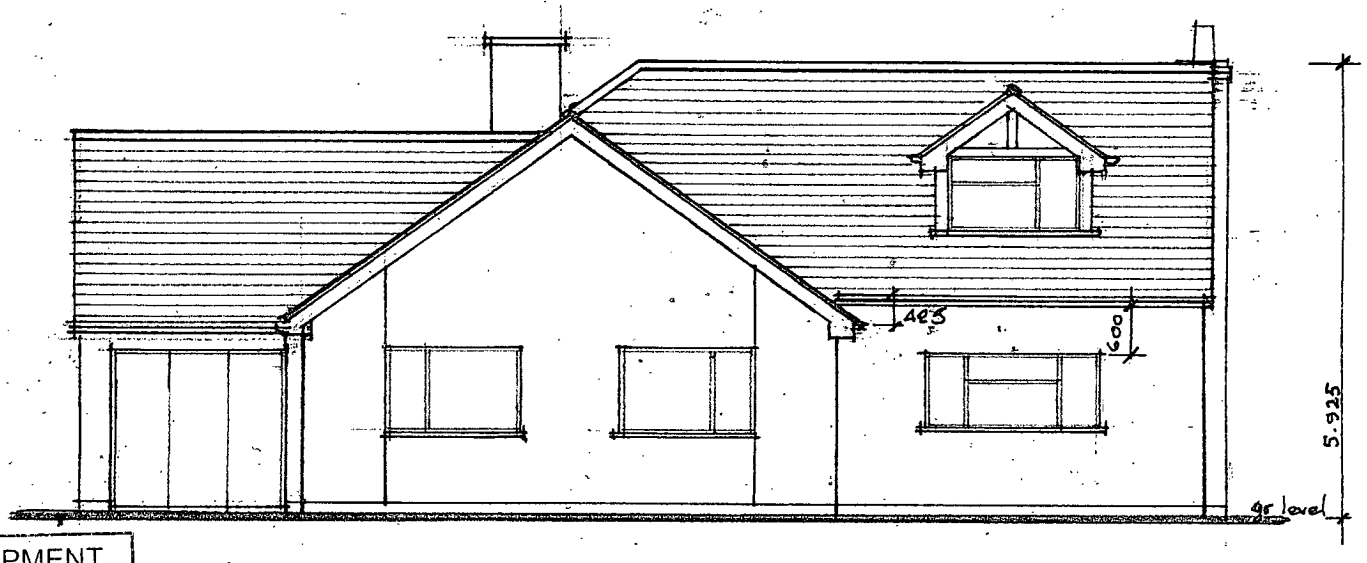

S. W. ELEVATION

DEVELOPMENT SERVICES
17 AUG 2009
RECEIVED

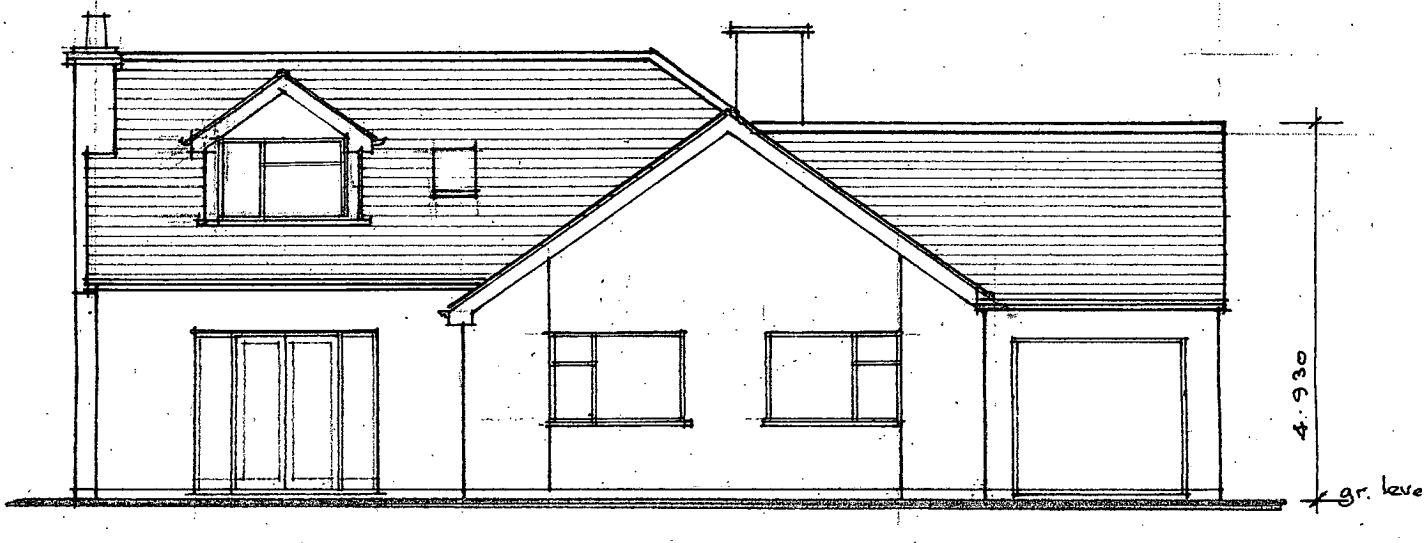

N. E. ELEVATION.

ELEVATIONS (As Built).	C. J. RUSTED M.C.I.A.T.
KITCHEN & BEDROOM EXTENSIONS 23 ALFRETON CLOSE BURBAGE.	Date: Aug 09. Scale: 1:100. Drwg N° T0620e8.4