AMENDED REAR
17.08.09.

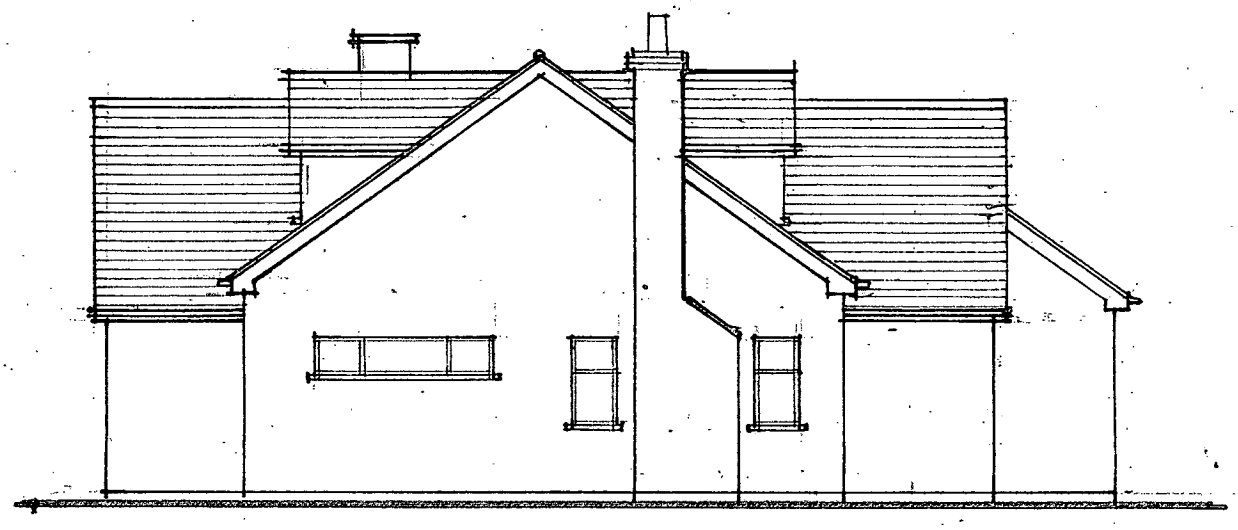

S.E. ELEVATION

DEVELOPMENT SERVICES
17 AUG 2009
RECEIVED

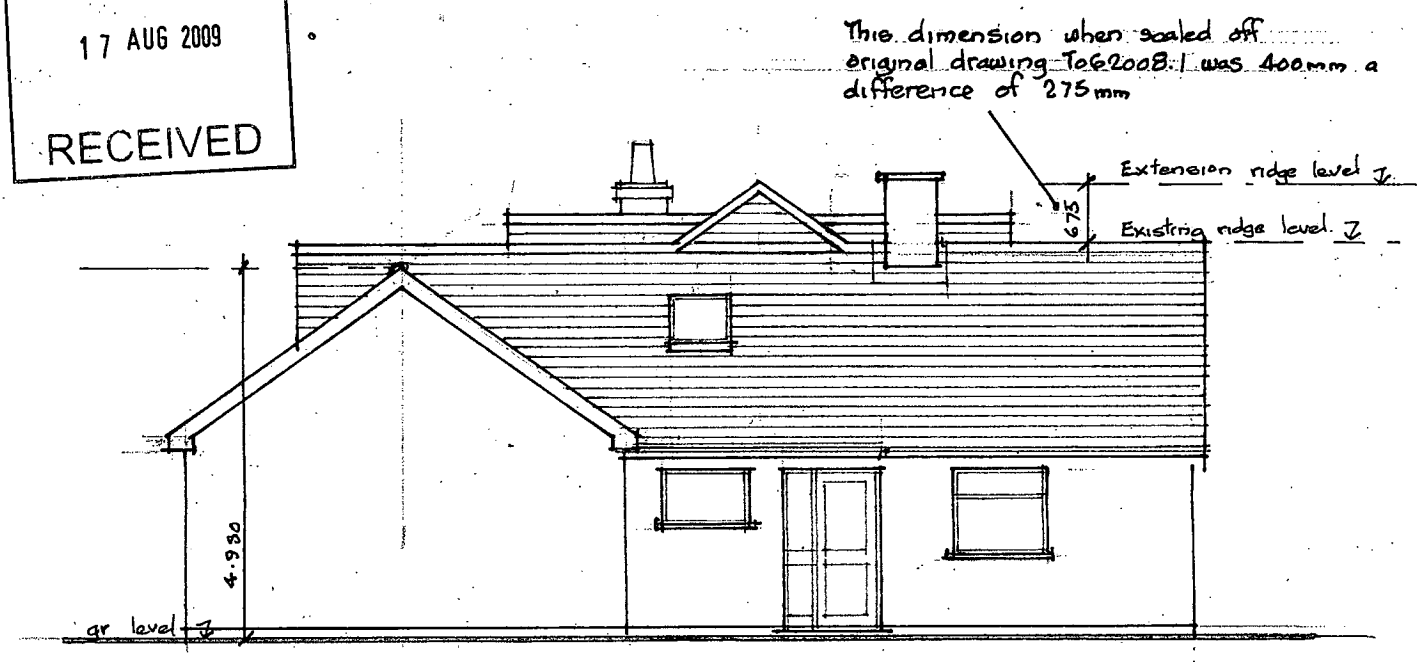

N. W. ELEVATION

ELEVATIONS (As Built.)

C. J. RUSTED M.C.I.A.T.

KITCHEN & BEDROOM EXTENSIONS
29 ALFRETON CLOSE BURBAGE.

Date: Aug 09
Scale: 1:100 Drwg N° TOG2008.5