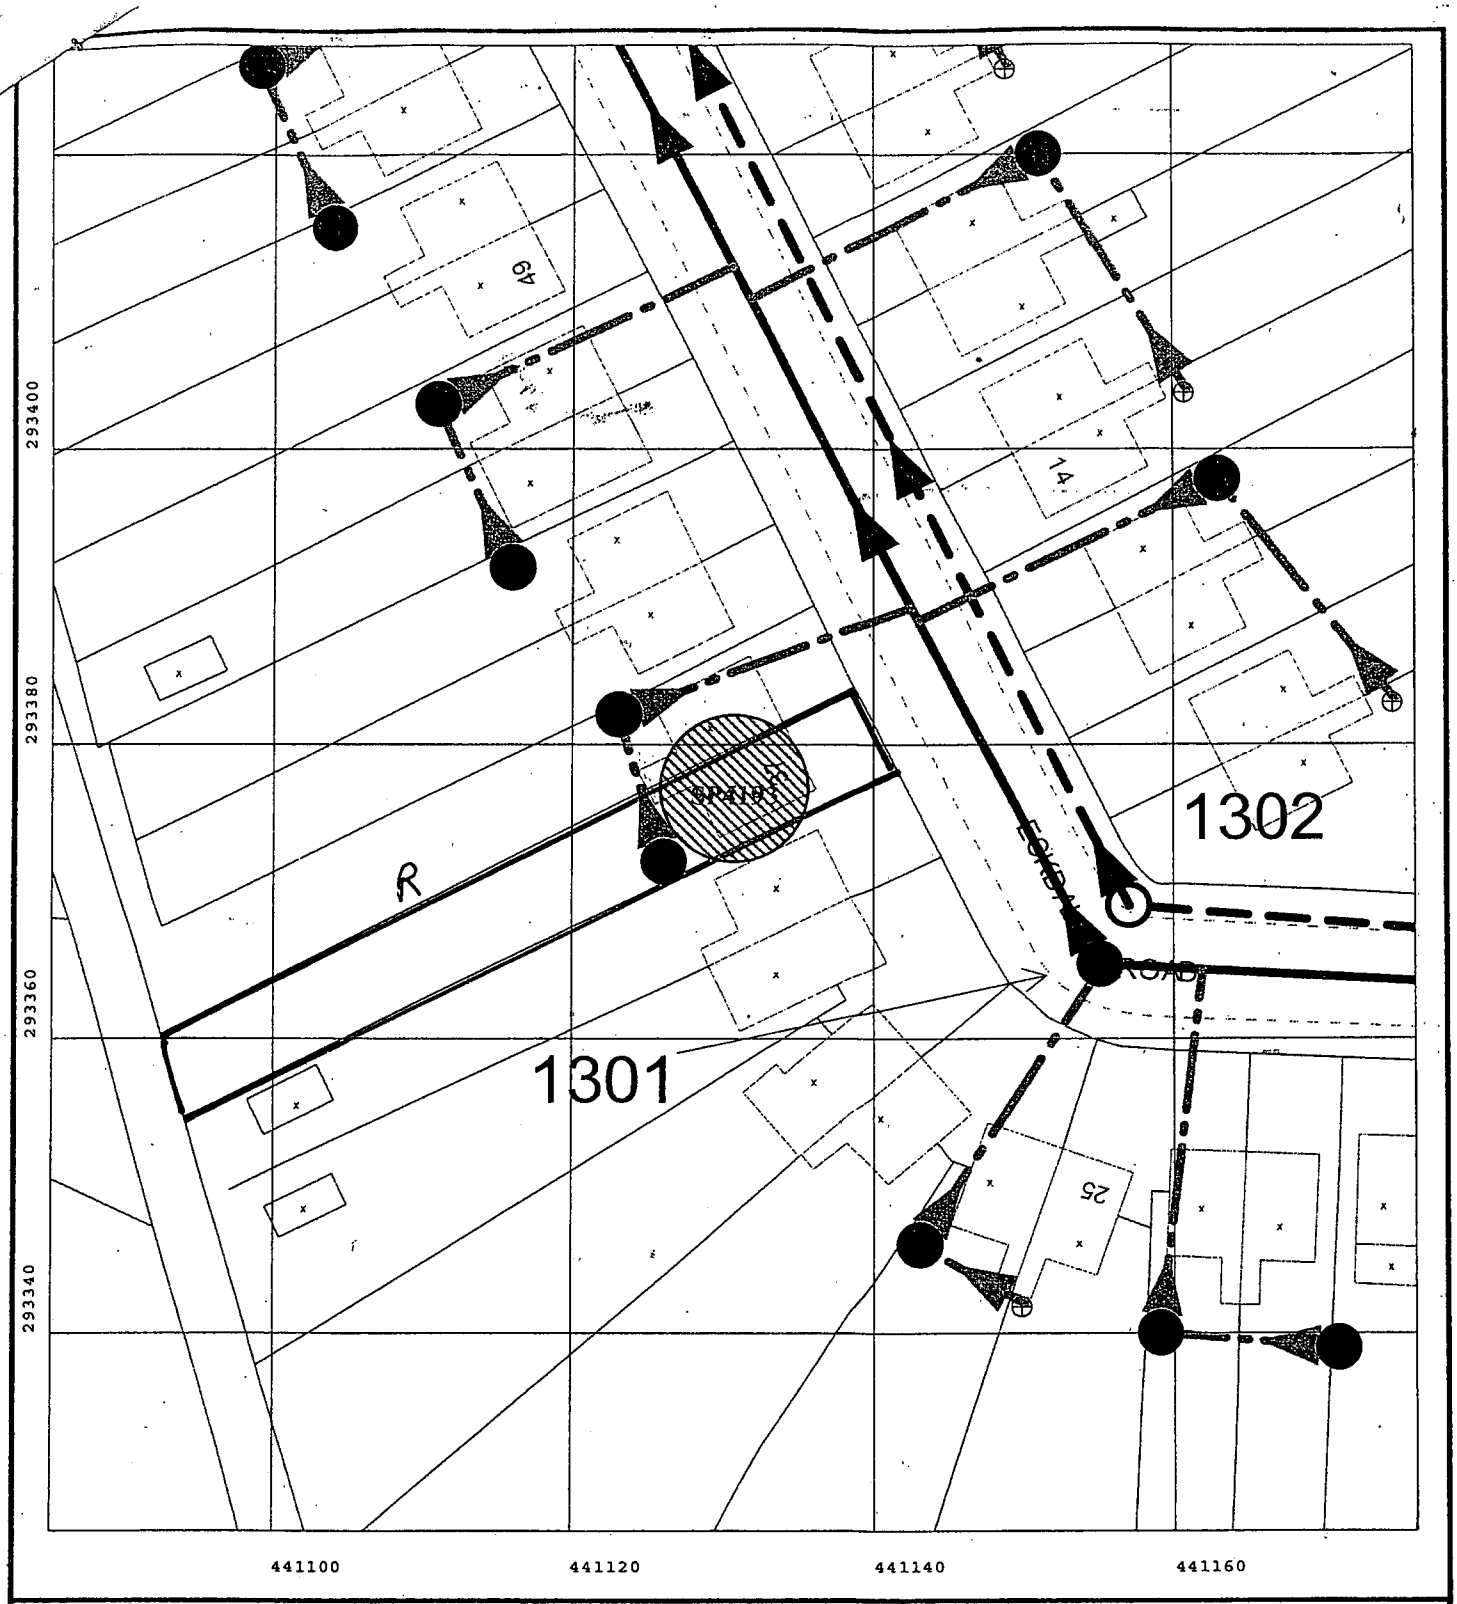

- Abandoned Gravity Sewer
- Private Combined Gravity Sewer
- Private Foul Gravity Sewer
- Private Surface Water Gravity Sewer
- Public Combined Gravity Sewer
- Public Foul Gravity Sewer
- Public Surface Water Gravity Sewer
- Trunk Combined Gravity Sewer
- Trunk Foul Use Gravity Sewer
- Trunk Surface water Gravity Sewer
- Abandoned Pressurised Sewer
- Combined Use Pressurised Sewer
- Foul Use Pressurised Sewer
- Surface Water Pressurised Sewer
- Highway Drain
- Combined Lateral Drain (SS)
- Foul Lateral Drain (SS)
- Surface Water Lateral Drain (SS)

All Private Sewers are shown in magenta
All Section 104 sewers are shown in green
All Non-Sewer Standard (NSS) Lateral Drains are shown in orange

- Blind Shaft
- Combined Use Manhole
- Disposal Site (DS)
- Flushing Chamber
- Foul Use Manhole
- Grease Trap
- Head Node
- Hydrobrake
- Lamphole
- Outfall
- Overflow
- Penstock
- Petrol Interceptor
- Sewage Treatment Works (STW)

- Sewer Blockage
- Sewer Chemical Injection Point
- Sewer Collapse
- Sewer Junction
- Sewerage Air Valve
- Sewerage Hatch Box Point
- Sewerage Isolation Valve
- Soakaway
- Surface Water Manhole
- Vent Column
- Waste Water Storage
- Culverted Watercourse
- Access Right
- Sewage Pumping Facility
- Sewer Facility Connection (Sewer Pumping Facility Inlet / Outlet, Sewer Treatment Works Inlet / Outlet)

LE10 0NW

Severn Trent Water

Severn Trent Water Limited
Waterworks Road
Edgbaston
Birmingham
B16 9DD
Telephone: 0845 601 6616

SEWER RECORD

Job ref.:
O/S Map scale: 1: 500
Date of issue: 24.08.07

This map is centred upon:
O / S Grid reference:
x - 441131
y - 293377

Do not scale off drawing.
Disclaimer:
1. This plan and any information supplied with it is furnished as a general guide, is only valid at the date of issue and no warranty as to its correctness is given or implied. In particular this plan and any information shown on it must not be relied upon in the event of any development or works (including but not limited to excavations) in the vicinity of Severn Trent's assets or for the purposes of determining the suitability of a point of connection to the sewerage or distribution systems.
The Positional Accuracy Improvement programme currently being implemented by Ordnance Survey may mean that the Severn Trent assets shown on this plan are not actually in the position indicated.
It is strongly recommended that a survey is carried out to determine the precise location of Severn Trent's assets.
2. The material contained in this drawing has been based upon the Ordnance Survey Map by SEVERN TRENT WATER Ltd. by permission of Ordnance Survey on behalf of the controller of her Majesty's Stationery Office.
© Crown Copyright - SEVERN TRENT WATER Ltd. • WU298522
3. Document users other than SEVERN TRENT WATER business users are advised that this document is provided for reference purpose only and no further copies should be made.