ORIGINAL

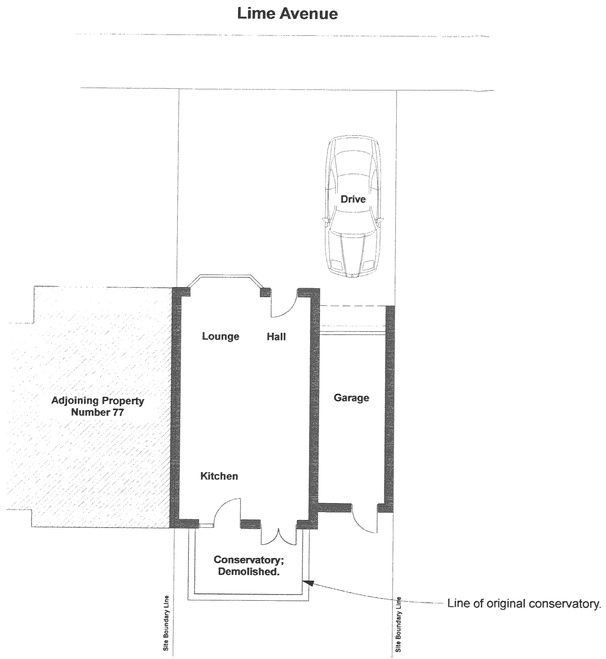

ORIGINAL FLOOR PLAN - 1:100

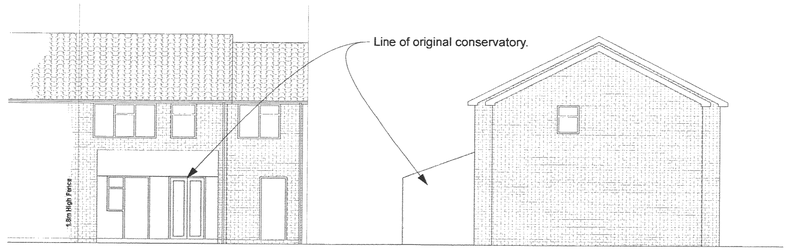

ORIGINAL REAR ELEVATION - 1:100

ORIGINAL SIDE ELEVATION - 1:100

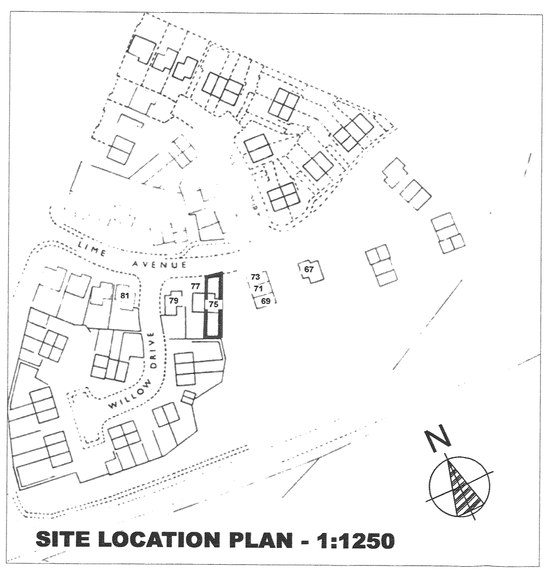

SITE LOCATION PLAN - 1:1250

NOTES:

1) This drawing MUST NOT BE SCALED.

2) All dimensions to be CHECKED ON SITE and any DISCREPANCY reported to the Architects.

AS BUILT

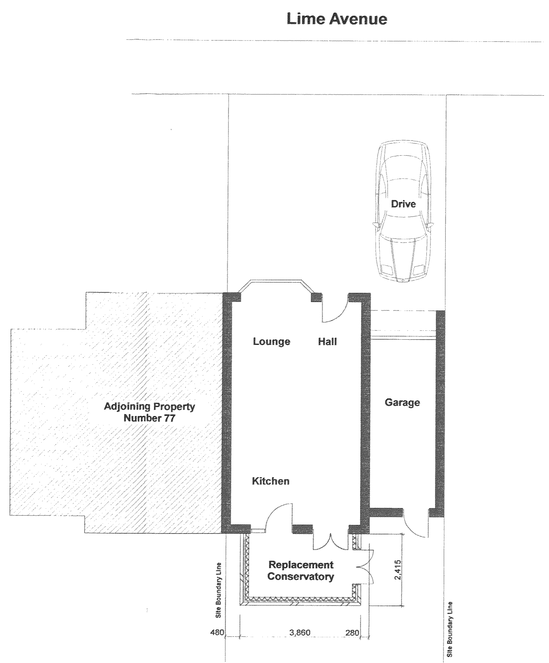

NEW FLOOR PLAN - 1:100

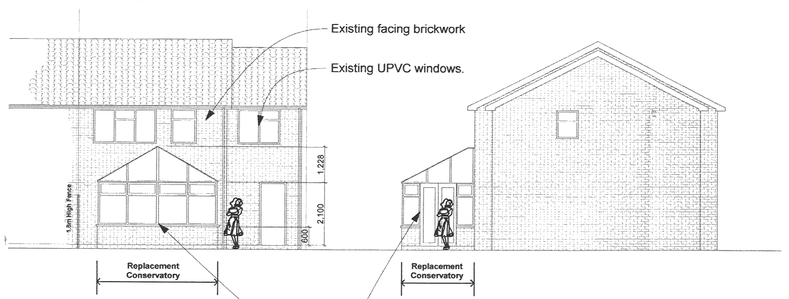

NEW REAR ELEVATION - 1:100

NEW SIDE ELEVATION - 1:100

New Conservatory;
Brick plinth to match house;
White UPVC framing with clear glass.



PHOTO AS BUILT

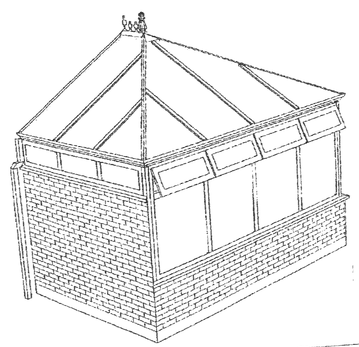

VISUAL OF CONSERVATORY (NTS)

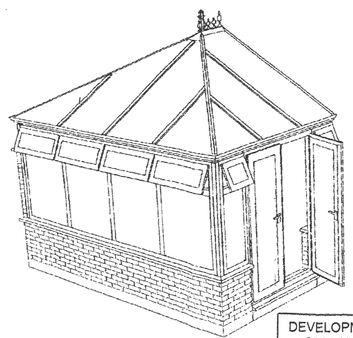

DEVELOPMENT SERVICES
- 5 JUN 2008
RECEIVED

Approval ☒ Information ☐
Preliminary ☐ For Construction ☐

REPLACEMENT CONSERVATORY:

75 LIME AVENUE
GROBY
LEICESTER

Mr L Overy

SCANNED

Drawing Title
ORIGINAL AND PROPOSED
PLANS, ELEVATIONS & SITE LOCATION PLAN

Drawn By	Checked By
Date: JUNE 2008	Scale: 1:100 @ A1
Drawing Number: 0001	Revision