



Tier Consult Ltd

Unit 5 Office Village, Sandpiper Court,
Chester Business Park, Chester CH4 9QZ
01244 684900

Project Excellence, Battram, Leicestershire, LE67 1HT.

Drainage Strategy

May 2025

Version 1.2



DOCUMENT CONTROL

Project No:	T/24/2757
Report Status:	Preliminary
Version No:	1.2
Project Engineer:	Ellie Grimsley
Date of Issue:	12/05/2025

This report has been prepared by Tier Consult with all reasonable skill, care and diligence, within the best practice and guidance current at the time of issue within the scope of works which have been agreed with the Client. This report is confidential to the Client and Tier Consult accepts no responsibility whatsoever to third parties to whom this report, or any part thereof is made presented, unless this is formally agreed in writing by a Director of Tier Consult before any reliance is made. Any such party relies upon the report at their own risk. Tier Consult disclaims any responsibility to the Client and others in respect of any matters outside the agreed scope of the work.

Version	Date Issued	Purpose of Issue	Author	Reviewed	Approved
V1.0	09/05/2025	Planning	ESG	JH	PJB
V1.1	12/05/2025	Planning	ESG	JH	PJB
V1.2	31/07/2025	Planning	JH	JH	PJB



Contents

1. Introduction
2. Site Description and Development Proposal
3. Existing Drainage
4. Surface Water Drainage
5. Proposed Surface Water Strategy
6. Proposed Foul Drainage Strategy

List of Appendices

Appendix A	Topographic Survey
Appendix B	Pre-Planning Sewerage Enquiry – Severn Trent Response
Appendix C	Drainage Layout



1.0 Introduction

- 1.1 Tier Consult have been appointed by Barberry Bardon Ltd, to prepare a drainage strategy proposal for the proposed development off Station Road, Battram, Leicestershire.
- 1.2 The report aims to provide an outline of the proposed drainage strategy, taking account of the requirements of the National Planning Policy Framework (NPPF) and associated Planning Practice Guidance.

2.0 Site Description and Development Proposal

- 2.1 The site is located adjacent off Station Road, Battram, Leicestershire. LE67 1HT. The approximate National Grid Reference for the centre of the site is SK438098 with coordinates Easting: 443814, Northing: 309801 at postcode LE67 1HT
- 2.2 The proposed development is 12.50Ha with a max impermeable area of 11.6Ha
- 2.3 A topographic survey (Appendix A) has been undertaken by Blue Earth Construction, indicates that the site predominantly falls from south to north with site levels varying from circa 162.6m to 150.3m AOD.
- 2.4 The soilscapes mapping details the site conditions to be Mudstone and siltstone, red-brown and greenish grey, with beds of indurated, variably dolomitic siltstone and very fine-grained sandstone common in the lower half; finely disseminated gypsum common in upper half. British Geological Survey Map indicates that the geological sequence below the site comprises mudstone of siltstone.

3.0 Existing Drainage

- 3.1 The development land is greenfield located southwest of Bardon Hill Industrial Estate. There are no public sewers within the site boundary.
- 3.2 Severn Trent Water have provided public sewer records in response to the pre-planning sewerage enquiry (Appendix B).

4.0 Surface Water Drainage

- 4.1 Requirement H3 of the Building Regulations 2010 and the NPPF, as suggested by Leicestershire County Council LLFA, prescribe a hierachal approach to surface water discharge. Consideration should firstly be given to discharge to soakaway, infiltration system and watercourse in that priority order before discharge to a sewer/formal drainage system is considered.

The government guidance to local authorities includes a hierarchy of connection, which can be summarised as follows:

- a) surface water runoff is collected for use.
- b) discharge into the ground via infiltration.
- c) discharge to a watercourse or other surface water body.
- d) discharge to a surface water sewer, highway drain or other drainage system, discharging to a watercourse or other surface water body.



- e) discharge to a combined sewer.

4.2 **Infiltration/Soakaways**

- 4.2.1 The ground infiltration testing has not been carried out on the site at this stage, however from the desktop study reviewing the BGS and soils mapping the ground conditions defined do not suggest that infiltration is achievable.

4.3 **Discharges to Watercourse**

- 4.3.1 There is a ditch to the south of the development and an existing pond to the east of the site. Existing photographs indicate the existing pond and southern ditch within appendix D.

5.0 **Proposed Surface Water Drainage Strategy**

- 5.1 Following the planning guidance, the existing area of 12.5 Ha has been used to calculate the greenfield run-off rate as 54.9l/s.
- 5.2 As there is an existing pond to the east of the development, the proposed drainage strategy is discharge into an existing surface water network that discharges to the pond.
- 5.3 The storm water drainage system is to be designed in accordance with the requirements of the NPPF and associated Planning Practice Guidance to ensure that flood risk is not increased, either on or off site, for all storm events up to and including the 1 in 100 year +40% climate change events.
- 5.4 The strategy is to restrict the surface water discharge rate to 54.9 l/s. This is to ensure that the discharge rate at the outfall location remains the same as the greenfield run off rate of the site.
- 5.5 Surface water runoff from roofs, private drives and any adoptable highways, will drain via a piped network to an attenuation facility which will provide attenuation storage for all flows up to and including the 1 in 100-year event plus 40% for climatic change. Refer to appendix C.
- 5.6 SuDS features, such as permeable paving and attenuation ponds, will be incorporated into the surface water drainage proposals to aid in the mitigation requirements for water quality prior to discharging to the wider natural surface water drainage network.
- 5.7 In addition to the SuDS features mentioned above, the proposals also include a petrol/ oil interceptor with an enhanced silt retention providing greater pollution mitigation indices.



6.0 Proposed Foul Drainage Strategy


6.1 The proposed foul drainage system will convey foul flows via a piped network and discharge into a proposed private pumping station. Foul water will be pumped to Station Road and connect to the Severn Trent adopted network.


Proposed drainage layout is pertained in Appendix C.





Appendix A

Topographic Survey

 

 

 

 



Appendix B

Pre-Planning Sewerage Enquiry – Severn Trent Water Response

WONDERFUL ON TAP

SEVERN

TRENT

Unit 5 Office Village,
 Sandpiper Court,
 Chester Business Park,
 Chester,
 CH4 9QZ

F.A.O: Joe Botting

09/02/2024

Severn Trent Water Ltd
 Leicester Water Centre
 Gorse Hill
 Anstey
 Leicester
 LE7 7GU

www.stwater.co.uk

Email:
Network.Solutions@SevernTrent.co.uk
 Page Barot
 Tel:
 Our ref: 1106607

Dear Sir/Madam,

**Proposed Development: (1 industrial unit – 3I/s) Wood Road,
 Coalville, LE67 1GA, 443548, 309455**

I refer to your 'Development Enquiry Request' in respect of the above named site. Please find enclosed the sewer records that are included in the fee together with the Supplementary Guidance Notes (SGN) which refer to surface water disposal from development sites.

Protective Strip

No public sewers within site boundary.

Due to a change in legislation on 1 October 2011 there may be former private sewers on the site which have transferred to the responsibility of Severn Trent Water Ltd, which are not shown on the statutory sewer records, but are located in your client's land. These sewers would require protective strips of 3 metres either side of the sewer's centreline that we will not allow to be built over. If such sewers are identified to be present on the site, please contact us for further guidance.

Please note: there is no guarantee that you will be able to build over or close to any Severn Trent sewers, and where a diversion is required there is no guarantee that you will be able to undertake those works on a self-lay basis. Every approach to build near to or divert our assets has to be assessed on its own merit and the decision of what is or isn't permissible is taken based on the risk to the asset and the wider catchment it serves. It is vital therefore that you contact us at the earliest opportunity to discuss the implications of our assets crossing your site. Failure to do so could significantly

affect the costs and timescales of your project if it transpires diversionary works need to be carried out by Severn Trent.

Foul Water Drainage

After reviewing the proposed options, the 225mm combined sewer, MH SK44091301 along station Road would be the most suitable connection point for your development due it having larger capacity and can be reached via gravity. The network can accommodate flows for 1 industrial unit (2.28 l/s 2dwf). Therefore, a connection is acceptable to the company subject to a S106 submission.

Alternatively, connection to the 150mm combined network along Battram road is also a suitable connection point it can be reached via gravity and is the closest to the site. However, we are unable to confirm if this connection point has enough capacity to handle the flows as a result modelling will need to take place.

In a change to our previous process, we no longer charge developers for the hydraulic modelling service. We will liaise with you over time with regards to the outcome of our investigations and any impact that may have on the planning status, occupation, or phasing of the site. However, while we can provide a brief summary of our findings if you need us to, we will no longer provide the full external capacity assessment report.

From the application you have submitted, I am assuming that the development has not been granted planning approval. Please inform us as and when planning has progressed as this will help determine how quick we carry out the modelling exercise. In the meantime, the site will be added to our modelling tracker and reviewed regularly until the site can be progressed for sewer modelling.

Surface Water Drainage

Under the terms of Section H of the Building Regulations 2000, the disposal of surface water by means of soakaways should be considered as the primary method. If these are found to be unsuitable, satisfactory evidence will need to be submitted. The evidence should be either percolation test results or by the submission of a statement from the SI consultant (extract or a supplementary letter).

Severn Trent Water expects all surface water from the development to be drained in a sustainable way to the nearest watercourse or

land drainage channel, subject to the developer discussing all aspects of the developments surface water drainage with the Local Lead Flood Authority (LLFA). Any discharge rate to a watercourse or drainage ditch will be determined by the LLFA / EA.

Note, STW will have to be satisfied that all sustainable option have been exhausted before allowing discharge to the public network.

Sewer records show a watercourse that runs east of the site. It is advised to pursue a connection to this if feasible, with flow rates to be agreed by the LLFA.

Connections


For any new connections (including the re-use of existing connections) to the public sewerage system, the developer will need to submit a Section 106 application form. Our Developer Services department are responsible for handling all new connections enquiries and applications. To contact them for an application form and associated guidance notes please call 0800 7076600 or download from www.stwater.co.uk.

Please quote the above reference in any future correspondence (including e-mails) with STW Limited. Please note that Developer Enquiry responses are only valid for 6 months from the date of this letter.

Yours sincerely



Page Barot
Network Solutions
Developer Services

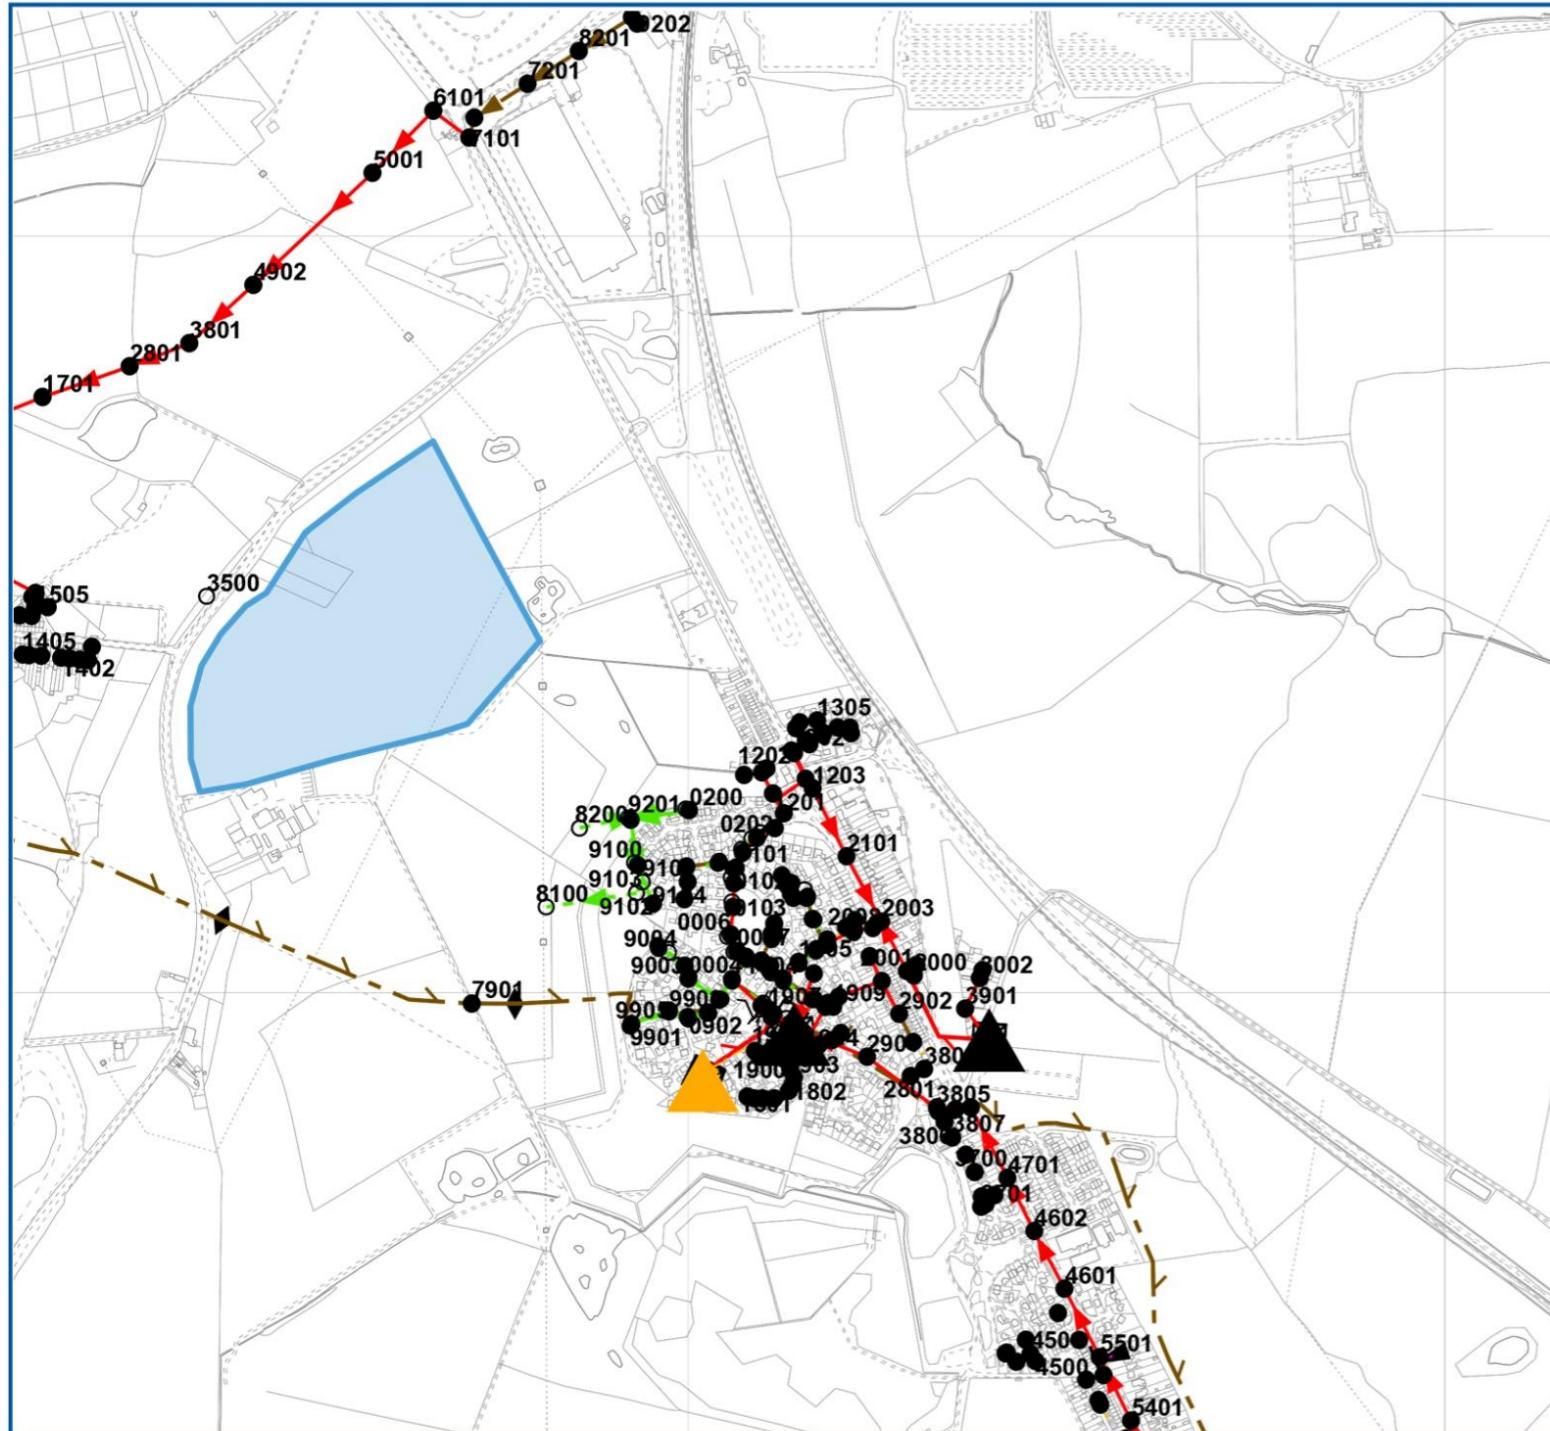

Reference	Cover Level	Invert Level Upstream	Invert Level Downstream	Purpose	Material	Pipe Shape	Max Size	Min Size	Gradient	Year Laid
SK44090100	0	<UNK>	<UNK>	C	<UNK>	<UNK>	<UNK>	<UNK>	0	01/12/2011 00:00:00
SK44082902	152.6	151.65	151.2	C	VC	C	150	<UNK>	110.33	31/12/1899 00:00:00
<UNK>	<UNK>	<UNK>	<UNK>	S	<UNK>	<UNK>	<UNK>	<UNK>	<UNK>	16/05/2012 00:00:00
SK44081910	<UNK>	151.18	149.13	C	VC	C	225	<UNK>	36.92	28/06/2016 00:00:00
SK44082903	152.2899	151.8	151.65	F	VC	C	150	<UNK>	277.27	31/12/1899 00:00:00
SK44080901	<UNK>	0	0	F	U	U	0	0	0	31/12/1899 00:00:00
SK43099001	0	<UNK>	<UNK>	S	U	U	<UNK>	<UNK>	0	31/12/1899 00:00:00
SK43089901	<UNK>	<UNK>	<UNK>	S	U	U	<UNK>	<UNK>	0	31/12/1899 00:00:00
SK43099202	<UNK>	<UNK>	<UNK>	F	<UNK>	<UNK>	<UNK>	<UNK>	<UNK>	31/12/1899 00:00:00
SK44090202	0	<UNK>	<UNK>	C	<UNK>	<UNK>	<UNK>	<UNK>	0	01/12/2011 00:00:00
SK44081905	<UNK>	146.96	146.84	F	U	<UNK>	150	<UNK>	<UNK>	31/12/1899 00:00:00
SK44092001	153.1	151.65	150.6	C	VC	C	225	<UNK>	68.58	31/12/1899 00:00:00
SK44091303	155.38	153.91	153.42	C	VC	C	150	<UNK>	98.71	31/12/1899 00:00:00
SK43107201	170	0	101.89	F	VC	C	225	0	<UNK>	31/12/1899 00:00:00
SK43098200	<UNK>	<UNK>	<UNK>	S	<UNK>	<UNK>	<UNK>	<UNK>	<UNK>	31/12/1899 00:00:00
SK44081800	<UNK>	147.77	147.62	F	U	<UNK>	150	<UNK>	<UNK>	31/12/1899 00:00:00
SK43089903	<UNK>	0	0	F	U	U	0	0	0	31/12/1899 00:00:00
SK43091504	163.1289	159.07	159.59	C	VC	C	150	<UNK>	<UNK>	31/12/1899 00:00:00
SK44091304	155.3699	154.08	153.62	C	VC	C	150	<UNK>	100.7	31/12/1899 00:00:00
SK44091006	0	0	0	C	<UNK>	<UNK>	0	0	0	01/12/2011 00:00:00
<UNK>	<UNK>	<UNK>	<UNK>	S	<UNK>	<UNK>	<UNK>	<UNK>	<UNK>	16/05/2012 00:00:00
SK43091701	158.74	157.56	157.33	C	VC	C	225	<UNK>	266.87	31/12/1899 00:00:00
SK44091007	0	0	0	C	<UNK>	<UNK>	0	0	0	01/12/2011 00:00:00
SK43093801	161.69	159.87	157.94	C	VC	C	225	<UNK>	43.91	31/12/1899 00:00:00
SK44083808	157.1399	155.78	154.41	F	VC	C	150	<UNK>	17.66	31/12/1899 00:00:00
SK43099102	<UNK>	<UNK>	<UNK>	S	<UNK>	<UNK>	<UNK>	<UNK>	<UNK>	31/12/1899 00:00:00
SK43099005	0	<UNK>	<UNK>	S	U	U	<UNK>	<UNK>	0	31/12/1899 00:00:00
SK44081803	<UNK>	147.49	147.41	F	U	<UNK>	150	<UNK>	<UNK>	31/12/1899 00:00:00
SK44083802	<UNK>	<UNK>	153.31	C	VC	C	300	<UNK>	0	31/12/1899 00:00:00

LEGEND

Operational Site

- Waste Water Pump
- Transferred Asset
- S24
- S104
- S102
- Null Private
- Null
- None
- Highway Drain
- Adopted Sewer
- Storage

Disposal Site

- Off-Line Waste Water Storage
- On-Line Waste Water Storage
- Wet Well

Waste Water Process Structure

- STP
- STI
- STP
- STI
- Manhole
- Twin Manhole

Symbol Legend:

- Foul Manhole
- Surface Water Manhole
- Combined Manhole
- Dual Manhole
- UnSurveyed Foul Manhole
- UnSurveyed Surface Water Manhole
- UnSurveyed Combined Manhole
- UnSurveyed Unknown Manhole
- Gravity Sewer Pipe
- Foul Gravity Sewer
- Combined Gravity Sewer
- Surface Water Gravity Sewer
- Disposal Site
- Off-Line Waste Water Storage
- On-Line Waste Water Storage
- Wet Well
- Sewage Treatment Point
- Sewage Treatment Structure
- Sludge Treatment Point
- Sludge Treatment Structure
- Manhole
- Twin Manhole

Asset Types:

- Transferred Foul Sewer
- Disposal Pipe
- Overflow Pipe
- Culverted Water Course
- Waste Internal Site Pipe
- Sewer Service Connection
- Gravity Sewer Others
- Pressure Sewer Pipe
- Surface Water Pressure Sewer
- Combined Pressure Sewer
- Foul Pressure Sewer
- Surface Water Gravity Sewer
- S104 Surface Water Gravity Sewer
- S104 Combined Gravity Sewer
- S104 Foul Gravity Sewer
- Private Surface Water Gravity Sewer
- Private Combined Gravity Sewer
- Private Foul Gravity Sewer
- Surface Water Vacuum Sewer
- Foul Vacuum Sewer
- Combined Vacuum Sewer
- S104 Surface Water Vacuum Sewer
- S104 Combined Vacuum Sewer
- S104 Foul Vacuum Sewer
- Service Pipe
- Surface Water Lateral Drain
- Combined Lateral Drain
- Foul Lateral Drain
- S104 Surface Water Lateral Drain
- S104 Combined Lateral Drain
- S104 Foul Lateral Drain

Private Surface Water Assets:

- Private Surface Water Vacuum Sewer
- Private Combined Vacuum Sewer
- Surface Water Siphon
- Combined Siphon
- Foul Siphon
- Private Surface Water Siphon
- Private Combined Siphon
- Private Foul Siphon
- S104 Surface Water Siphon
- S104 Combined Siphon
- S104 Foul Siphon
- Surface Water Unsurveyed Pipe
- Combined Unsurveyed Pipe
- Foul Unsurveyed Pipe
- Disposal Pipe
- Service Pipe
- Surface Water Lateral Drain
- Combined Lateral Drain
- Foul Lateral Drain

MATERIALS

-	- NONE	W	- WEIR
AC	- ASBESTOS CEME	C	- CASCADE
BR	- BRICK	DB	- DAMBOARD
CC	- CONCRETE BOX CULVERT	SE	- SIDE ENTRY
CI	- CAST IRON	FV	- FLAP VALVE
CO	- CONCRETE	BD	- BACK DROP
CSB	CONCRETE SEGMENTS (BOLTED)	S	- SIPHON
CSU	- CONCRETE SEGMENTS (UNBOLTED)	D	- HIGHWAY DRAIN
PI	- DUCTILE IRON		S104 - SECTION 104

CATEGORIES

W	- WEIR
C	- CASCADE
DB	- DAMBOARD
SE	- SIDE ENTRY
FV	- FLAP VALVE
BD	- BACK DROP
S	- SIPHON
D	- HIGHWAY DRAIN
S104	- SECTION 104

PURPOSE
C - COMBINED
E - FINAL EFFLUENT
F - FOUL
L - SLUDGE
S - SURFACE WATER

Severn Trent Water Limited
Asset Data Management
PO Box 5344
Coventry

SEWER RECORD (Tabular)

O/S Map Scale: 1:10,000

This map is centred upon:

Date of Issue: 09-02-24

X: 444125.53 **X:** 309355.54

Disclaimer Statement

- 1 Do not scale off this Map.
- 2 This plan and any information supplied with it is furnished as a general guide, is only valid at the date of issue and no warranty as to its correctness is given or implied. In particular this plan and any information shown on it must not be relied upon in the event of any development or works (including but not limited to excavations) in the vicinity of SEVERN TRENT WATER assets or for the


purposes of determining the suitability of a point of connection to the sewerage or distribution systems.

3 On 1 October 2011 most private sewers and private lateral drains in Severn Trent Water's sewerage area, which were connected to a public sewer as at 1 July 2011, transferred to the ownership of Severn Trent Water and became public sewers and public

lateral drains. A further transfer takes place on 1 October 2012. Private pumping stations, which form part of these sewers or lateral drains, will transfer to ownership of Severn Trent Water on or before 1 October 2016. Severn Trent Water does not possess complete records of these assets. These assets may not be displayed on the map.

4 Reproduction by permission of Ordnance Survey on behalf of the Secretary of State for Transport

5 Ordnance Survey licence number: **100031673**
5 Ordnance Survey licence number: **100031673**

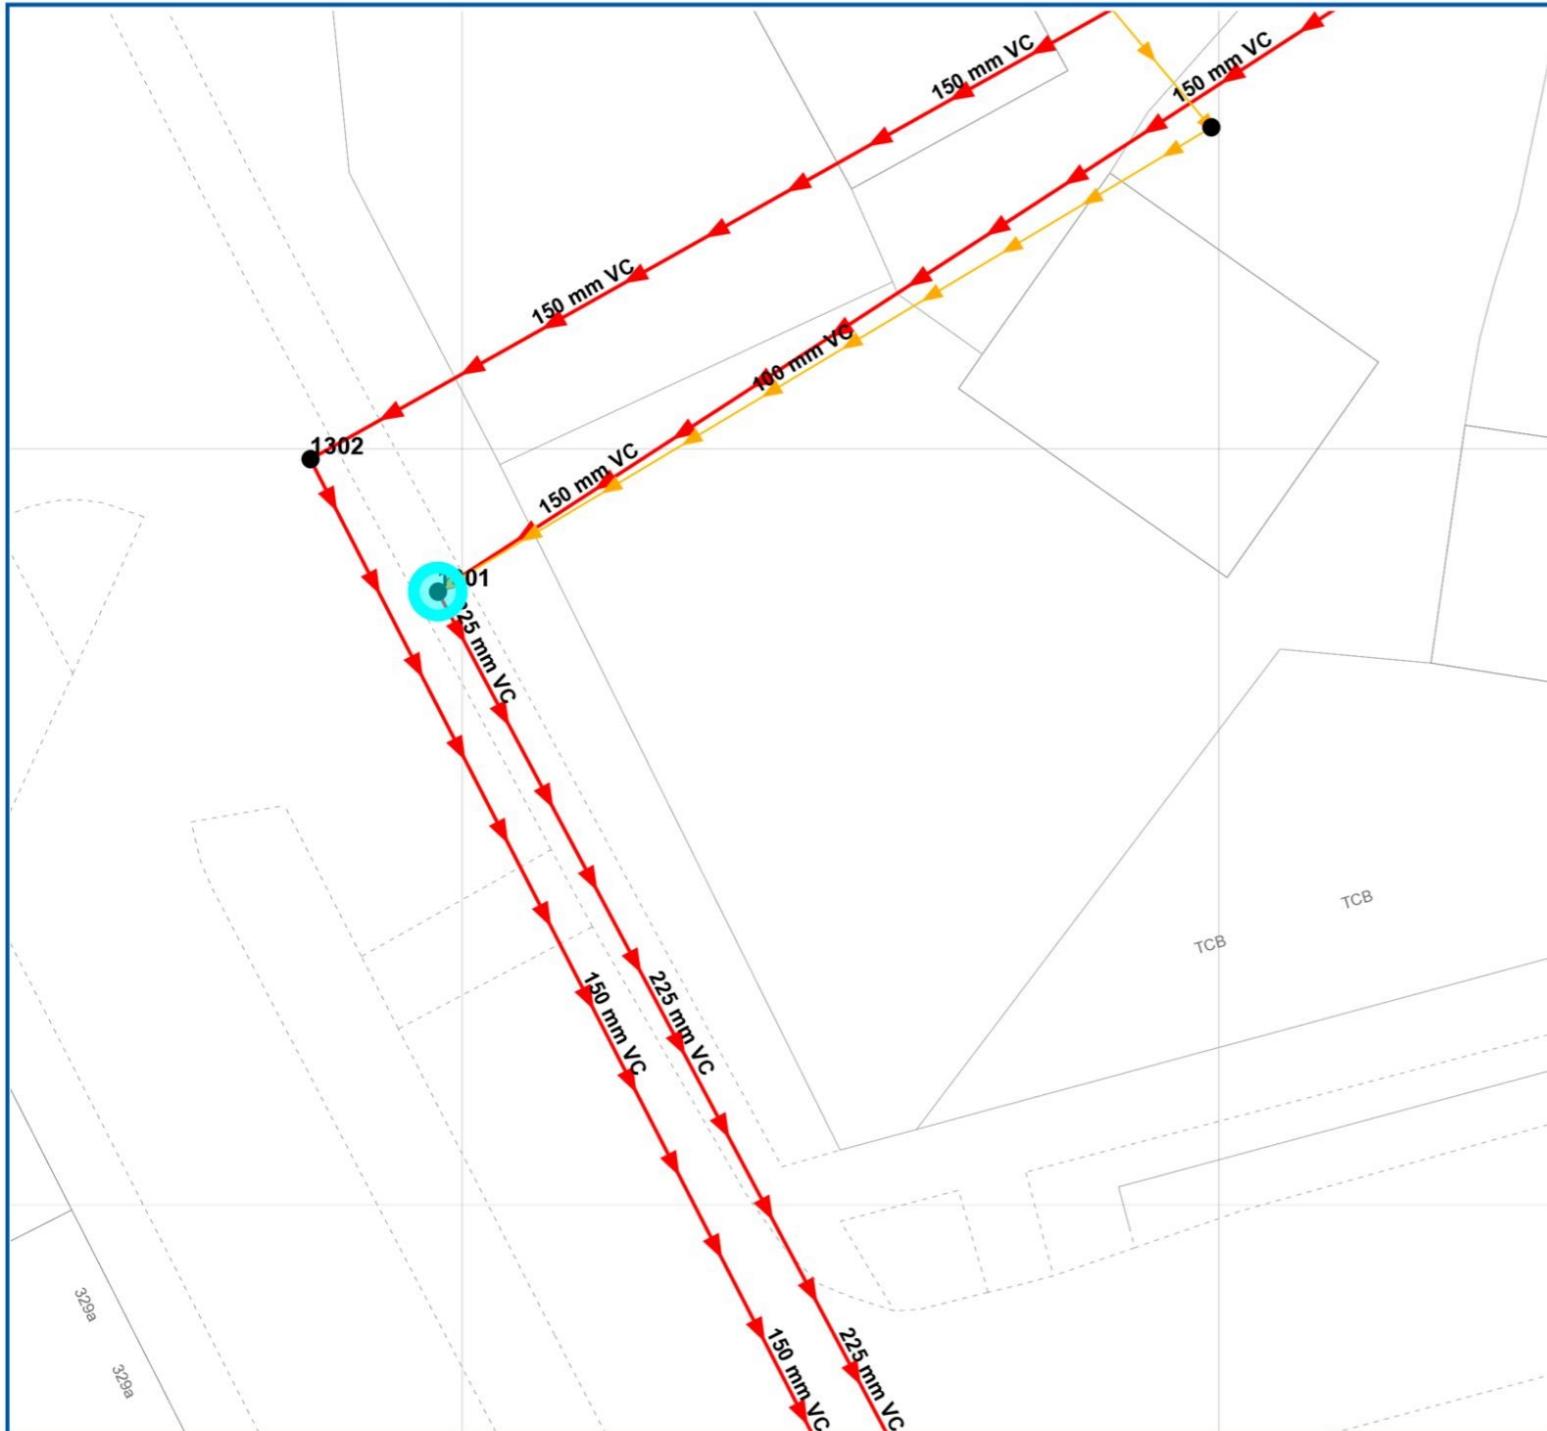

Reference	Cover Level	Invert Level Upstream	Invert Level Downstream	Purpose	Material	Pipe Shape	Max Size	Min Size	Gradient	Year Laid
SK44091301	155.2899	153.59	153.02	C	VC	C	225	<UNK>	94.95	31/12/1899 00:00:00
SK44091302	155.2799	153.41	152.89	C	VC	C	150	<UNK>	81.71	31/12/1899 00:00:00
<UNK>	<UNK>	<UNK>	<UNK>	C	VC	<UNK>	<UNK>	<UNK>	<UNK>	31/12/1899 00:00:00

LEGEND

Operational Site	● Foul Manhole	○ Surface Water Manhole	● Combined Manhole	● Dual Manhole	● UnSurveyed Foul Manhole	○ UnSurveyed Surface Water Manhole	● UnSurveyed Combined Manhole	● UnSurveyed Unknown Manhole
Waste Water Pump								
Null								
None								
Highway Drain								
Adopted Sewer								
Storage	■ DS							
Disposal Site								
Off-Line Waste Water Storage								
On-Line Waste Water Storage								
Wet Well								
Sewage Treatment Point								
Sewage Treatment Structure								
Sludge Treatment Point								
Sludge Treatment Structure								
Manhole	○	○	○	○	○	○	○	○
Twin Manhole								

MATERIALS

- AC	- ASBESTOS CEME
BR	- BRICK
CC	- CONCRETE BOX CULVERT
CI	- CAST IRON
CO	- CONCRETE
CSB	- CONCRETE SEGMENTS (BOLTED)
CSU	- CONCRETE SEGMENTS (UNBOLTED)
DI	- DUCTILE IRON
GRP	- GLASS REINFORCED PLASTIC
MAC	- MASONRY IN REGULAR COURSES
MAR	- MASONRY RANDOMLY COURSED
PE	- POLYETHYLENE
PF	- PITCH
PP	- POLYPROPYLENE
PSC	- PLASTIC STEEL COMPOSITE
PVC	- POLYVINYL CHLORIDE
RPM	- REINFORCED PLASTIC MATRIX
SI	- SPUN (GREY) IRON
ST	- STEEL
U	- UNKNOWN
VC	- VITRIFIED CLAY
XXX	- OTHER

CATEGORIES

W	- WEIR
C	- CASCADE
DB	- DAMBOARD
SE	- SIDE ENTRY
FV	- FLAP VALVE
BD	- BACK DROP
S	- SIPHON
D	- HIGHWAY DRAIN
S104	- SECTION 104

SHAPE

C	- CIRCULAR
E	- EGG SHAPED
O	- OTHER
R	- RECTANGLE
S	- SQUARE
T	- TRAPEZOIDAL
U	- UNKNOWN

PURPOSE

C	- COMBINED
E	- FINAL EFFLUENT
F	- FOUL
L	- SLUDGE
S	- SURFACE WATER



Severn Trent Water Limited
Asset Data Management
PO Box 5344
Coventry
CV3 9FT
Telephone: 0345 601 6616

SEWER RECORD (Tabular)

O/S Map Scale: 1:200


This map is centred upon:

Date of Issue: 09-02-24

X: 441418.41 Y: 309312.73

Disclaimer Statement:

- 1 Do not scale off this Map.
- 2 This plan and any information supplied with it is furnished as a general guide, is only valid at the date of issue and no warranty as to its correctness is given or implied. In particular this plan and any information shown on it must not be relied upon in the event of any development or works (including but not limited to excavations) in the vicinity of SEVERN TRENT WATER assets or for the purposes of determining the suitability of a point of connection to the sewerage or distribution systems.
- 3 On 1 October 2011 most private sewers and private lateral drains in Severn Trent Water's sewerage area, which were connected to a public sewer as at 1 July 2011, transferred to the ownership of Severn Trent Water and became public sewers and public lateral drains. A further transfer takes place on 1 October 2012. Private pumping stations, which form part of these sewers or lateral drains, will transfer to ownership of Severn Trent Water on or before 1 October 2016. Severn Trent Water does not possess complete records of these assets. These assets may not be displayed on the map.
- 4 Reproduction by permission of Ordnance Survey on behalf of HMSO. Crown Copyright and database right 2004. All rights reserved.
- 5 Ordnance Survey licence number: 100031673
- 6 Document users other than SEVERN TRENT WATER business users are advised that this document is provided for reference purpose only and is subject to copyright; therefore, no further copies should be made from it.

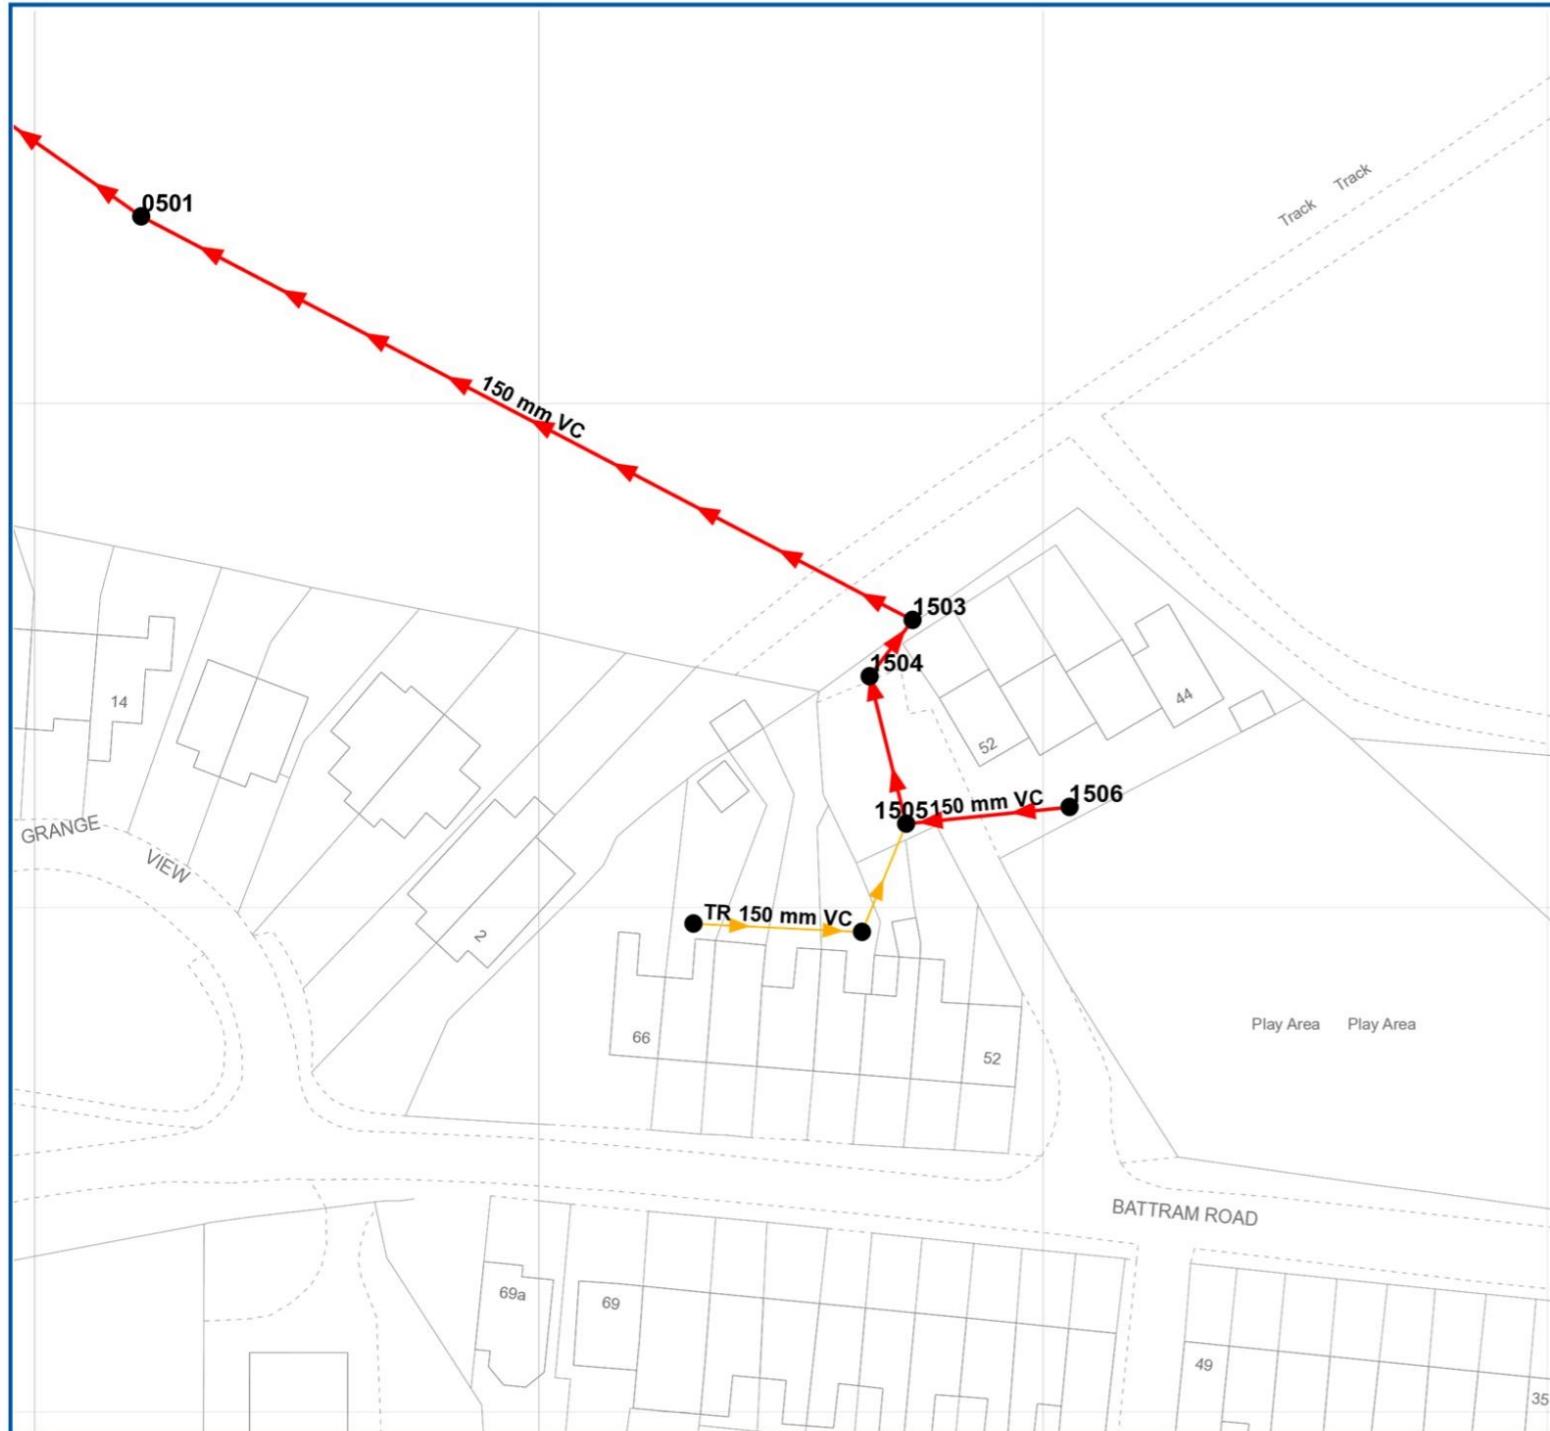

LEGEND

Operational Site	Foul Manhole	Transferred Foul Sewer	Private Surface Water Vacuum Sewer	Private Surface Water Lateral Drain	Sewerage Air Valve
Waste Water Pump	Surface Water Manhole	Disposal Pipe	Private Combined Vacuum Sewer	Private Combined Lateral Drain	Sewerage Chemical Injection Point
Transferred Asset	Combined Manhole	Overflow Pipe	Private Foul Vacuum Sewer	Private Foul Lateral Drain	Sewerage Hatch Box
S24	Dual Manhole	Culverted Water Course	Private Foul Vacuum Sewer	Transferred Surface Water Lateral Drain	Sewerage Pressure Washout
S104	UnSurveyed Foul Manhole	Wade Internal Site Pipe	Combined Siphon	Transferred Combined Lateral Drain	Vent Column
S102	UnSurveyed Surface Water Manhole	Sewer Service Connection	Foul Siphon	Transferred Foul Lateral Drain	Waste Water Outfall
Null Private	UnSurveyed Combined Manhole	Gravity Sewer Others	Private Surface Water Siphon	Ancillary	
Null	UnSurveyed Unknown Manhole	Pressure Sewer Pipe	Private Combined Siphon	Control Valve	
None	Gravity Sewer Pipe	Surface Water Pressure Sewer	Private Foul Siphon	Hydrobake	
Highway Dain	Foul Gravity Sewer	Combined Pressure Sewer	S104 Surface Water Siphon	Grease Trap	
Adopted Sewer	Combined Gravity Sewer	Foul Pressure Sewer	S104 Combined Siphon	Interceptor	
Storage	Surface Water Gravity Sewer	S104 Surface Water Pressure Sewer	S104 Foul Siphon	Screen	
D5	S104 Surface Water Gravity Sewer	S104 Combined Pressure Sewer	Surface Water Unsurveyed Pipe	Chamber	
Off-Line Waste Water Storage	S104 Combined Gravity Sewer	S104 Foul Pressure Sewer	Combined Unsurveyed Pipe	Flushing Chamber	
On-Line Waste Water Storage	S104 Foul Gravity Sewer	Private Surface Water Pressure Sewer	Foul Unsurveyed Pipe	Scalaway	
Wet Well	Private Surface Water Gravity Sewer	Private Combined Pressure Sewer	Disposal Pipe	Overflow	
Waste Water Process Structure	Private Combined Gravity Sewer	Private Foul Pressure Sewer	Service Pipe	Connector	
Sewage Treatment Point	Private Foul Gravity Sewer	Surface Water Vacuum Sewer	Surface Water Lateral Drain	Sewer Junctions	
Sewage Treatment Structure	Surface Water Unsurveyed Pipe	Foul Vacuum Sewer	Combined Lateral Drain	Sewer Line Connection Node	
Sludge Treatment Point	Combined Unsurveyed Pipe	Combined Vacuum Sewer	Foul Lateral Drain	Fitting	
Sludge Treatment Structure	Foul Unsurveyed Pipe	S104 Surface Water Vacuum Sewer	S104 Surface Water Lateral Drain	Print50mLine	
Manhole	Transferred Surface Water Sewer	Transferred Combined Vacuum Sewer	S104 Combined Lateral Drain		
Twin Manhole	Transferred Combined Sewer	S104 Foul Vacuum Sewer	S104 Foul Lateral Drain		

Reference	Cover Level	Invert Level Upstream	Invert Level Downstream	Purpose	Material	Pipe Shape	Max Size	Min Size	Gradient	Year Laid
SK43091503	163.5	159.63	159.37	C	VC	C	150	<UNK>	330.31	31/12/1899 00:00:00
SK43091506	163.2899	159.69	159.68	C	VC	C	150	<UNK>	1607	31/12/1899 00:00:00
SK43090501	163.1999	159.35	158.7	C	VC	C	150	<UNK>	129.17	31/12/1899 00:00:00
SK43091504	163.1289	159.07	159.59	C	VC	C	150	<UNK>	<UNK>	31/12/1899 00:00:00
SK43091505	163.5399	159.65	159.65	C	VC	C	150	<UNK>	0	31/12/1899 00:00:00
<UNK>	<UNK>	<UNK>	<UNK>	C	VC	<UNK>	<UNK>	<UNK>	<UNK>	03/11/2023 00:00:00

LEGEND

MATERIALS		CATEGORIES	
-	- NONE	W - WEIR	
AC	- ASBESTOS CEME	C - CASCADE	
BR	- BRICK	DB - DAMBOARD	
CC	- CONCRETE BOX CULVERT	SE - SIDE ENTRY	
CI	- CAST IRON	FV - FLAP VALVE	
CO	- CONCRETE	BD - BACK DROP	
CSB	- CONCRETE SEGMENTS (BOLTED)	S - SIPHON	
CSU	- CONCRETE SEGMENTS (UNBOLTED)	D - HIGHWAY DRAIN	
DI	- DUCTILE IRON	S104 - SECTION 104	
GRP	- GLASS REINFORCED PLASTIC		
MAC	- MASONRY IN REGULAR COURSES		
MAR	- MASONRY RANDOMLY COURSED		
PE	- POLYETHYLENE		
PF	- PITCH		
PP	- POLYPROPYLENE		
PSC	- PLASTIC STEEL COMPOSITE		
PVC	- POLYVINYL CHLORIDE		
RPM	- REINFORCED PLASTIC MATRIX		
SI	- SPUN (GREY) IRON		
ST	- STEEL		
U	- UNKNOWN		
VC	- VITRIFIED CLAY		
XXX	- OTHER		

PURPOSE	
C - COMBINED	E - FINAL EFFLUENT
E - FINAL EFFLUENT	F - FOUL
F - FOUL	L - SLUDGE
L - SLUDGE	S - SURFACE WATER

Severn Trent Water Limited
Asset Data Management
PO Box 5344
Coventry
CV3 9FT
Telephone: 0345 601 6616



SEWER RECORD (Tabular)

O/S Map Scale: 1:750	This map is centred upon:
Date of Issue: 09-02-24	X: 443124.23 Y: 309518.25
Disclaimer Statement:	
1 Do not scale off this Map.	
2 This plan and any information supplied with it is furnished as a general guide, is only valid at the date of issue and no warranty as to its correctness is given or implied. In particular this plan and any information shown on it must not be relied upon in the event of any development or works (including but not limited to excavations) in the vicinity of SEVERN TRENT WATER assets or for the purposes of determining the suitability of a point of connection to the sewerage or distribution systems.	
3 On 1 October 2011 most private sewers and private lateral drains in Severn Trent Water's sewerage area, which were connected to a public sewer as at 1 July 2011, transferred to the ownership of Severn Trent Water and became public sewers and public lateral drains. A further transfer takes place on 1 October 2024. Private pumping stations, which form part of these sewers or lateral drains, will transfer to ownership of Severn Trent Water on or before 1 October 2016. Severn Trent Water does not possess complete records of these assets. These assets may not be displayed on the map.	
4 Reproduction by permission of Ordnance Survey on behalf of HMSO. Crown Copyright and database right 2004. All rights reserved.	
5 Ordnance Survey licence number: 100031673	
6 Document users other than SEVERN TRENT WATER business users are advised that this document is provided for reference purpose only and is subject to copyright; therefore, no further copies should be made from it.	

Sewer Node

Sewer Pipe Data

Reference	Cover Level	Invert Level Upstream	Invert Level Downstream	Purpose	Material	Pipe Shape	Max Size	Min Size	Gradient	Year Laid
<UNK>	<UNK>	<UNK>	<UNK>	S	<UNK>	<UNK>	<UNK>	<UNK>	<UNK>	16/05/2012 00:00:00
SK44090007	0	<UNK>	<UNK>	C	<UNK>	<UNK>	<UNK>	<UNK>	0	01/12/2011 00:00:00
<UNK>	<UNK>	<UNK>	<UNK>	S	<UNK>	<UNK>	<UNK>	<UNK>	<UNK>	16/05/2012 00:00:00
<UNK>	<UNK>	<UNK>	<UNK>	S	<UNK>	<UNK>	<UNK>	<UNK>	<UNK>	16/05/2012 00:00:00
SK44091006	0	0	0	C	<UNK>	<UNK>	0	0	0	01/12/2011 00:00:00
SK44090201	154.4799	153.57	152.46	C	VC	C	<UNK>	<UNK>	28.61	31/12/1899 00:00:00
SK44090200	<UNK>	<UNK>	<UNK>	F	VC	<UNK>	<UNK>	<UNK>	<UNK>	31/12/1899 00:00:00
SK44091201	153.35	152.43	<UNK>	C	VC	C	<UNK>	<UNK>	0	31/12/1899 00:00:00
<UNK>	<UNK>	<UNK>	<UNK>	S	<UNK>	<UNK>	<UNK>	<UNK>	<UNK>	16/05/2012 00:00:00
SK44091304	155.3699	154.08	153.62	C	VC	C	150	<UNK>	100.7	31/12/1899 00:00:00
SK44090100	0	<UNK>	<UNK>	C	<UNK>	<UNK>	<UNK>	<UNK>	0	01/12/2011 00:00:00
SK44091302	155.2799	153.41	152.89	C	VC	C	150	<UNK>	81.71	31/12/1899 00:00:00
SK44090005	0	<UNK>	<UNK>	C	<UNK>	<UNK>	<UNK>	<UNK>	0	01/12/2011 00:00:00
SK44091205	0	<UNK>	<UNK>	C	<UNK>	<UNK>	<UNK>	<UNK>	0	01/12/2011 00:00:00
<UNK>	<UNK>	<UNK>	<UNK>	S	<UNK>	<UNK>	<UNK>	<UNK>	<UNK>	16/05/2012 00:00:00
<UNK>	<UNK>	<UNK>	<UNK>	S	<UNK>	<UNK>	<UNK>	<UNK>	<UNK>	16/05/2012 00:00:00
<UNK>	<UNK>	<UNK>	<UNK>	S	<UNK>	<UNK>	<UNK>	<UNK>	<UNK>	16/05/2012 00:00:00
<UNK>	<UNK>	<UNK>	<UNK>	S	<UNK>	<UNK>	<UNK>	<UNK>	<UNK>	16/05/2012 00:00:00
<UNK>	<UNK>	<UNK>	<UNK>	S	<UNK>	<UNK>	<UNK>	<UNK>	<UNK>	16/05/2012 00:00:00
<UNK>	<UNK>	<UNK>	<UNK>	S	<UNK>	<UNK>	<UNK>	<UNK>	<UNK>	16/05/2012 00:00:00
<UNK>	<UNK>	<UNK>	<UNK>	S	<UNK>	<UNK>	<UNK>	<UNK>	<UNK>	16/05/2012 00:00:00
<UNK>	<UNK>	<UNK>	<UNK>	S	<UNK>	<UNK>	<UNK>	<UNK>	<UNK>	16/05/2012 00:00:00
SK44091301	155.2899	153.59	153.02	C	VC	C	225	<UNK>	94.95	31/12/1899 00:00:00
SK44091203	154.61	153	151.14	C	VC	C	225	<UNK>	54.1	31/12/1899 00:00:00
<UNK>	<UNK>	<UNK>	<UNK>	S	<UNK>	<UNK>	<UNK>	<UNK>	<UNK>	16/05/2012 00:00:00
<UNK>	<UNK>	<UNK>	<UNK>	S	<UNK>	<UNK>	<UNK>	<UNK>	<UNK>	16/05/2012 00:00:00
<UNK>	<UNK>	<UNK>	<UNK>	F	<UNK>	<UNK>	<UNK>	<UNK>	<UNK>	16/05/2012 00:00:00
SK44091202	154.5	153.62	153.59	C	VC	C	150	<UNK>	283	31/12/1899 00:00:00
<UNK>	<UNK>	<UNK>	<UNK>	S	<UNK>	<UNK>	<UNK>	<UNK>	<UNK>	16/05/2012 00:00:00
<UNK>	<UNK>	<UNK>	<UNK>	S	<UNK>	<UNK>	<UNK>	<UNK>	<UNK>	16/05/2012 00:00:00
SK44090102	0	0	0	C	<UNK>	<UNK>	0	0	0	01/12/2011 00:00:00
SK44091303	155.38	153.91	153.42	C	VC	C	150	<UNK>	98.71	31/12/1899 00:00:00
SK44090103	0	0	0	C	<UNK>	<UNK>	0	0	0	01/12/2011 00:00:00
<UNK>	<UNK>	<UNK>	<UNK>	S	<UNK>	<UNK>	<UNK>	<UNK>	<UNK>	16/05/2012 00:00:00
SK44090202	0	<UNK>	<UNK>	C	<UNK>	<UNK>	<UNK>	<UNK>	0	01/12/2011 00:00:00
<UNK>	<UNK>	<UNK>	<UNK>	S	<UNK>	<UNK>	<UNK>	<UNK>	<UNK>	16/05/2012 00:00:00
SK44091007	0	0	0	C	<UNK>	<UNK>	0	0	0	01/12/2011 00:00:00
SK44092008	0	<UNK>	<UNK>	C	<UNK>	<UNK>	<UNK>	<UNK>	0	01/12/2011 00:00:00
SK44090006	0	<UNK>	<UNK>	C	<UNK>	<UNK>	<UNK>	<UNK>	0	01/12/2011 00:00:00
SK43099004	0	<UNK>	<UNK>	S	U	U	<UNK>	<UNK>	0	31/12/1899 00:00:00
SK44091204	154.8899	152.88	<UNK>	C	VC	C	150	<UNK>	0	31/12/1899 00:00:00
<UNK>	<UNK>	<UNK>	<UNK>	F	<UNK>	<UNK>	<UNK>	<UNK>	<UNK>	16/05/2012 00:00:00
SK44091206	0	<UNK>	<UNK>	C	<UNK>	<UNK>	<UNK>	<UNK>	0	01/12/2011 00:00:00

Sewer Node


Sewer Pipe Data

Reference	Cover Level	Invert Level Upstream	Invert Level Downstream	Purpose	Material	Pipe Shape	Max Size	Min Size	Gradient	Year Laid
SK44091305	155.4799	154.47	153.91	C	VC	C	150	<UNK>	31.18	31/12/1899 00:00:00
SK44090101	0	0	0	C	<UNK>	<UNK>	0	0	0	01/12/2011 00:00:00
<UNK>	<UNK>	<UNK>	<UNK>	F	<UNK>	<UNK>	<UNK>	<UNK>	<UNK>	16/05/2012 00:00:00
SK44092101	152.72	151.12	150.55	C	VC	C	<UNK>	<UNK>	171.11	31/12/1899 00:00:00
SK43099200	<UNK>	<UNK>	<UNK>	S	<UNK>	<UNK>	<UNK>	<UNK>	<UNK>	31/12/1899 00:00:00
<UNK>	<UNK>	<UNK>	<UNK>	F	<UNK>	<UNK>	<UNK>	<UNK>	<UNK>	16/05/2012 00:00:00
<UNK>	<UNK>	<UNK>	<UNK>	F	P	<UNK>	<UNK>	<UNK>	<UNK>	31/12/1899 00:00:00
<UNK>	<UNK>	<UNK>	<UNK>	F	PVCMO	<UNK>	<UNK>	<UNK>	<UNK>	01/11/2024 00:00:00
<UNK>	<UNK>	<UNK>	<UNK>	C	VC	<UNK>	<UNK>	<UNK>	<UNK>	31/12/1899 00:00:00
<UNK>	<UNK>	<UNK>	<UNK>	F	VC	<UNK>	<UNK>	<UNK>	<UNK>	15/03/2022 00:00:00
<UNK>	<UNK>	<UNK>	<UNK>	F	VC	<UNK>	<UNK>	<UNK>	<UNK>	31/12/1899 00:00:00
<UNK>	<UNK>	<UNK>	<UNK>	F	PVCMO	<UNK>	<UNK>	<UNK>	<UNK>	11/11/2023 00:00:00
<UNK>	<UNK>	<UNK>	<UNK>	C	VC	<UNK>	<UNK>	<UNK>	<UNK>	31/12/1899 00:00:00
<UNK>	<UNK>	<UNK>	<UNK>	F	VC	<UNK>	<UNK>	<UNK>	<UNK>	31/12/1899 00:00:00
<UNK>	<UNK>	<UNK>	<UNK>	F	PVCMO	<UNK>	<UNK>	<UNK>	<UNK>	01/11/2024 00:00:00
<UNK>	<UNK>	<UNK>	<UNK>	C	VC	<UNK>	<UNK>	<UNK>	<UNK>	31/12/1899 00:00:00
<UNK>	<UNK>	<UNK>	<UNK>	F	VC	<UNK>	<UNK>	<UNK>	<UNK>	31/12/1899 00:00:00
<UNK>	<UNK>	<UNK>	<UNK>	F	P	<UNK>	<UNK>	<UNK>	<UNK>	31/12/1899 00:00:00
<UNK>	<UNK>	<UNK>	<UNK>	F	VC	<UNK>	<UNK>	<UNK>	<UNK>	31/12/1899 00:00:00
<UNK>	<UNK>	<UNK>	<UNK>	F	P	<UNK>	<UNK>	<UNK>	<UNK>	31/12/1899 00:00:00
<UNK>	<UNK>	<UNK>	<UNK>	F	VC	<UNK>	<UNK>	<UNK>	<UNK>	31/12/1899 00:00:00
<UNK>	<UNK>	<UNK>	<UNK>	F	P	<UNK>	<UNK>	<UNK>	<UNK>	31/12/1899 00:00:00
<UNK>	<UNK>	<UNK>	<UNK>	F	VC	<UNK>	<UNK>	<UNK>	<UNK>	31/12/1899 00:00:00
<UNK>	<UNK>	<UNK>	<UNK>	F	P	<UNK>	<UNK>	<UNK>	<UNK>	31/12/1899 00:00:00
<UNK>	<UNK>	<UNK>	<UNK>	C	VC	<UNK>	<UNK>	<UNK>	<UNK>	31/12/1899 00:00:00
<UNK>	<UNK>	<UNK>	<UNK>	F	VC	<UNK>	<UNK>	<UNK>	<UNK>	31/12/1899 00:00:00
<UNK>	<UNK>	<UNK>	<UNK>	F	P	<UNK>	<UNK>	<UNK>	<UNK>	31/12/1899 00:00:00



Appendix C

Drainage Layout

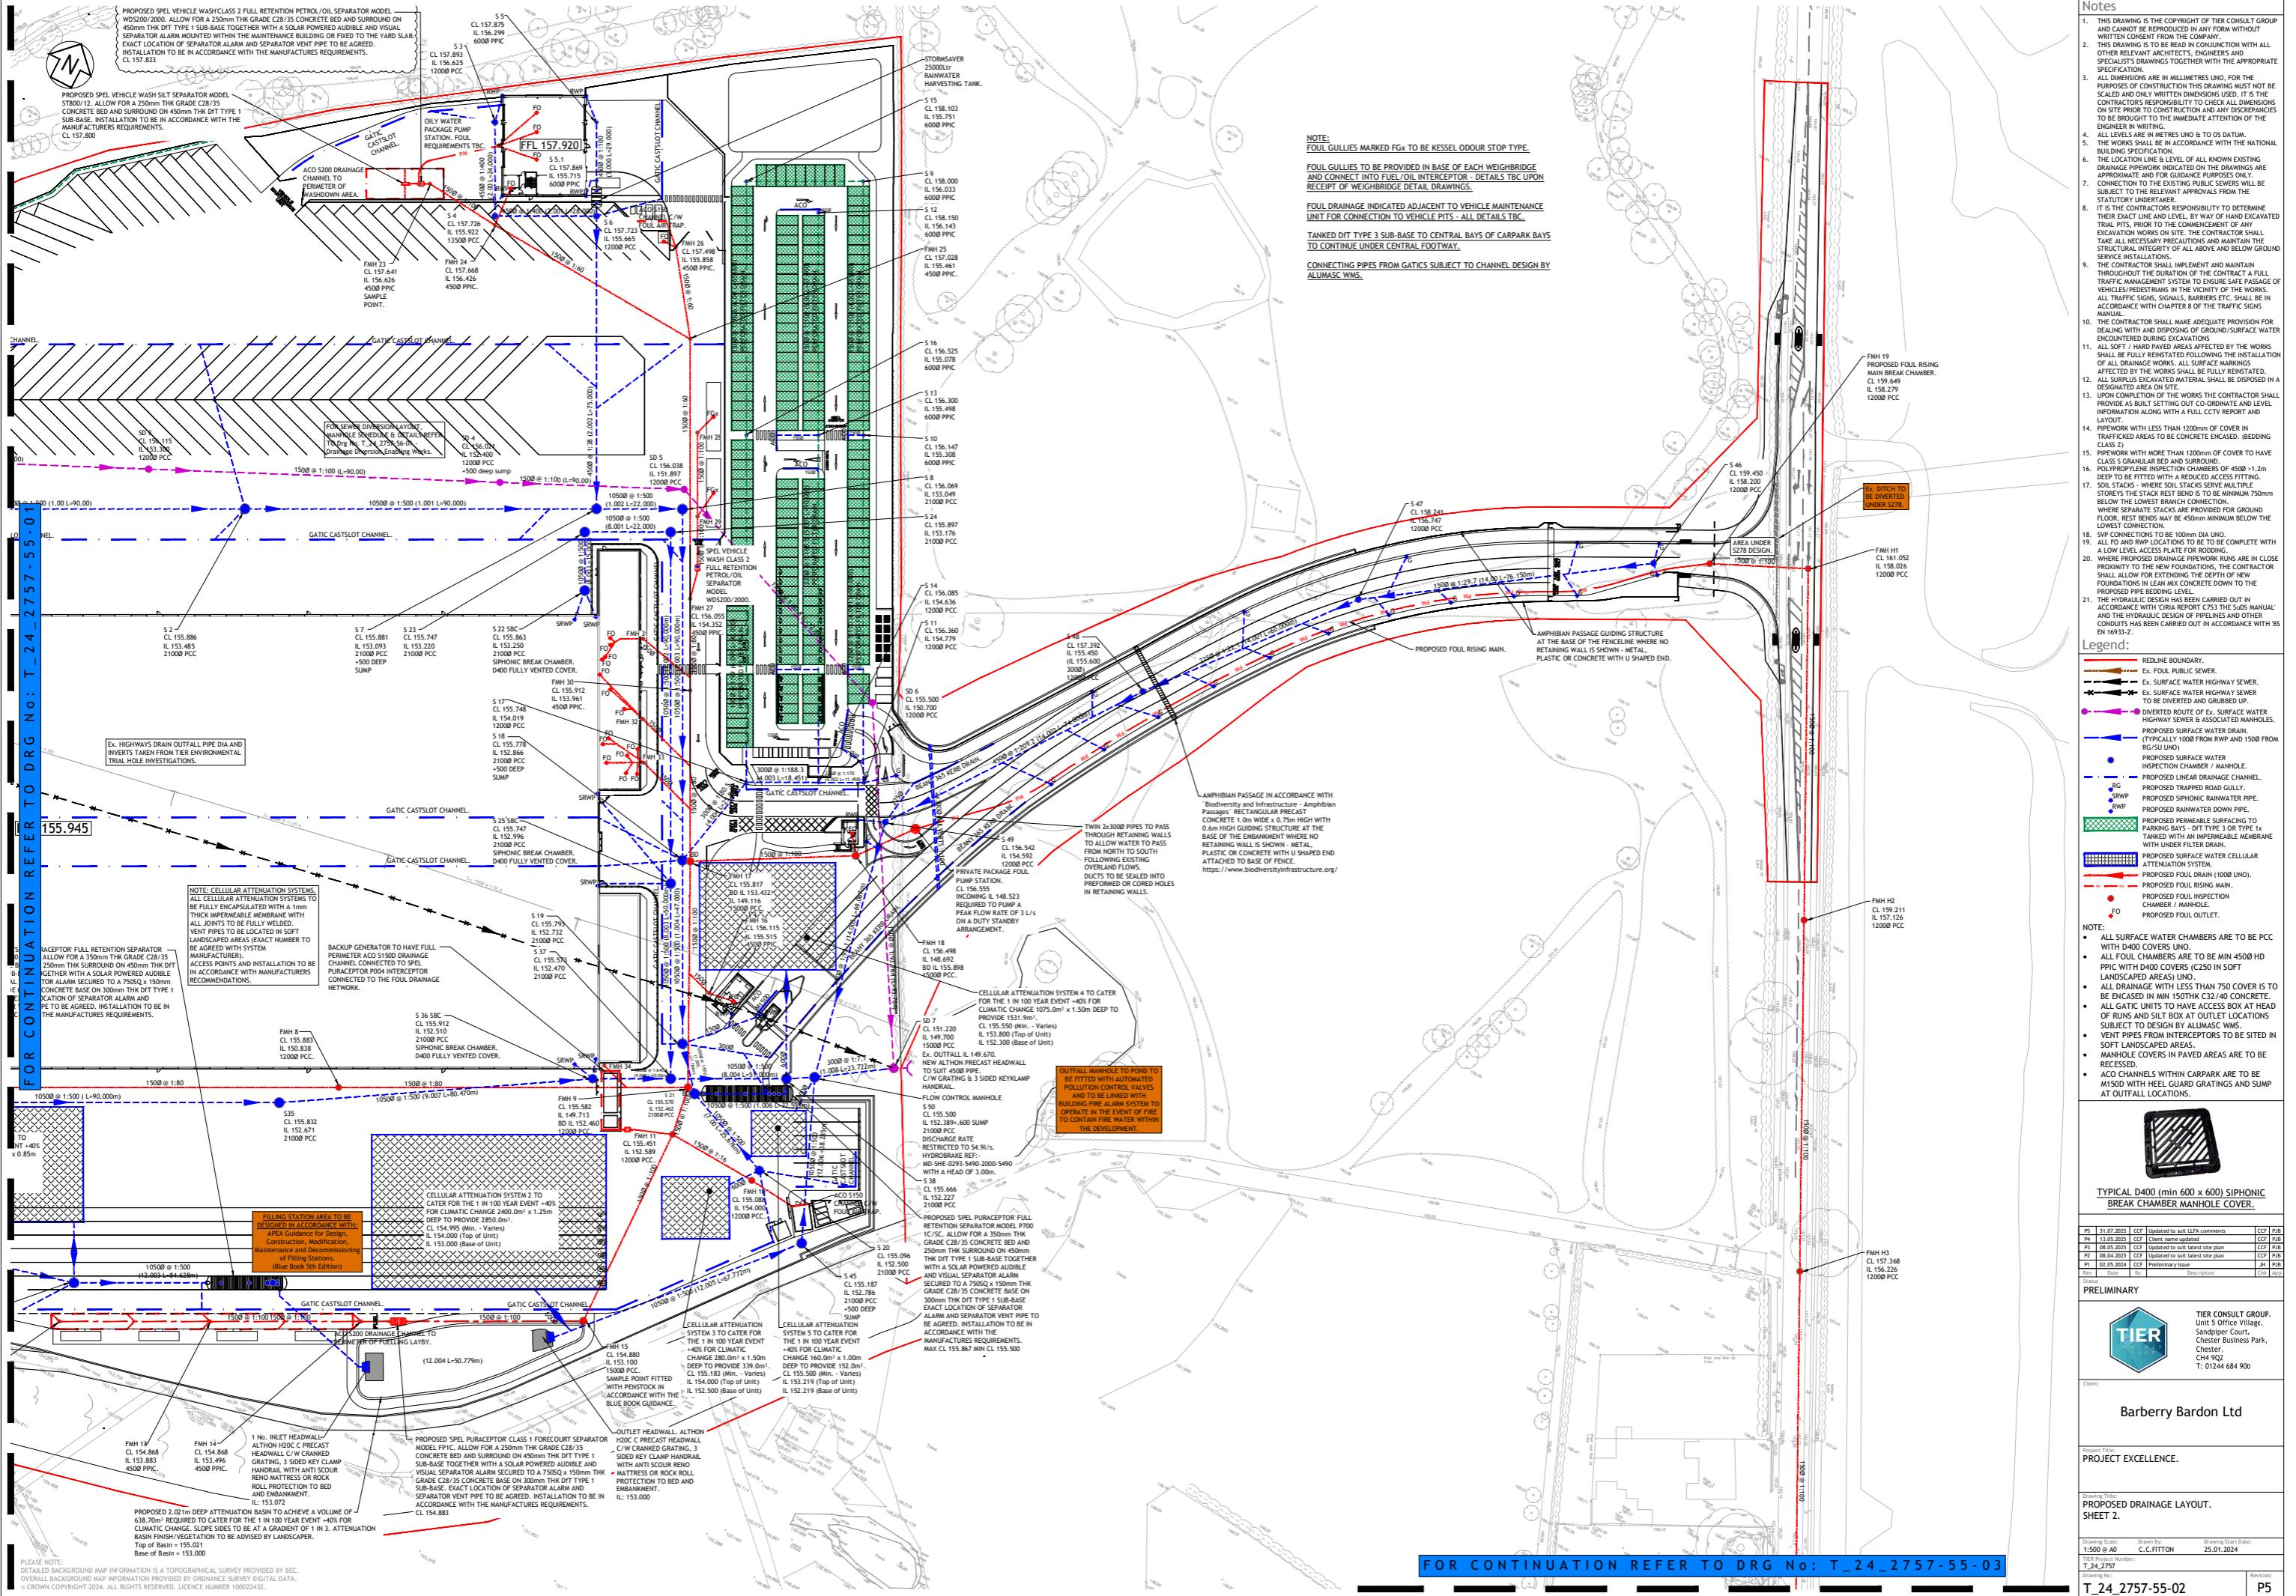



Appendix D

Existing Water Features



