

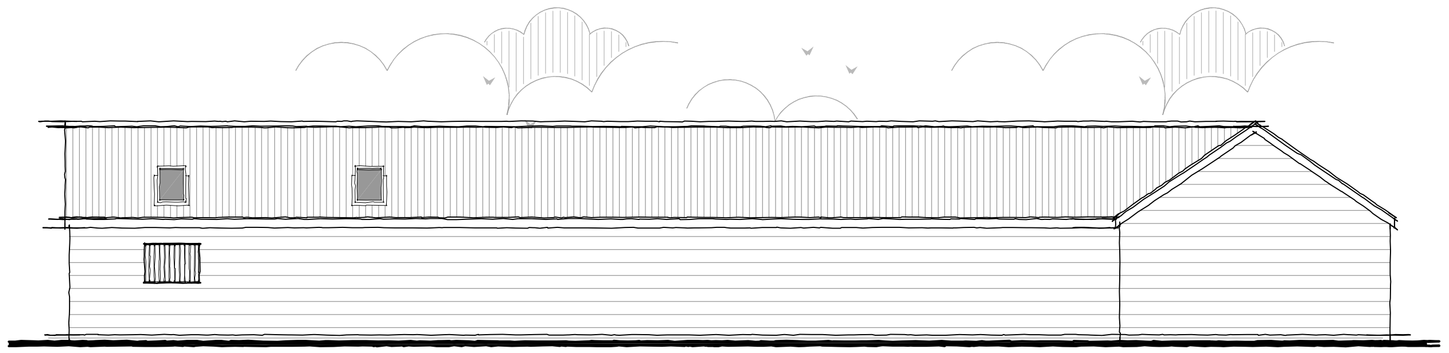



East Facing Elevation
Scale 1:100

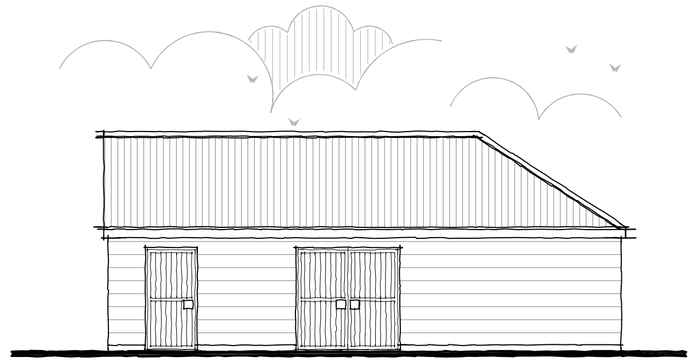

South Facing Elevation
Scale 1:100

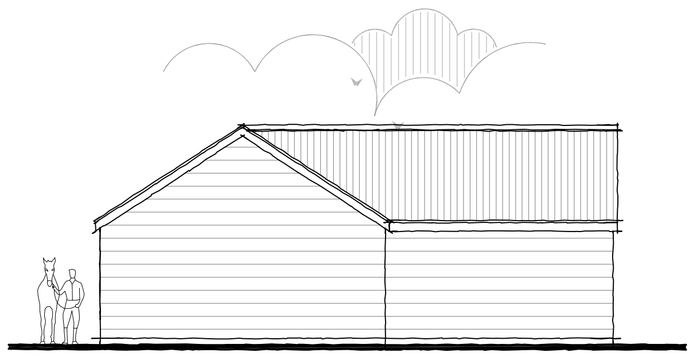


North Facing Elevation
Scale 1:100

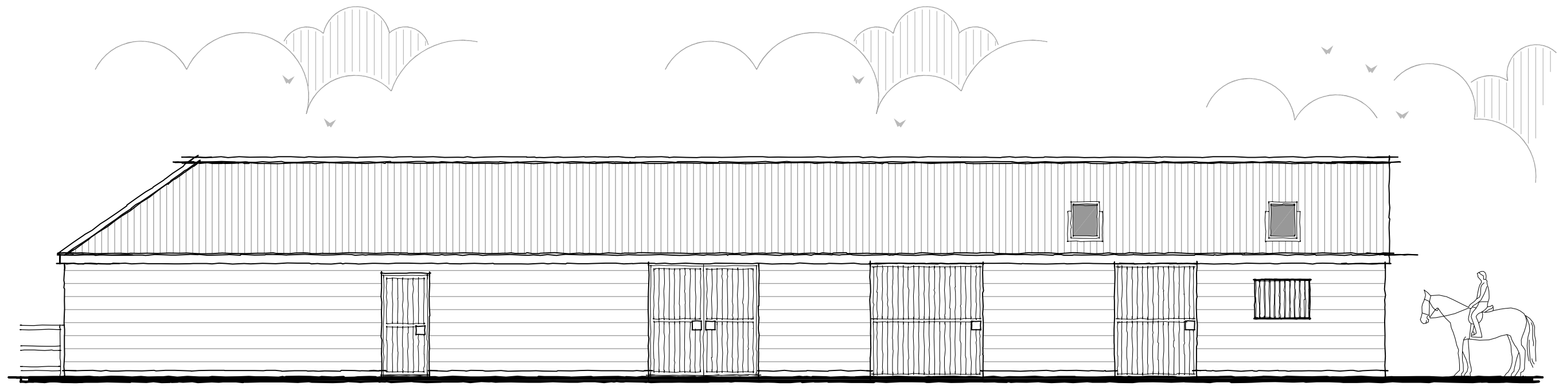


West Facing Elevation
Scale 1:100

Materials
Plain clay roof tiles
Horizontal cedar timber boarding
Sliding and opening timber & steel stable doors

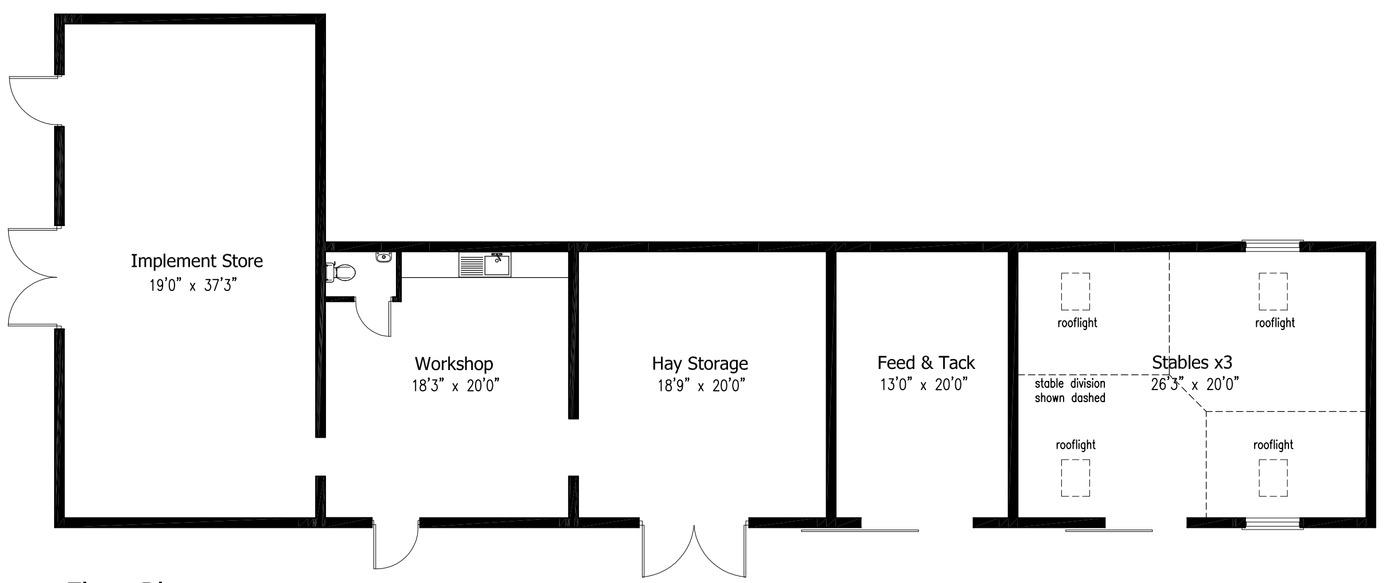

Floor Plan
Scale 1:100

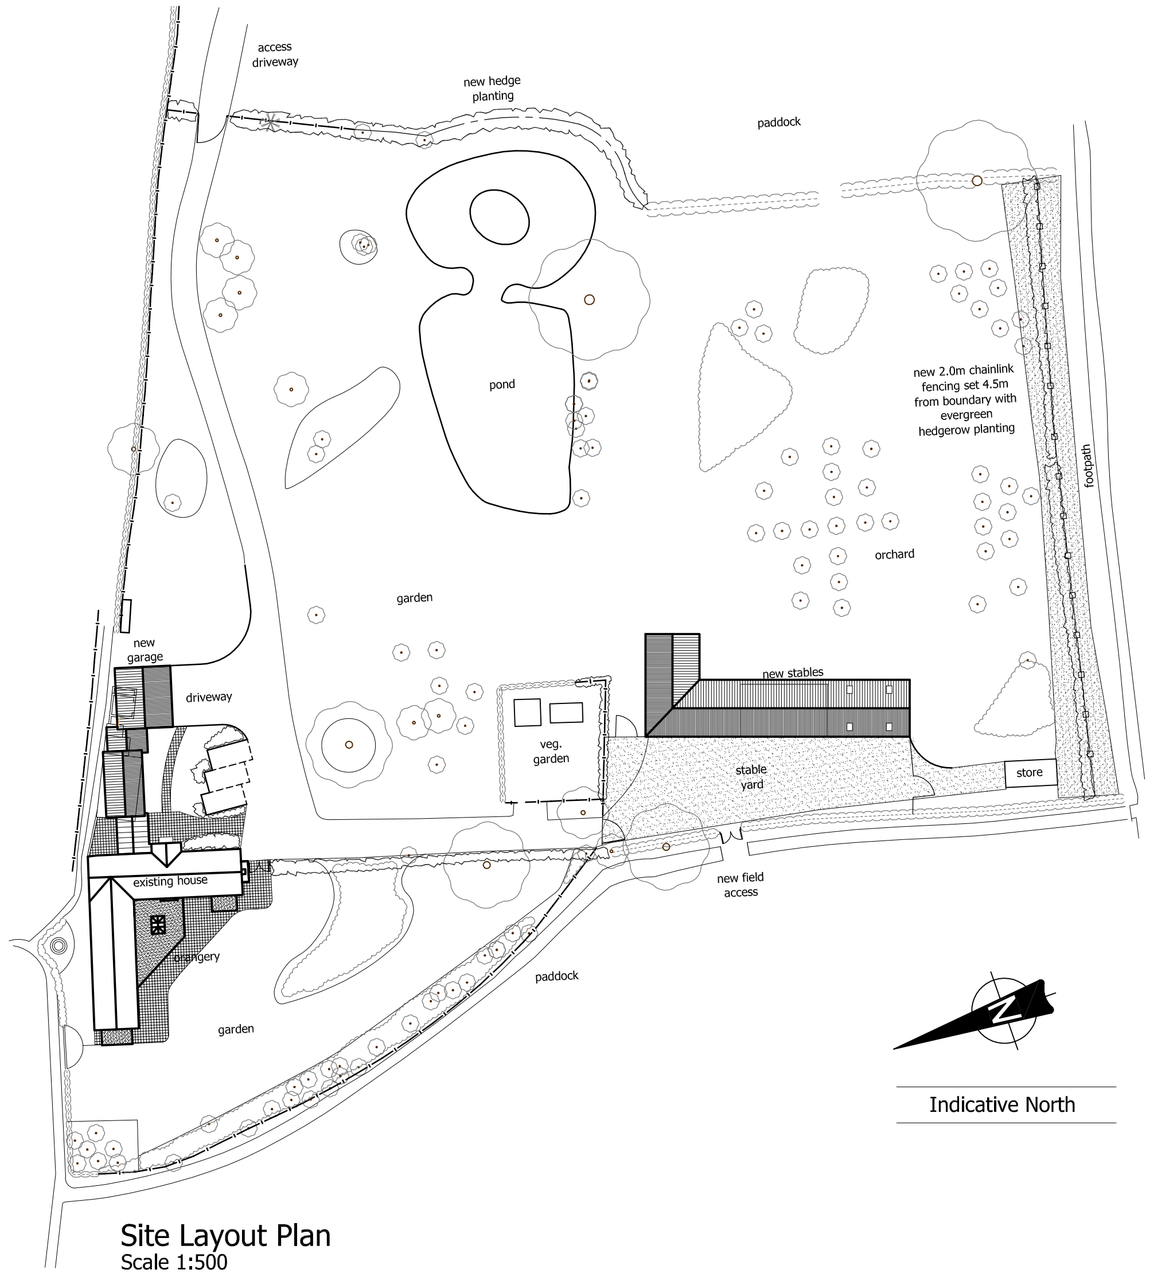

Site Layout Plan
Scale 1:500
New biodisc treatment plant location to be agreed

DETAILED PLANNING DRAWING ~ AS BUILT
PROPOSED EXTENSION & ALTERATIONS~ TOP FARM, RATBY

To be read in conjunction with existing details and topographical site survey by Greenhatch.
Extent of land holding approx. 23 acres.

Revisions :			
	B	Boarding & fence amendments	15.06.09
	A	Client Amendments	12.05.09

Figured dimensions must be taken in preference to scaled dimensions and any discrepancies are to be referred to David Granger Architectural Design Limited. Contractors, subcontractors and suppliers must verify all dimensions on site before commencing any work or making any workshop drawings. All drawings are copyright of David Granger Architectural Design Limited.



DAVID GRANGER
Architectural Design Limited

Project
Proposed Extension & Alterations
Top Farm, Bondman Hayes, Cow Lane,
Ratby, Leicestershire.

Drawing Title
As Built Planning Drawing (sheet 2 of 2)
Proposed Stable Building & Site Plan

Client
Mr & Mrs F.Drummond

Drawing No.
07.2248.10 B

Date	Scale
April 2009	1:100
Drawn by	Checked by
MP	DG

The Old Dairy, Mill St., Packington,
Ashby-de-la-Zouch, Leics. LE65 1WN
Tel: 01530 560939 Fax: 01530 560115
www.davidgrangerdesign.com
Company Reg. No. 5068912