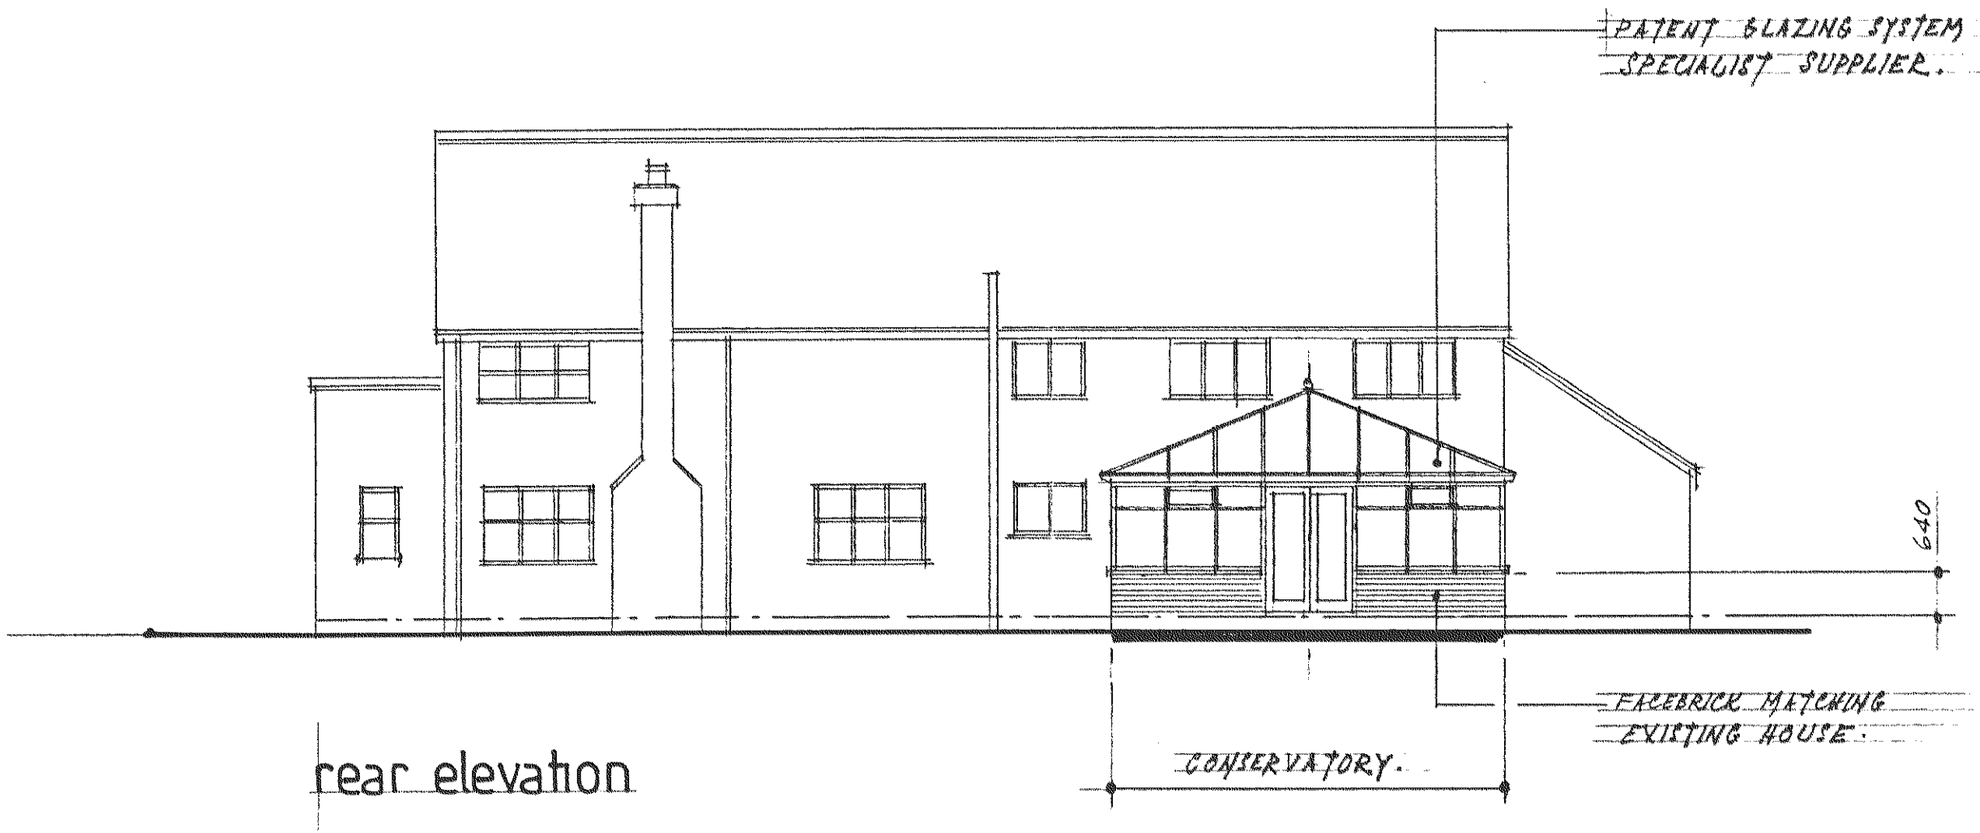

rear elevation



side eley north

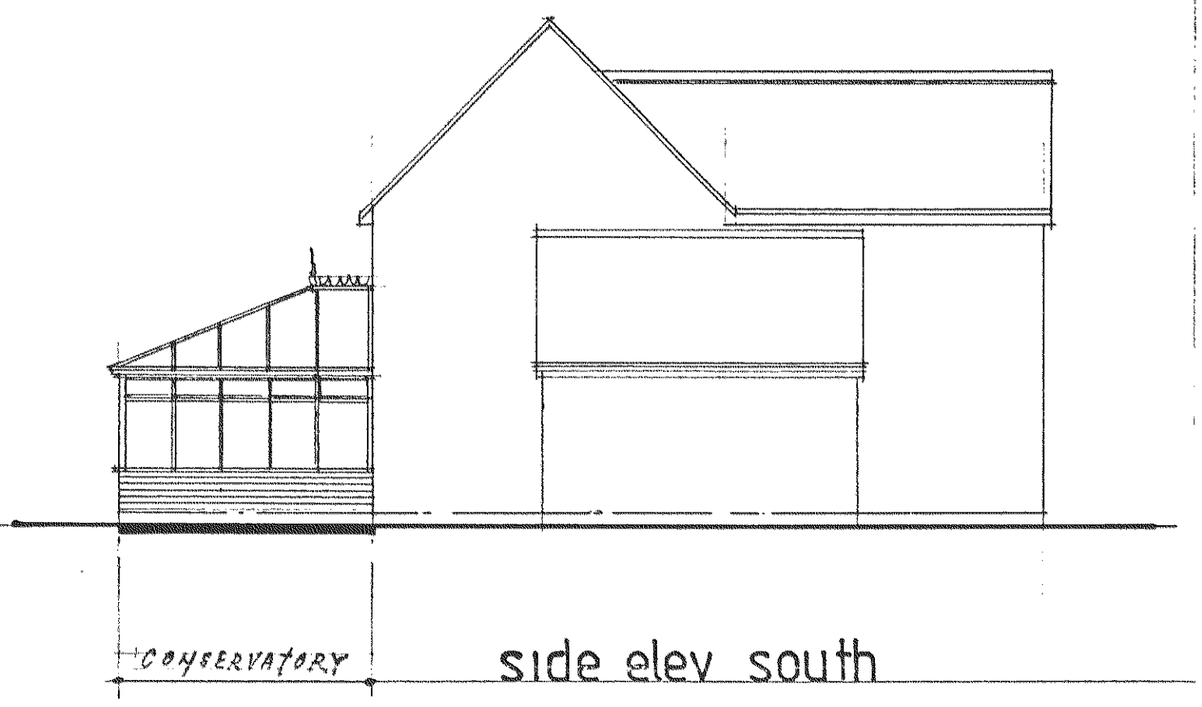

side eley south

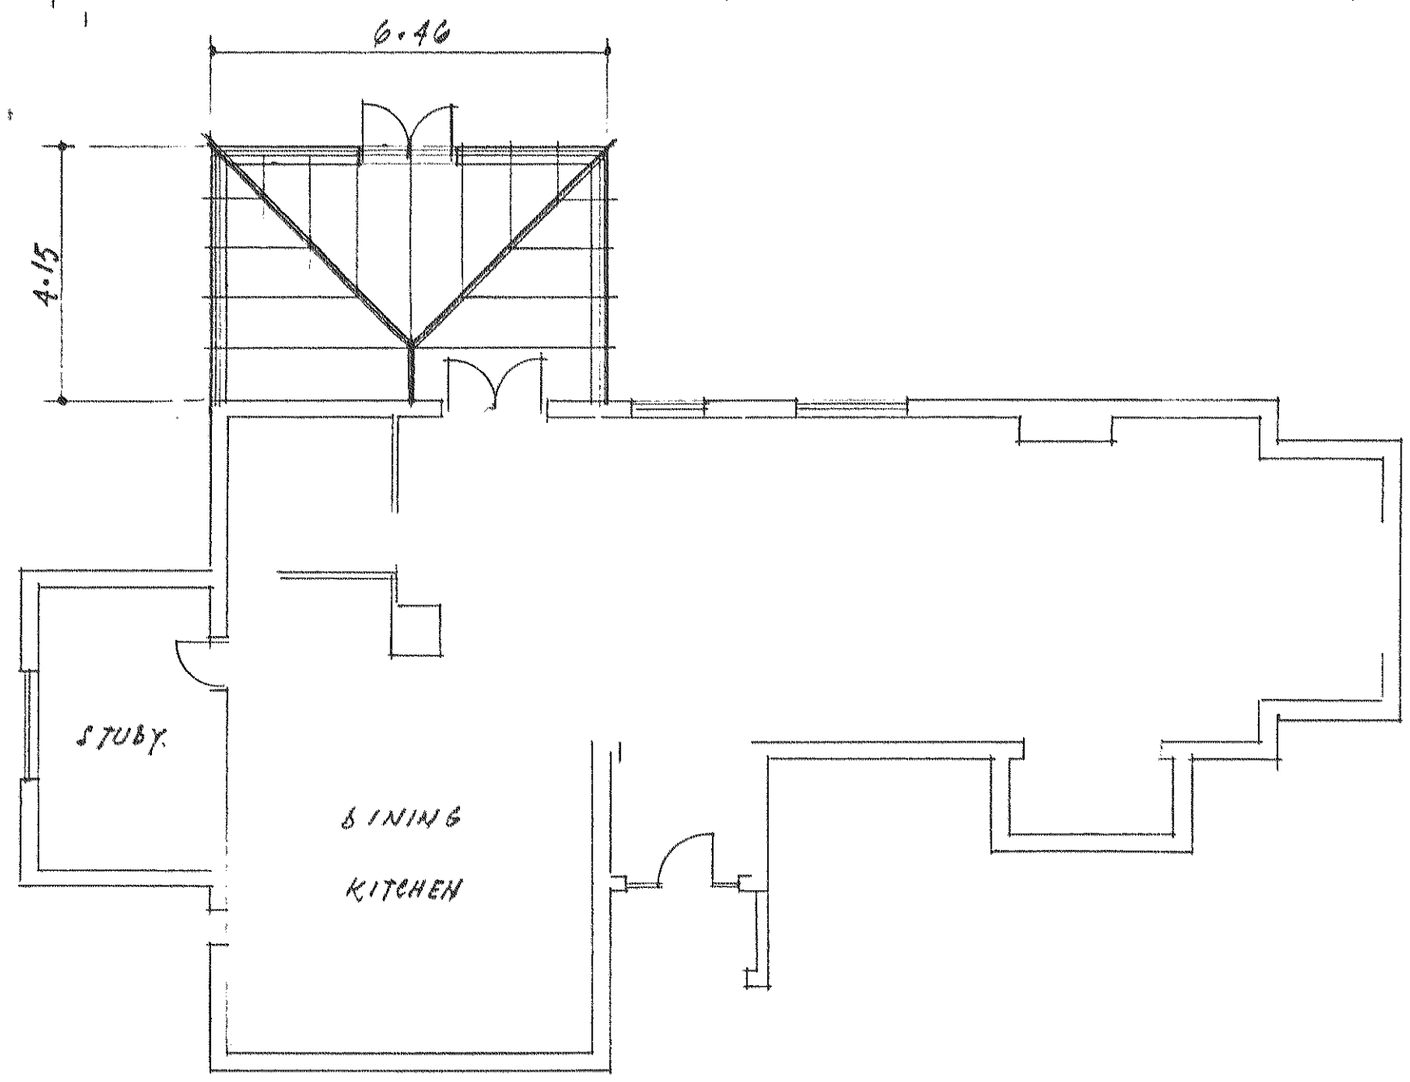

plan

DEVELOPMENT SERVICES
29 JAN 2006
RECEIVED

SCALE: 1:100.

EXISTING HOUSE 15. 266 SQ M
CONSERVATORY 15. 26.8 SQ M.

CONSERVATORY AS BUILT TO THE REAR OF DETACHED HOUSE AT :-
5. STAPLETON LANE, BARLINGTON, LEICS. for. MR. A SWEENEY.

JOHN E. WRIGHT 526657

DR- 359730