


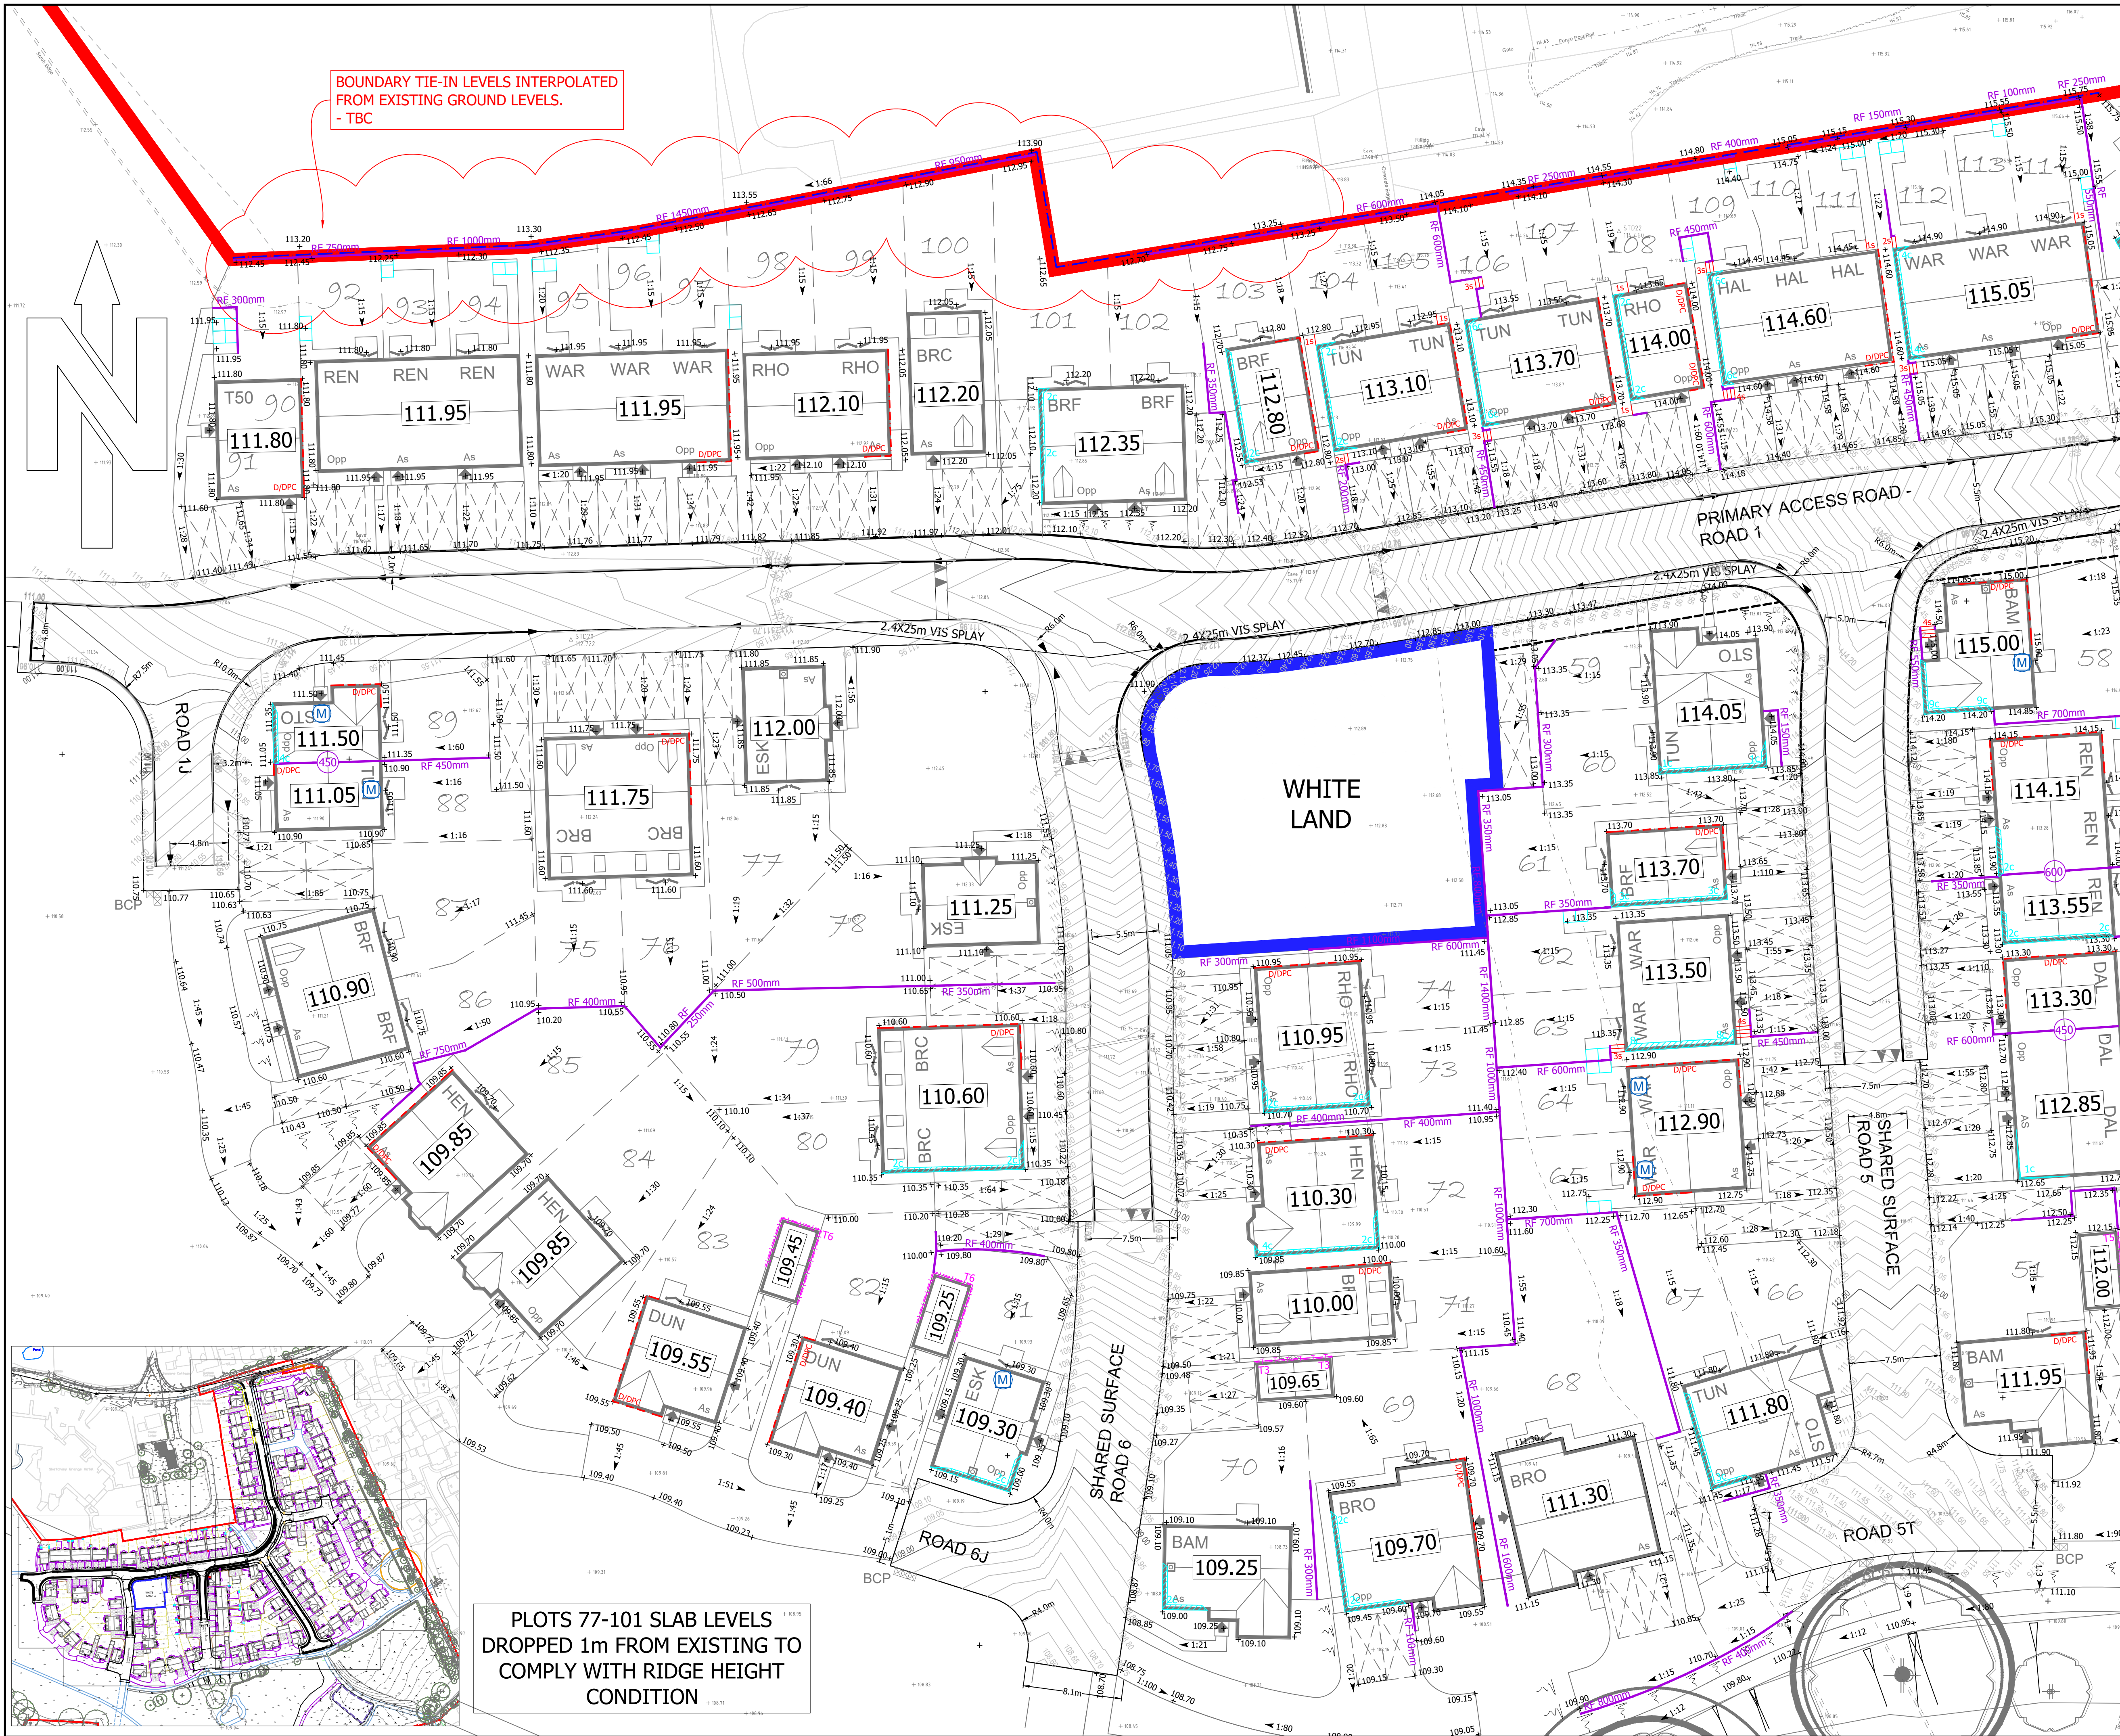

1. DO NOT SCALE FROM THIS DRAWING. IF IN DOUBT CONTACT TRAVIS BAKER LIMITED.
2. ALL DIMENSIONS ARE IN METRES UNLESS OTHERWISE NOTED.
3. THIS DRAWING IS TO BE READ IN CONJUNCTION WITH ALL OTHER RELEVANT DRAWINGS RELATING TO THIS PROJECT.
4. ALL DIMENSIONS SHOULD BE CHECKED ON SITE PRIOR TO CONSTRUCTION. ANY DISCREPANCIES SHOULD BE IMMEDIATELY NOTIFIED IN WRITING TO TRAVIS BAKER LIMITED.
5. THE CONTRACTOR SHALL PRIOR TO CONSTRUCTION CHECK AND VERIFY THAT THE DETAILS SHOWN ON THIS DRAWING ARE FULLY COMPATIBLE WITH ANY AS CONSTRUCTED DIMENSIONS OR LEVELS. ANY DISCREPANCIES TO BE REPORTED IMMEDIATELY IN WRITING TO TRAVIS BAKER LIMITED.
6. THIS DRAWING HAS BEEN PREPARED FOR THE EXCLUSIVE USE OF THE COMMISSIONING PARTY AND UNLESS AGREED IN WRITING BY TRAVIS BAKER LIMITED NO OTHER PARTY MAY USE OR RELY ON ITS CONTENTS. NO LIABILITY IS ACCEPTED BY TRAVIS BAKER LIMITED FOR ANY USE OF THIS DRAWING OTHER THAN FOR THE PURPOSE FOR WHICH IT WAS ORIGINALLY PREPARED.
7. IT SHOULD BE NOTED THAT THIS DRAWING MAY INCLUDE DATA PROVIDED BY THIRD PARTIES. NO LIABILITY IS ACCEPTED BY TRAVIS BAKER LIMITED AS TO THE ACCURACY OF THIS DATA.
8. THIS DRAWING SHALL NOT BE REPRODUCED IN ANY WAY WITHOUT THE WRITTEN PERMISSION OF TRAVIS BAKER LIMITED.

RETAINING STRUCTURES SHOW  
NO REFERENCE TO MATERIALS  
USED AS PER DESIGN GUIDANCE.

SUBJECT TO DETAILED DESIGN

- KEY
- SITE BOUNDARY
  - EXISTING LEVELS
  - PROPOSED LEVELS
  - 114.15 FFL
  - 1:12 GRADIENT
  - 600mm Retaining (SHOWN WHERE HEIGHTS EXCEED 600mm)
  - EXPOSURE
  - TANKING
  - DOUBLE DPC
  - EMBANKMENT

| REV | DESCRIPTION                                                                                              | DATE     | BY | AUTH |
|-----|---|----------|----|------|
| H   | UPDATED TO NEW SITE LAYOUT.                                                                              | 18.09.26 | PN | PN   |
| G   | PLOTS 111/112 RETAINING WALL REVIEWED                                                                    | 29.07.26 | PN | PN   |
| F   | UPDATED TO NEW SITE LAYOUT.                                                                              | 28.07.26 | PN | PN   |
| E   | UPDATED ROAD LAYOUT - SHARED DRIVE REDUCED TO 4m LENGTH. END OF ROAD 1 ADJUSTED. LEVELS AMENDED TO SUIT. | 19.04.24 | CL | TW   |
| D   | UPDATED ROAD LAYOUT - BUILD OUTS REMOVED AND ADDED ADDITIONAL SPEED CONTROL FEATURES                     | 22.03.24 | CL | TW   |
| C   | PLOT 85 SHIFTED SLIGHTLY - UPDATED LEVELS AROUND PLOT.                                                   | 21.03.24 | CL | TW   |
| B   | UPDATED TO NEW SITE AND ROAD LAYOUT. SPEED RAMPS INTRODUCED. RW DETAILS ADDED.                           | 12.03.24 | CL | TW   |
| A   | UPDATED TO SUIT NEW LAYOUT - ROAD 5T, 6I, AND ROAD 1 EXTENDED.                                           | 28.11.23 | CL | TW   |

Travis Baker  
39 Storey Street  
Lace Market  
Nottingham  
NG1 1JX

Transport Planning  
Flood Risk and Drainage  
Geo-Environmental  
Civil and Structural Engineering

Nottingham Telephone:  
0115 896 6655  
info@travisbaker.co.uk  
www.travisbaker.co.uk

CLIENT  
CHARLES CHURCH

PROJECT  
SKETCHLEY LANE BURBAGE

TITLE  
EXTERNAL LEVELS SH1 OF 3

| DRAWN | AUTHORISED | SCALE    | DATE     |
|-------|------------|----------|----------|
| CL    | TW         | 1/250@A1 | 31.10.23 |

| PROJECT NO. | DRAWING NO. | REV |
|-------------|-------------|-----|
| 23053       | 020         | H   |

STATUS:  
PRELIMINARY

COPYRIGHT TRAVIS BAKER LIMITED. ALL RIGHTS RESERVED.