

Enquirer

Name	Mr Tom Furlong	Phone	07500601088
Company	BWB Consulting	Mobile	07500601088
Address	B W B Consulting Ltd Whitehall Waterfront Leeds WYK LS1 4EH		
Email	TOM.FURLONG@BWCNSULTING.COM		


Enquiry Details

Enquiry type	Initial Enquiry
Work category	Development Projects
Work type	Commercial/industrial
Work type buffer*	75 metres
Start date	22/03/2024
End date	22/03/2024
Scheme/Reference	- Newbold Verdon, Phase 2
Search location	XY= 444854, 303296
Confirmed location	444784 303319
Site size	0 metres square
Site Contact Name	Tom Furlong
Site Phone No.	07500601088

Description of Works

* The WORK TYPE BUFFER is a distance added to your search area based on the Work type you have chosen.

Site Map

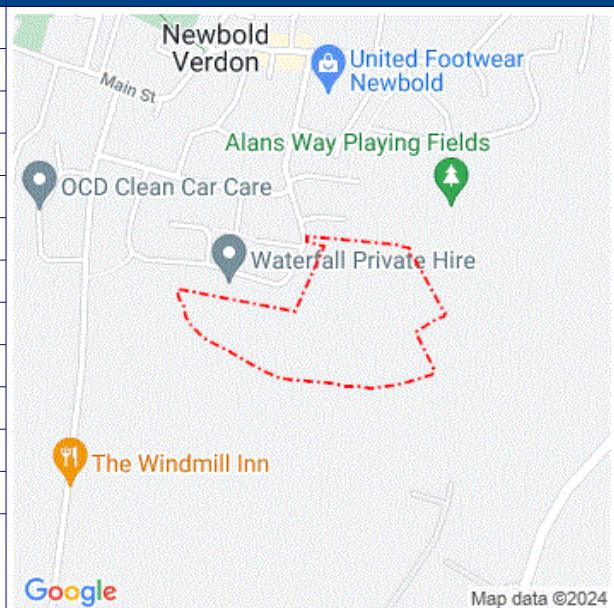

Please note that the above map only displays the location of the proposed work site and will not display any of the Members' pipes and cables. It is imperative that this area accurately reflects the proposed work site.

Affected LSBUD members

(LSBUD Members who have assets registered on LSBUD within the vicinity of your search area.)

Asset Owner	Phone/Email	Emergency Only	Status
Cadent Gas	0800688588	0800111999	Await response
National Grid Electricity Distribution	08000963080	08006783105	Await response
National Grid Electricity Transmission	08000014282	0800404090	Await response

Status explanation

Await Response means that the asset owner will contact you. This is typically by sending the plan response but they may ask for further information before being able to do so, particularly if any payments or authorisations are required.

Email Additional Info means that the asset owner needs further information about your works to assess your enquiry before providing a response. Please provide any details you have available including plans, method statements etc. if available.

Important notices

It is very important that you correctly understand what the service does and the procedures in order for you to work safely. Please refer to the LSBUD Support Page (www.lsbud.co.uk/linesearchbeforeudig-support) for further guidance.

This information includes how to provide additional information to the LSBUD Members who request it to provide a response to your enquiry.

Validity and search criteria. The results of this enquiry are based on the confirmed information you entered and are valid only as at the date and time of the enquiry. It is your responsibility to ensure that the Enquiry Details are correct, and LinesearchbeforeUdig (LSBUD) accepts no responsibility for any errors or omissions in the Enquiry Details or any consequences thereof. LSBUD Members update their asset information on a regular basis so you are advised to consider this when undertaking any works. It is your responsibility to choose the period of time after which you need to resubmit any enquiry but the maximum time (after which your enquiry will no longer be dealt with by the LSBUD Helpdesk and LSBUD Members) is 28 days. If any details of the enquiry change, particularly including, but not limited to, the location of the work, then a further enquiry must be made.

Terms and Conditions. Please note that this enquiry is subject always to our standard terms and conditions available at www.lsbud.co.uk ("Terms of Use") and the disclaimer at the end of this document. Please note that in the event of any conflict or ambiguity between the terms of this Enquiry Confirmation and the Terms of Use, the Terms of Use shall take precedence.

List of not affected LSBUD members

(LSBUD Members who do not have assets registered on the LSBUD service within the vicinity of your search area.)

Angus Energy	AWE Pipeline	B & D Energy Limited
Balfour Beatty Investments Limited	BOC Limited (A Member of the Linde Group)	Box Broadband
BP Exploration Operating Company Limited	BPA	Cambridgeshire County Council Climate Change and Energy Services
CATS Pipeline c/o Wood Group PSN	Cemex	Centrica Storage Ltd
CNG Services Ltd	Concept Solutions People Ltd	ConocoPhillips (UK) Teesside Operator Ltd
D.S.Smith	Diamond Transmission Corporation	DIO (MOD Abandoned Pipelines)
DIO (MOD Live Pipelines)	Drax Power Limited	E.ON UK CHP Limited
EDF Energy Renewables Ltd	EirGrid	Eleclink Limited
Electricity North West Limited	Energy Assets Networks	ENI & Himor c/o Penspen Ltd
EnQuest NNS Limited	EP Langage Limited	ESB CCGT Power station (Carrington Gas Pipeline)
ESP Utilities Group	ESSAR	Esso Petroleum Company Limited
euNetworks Fiber UK Ltd	EXA Infrastructure	Exolium Pipeline System
Fulcrum Electricity Assets Limited	Fulcrum Pipelines Limited	Gamma
Gas Networks Ireland (UK)	Gateshead Energy Company	Gigaclear Ltd
Harbour Energy	Heathrow Airport LTD	Humbly Grove Energy
IGas Energy	INEOS FPS Pipelines	INEOS Manufacturing (Scotland and TSEP)
INOVYN ChlorVinyls Limited	INOVYN Enterprises Limited	Intergen (Coryton Energy or Spalding Energy)
Jurassic Fibre Ltd	Kensa Utilities	Last Mile
Mainline Pipelines Limited	Manchester Jetline Limited	Manx Cable Company
Marchwood Power Ltd (Gas Pipeline)	Melbourn Solar Limited	MUA Group Limited
National Gas Transmission	National Grid Ventures	Neos Networks
Northern Gas Networks Limited	Northumbrian Water Group	NPower CHP Pipelines
NTT Global Data Centers EMEA UK Ltd	NYnet Ltd	Ogi
Oikos Storage Limited	Ørsted	Palm Paper Ltd
Perenco UK Limited (Purbeck Southampton Pipeline)	Petroineos	Phillips 66
Portsmouth Water	Premier Transmission Ltd (SNIP)	Redundant Pipelines - LPDA
RWE - Great Yarmouth Pipeline (Bacton to Great Yarmouth Power Station)	RWEpower (Little Barford and South Haven)	SABIC UK Petrochemicals
SAS Utility Services Ltd	Scottish and Southern Electricity Networks	Scottish Power Generation
Seabank Power Ltd	SES Water	SGN
Shell	Shell NOP	SP Energy Networks
Spring Fibre Limited	Squire Energy Networks	SSE Generation Ltd
SSE Transmission	SSE Utility Solutions Limited	Storengy

Tata Communications (c/o JSM Construction Ltd)	TfL – London Underground HV Cables (Road Side Cables)	toob Limited
Total Colnbrook Pipelines	Total Finaline Pipelines	Transmission Capital
Trojan Energy Limited	UK Power Networks	Uniper UK Ltd
University of Cambridge Granta Backbone Network	Vattenfall	Veolia ES SELCHP Limited
Veolia ES Sheffield Ltd	Voneus Limited	VPI Power Limited
Wales and West Utilities	Welsh Power	West of Duddon Sands Transmission Ltd
West Sussex OpenNetwork (Cooperative National Infrastructure)	Westminster City Council	Zayo Group UK Ltd c/o JSM Group Ltd

Non-LSBUD members (Asset owners not registered on LSBUD)

(The following Non-LSBUD Members may have assets in your search area. It is YOUR RESPONSIBILITY to contact them before proceeding.

Please be aware this list is not exhaustive and it is your responsibility to identify and contact all asset owners within your search area.)

Asset Owner	Preferred contact method	Phone	Status
BT	https://www.swns.bt.com/pls/mbe/welcome.home	08000232023	Not Notified
CityFibre	asset.team@cityfibre.com	033 3150 7282	Not Notified
Colt	plantenquiries@catelecomuk.com	01227768427	Not Notified
Equans	nrswa.uk@equans.com	0800 130 3600	Not Notified
GTC	https://pe.gtc-uk.co.uk/PlantEnqMembership	01359240363	Not Notified
Lumen Technologies	plantenquiries@ocugroup.com	02087314613	Not Notified
Mobile Broadband Network Limited	mbnl.plant.enquiries@turntown.com	01212 621 100	Not Notified
Severn Trent Water	www.stwater.co.uk/building-and-developing/estimators-and-maps/request-a-water-sewer-map	03456016616	Not Notified
Sky UK Limited	nrswa@sky.uk	02070323234	Not Notified
Sota	sota.plantenquiries@ocugroup.com		Not Notified
Utility assets Ltd	assetrecords@utilityassets.co.uk		Not Notified
Verizon Business	osp-team@uk.verizonbusiness.com	01293611736	Not Notified
Virgin Media	http://www.digdat.co.uk	08708883116	Not Notified
Vodafone	osm.enquiries@atkinsglobal.com	01454662881	Not Notified


Disclaimer

Please refer to LSBUD's Terms of Use for full terms of use available at www.lsbud.co.uk


The results of this Enquiry are personal to the Enquirer and shall not be shared with or relied upon by any other party. The asset information on which the Enquiry results are based has been provided by LSBUD Members, therefore LSBUD will provide no guarantee that such information is accurate or reliable nor does it monitor such asset information for accuracy and reliability going forward. There may also be asset owners which do not participate in the enquiry service operated by LSBUD, including but not exclusively those set out above. Therefore, LSBUD cannot make any representation or give any guarantee or warranty as to the completeness of the information contained in the enquiry results or accept any responsibility for the accuracy of the mapping images used. LSBUD and its employees, agents and consultants accept no liability (save that nothing in this Enquiry Confirmation excludes or limits our liability for death or personal injury arising from our negligence, or our fraud or fraudulent misrepresentation, or any other liability that cannot be excluded or limited by English law) arising in respect thereof or in any other way for errors or omissions including responsibility to any person by reason of negligence.

APPENDIX 3: NATIONAL GRID ELECTRICITY DISTRIBUTION

Overview Map of Worksite

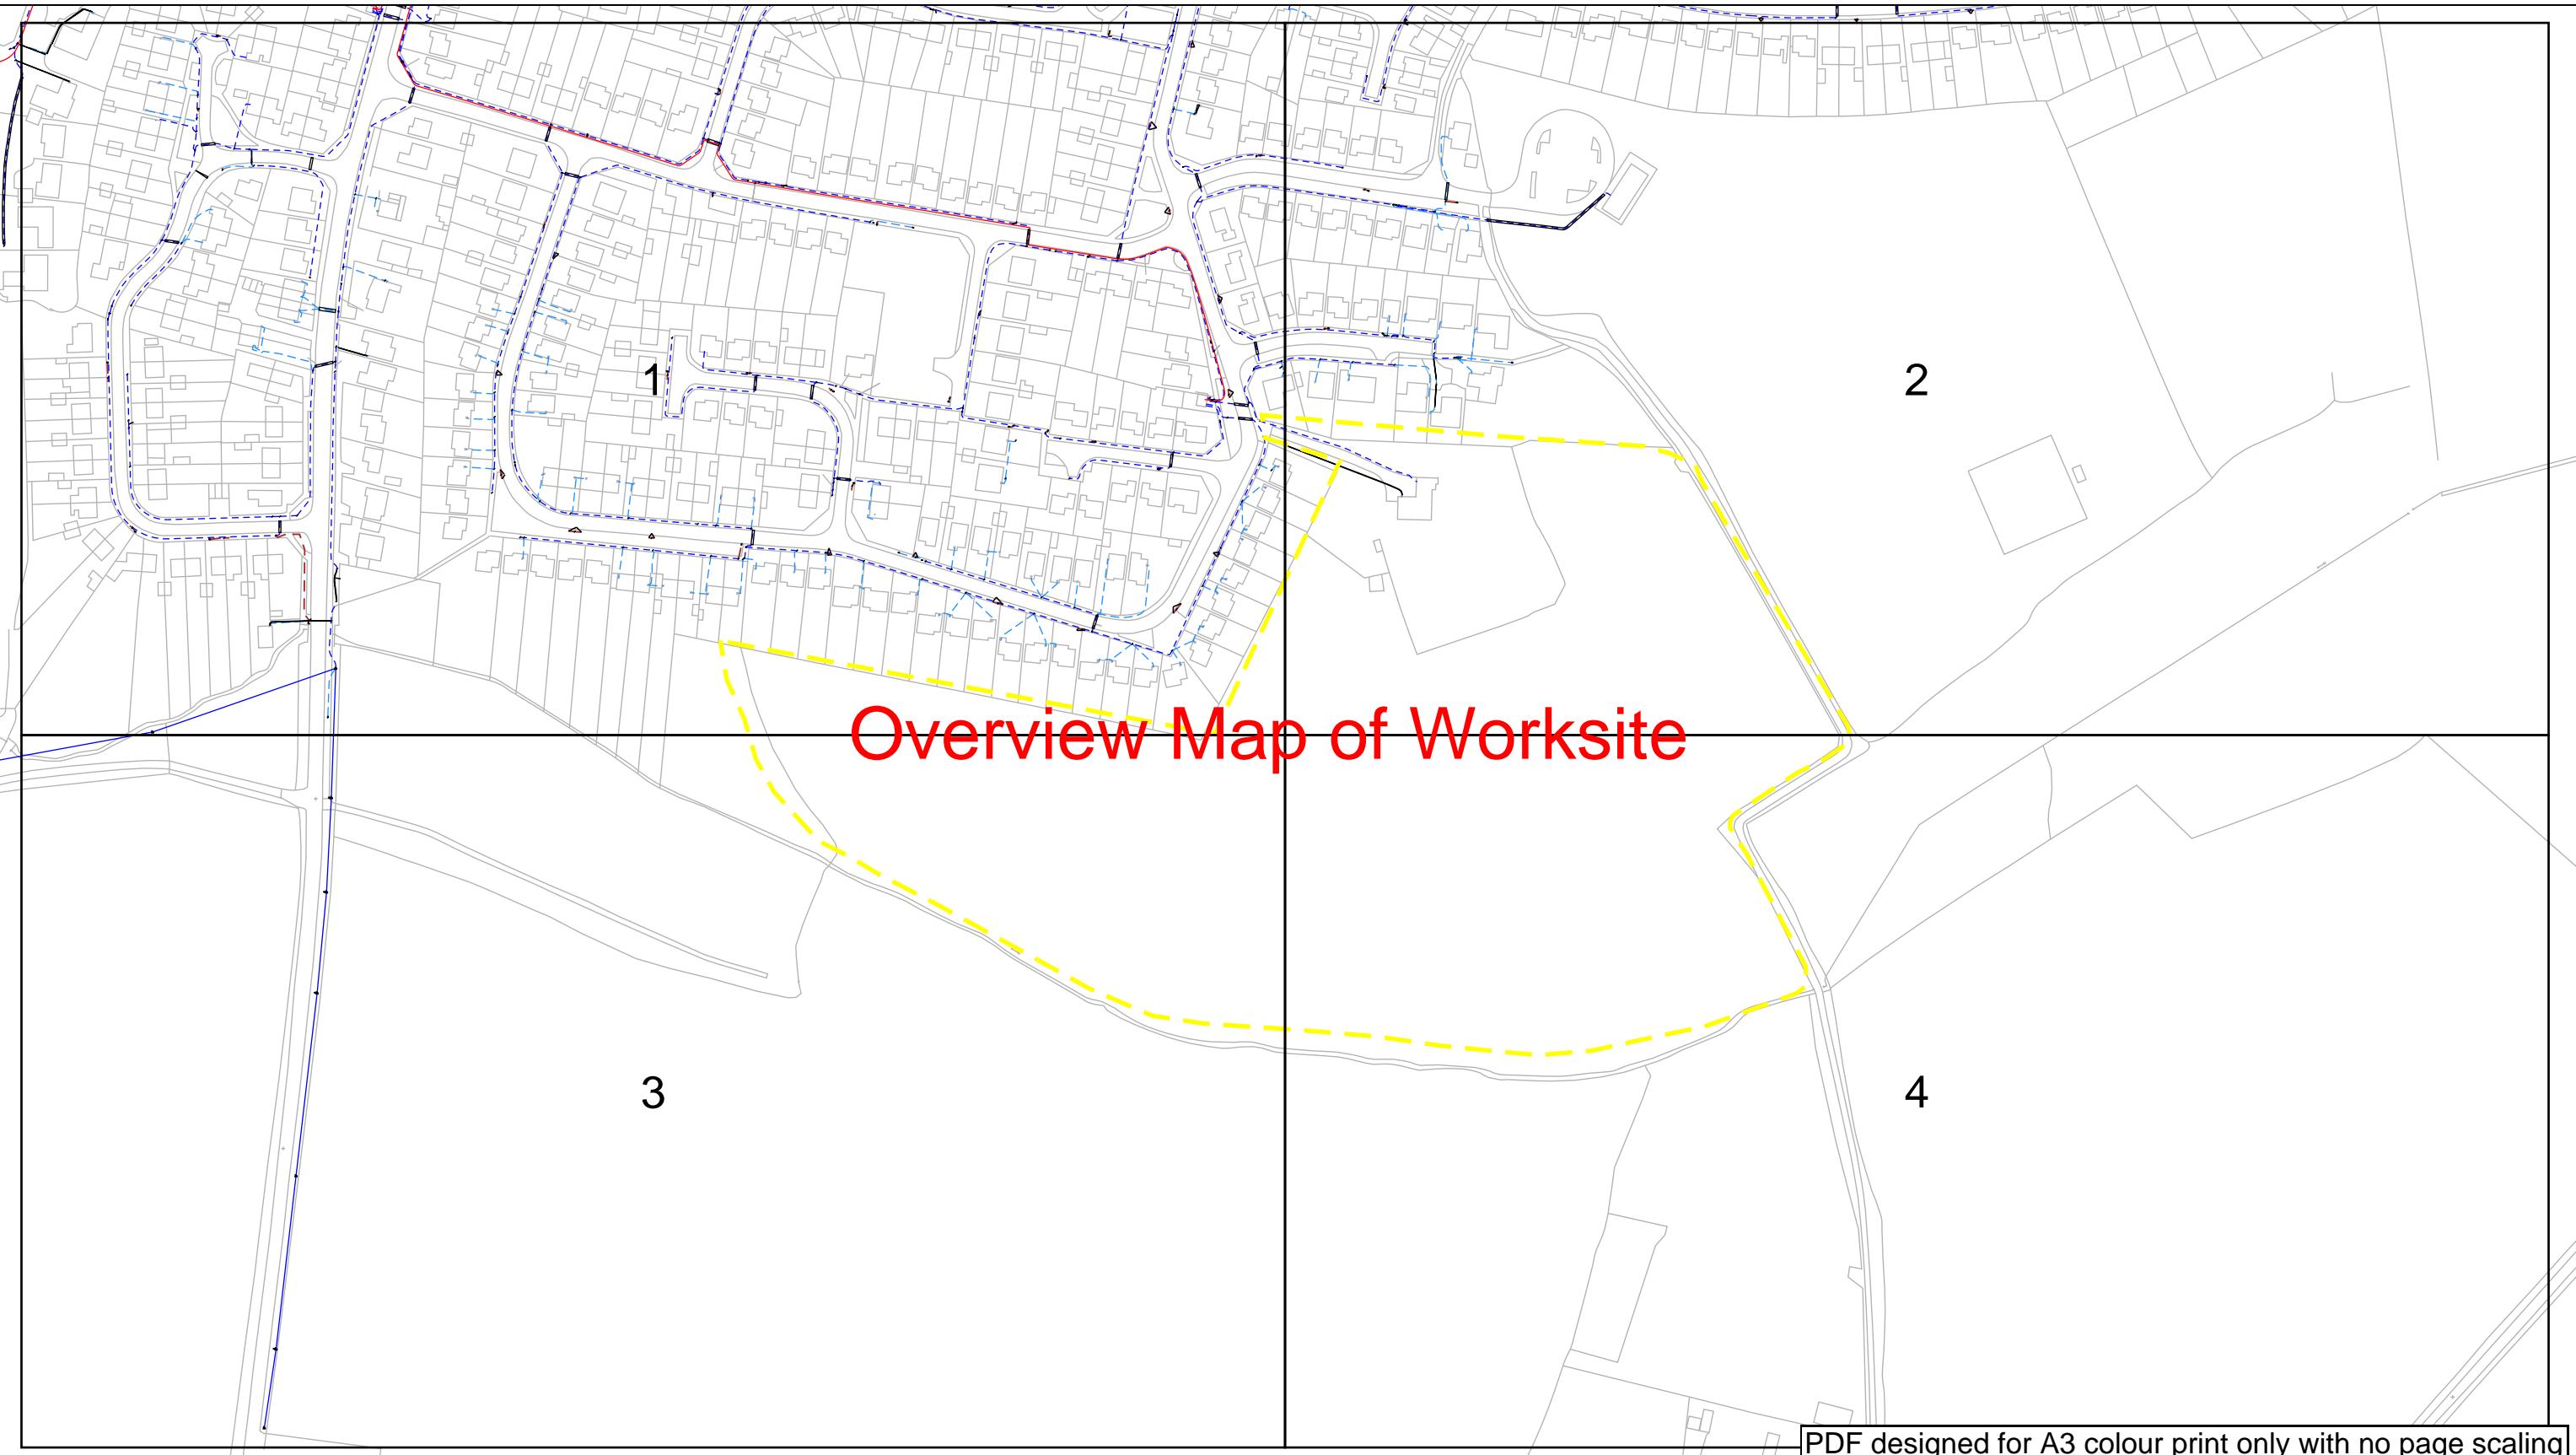


<p>Contact Us</p> <p>Mapping Enquiries: 0121 623 9780</p> <p>General Enquiries: 0800 096 3080</p>	<p>IMPORTANT NOTICES</p> <ul style="list-style-type: none"> This information is given as a guide only and its accuracy cannot be guaranteed. Services or recent additions to the network may not be shown. Cables, overhead lines & substations owned by other electricity network owners or private companies may be present and may not be shown. You should always verify exact locations of cables using a cable locator and by careful use of hand tools in accordance with HSE guidance note HSG47. When working within 10m of any overhead electric line you should follow the requirements of HSE Guidance Note GS6. For further advice on working near our electricity cables or lines, call our Contact Centre on 0800 096 3080. Advice should be sought from the National Grid Electricity Distribution Contact Centre for any work that is to take place in proximity to 66kV or 132kV underground cables and 66kV 132kV overhead lines – 0800 096 3080 	<p>Link Box</p> <p>Site Location Line/Area</p> <p>Overhead Line</p> <p>Underground Cable</p> <p>National Grid Telecoms</p> <p>Pilot Cables</p> <p>Private Cables</p> <p>Pole Mounted Transformer</p> <p>Ground Mounted Transformer</p> <p>PME Earth</p> <p>Underground Earth</p>	<p>nationalgrid </p> <p>Email: NGED.MapResponse@NationalGrid.co.uk</p>
<p>Date Requested: 21/03/2024</p> <p>Job Reference: 32864702</p> <p>Site Location: 444784 303319</p> <p>Requested by: Mr Tom Furlong</p> <p>Your Scheme/Reference: - Newbold Verdon, Phase 2</p> <p>Scale: 1:2563 (When plotted at A3)</p>	<p>Crown Copyright © All Rights Reserved. Ordnance Survey Licence numbers: 100022432. NGED Copyright: This copy has been made by or with the authority of National Grid Electricity Distribution (NGED) pursuant to Section 47 of the Copyright Designs and Patents Act 1988 unless that Act provides a relevant exception to copyright the copy must not be copied without the prior permission of the copyright owner.</p>	<p>Report damage immediately KEEP EVERYONE AWAY FROM THE AREA</p> <p>0800 6783 105</p>	

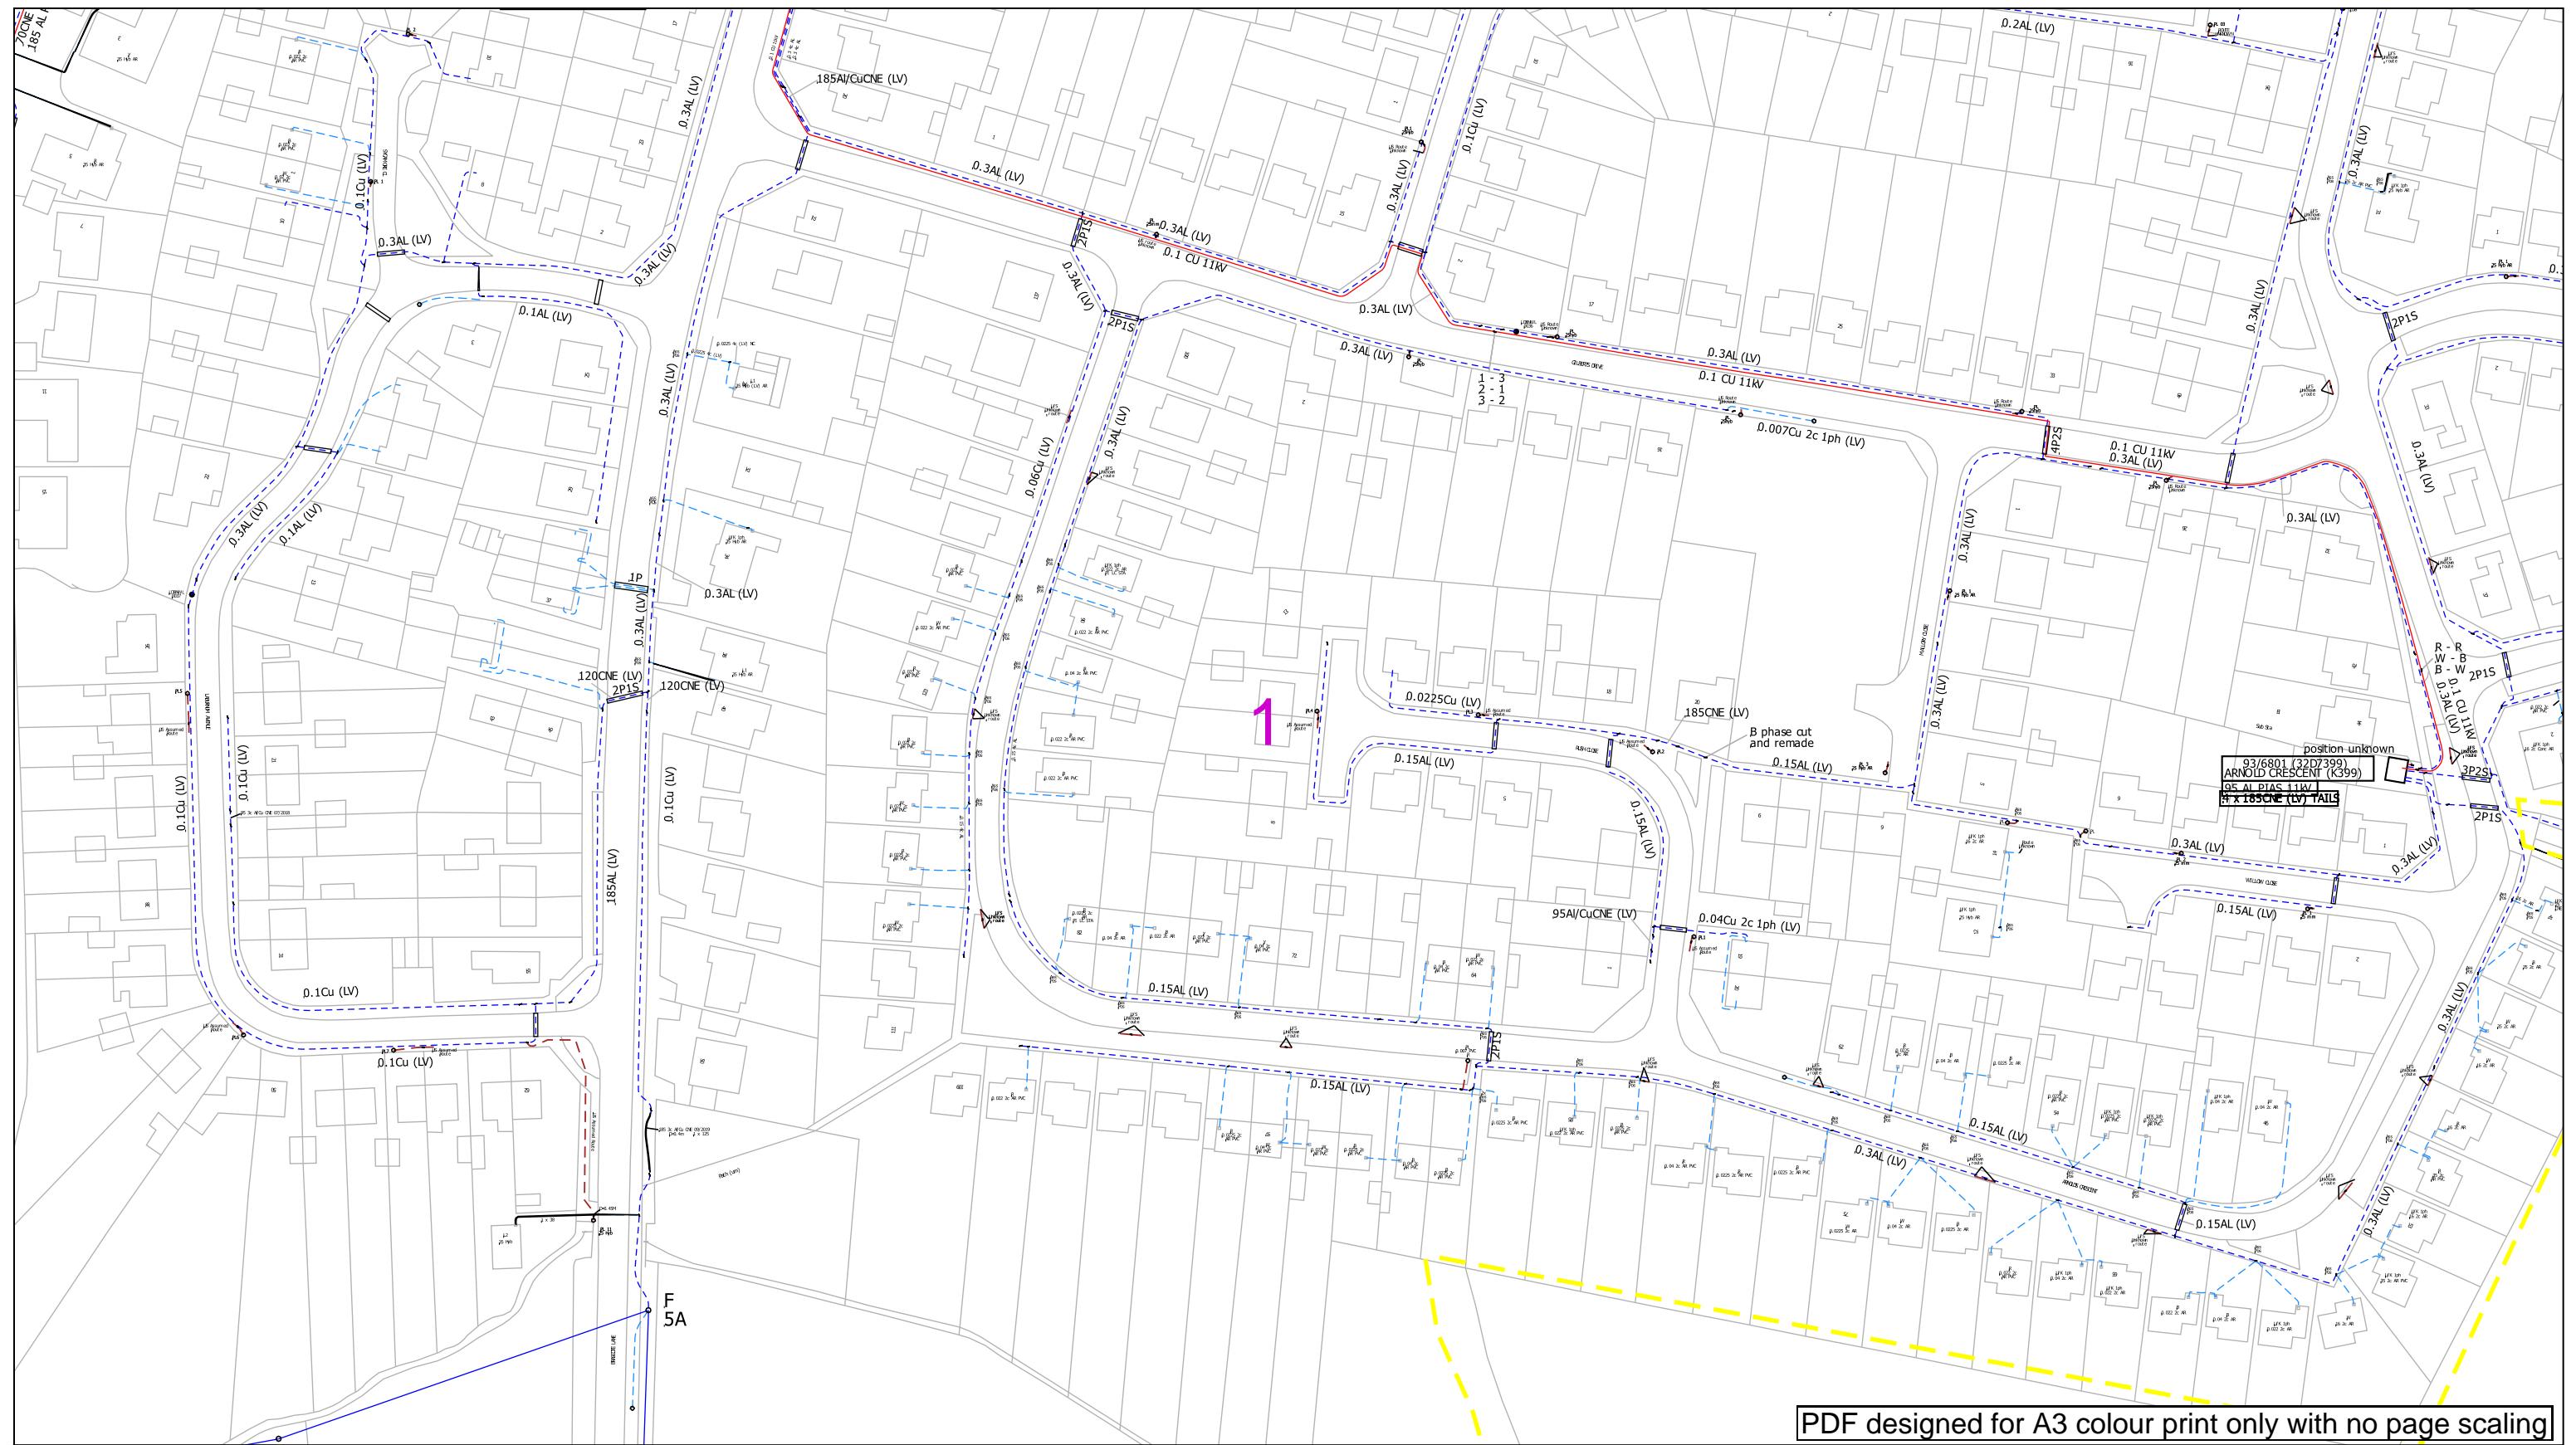

PDF designed for A3 colour print only with no page scaling

<p>Contact Us</p> <p>Mapping Enquiries: 0121 623 9780</p> <p>General Enquiries: 0800 096 3080</p>	<p>IMPORTANT NOTICES</p> <ul style="list-style-type: none"> This information is given as a guide only and its accuracy cannot be guaranteed. Services or recent additions to the network may not be shown. Cables, overhead lines & substations owned by other electricity network owners or private companies may be present and may not be shown. You should always verify exact locations of cables using a cable locator and by careful use of hand tools in accordance with HSE guidance note HSG47. When working within 10m of any overhead electric line you should follow the requirements of HSE Guidance Note GS6. For further advice on working near our electricity cables or lines, call our Contact Centre on 0800 096 3080. Advice should be sought from the National Grid Electricity Distribution Contact Centre for any work that is to take place in proximity to 66kV or 132kV underground cables and 66kV 132kV overhead lines – 0800 096 3080 	<p>0 100m</p> 	<p>nationalgrid </p>
<p>Date Requested: 21/03/2024</p> <p>Job Reference: 32864702</p> <p>Site Location: 444784 303319</p> <p>Requested by: Mr Tom Furlong</p> <p>Your Scheme/Reference: - Newbold Verdon, Phase 2</p>		<p>Link Box</p> <p>Site Location</p> <p>Line/Area</p> 	<p>Report damage immediately KEEP EVERYONE AWAY FROM THE AREA</p> <p>0800 6783 105</p>
<p>Scale: 1:1250 (When plotted at A3)</p>		<p>Report damage immediately KEEP EVERYONE AWAY FROM THE AREA</p> <p>0800 6783 105</p>	<p>Email: NGED.MapResponse@NationalGrid.co.uk</p>

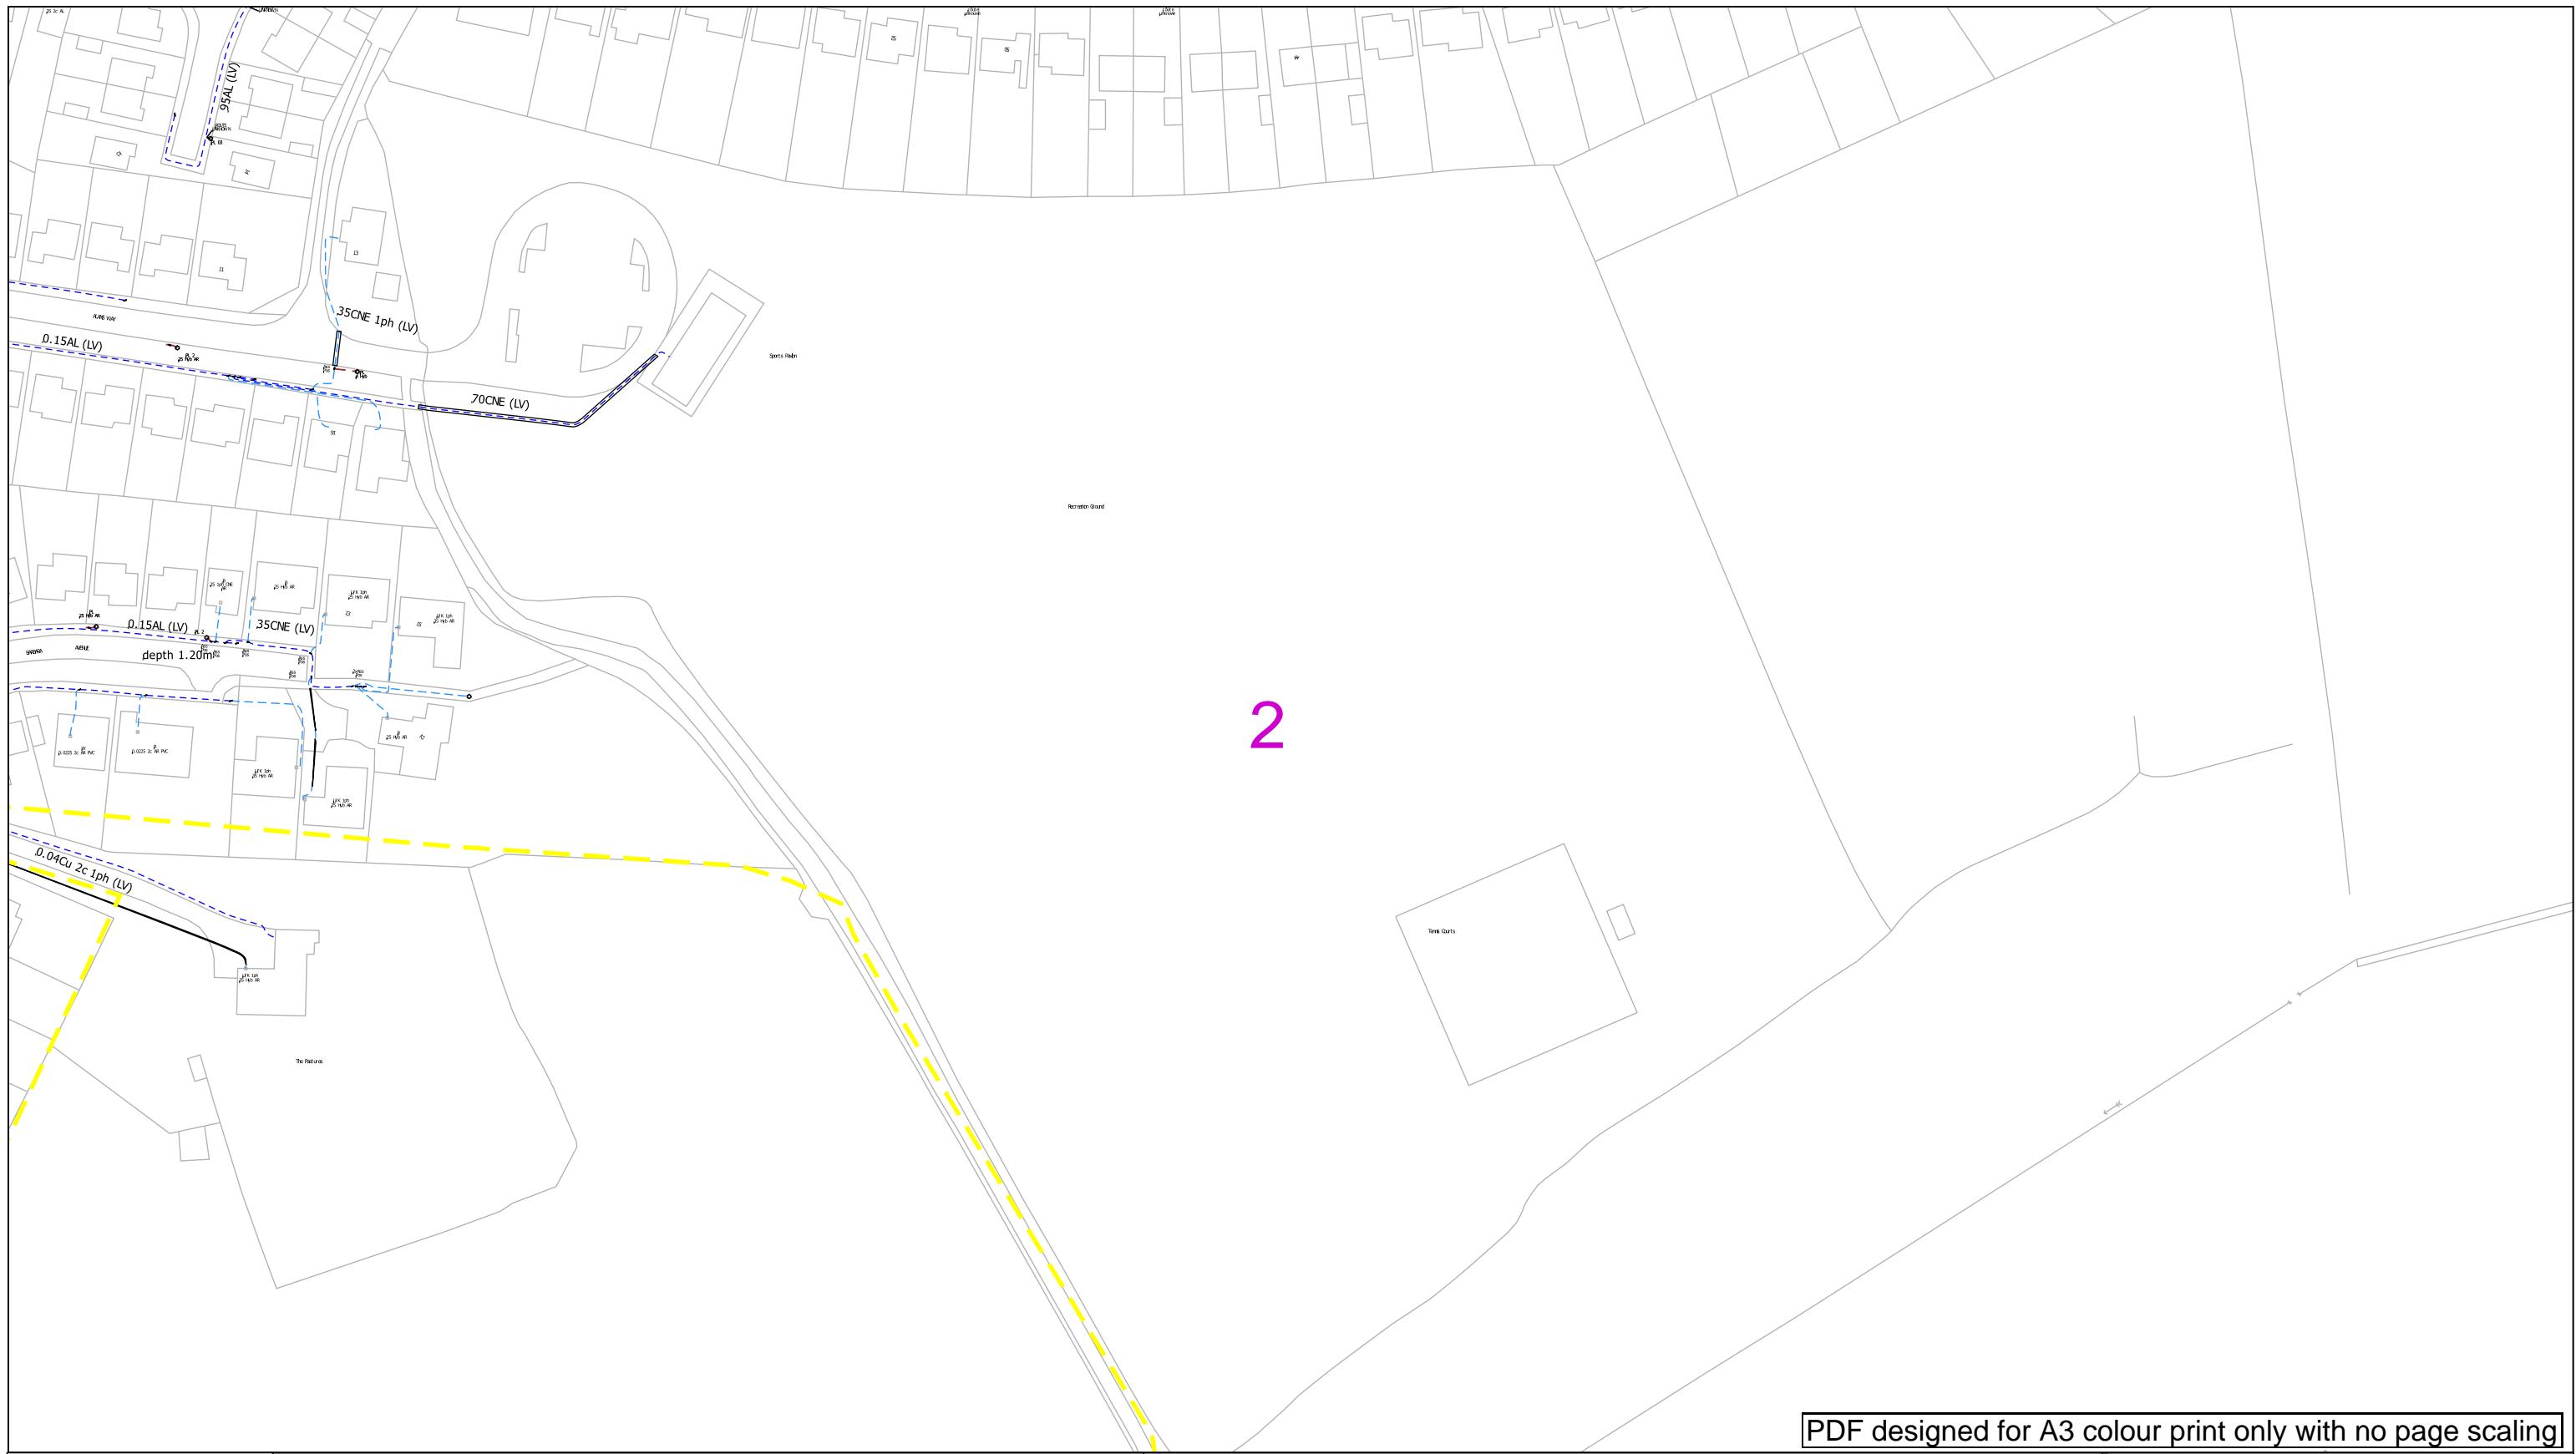


PDF designed for A3 colour print only with no page scaling

Contact Us Mapping Enquiries: 0121 623 9780 General Enquiries: 0800 096 3080
Date Requested: 21/03/2024 Job Reference: 32864702 Site Location: 444784 303319 Requested by: Mr Tom Furlong Your Scheme/Reference: - Newbold Verdon, Phase 2
Scale: 1:1250 (When plotted at A3)


IMPORTANT NOTICES

- This information is given as a guide only and its accuracy cannot be guaranteed. Services or recent additions to the network may not be shown.
- Cables, overhead lines & substations owned by other electricity network owners or private companies may be present and may not be shown.
- You should always verify exact locations of cables using a cable locator and by careful use of hand tools in accordance with HSE guidance note HSG47.
- When working within 10m of any overhead electric line you should follow the requirements of HSE Guidance Note GS6.
- For further advice on working near our electricity cables or lines, call our Contact Centre on 0800 096 3080.
- Advice should be sought from the National Grid Electricity Distribution Contact Centre for any work that is to take place in proximity to 66kV or 132kV underground cables and 66kV 132kV overhead lines – 0800 096 3080

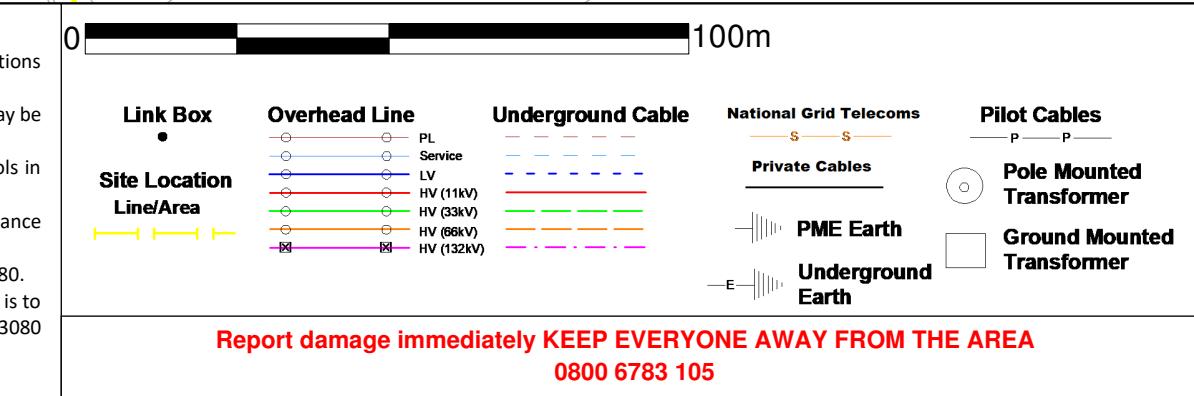

nationalgrid  **Electricity Distribution**

Email: NGED.MapResponse@NationalGrid.co.uk

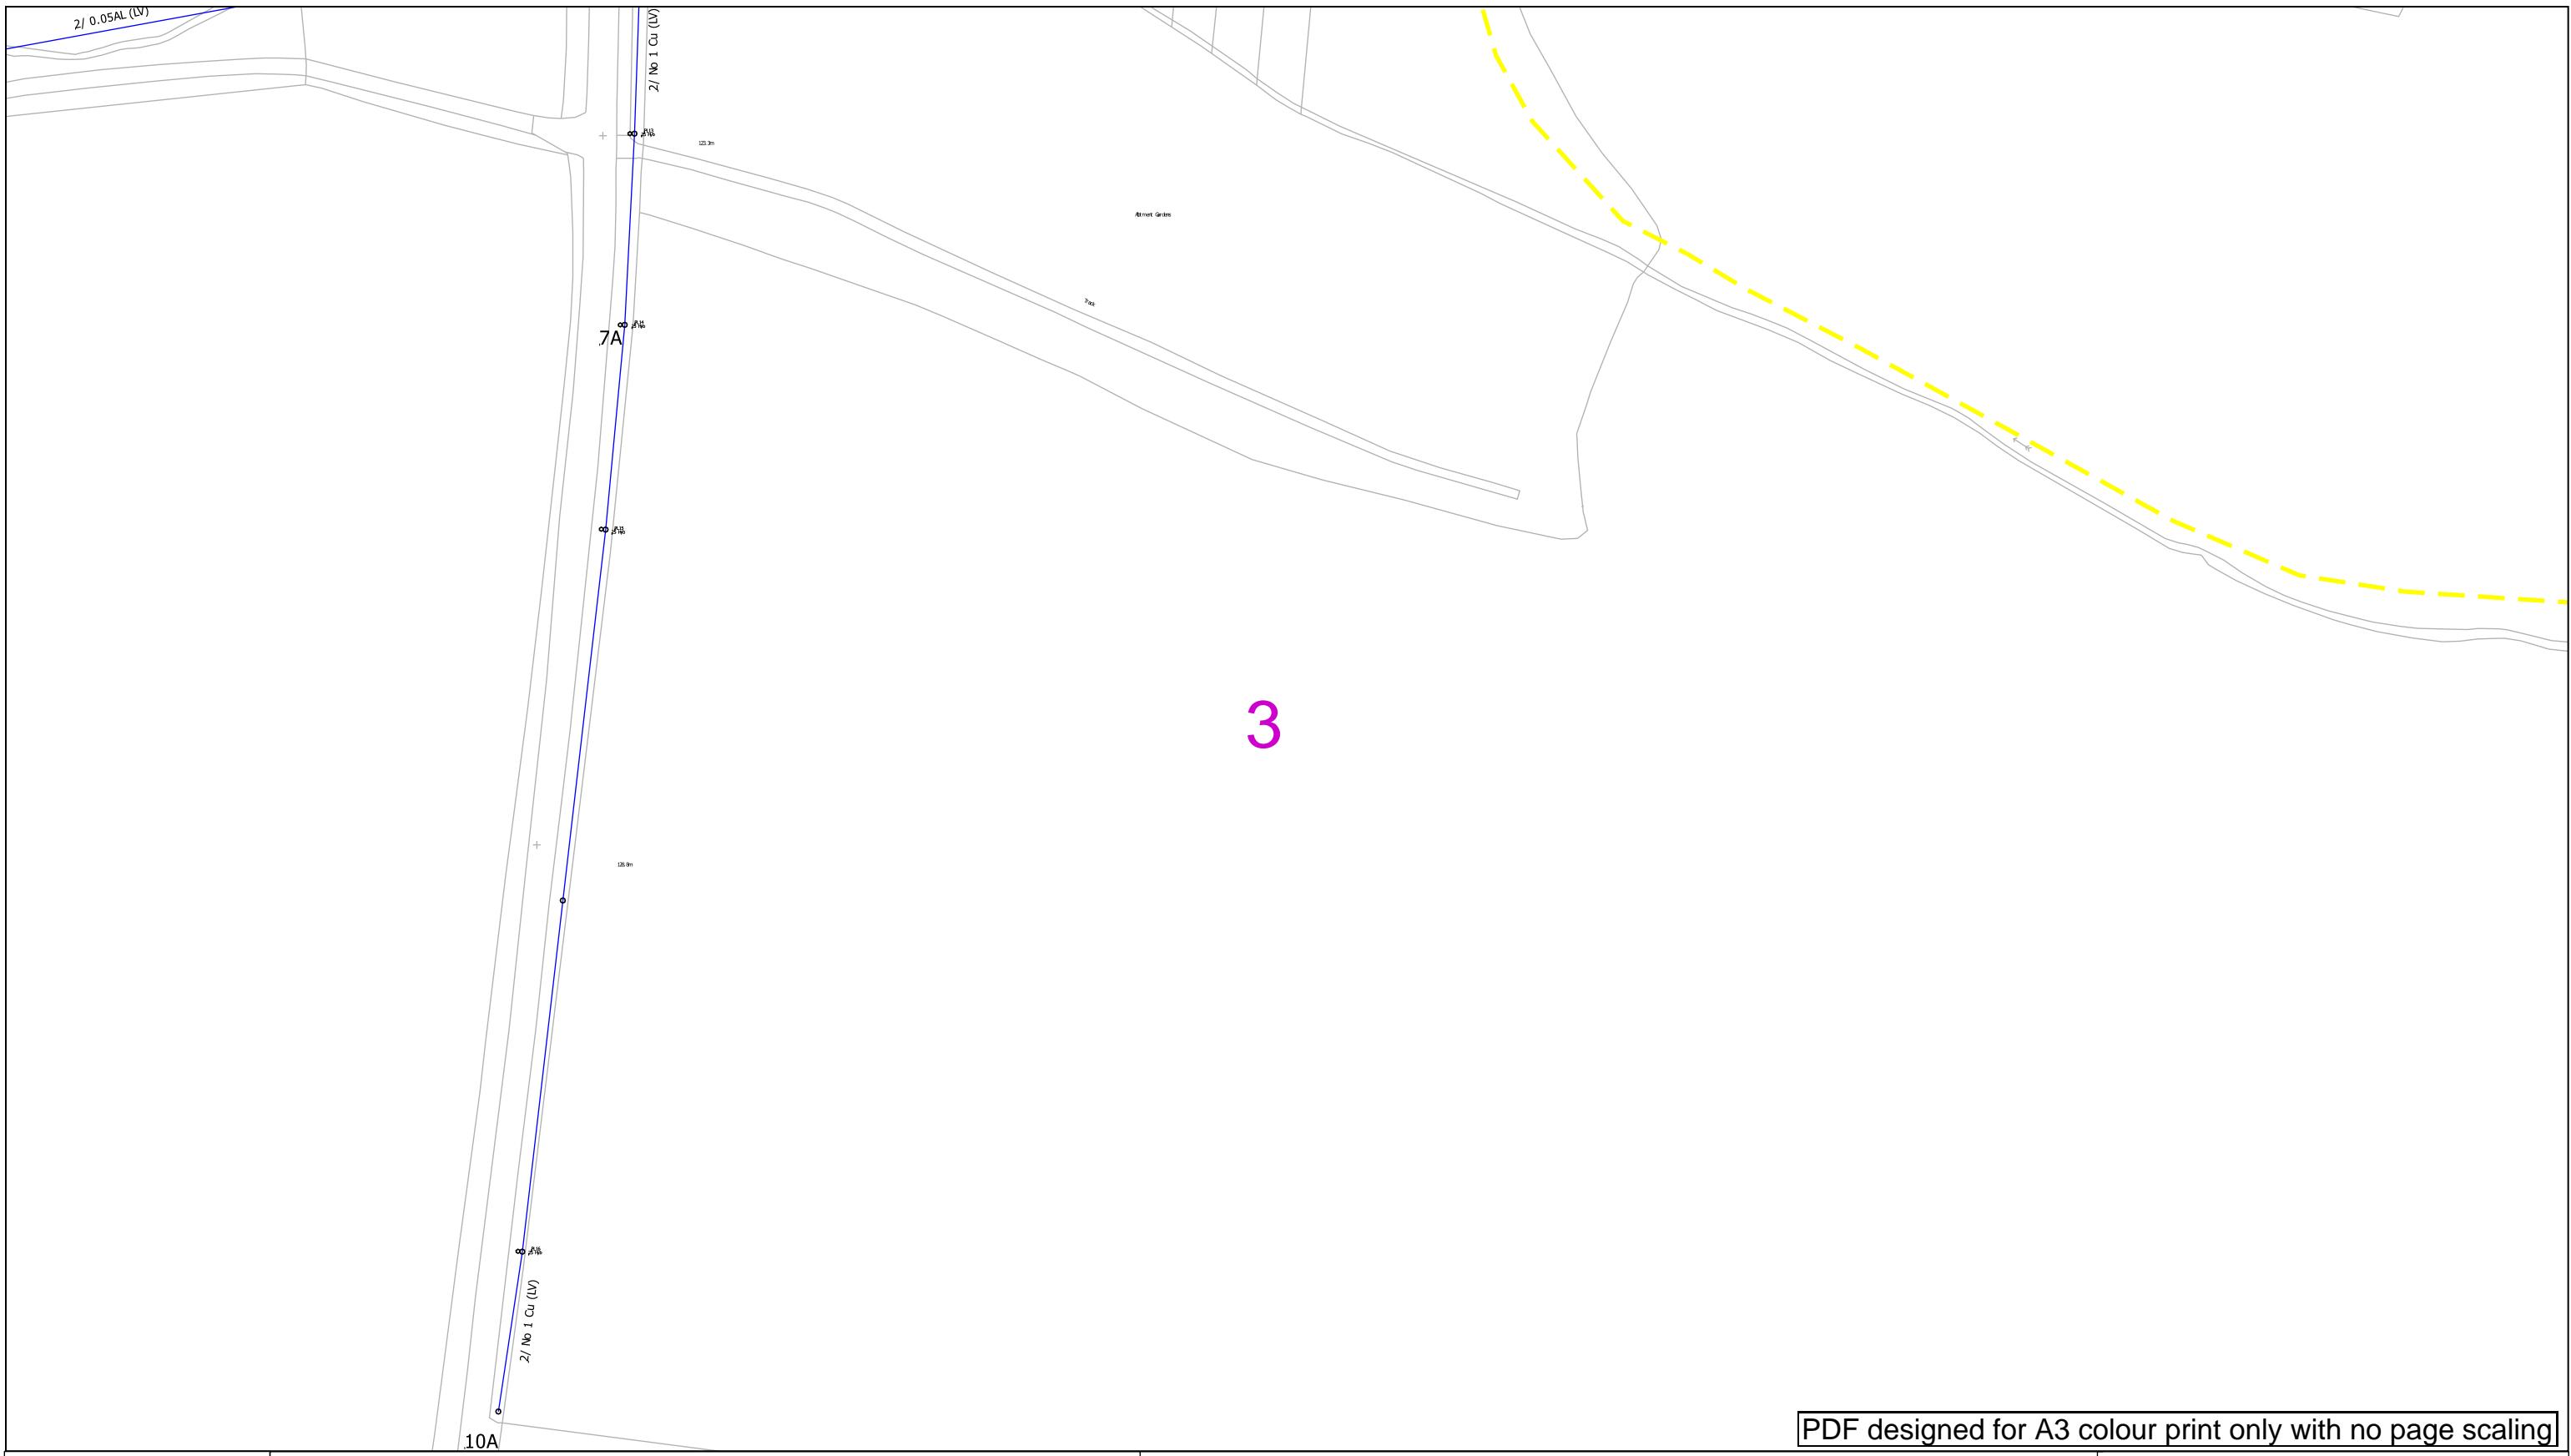


PDF designed for A3 colour print only with no page scaling

Contact Us Mapping Enquiries: 0121 623 9780 General Enquiries: 0800 096 3080	
Date Requested: 21/03/2024 Job Reference: 32864702 Site Location: 444784 303319 Requested by: Mr Tom Furlong Your Scheme/Reference: - Newbold Verdon, Phase 2	
Scale: 1:1250 (When plotted at A3)	


IMPORTANT NOTICES

- This information is given as a guide only and its accuracy cannot be guaranteed. Services or recent additions to the network may not be shown.
- Cables, overhead lines & substations owned by other electricity network owners or private companies may be present and may not be shown.
- You should always verify exact locations of cables using a cable locator and by careful use of hand tools in accordance with HSE guidance note HSG47.
- When working within 10m of any overhead electric line you should follow the requirements of HSE Guidance Note GS6.
- For further advice on working near our electricity cables or lines, call our Contact Centre on 0800 096 3080.
- Advice should be sought from the National Grid Electricity Distribution Contact Centre for any work that is to take place in proximity to 66kV or 132kV underground cables and 66kV 132kV overhead lines – 0800 096 3080

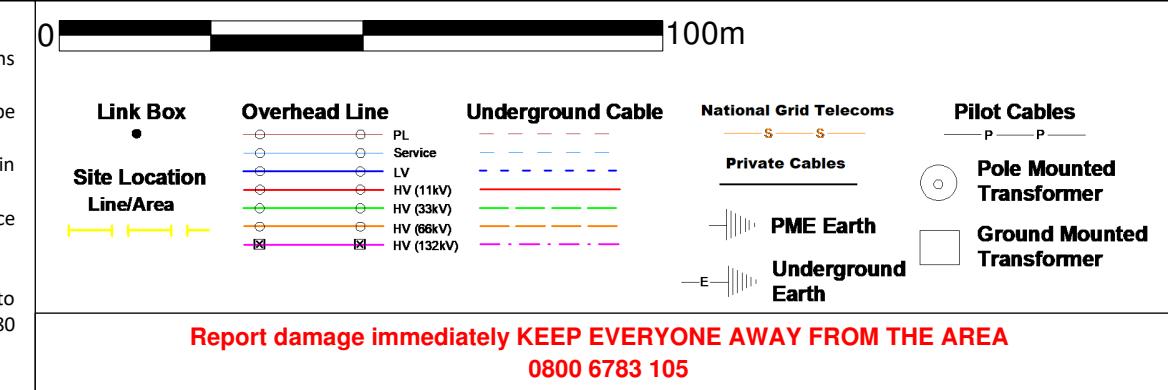

nationalgrid  **Electricity Distribution**

Email: NGED.MapResponse@NationalGrid.co.uk

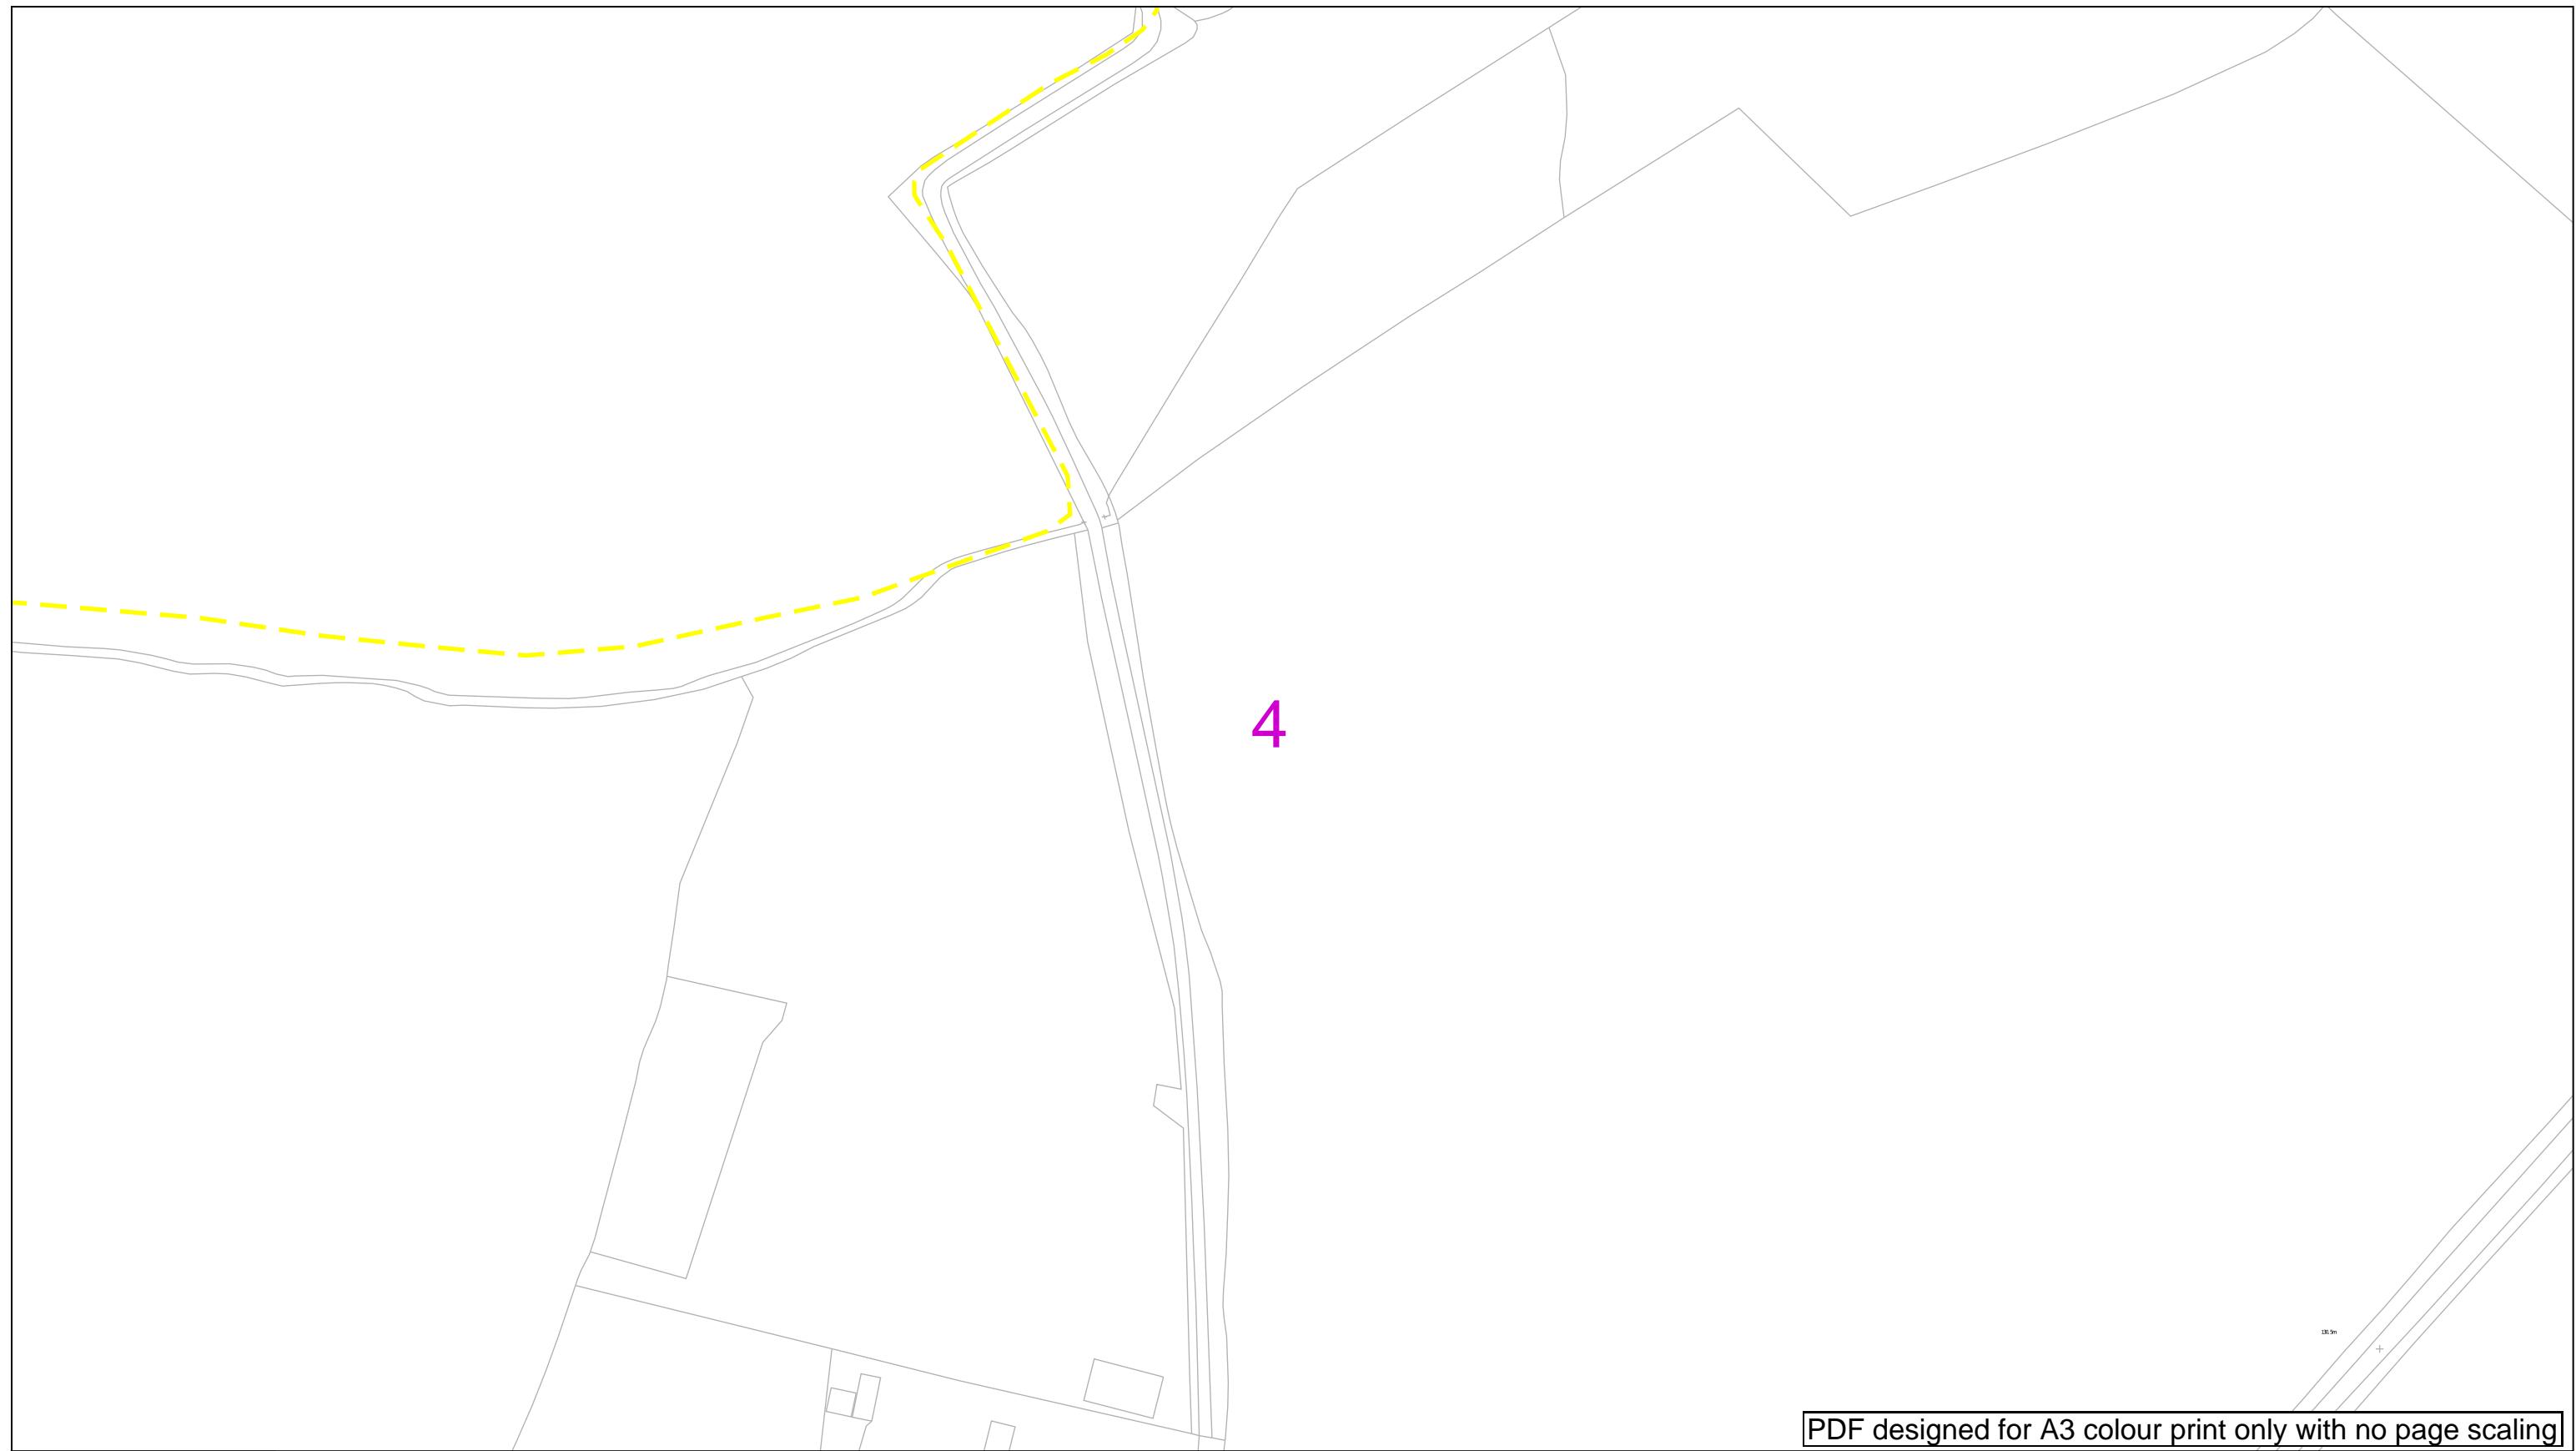


PDF designed for A3 colour print only with no page scaling

Contact Us Mapping Enquiries: 0121 623 9780 General Enquiries: 0800 096 3080
Date Requested: 21/03/2024 Job Reference: 32864702 Site Location: 444784 303319 Requested by: Mr Tom Furlong Your Scheme/Reference: - Newbold Verdon, Phase 2
Scale: 1:1250 (When plotted at A3)

IMPORTANT NOTICES

- This information is given as a guide only and its accuracy cannot be guaranteed. Services or recent additions to the network may not be shown.
- Cables, overhead lines & substations owned by other electricity network owners or private companies may be present and may not be shown.
- You should always verify exact locations of cables using a cable locator and by careful use of hand tools in accordance with HSE guidance note HSG47.
- When working within 10m of any overhead electric line you should follow the requirements of HSE Guidance Note GS6.
- For further advice on working near our electricity cables or lines, call our Contact Centre on 0800 096 3080.
- Advice should be sought from the National Grid Electricity Distribution Contact Centre for any work that is to take place in proximity to 66kV or 132kV underground cables and 66kV 132kV overhead lines – 0800 096 3080

0 100m

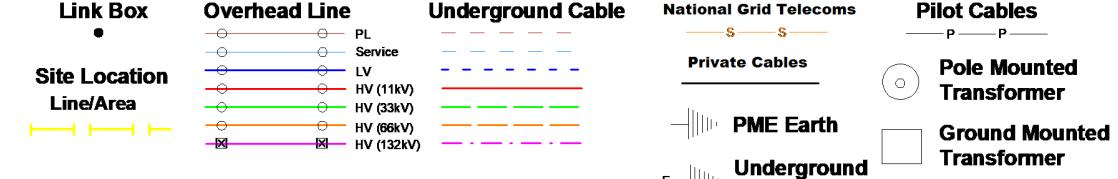


Report damage immediately KEEP EVERYONE AWAY FROM THE AREA
0800 6783 105


nationalgrid **Electricity Distribution**

Email: NGED.MapResponse@NationalGrid.co.uk

APPENDIX 4: CADENT GAS

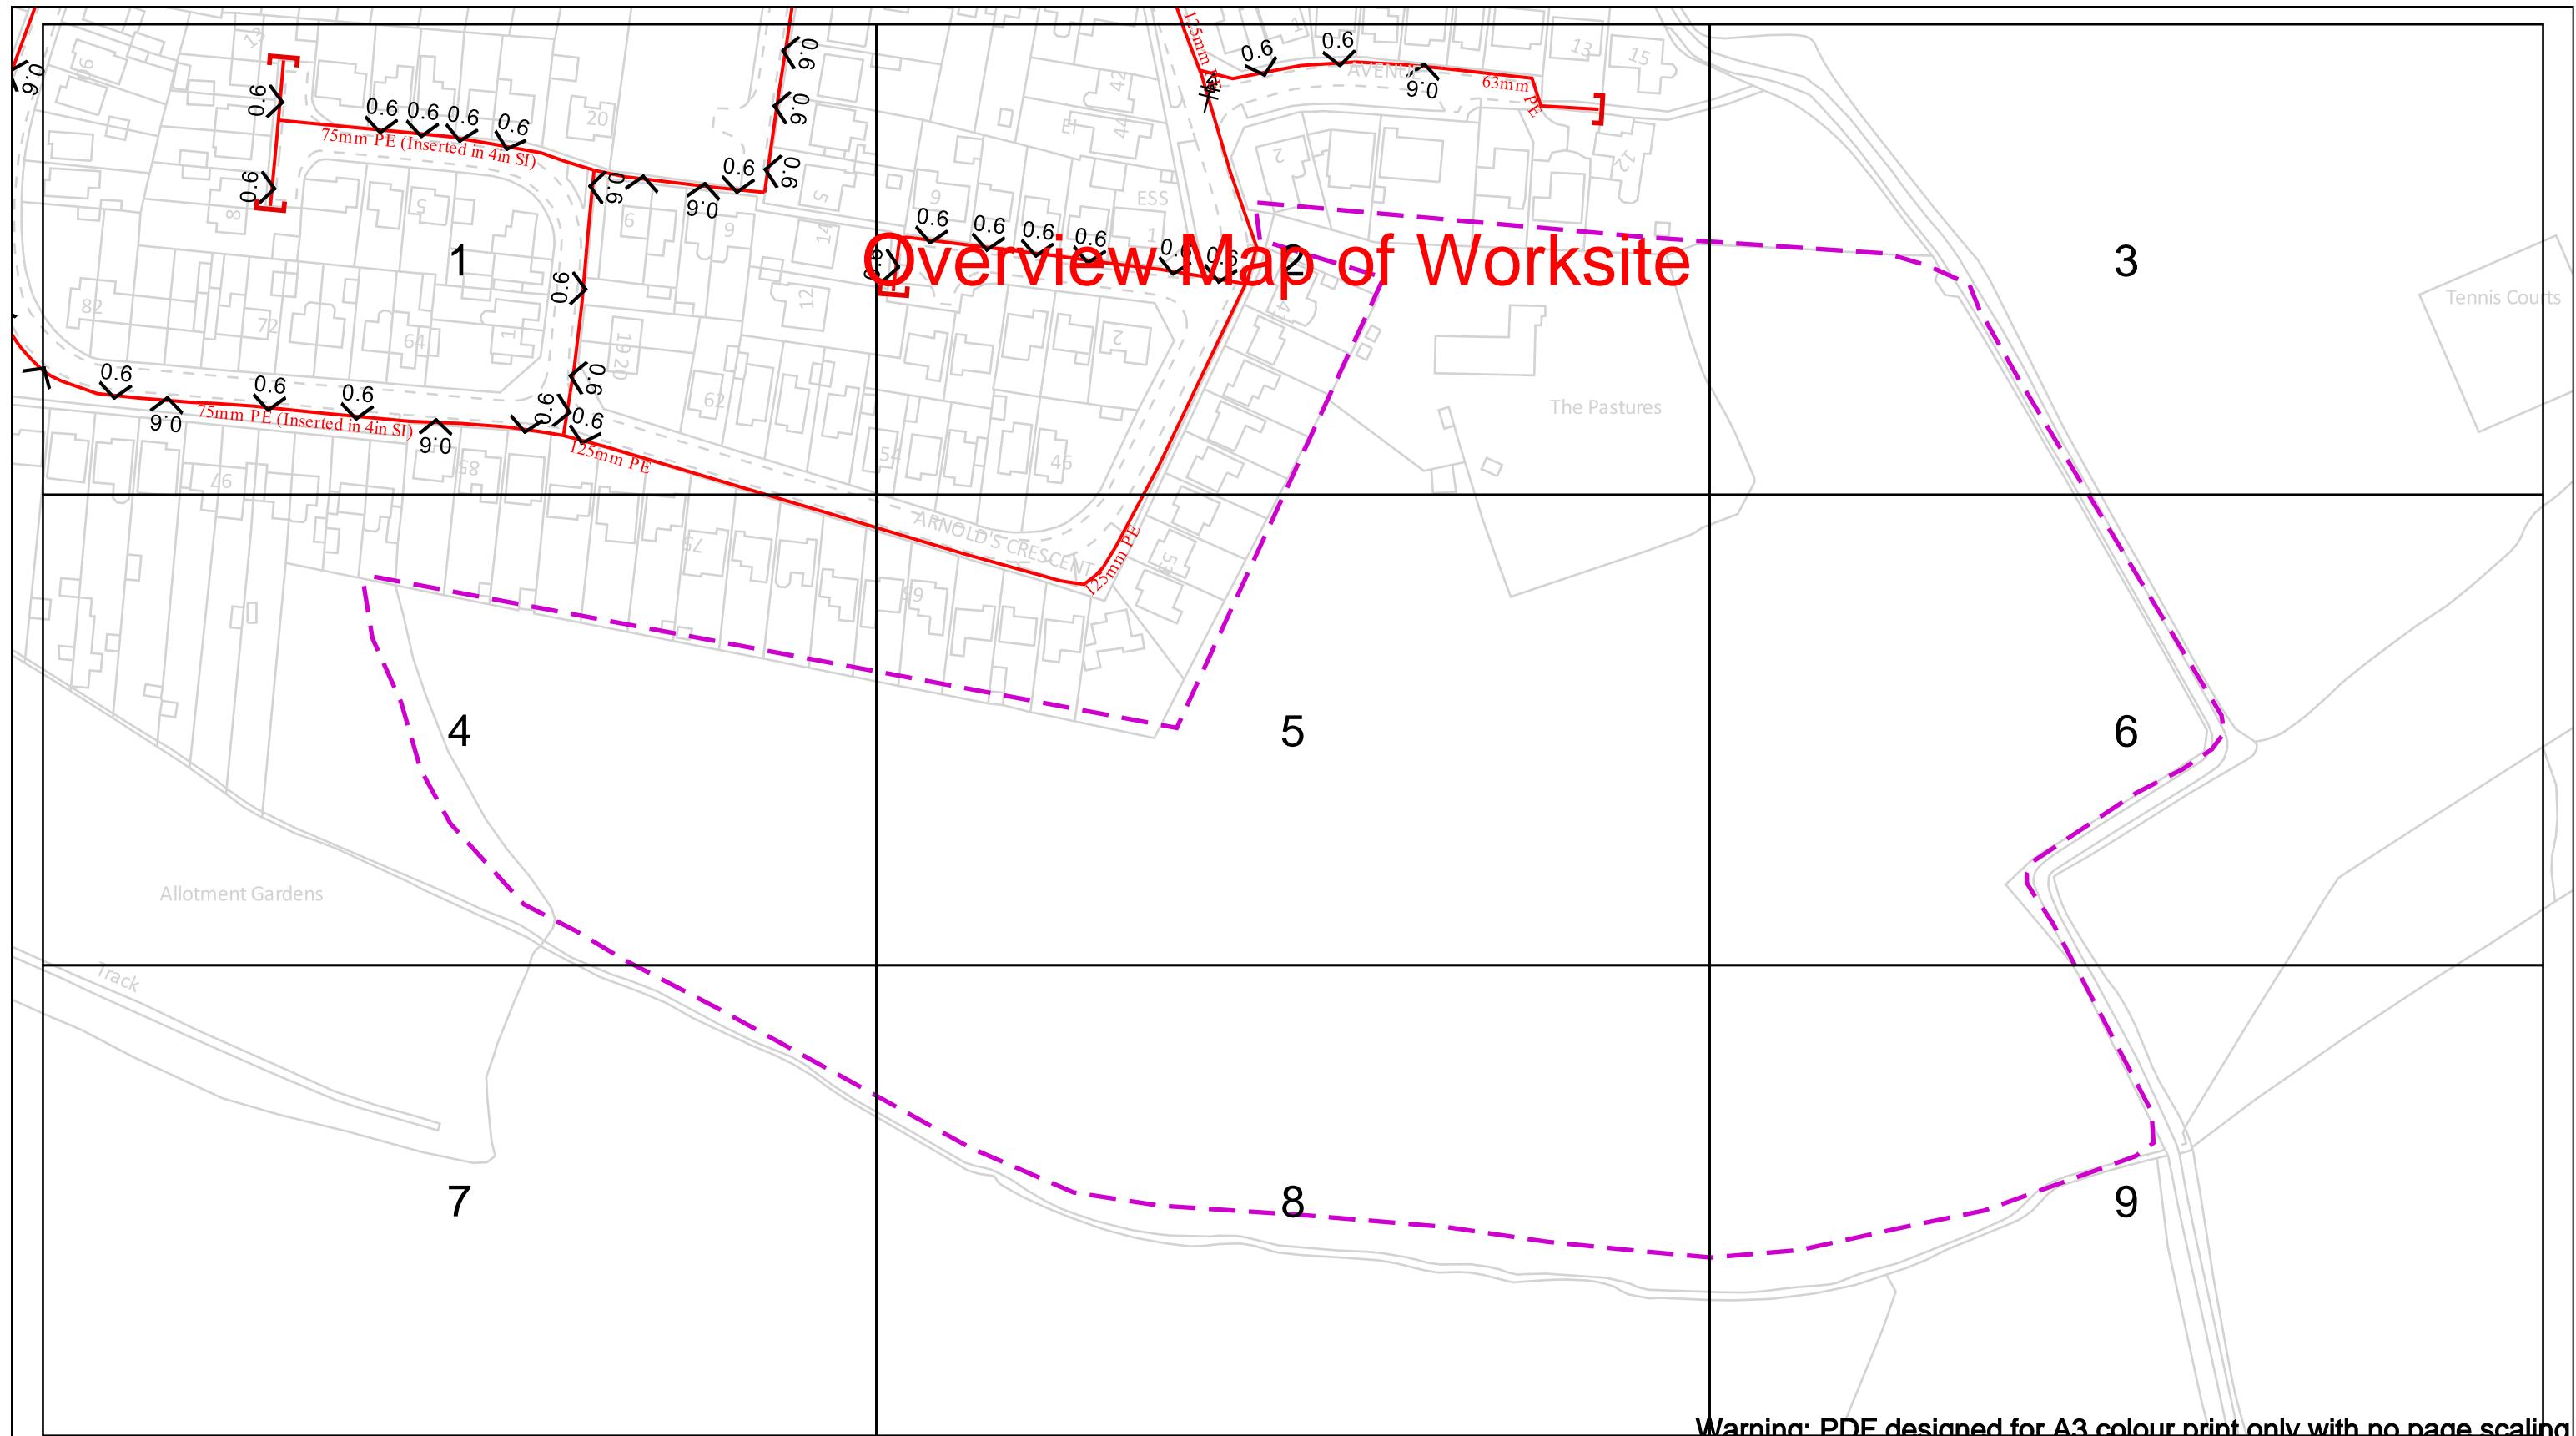


Warning: PDF designed for A3 colour print only with no page scaling

 	<p>View extent: 200m, 115m</p> <p>Date Requested: 21/03/2024 Job Reference: 32864702 Site Location: 444784 303319 Requested by: Mr Tom Furlong Your Scheme/Reference: - Newbold Verdon, Phase 2</p>	<p>In case of an emergency call 0800 111 999</p>	
<p>Scale: 1:1537 (When plotted at A3)</p>	<p>IMPORTANT NOTICES</p> <p>This plan shows these pipes owned by Cadent Gas Limited in its role as a Licensed Gas Transporter (GT). Gas pipes owned by other GT's or otherwise privately owned may be present in this area. Information with regards to such pipes should be obtained from the relevant owners. The information shown on this plan is given without warranty, the accuracy thereof cannot be guaranteed. Service pipes, valves, siphons, stub connections etc. are not shown but their presence should be anticipated. No liability of any kind whatsoever is accepted by Cadent Gas Limited or their agents, servants or contractors for any errors or omission. Safe digging practices, in accordance with HSG47, must be used to verify and establish the actual position of mains, pipes, services and other apparatus on site before any mechanical plant is used. It is your responsibility to ensure that this information is provided to all persons (either direct labour or contractors) working for you on or near gas apparatus. The information included on this plan should not be referred to beyond a period of 28 days from the date of issue.</p>	<p>Dig Sites</p> <p>Area:  Line: </p> <p>  LP Mains  MP Mains  IP Mains  LHP Mains </p> <p>  Valve  Diameter Change  Depth of cover  Material Change  Siphon  Out of Standard Service </p> <p>Where an out-of-standard service is present please contact plant protection 0800 688 588 for further information.</p> <p>Out-of-standard service symbology may be used to indicate one or more of the following:</p> <ul style="list-style-type: none"> • Identification of shallow services • Identification of dual services • Recording of non-perpendicular services <p>A perpendicular service/connection is laid in a straight line from the entry point at the property to the connection at the main – this includes a pipe that has a perpendicular connection and is not straight but does not deviate more than 1m off centre line.</p>	<p>Cadent Your Gas Network</p>

Cadent

Your Gas Network

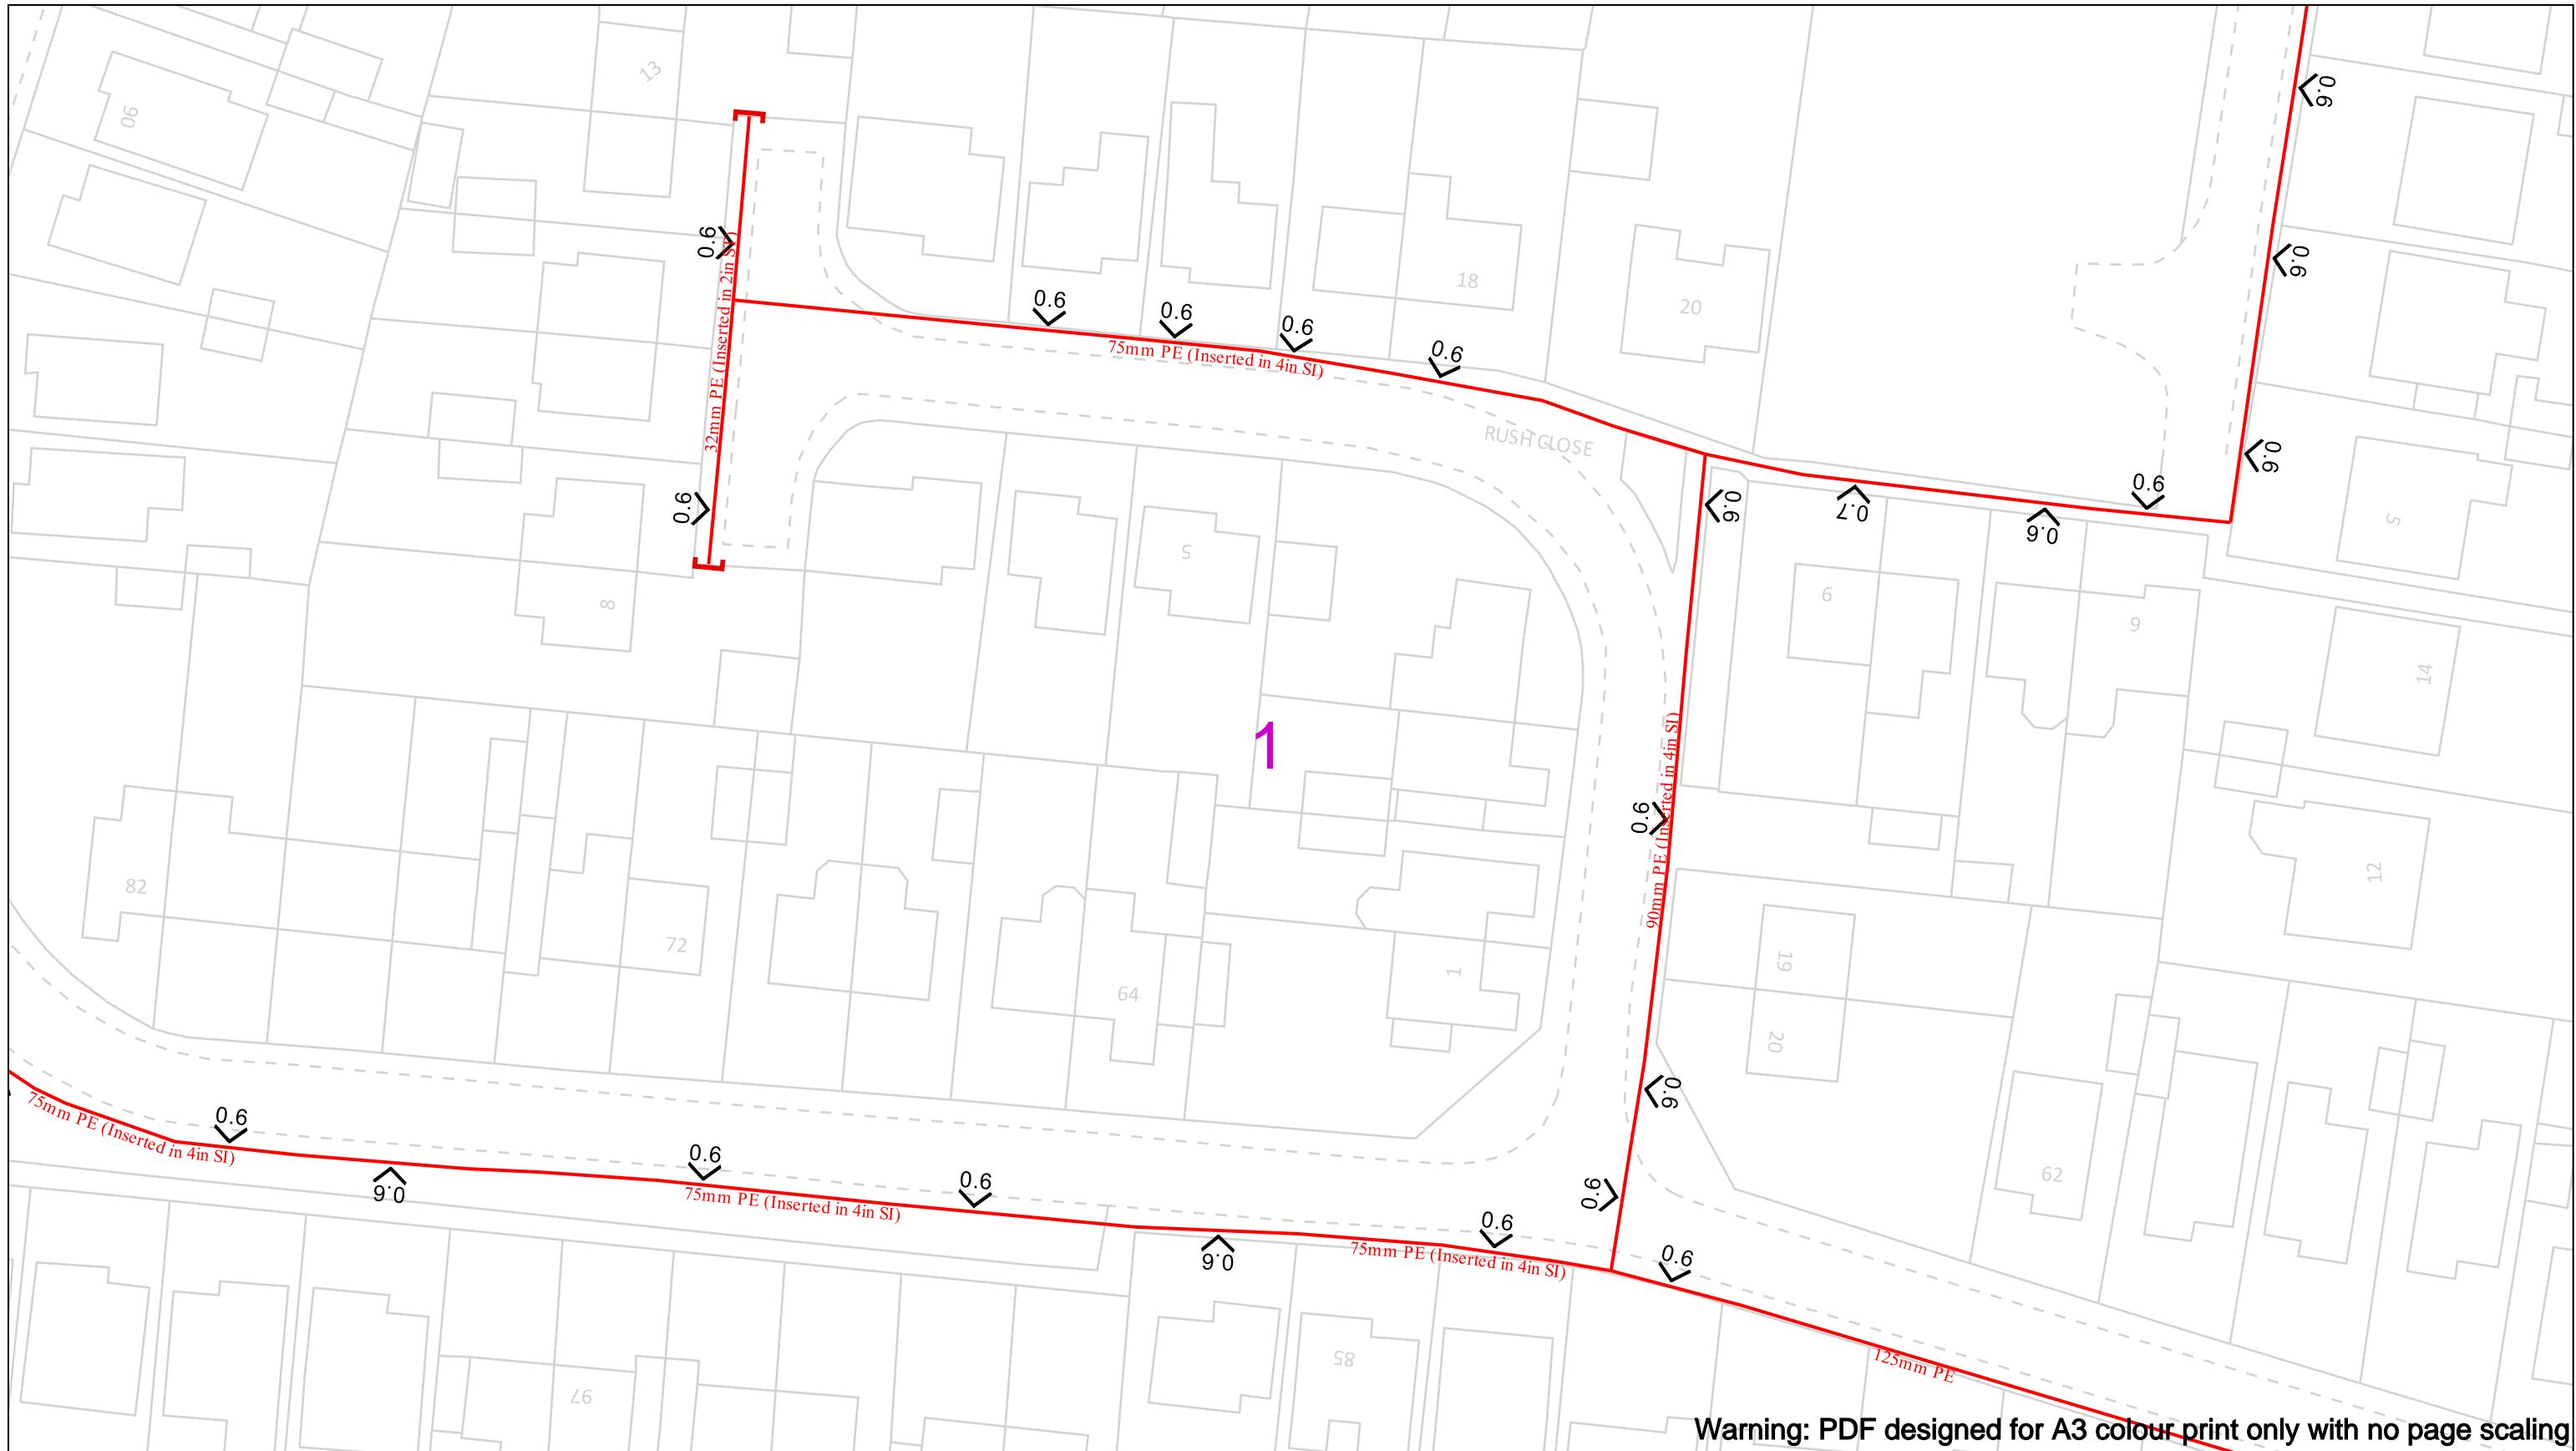

View extent: 200m, 115m

IMPORTANT NOTICES

Date Requested: 21/03/2024
 Job Reference: 32864702
 Site Location: 444784 303319
 Requested by:
 Mr Tom Furlong
 Your Scheme/Reference: - Newbold
 Verdon, Phase 2

Scale: 1:500 (When plotted at A3)

In case of an emergency call 0800 111 999

Dig Sites

- LP Mains
- MP Mains
- IP Mains
- LHP Mains

Area:  Line: 

-  Valve
-  Diameter Change
-  Depth of cover
-  Material Change
-  Syphon
-  Out of Standard Service


Where an out-of-standard service is present please contact plant protection 0800 688 588 for further information.

Out-of-standard service symbology may be used to indicate one or more of the following:

- Identification of shallow services
- Identification of dual services
- Recording of non-perpendicular services

A perpendicular service/connection is laid in a straight line from the entry point at the property to the connection at the main – this includes a pipe that has a perpendicular connection and is not straight but does not deviate more than 1m off centre line.

Cadent
 Your Gas Network

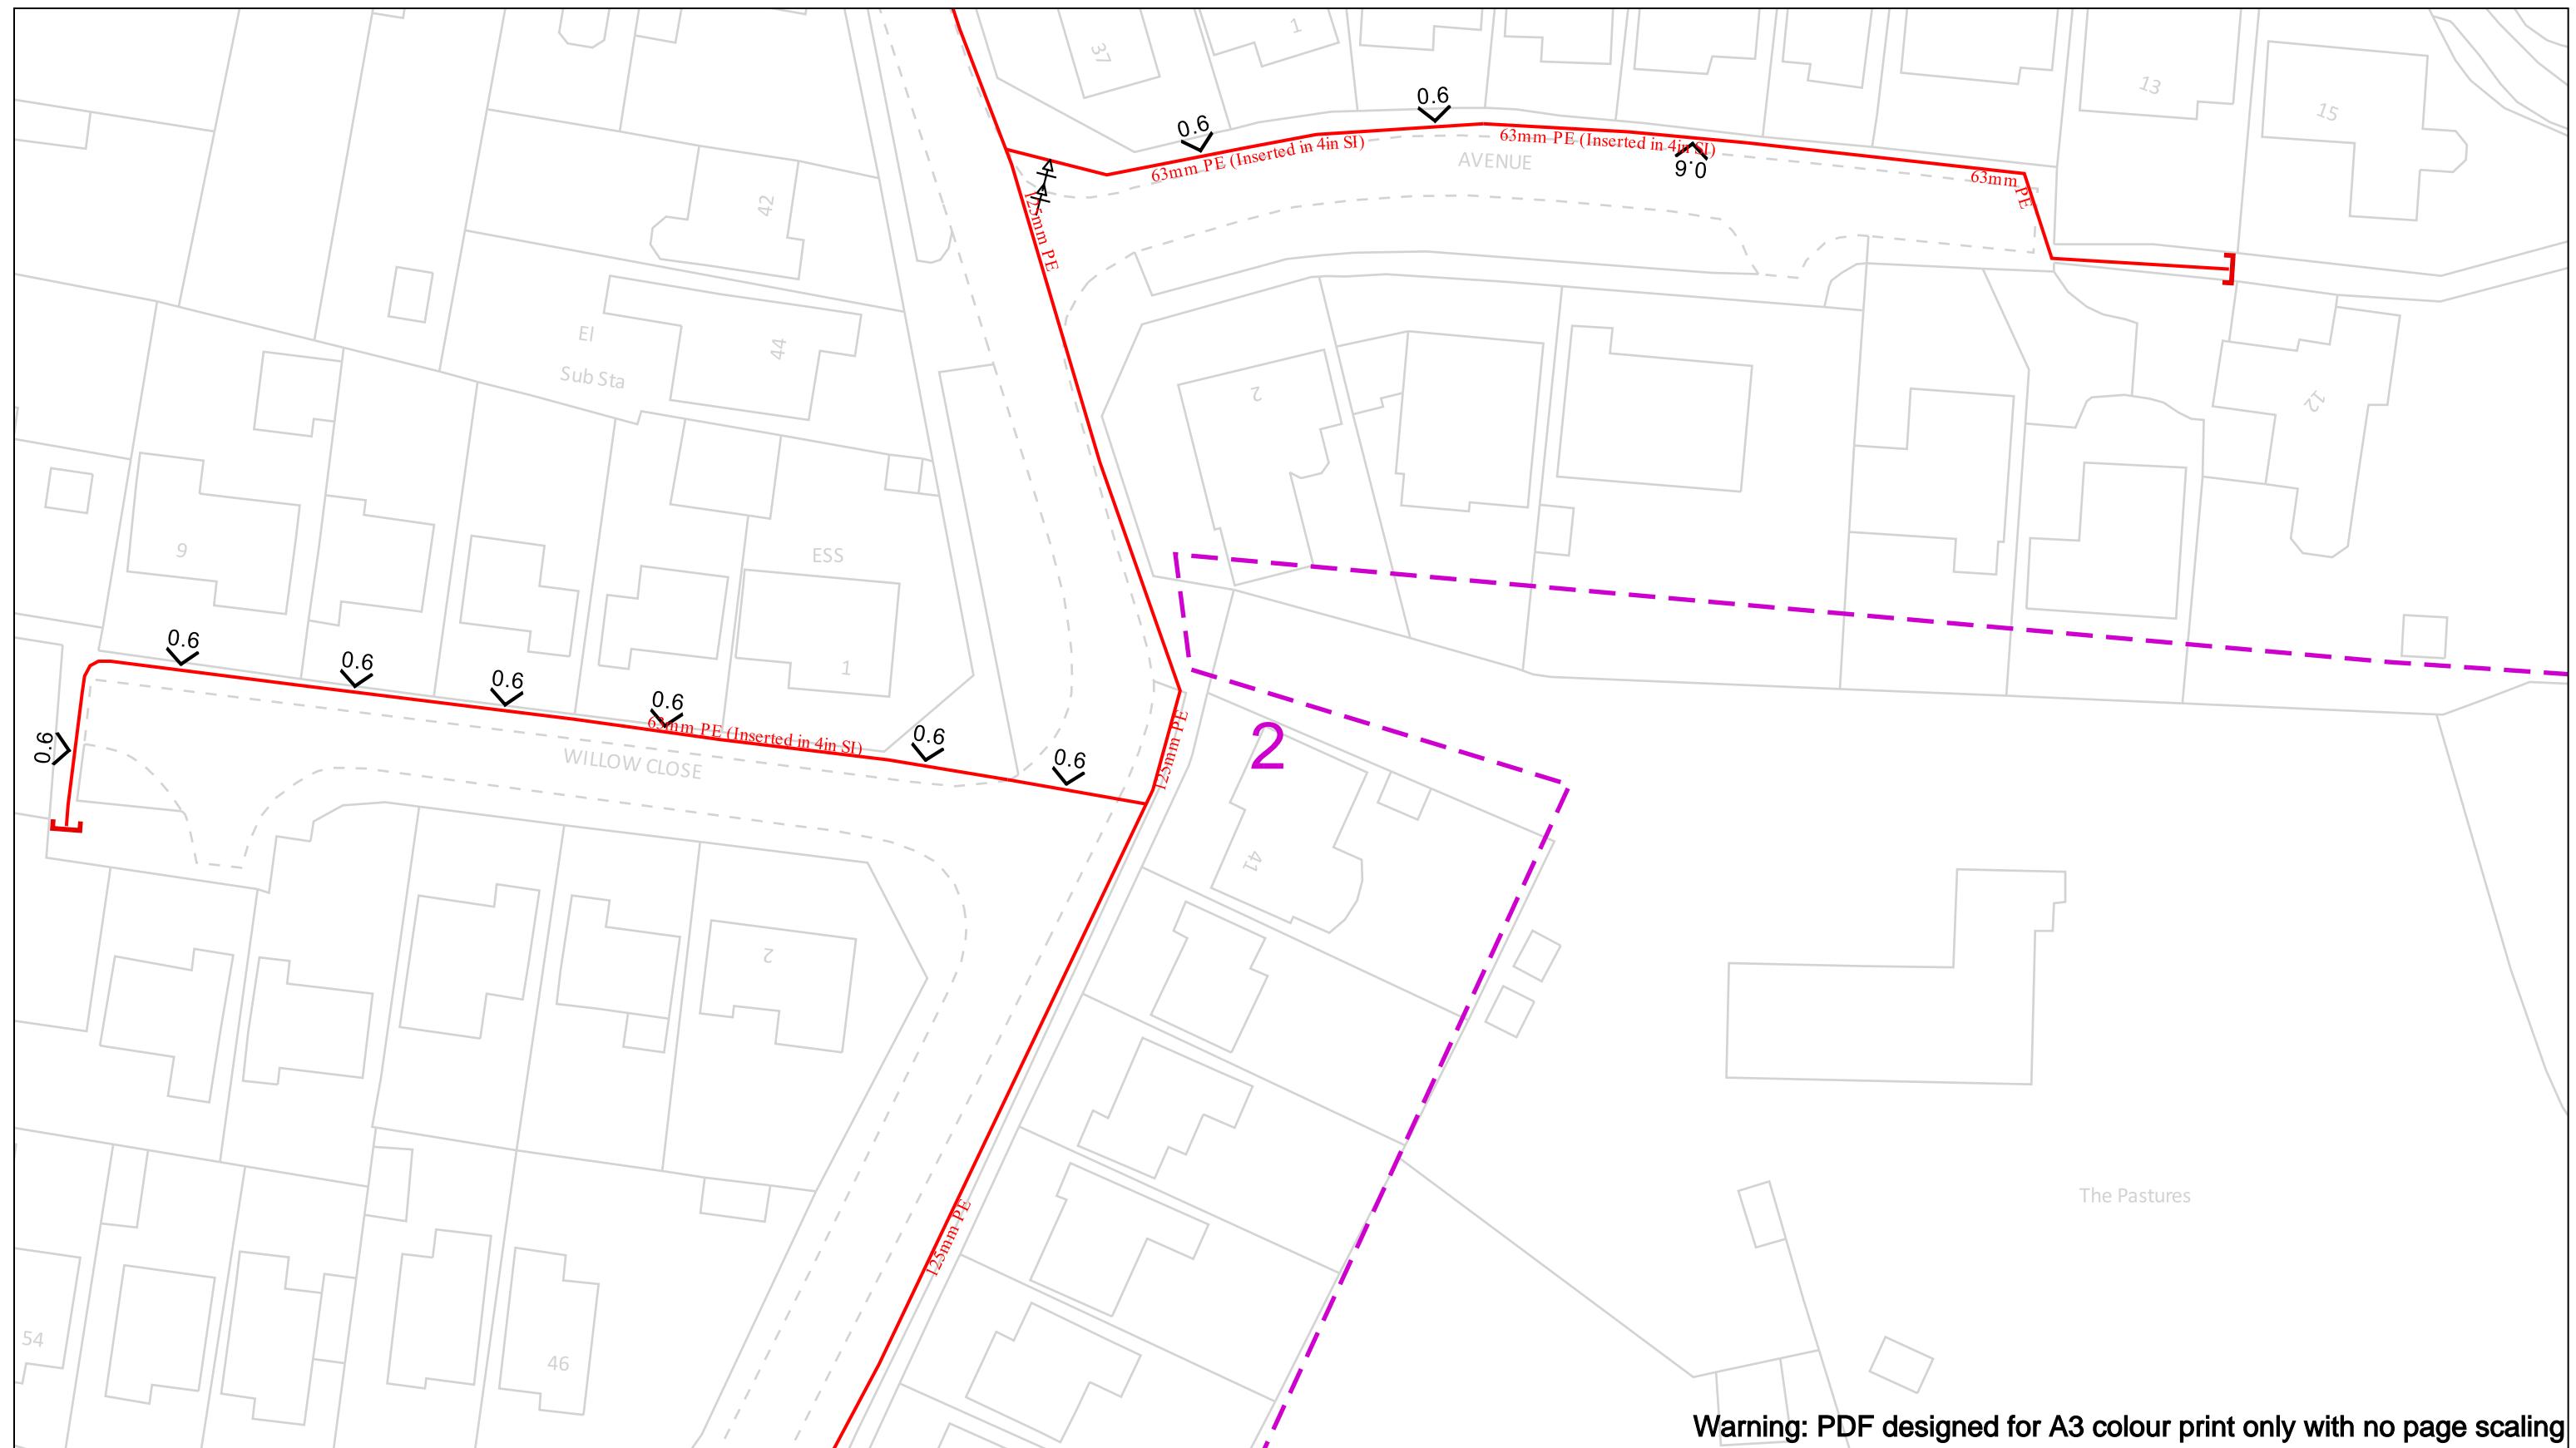

Warning: PDF designed for A3 colour print only with no page scaling

	<p>View extent: 200m, 115m</p> <p>IMPORTANT NOTICES</p> <p>This plan shows these pipes owned by Cadent Gas Limited in its role as a Licensed Gas Transporter (GT). Gas pipes owned by other GT's or otherwise privately owned may be present in this area. Information with regards to such pipes should be obtained from the relevant owners. The information shown on this plan is given without warranty, the accuracy thereof cannot be guaranteed. Service pipes, valves, siphons, stub connections etc. are not shown but their presence should be anticipated. No liability of any kind whatsoever is accepted by Cadent Gas Limited or their agents, servants or contractors for any errors or omission. Safe digging practices, in accordance with HS(G)47, must be used to verify and establish the actual position of mains, pipes, services and other apparatus on site before any mechanical plant is used. It is your responsibility to ensure that this information is provided to all persons (either direct labour or contractors) working for you on or near gas apparatus. The information included on this plan should not be referred to beyond a period of 28 days from the date of issue.</p> <p>Scale: 1:500 (When plotted at A3)</p>	<p>In case of an emergency call 0800 111 999</p> <p> 50m</p> <p>Where an out-of-standard service is present please contact plant protection 0800 688 588 for further information.</p> <p>Out-of-standard service symbology may be used to indicate one or more of the following:</p> <ul style="list-style-type: none"> • Identification of shallow services • Identification of dual services • Recording of non-perpendicular services <p>A perpendicular service/connection is laid in a straight line from the entry point at the property to the connection at the main – this includes a pipe that has a perpendicular connection and is not straight but does not deviate more than 1m off centre line.</p>
--	--	---

Cadent

3


Tennis Courts

Warning: PDF designed for A3 colour print only with no page scaling

	<p>View extent: 200m, 115m</p> <p>IMPORTANT NOTICES</p> <p>This plan shows these pipes owned by Cadent Gas Limited in its role as a Licensed Gas Transporter (GT). Gas pipes owned by other GT's or otherwise privately owned may be present in this area. Information with regards to such pipes should be obtained from the relevant owners. The information shown on this plan is given without warranty, the accuracy thereof cannot be guaranteed. Service pipes, valves, syphons, stub connections etc. are not shown but their presence should be anticipated. No liability of any kind whatsoever is accepted by Cadent Gas Limited or their agents, servants or contractors for any errors or omission. Safe digging practices, in accordance with HS(G)47, must be used to verify and establish the actual position of mains, pipes, services and other apparatus on site before any mechanical plant is used. It is your responsibility to ensure that this information is provided to all persons (either direct labour or contractors) working for you on or near gas apparatus. The information included on this plan should not be referred to beyond a period of 28 days from the date of issue.</p> <p>Date Requested: 21/03/2024 Job Reference: 32864702 Site Location: 444784 303319 Requested by: Mr Tom Furlong Your Scheme/Reference: - Newbold Verdon, Phase 2</p> <p>Scale: 1:500 (When plotted at A3)</p>	<p>In case of an emergency call 0800 111 999</p> <p>50m</p> <p>Dig Sites</p> <p>Area:  Line: </p> <p>Legend:</p> <ul style="list-style-type: none">LP Mains (Red solid line)MP Mains (Blue contact plant protection 0800 688 588 for further information. Out-of-standard service symbology may be used to indicate one or more of the following:</p> <ul style="list-style-type: none">Identification of shallow servicesIdentification of dual servicesRecording of non-perpendicular services <p>A perpendicular service/connection is laid in a straight line from the entry point at the property to the connection at the main – this includes a pipe that has a perpendicular connection and is not straight but does not deviate more than 1m off centre line.</p>	<p>Cadent Your Gas Network</p>
--	---	---	---



<p>Date Requested: 21/03/2024 Job Reference: 32864702 Site Location: 444784 303319 Requested by: Mr Tom Furlong Your Scheme/Reference: - Newbold Verdon, Phase 2</p> <p>Scale: 1:500 (When plotted at A3)</p>	<p>View extent: 200m, 115m</p> <p>IMPORTANT NOTICES</p> <p>This plan shows these pipes owned by Cadent Gas Limited in its role as a Licensed Gas Transporter (GT). Gas pipes owned by other GT's or otherwise privately owned may be present in this area. Information with regards to such pipes should be obtained from the relevant owners. The information shown on this plan is given without warranty, the accuracy thereof cannot be guaranteed. Service pipes, valves, siphons, stub connections etc. are not shown but their presence should be anticipated. No liability of any kind whatsoever is accepted by Cadent Gas Limited or their agents, servants or contractors for any errors or omission. Safe digging practices, in accordance with HS(G)47, must be used to verify and establish the actual position of mains, pipes, services and other apparatus on site before any mechanical plant is used. It is your responsibility to ensure that this information is provided to all persons (either direct labour or contractors) working for you on or near gas apparatus. The information included on this plan should not be referred to beyond a period of 28 days from the date of issue.</p>	<p>In case of an emergency call 0800 111 999</p> <p>50m</p> <p>Dig Sites</p> <p>Area: Line: </p> <table border="0"> <tr> <td> LP Mains</td><td> MP Mains</td><td> IP Mains</td><td> LHP Mains</td></tr> <tr> <td> Valve</td><td> Diameter Change</td><td> Depth of cover</td><td> Material Change</td></tr> <tr> <td> Syphon</td><td> Out of Standard Service</td><td colspan="2" rowspan="2"></td></tr> </table> <p>Where an out-of-standard service is present please contact plant protection 0800 688 588 for further information. Out-of-standard service symbology may be used to indicate one or more of the following:</p> <ul style="list-style-type: none"> Identification of shallow services Identification of dual services Recording of non-perpendicular services <p>A perpendicular service/connection is laid in a straight line from the entry point at the property to the connection at the main – this includes a pipe that has a perpendicular connection and is not straight but does not deviate more than 1m off centre line.</p>	LP Mains	MP Mains	IP Mains	LHP Mains	Valve	Diameter Change	Depth of cover	Material Change	Syphon	Out of Standard Service			<p>Cadent Your Gas Network</p>
LP Mains	MP Mains	IP Mains	LHP Mains												
Valve	Diameter Change	Depth of cover	Material Change												
Syphon	Out of Standard Service														
<p>Crown Copyright © - This plan is reproduced from or based on the OS map by Cadent Gas Limited, with the sanction of the controller of HM Stationery Office. Crown Copyright Reserved. Ordnance Survey Licence number 100024886</p>															

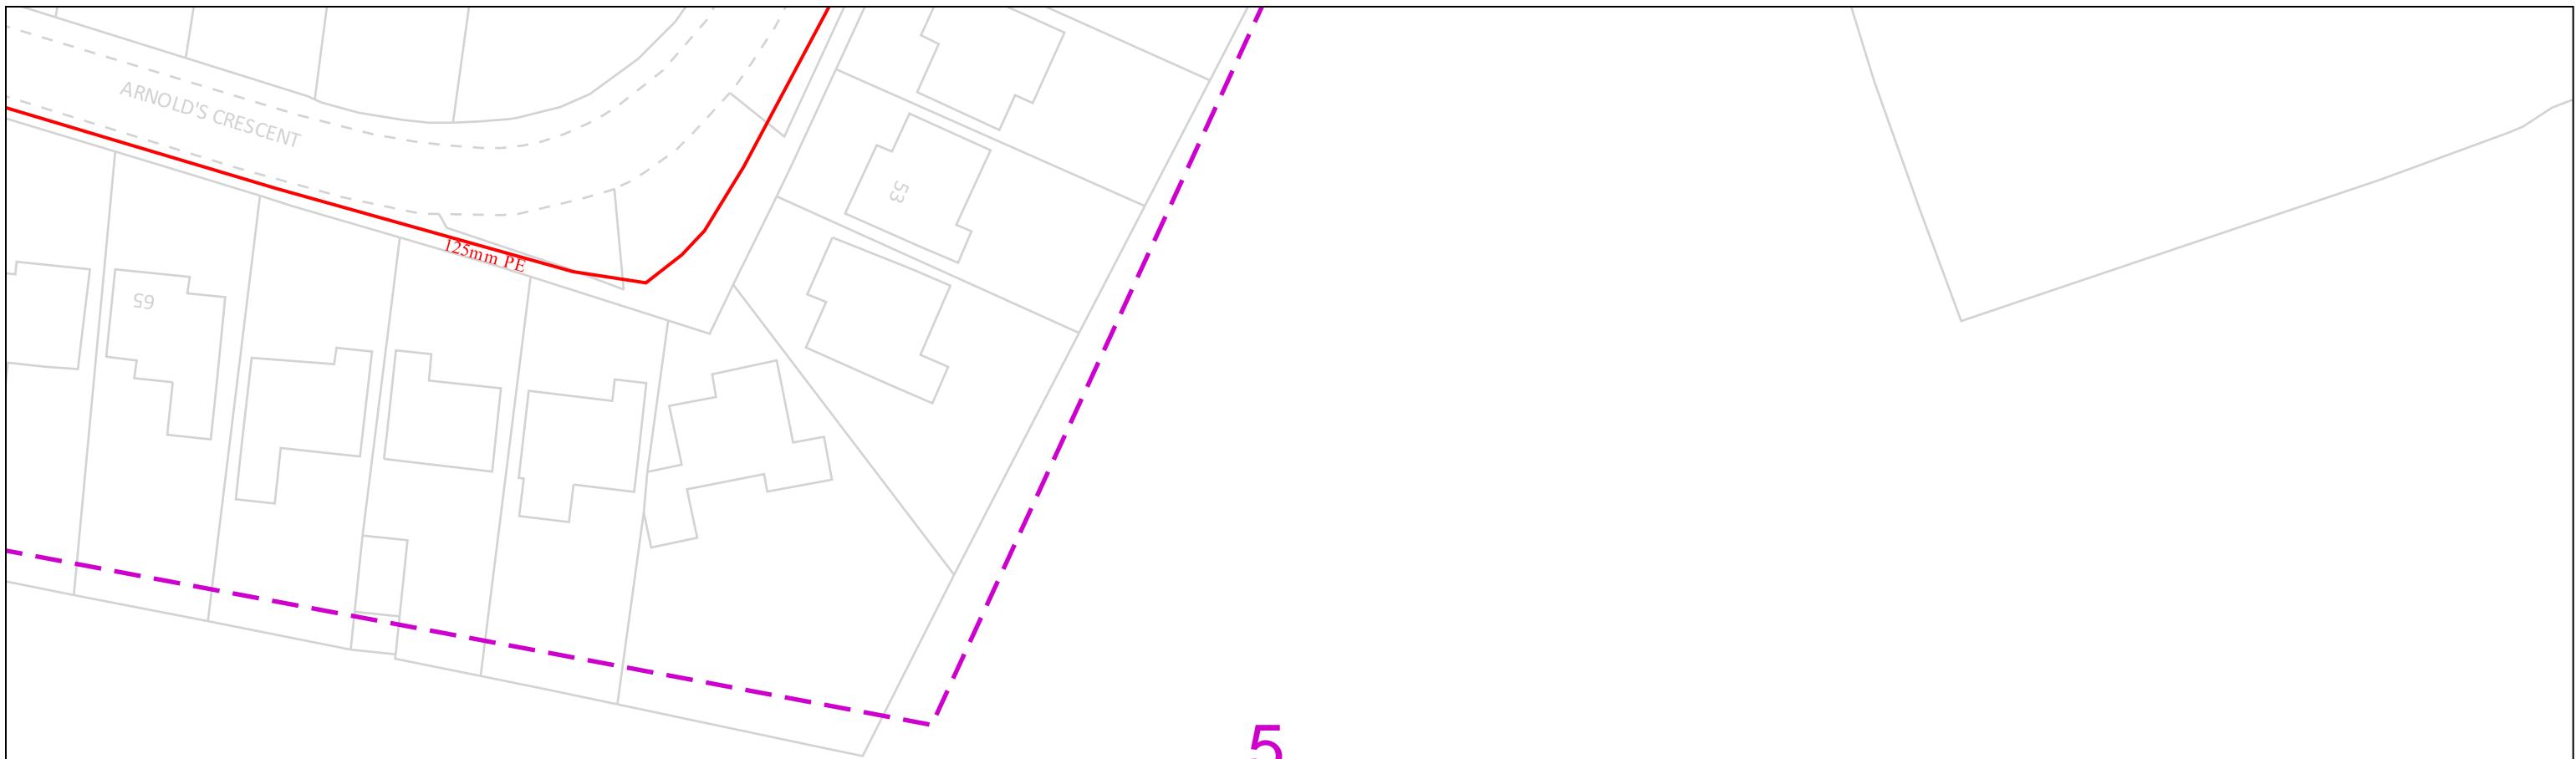

5

Warning: PDF designed for A3 colour print only with no page scaling

	<p>View extent: 200m, 115m</p> <p>IMPORTANT NOTICES</p> <p>This plan shows these pipes owned by Cadent Gas Limited in its role as a Licensed Gas Transporter (GT). Gas pipes owned by other GT's or otherwise privately owned may be present in this area. Information with regards to such pipes should be obtained from the relevant owners. The information shown on this plan is given without warranty, the accuracy thereof cannot be guaranteed. Service pipes, valves, syphons, stub connections etc. are not shown but their presence should be anticipated. No liability of any kind whatsoever is accepted by Cadent Gas Limited or their agents, servants or contractors for any errors or omission. Safe digging practices, in accordance with HS(G)47, must be used to verify and establish the actual position of mains, pipes, services and other apparatus on site before any mechanical plant is used. It is your responsibility to ensure that this information is provided to all persons (either direct labour or contractors) working for you on or near gas apparatus. The information included on this plan should not be referred to beyond a period of 28 days from the date of issue.</p>	<p>In case of an emergency call 0800 111 999</p> <p>50m</p> <p>Dig Sites</p> <p>Area: Line: </p> <p>50m</p> <p>Where an out-of-standard service is present please contact plant protection 0800 688 588 for further information.</p> <p>Out-of-standard service symbology may be used to indicate one or more of the following:</p> <ul style="list-style-type: none"> Identification of shallow services Identification of dual services Recording of non-perpendicular services <p>A perpendicular service/connection is laid in a straight line from the entry point at the property to the connection at the main – this includes a pipe that has a perpendicular connection and is not straight but does not deviate more than 1m off centre line.</p>
<p>Date Requested: 21/03/2024 Job Reference: 32864702 Site Location: 444784 303319 Requested by: Mr Tom Furlong Your Scheme/Reference: - Newbold Verdon, Phase 2</p> <p>Scale: 1:500 (When plotted at A3)</p>	<p>LP Mains</p> <p>MP Mains</p> <p>IP Mains</p> <p>LHP Mains</p> <p>Valve</p> <p>Diameter Change</p> <p>Depth of cover</p> <p>Material Change</p> <p>Syphon</p> <p>Out of Standard Service</p>	<p>Cadent Your Gas Network</p>
<p>Crown Copyright © - This plan is reproduced from or based on the OS map by Cadent Gas Limited, with the sanction of the controller of HM Stationery Office. Crown Copyright Reserved. Ordnance Survey Licence number 100024886</p>		

6

Warning: PDF designed for A3 colour print only with no page scaling

	<p>View extent: 200m, 115m</p> <p>IMPORTANT NOTICES</p> <p>This plan shows these pipes owned by Cadent Gas Limited in its role as a Licensed Gas Transporter (GT). Gas pipes owned by other GT's or otherwise privately owned may be present in this area. Information with regards to such pipes should be obtained from the relevant owners. The information shown on this plan is given without warranty, the accuracy thereof cannot be guaranteed. Service pipes, valves, syphons, stub connections etc. are not shown but their presence should be anticipated. No liability of any kind whatsoever is accepted by Cadent Gas Limited or their agents, servants or contractors for any errors or omission. Safe digging practices, in accordance with HS(G)47, must be used to verify and establish the actual position of mains, pipes, services and other apparatus on site before any mechanical plant is used. It is your responsibility to ensure that this information is provided to all persons (either direct labour or contractors) working for you on or near gas apparatus. The information included on this plan should not be referred to beyond a period of 28 days from the date of issue.</p> <p>Date Requested: 21/03/2024 Job Reference: 32864702 Site Location: 444784 303319 Requested by: Mr Tom Furlong Your Scheme/Reference: - Newbold Verdon, Phase 2</p> <p>Scale: 1:500 (When plotted at A3)</p>	<p>In case of an emergency call 0800 111 999</p> <p>50m</p> <p>Dig Sites</p> <p>Area:  Line: </p> <p>50m</p> <p>Where an out-of-standard service is present please contact plant protection 0800 688 588 for further information.</p> <p>Out-of-standard service symbology may be used to indicate one or more of the following:</p> <ul style="list-style-type: none">Identification of shallow servicesIdentification of dual servicesRecording of non-perpendicular services <p>A perpendicular service/connection is laid in a straight line from the entry point at the property to the connection at the main – this includes a pipe that has a perpendicular connection and is not straight but does not deviate more than 1m off centre line.</p> <p>LP Mains MP Mains IP Mains LHP Mains</p> <p>Valve Diameter Change Depth of cover Material Change Syphon Out of Standard Service</p>	<p>Cadent Your Gas Network</p>
--	---	---	---

Track

7

Warning: PDF designed for A3 colour print only with no page scaling

	<p>View extent: 200m, 115m</p> <p>IMPORTANT NOTICES</p> <p>This plan shows these pipes owned by Cadent Gas Limited in its role as a Licensed Gas Transporter (GT). Gas pipes owned by other GT's or otherwise privately owned may be present in this area. Information with regards to such pipes should be obtained from the relevant owners. The information shown on this plan is given without warranty, the accuracy thereof cannot be guaranteed. Service pipes, valves, syphons, stub connections etc. are not shown but their presence should be anticipated. No liability of any kind whatsoever is accepted by Cadent Gas Limited or their agents, servants or contractors for any errors or omission. Safe digging practices, in accordance with HS(G)47, must be used to verify and establish the actual position of mains, pipes, services and other apparatus on site before any mechanical plant is used. It is your responsibility to ensure that this information is provided to all persons (either direct labour or contractors) working for you on or near gas apparatus. The information included on this plan should not be referred to beyond a period of 28 days from the date of issue.</p> <p>Date Requested: 21/03/2024 Job Reference: 32864702 Site Location: 444784 303319 Requested by: Mr Tom Furlong Your Scheme/Reference: - Newbold Verdon, Phase 2</p> <p>Scale: 1:500 (When plotted at A3)</p>	<p>In case of an emergency call 0800 111 999</p> <p>50m</p> <p>Dig Sites</p> <p>Area:  Line: </p> <p>LP Mains  MP Mains  IP Mains  LHP Mains </p> <p>Valve  Diameter Change </p> <p>Depth of cover  Material Change </p> <p>Syphon  Out of Standard Service </p> <p>Where an out-of-standard service is present please contact plant protection 0800 688 588 for further information. Out-of-standard service symbology may be used to indicate one or more of the following:</p> <ul style="list-style-type: none">Identification of shallow servicesIdentification of dual servicesRecording of non-perpendicular services <p>A perpendicular service/connection is laid in a straight line from the entry point at the property to the connection at the main – this includes a pipe that has a perpendicular connection and is not straight but does not deviate more than 1m off centre line.</p>	<p>Cadent Your Gas Network</p>
<p>Crown Copyright © - This plan is reproduced from or based on the OS map by Cadent Gas Limited, with the sanction of the controller of HM Stationery Office. Crown Copyright Reserved. Ordnance Survey Licence number 100024886</p>			

8

Warning: PDF designed for A3 colour print only with no page scaling


	<p>View extent: 200m, 115m</p> <p>IMPORTANT NOTICES</p> <p>This plan shows these pipes owned by Cadent Gas Limited in its role as a Licensed Gas Transporter (GT). Gas pipes owned by other GT's or otherwise privately owned may be present in this area. Information with regards to such pipes should be obtained from the relevant owners. The information shown on this plan is given without warranty, the accuracy thereof cannot be guaranteed. Service pipes, valves, syphons, stub connections etc. are not shown but their presence should be anticipated. No liability of any kind whatsoever is accepted by Cadent Gas Limited or their agents, servants or contractors for any errors or omission. Safe digging practices, in accordance with HS(G)47, must be used to verify and establish the actual position of mains, pipes, services and other apparatus on site before any mechanical plant is used. It is your responsibility to ensure that this information is provided to all persons (either direct labour or contractors) working for you on or near gas apparatus. The information included on this plan should not be referred to beyond a period of 28 days from the date of issue.</p> <p>Date Requested: 21/03/2024 Job Reference: 32864702 Site Location: 444784 303319 Requested by: Mr Tom Furlong Your Scheme/Reference: - Newbold Verdon, Phase 2</p> <p>Scale: 1:500 (When plotted at A3)</p>	<p>In case of an emergency call 0800 111 999</p> <p>50m</p> <p>Dig Sites</p> <p>Area:  Line: </p> <p>LP Mains  MP Mains  IP Mains  LHP Mains </p> <p>Valve  Diameter Change </p> <p>Depth of cover  Material Change </p> <p>Syphon  Out of Standard Service </p> <p>Where an out-of-standard service is present please contact plant protection 0800 688 588 for further information. Out-of-standard service symbology may be used to indicate one or more of the following:</p> <ul style="list-style-type: none">Identification of shallow servicesIdentification of dual servicesRecording of non-perpendicular services <p>A perpendicular service/connection is laid in a straight line from the entry point at the property to the connection at the main – this includes a pipe that has a perpendicular connection and is not straight but does not deviate more than 1m off centre line.</p>	<p>Cadent Your Gas Network</p>
<p>Crown Copyright © - This plan is reproduced from or based on the OS map by Cadent Gas Limited, with the sanction of the controller of HM Stationery Office. Crown Copyright Reserved. Ordnance Survey Licence number 100024886</p>			

9

Warning: PDF designed for A3 colour print only with no page scaling

<p>Date Requested: 21/03/2024 Job Reference: 32864702 Site Location: 444784 303319 Requested by: Mr Tom Furlong Your Scheme/Reference: - Newbold Verdon, Phase 2</p> <p>Scale: 1:500 (When plotted at A3)</p>	<p>View extent: 200m, 115m</p> <p>IMPORTANT NOTICES</p> <p>This plan shows these pipes owned by Cadent Gas Limited in its role as a Licensed Gas Transporter (GT). Gas pipes owned by other GT's or otherwise privately owned may be present in this area. Information with regards to such pipes should be obtained from the relevant owners. The information shown on this plan is given without warranty, the accuracy thereof cannot be guaranteed. Service pipes, valves, syphons, stub connections etc. are not shown but their presence should be anticipated. No liability of any kind whatsoever is accepted by Cadent Gas Limited or their agents, servants or contractors for any errors or omission. Safe digging practices, in accordance with HS(G)47, must be used to verify and establish the actual position of mains, pipes, services and other apparatus on site before any mechanical plant is used. It is your responsibility to ensure that this information is provided to all persons (either direct labour or contractors) working for you on or near gas apparatus. The information included on this plan should not be referred to beyond a period of 28 days from the date of issue.</p>	<p>In case of an emergency call 0800 111 999</p> <p>50m</p> <p>Dig Sites</p> <p>Area:  Line: </p> <table border="0"> <tr> <td> LP Mains</td><td> MP Mains</td><td> IP Mains</td><td> LHP Mains</td></tr> <tr> <td> Valve</td><td> Diameter Change</td><td> Depth of cover</td><td> Material Change</td></tr> <tr> <td> Syphon</td><td> Out of Standard Service</td><td colspan="2"></td></tr> </table> <p>Where an out-of-standard service is present please contact plant protection 0800 688 588 for further information. Out-of-standard service symbology may be used to indicate one or more of the following:</p> <ul style="list-style-type: none"> • Identification of shallow services • Identification of dual services • Recording of non-perpendicular services <p>A perpendicular service/connection is laid in a straight line from the entry point at the property to the connection at the main – this includes a pipe that has a perpendicular connection and is not straight but does not deviate more than 1m off centre line.</p>	 LP Mains	 MP Mains	 IP Mains	 LHP Mains	 Valve	 Diameter Change	 Depth of cover	 Material Change	 Syphon	 Out of Standard Service			<p>Cadent Your Gas Network</p>
 LP Mains	 MP Mains	 IP Mains	 LHP Mains												
 Valve	 Diameter Change	 Depth of cover	 Material Change												
 Syphon	 Out of Standard Service														

APPENDIX 5: SEVERN TRENT WATER

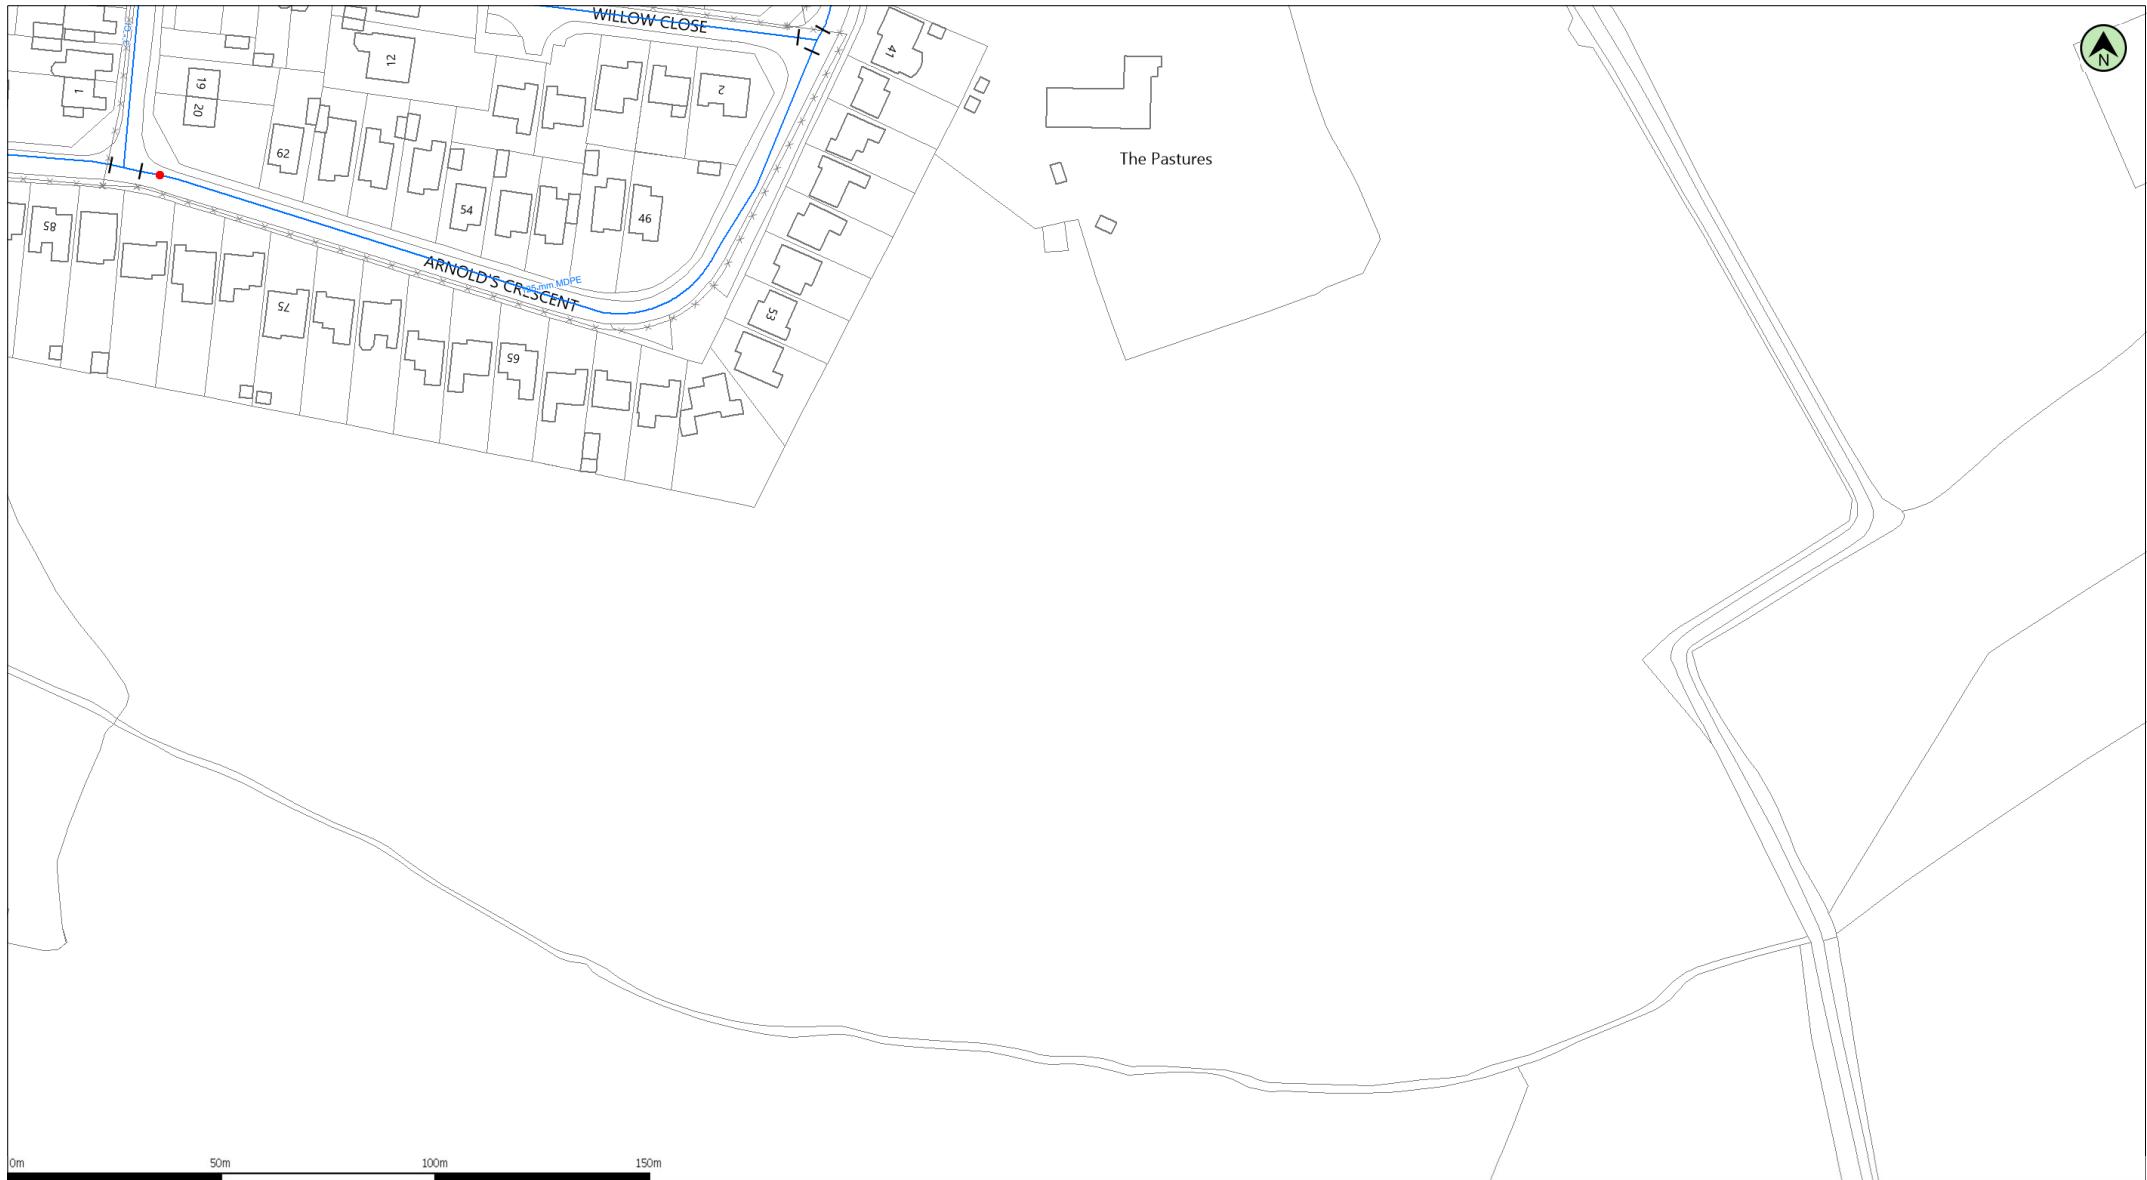

(c) Crown copyright and database rights 2024 Ordnance Survey 100031673

Date: 27/03/24

Scale: 1:1250

Map Centre: 444854,303296

Data updated: 14/03/24

Our Ref: 1431865 - 1

Clean Water Plan A3

Do not scale off this map. The plan and any information supplied with it is furnished as a general guide, is only valid at the date of issue and no warranty as to its correctness is given or implied. In particular this plan and any information shown on it must not be relied upon in the event of any development or works (including but not limited to excavations) in the vicinity of SEVERN TRENT WATER assets or for the purposes of determining the suitability of a point of connection to the sewerage or distribution systems. Reproduction by permission of Ordnance Survey on behalf of HMSO. ©Crown Copyright and database rights 2024. All rights reserved. Ordnance Survey licence number 100031673. Document users other than SEVERN TRENT WATER business users are advised that this document is provided for reference purpose only and is subject to copyright, therefore, no further copies should be made from it.



tom.furlong@bwbconsulting.com
Newbold Verdon

SEVERN
TRENT

GENERAL CONDITIONS AND PRECAUTIONS TO BE TAKEN WHEN CARRYING OUT WORK ADJACENT TO SEVERN TRENT WATER'S APPARATUS

Please ensure that a copy of these conditions is passed to your representative and/or your contractor on site. If any damage is caused to Severn Trent Water Limited (STW) apparatus (defined below), the person, contractor or subcontractor responsible must inform STW immediately on:
0800 783 4444 (24 hours)

- a) These general conditions and precautions apply to the public sewerage, water distribution and cables in ducts including (but not limited to) sewers which are the subject of an Agreement under Section 104 of the Water Industry Act 1991(a legal agreement between a developer and STW, where a developer agrees to build sewers to an agreed standard, which STW will then adopt); mains installed in accordance with an agreement for the self-construction of water mains entered into with STW and the assets described at condition b) of these general conditions and precautions. Such apparatus is referred to as "STW Apparatus" in these general conditions and precautions.
- b) Please be aware that due to The Private Sewers Transfer Regulations June 2011, the number of public sewers has increased, but many of these are not shown on the public sewer record. However, some idea of their positions may be obtained from the position of inspection covers and their existence must be anticipated.
- c) On request, STW will issue a copy of the plan showing the approximate locations of STW Apparatus although in certain instances a charge will be made. The position of private drains, private sewers and water service pipes to properties are not normally shown but their presence must be anticipated. This plan and the information supplied with it is furnished as a general guide only and STW does not guarantee its accuracy.
- d) STW does not update these plans on a regular basis. Therefore the position and depth of STW Apparatus may change and this plan is issued subject to any such change. Before any works are carried out, you should confirm whether any changes to the plan have been made since it was issued.
- e) The plan must not be relied upon in the event of excavations or other works in the vicinity of STW Apparatus. It is your responsibility to ascertain the precise location of any STW Apparatus prior to undertaking any development or other works (including but not limited to excavations).
- f) No person or company shall be relieved from liability for loss and/or damage caused to STW Apparatus by reason of the actual position and/or depths of STW Apparatus being different from those shown on the plan.

In order to achieve safe working conditions adjacent to any STW Apparatus the following should be observed:

1. All STW Apparatus should be located by hand digging prior to the use of mechanical excavators.
2. All information set out in any plans received from us, or given by our staff at the site of the works, about the position and depth of the mains, is approximate. Every possible precaution should be taken to avoid damage to STW Apparatus. You or your contractor must ensure the safety of STW Apparatus and will be responsible for the cost of repairing any loss and/or damage caused (including without limitation replacement parts).
3. Water mains are normally laid at a depth of 900mm. No records are kept of customer service pipes which are normally laid at a depth of 750mm; but some idea of their positions may be obtained from the position of stop tap covers and their existence must be anticipated.
4. During construction work, where heavy plant will cross the line of STW Apparatus, specific crossing points must be agreed with STW and suitably reinforced where required. These crossing points should be clearly marked and crossing of the line of STW Apparatus at other locations must be prevented.
5. Where it is proposed to carry out piling or boring within 20 metres of any STW Apparatus, STW should be consulted to enable any affected STW Apparatus to be surveyed prior to the works commencing.
6. Where excavation of trenches adjacent to any STW Apparatus affects its support, the STW Apparatus must be supported to the satisfaction of STW. Water mains and some sewers are pressurised and can fail if excavation removes support to thrust blocks to bends and other fittings.
7. Where a trench is excavated crossing or parallel to the line of any STW Apparatus, the backfill should be adequately compacted to prevent any settlement which could subsequently cause damage to the STW Apparatus. In special cases, it may be necessary to provide permanent support to STW Apparatus which has been exposed over a length of the excavation before backfilling and reinstatement is carried out. There should be no concrete backfill in contact with the STW Apparatus.
8. No other apparatus should be laid along the line of STW Apparatus irrespective of clearance. Above ground apparatus must not be located within a minimum of 3 metres either side of the centre line of STW Apparatus for smaller sized pipes and 6 metres either side for larger sized pipes without prior approval. No manhole or chamber shall be built over or around any STW Apparatus.
9. A minimum radial clearance of 300 millimetres should be allowed between any plant or equipment being installed and existing STW Apparatus. We reserve the right to increase this distance where strategic assets are affected.
10. Where any STW Apparatus coated with a special wrapping is damaged, even to a minor extent, STW must be notified and the trench left open until the damage has been inspected and the necessary repairs have been carried out. In the case of any material damage to any STW Apparatus causing leakage, weakening of the mechanical strength of the pipe or corrosion-protection damage, the necessary remedial work will be recharged to you.
11. It may be necessary to adjust the finished level of any surface boxes which may fall within your proposed construction. Please ensure that these are not damaged, buried or otherwise rendered inaccessible as a result of the works and that all stop taps, valves, hydrants, etc. remain accessible and operable. Minor reduction in existing levels may result in conflict with STW Apparatus such as valve spindles or tops of hydrants housed under the surface boxes. Checks should be made during site investigations to ascertain the level of such STW Apparatus in order to determine any necessary alterations in advance of the works.
12. With regard to any proposed resurfacing works, you are required to contact STW on the number given above to arrange a site inspection to establish the condition of any STW Apparatus in the nature of surface boxes or manhole covers and frames affected by the works. STW will then advise on any measures to be taken, in the event of this a proportionate charge will be made.
13. You are advised that STW will not agree to either the erection of posts, directly over or within 1.0 metre of valves and hydrants,

14. No explosives are to be used in the vicinity of any STW Apparatus without prior consultation with STW.

TREE PLANTING RESTRICTIONS

There are many problems with the location of trees adjacent to sewers, water mains and other STW Apparatus and these can lead to the loss of trees and hence amenity to the area which many people may have become used to. It is best if the problem is not created in the first place. Set out below are the recommendations for tree planting in close proximity to public sewers, water mains and other STW Apparatus.

15. Please ensure that, in relation to STW Apparatus, the mature root systems and canopies of any tree planted do not and will not encroach within the recommended distances specified in the notes below.

16. Both Poplar and Willow trees have extensive root systems and should not be planted within 12 metres of a sewer, water main or other STW Apparatus.

17. The following trees and those of similar size, be they deciduous or evergreen, should not be planted within 6 metres of a sewer, water main or other STW Apparatus. E.g. Ash, Beech, Birch, most Conifers, Elm, Horse Chestnut, Lime, Oak, Sycamore, Apple and Pear. Asset Protection Statements Updated May 2014

18. STW personnel require a clear path to conduct surveys etc. No shrubs or bushes should be planted within 2 metre of the centre line of a sewer, water main or other STW Apparatus.

19. In certain circumstances, both STW and landowners may wish to plant shrubs/bushes in close proximity to a sewer, water main or other STW Apparatus for screening purposes. The following are shallow rooting and are suitable for this purpose: Blackthorn, Broom, Cotoneaster, Elder, Hazel, Laurel, Privet, Quickthorn, Snowberry, and most ornamental flowering shrubs.