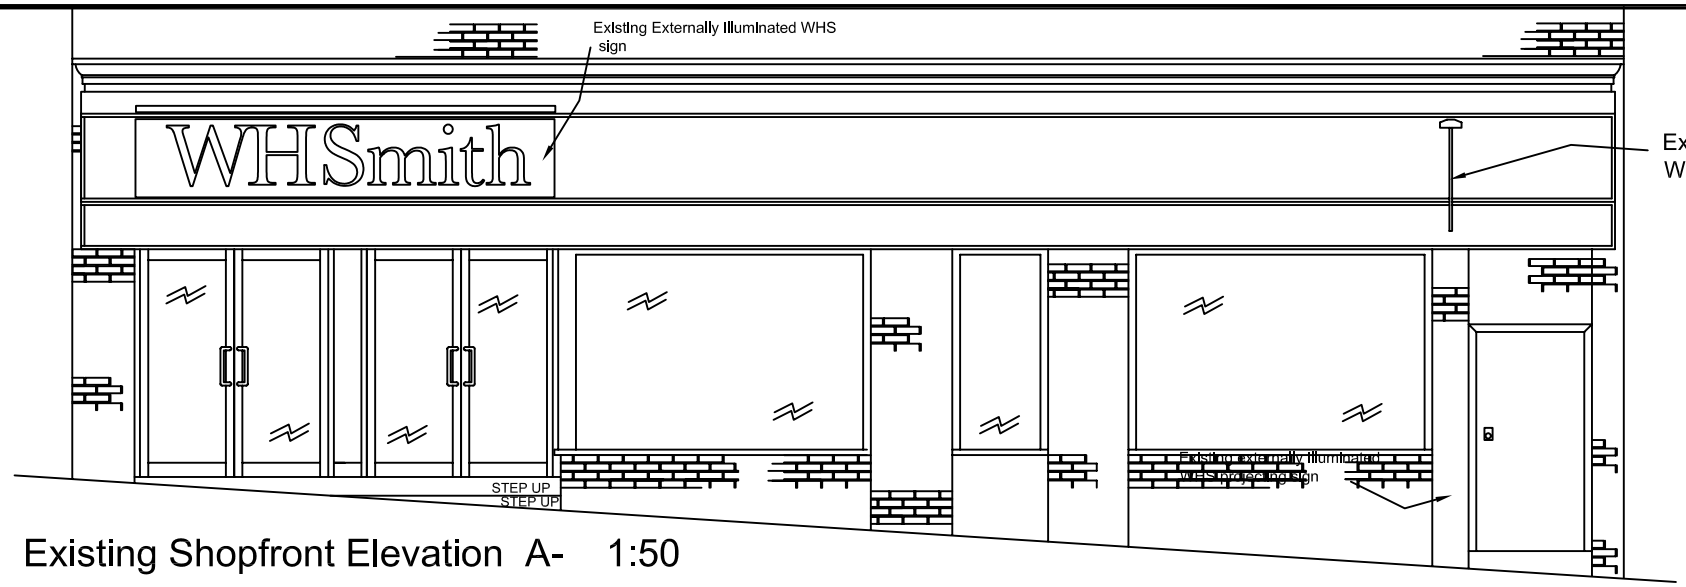

Existing Shopfront Elevation A- 1:50

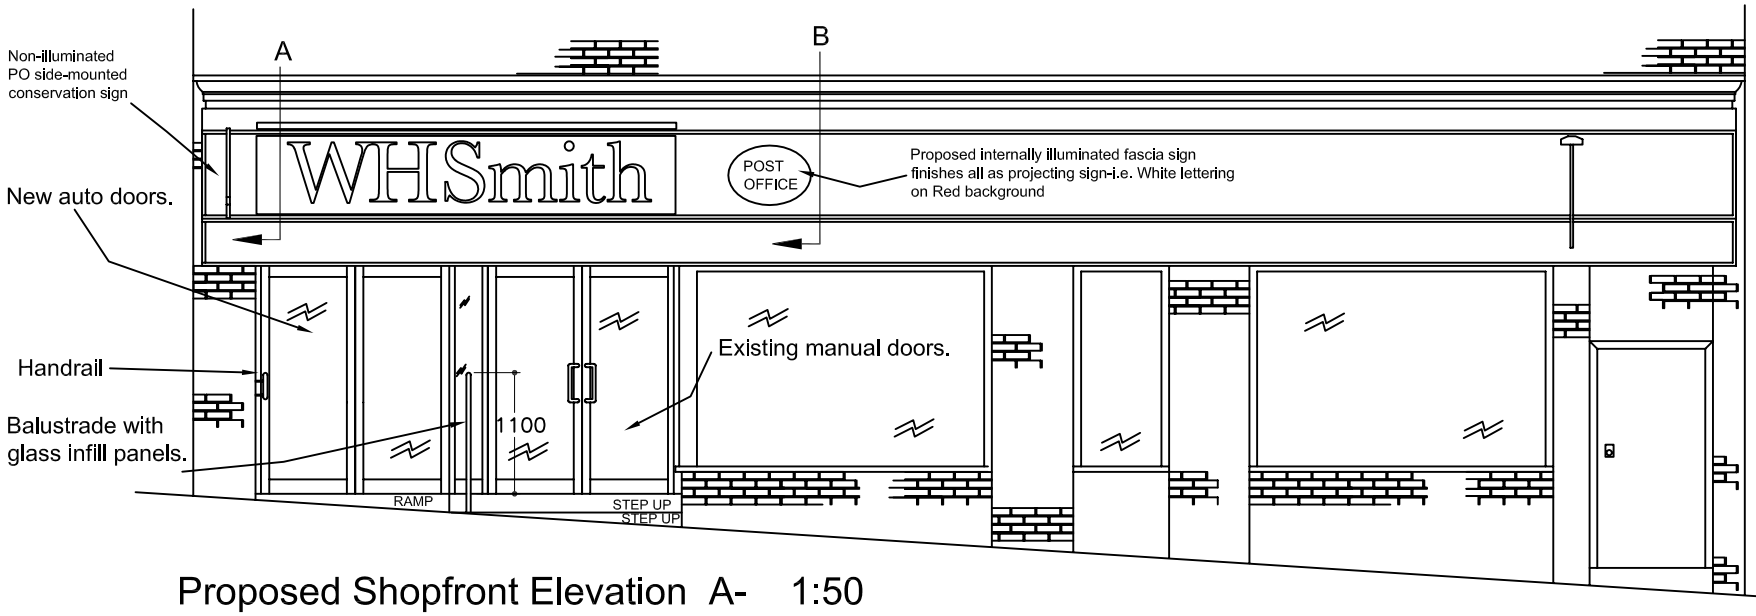

Proposed Shopfront Elevation A- 1:50

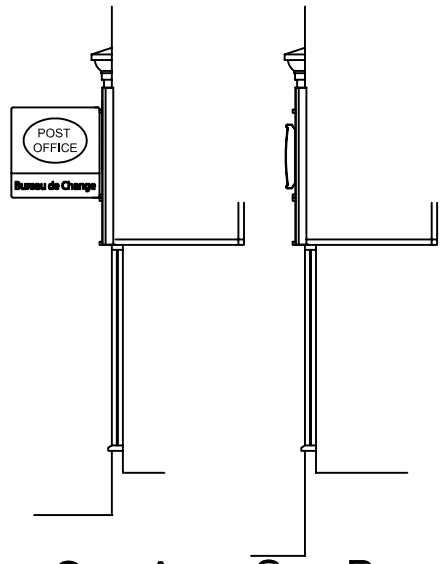

Sec A Sec B

Colur ref as follows
Red= Pantone 186
White=Ral 9003

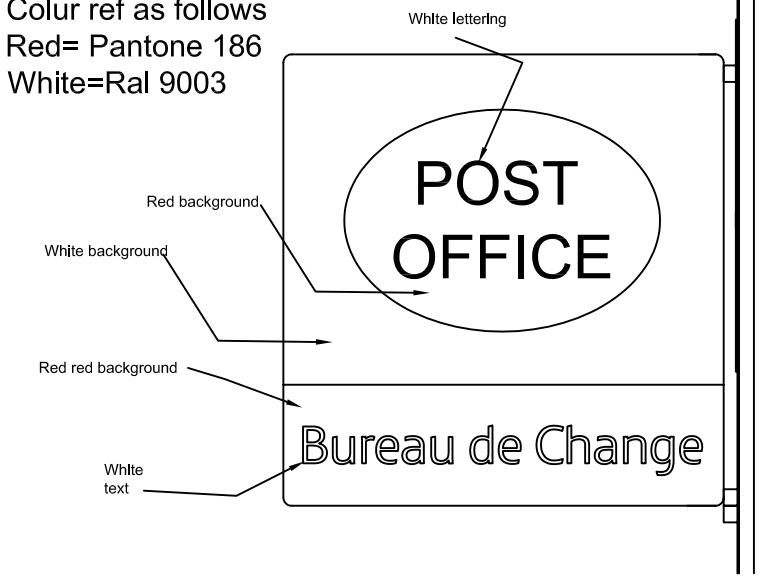

Elevation A- 1:10

Elevation of PO Fascia Signage. 1:10

AS BUILT

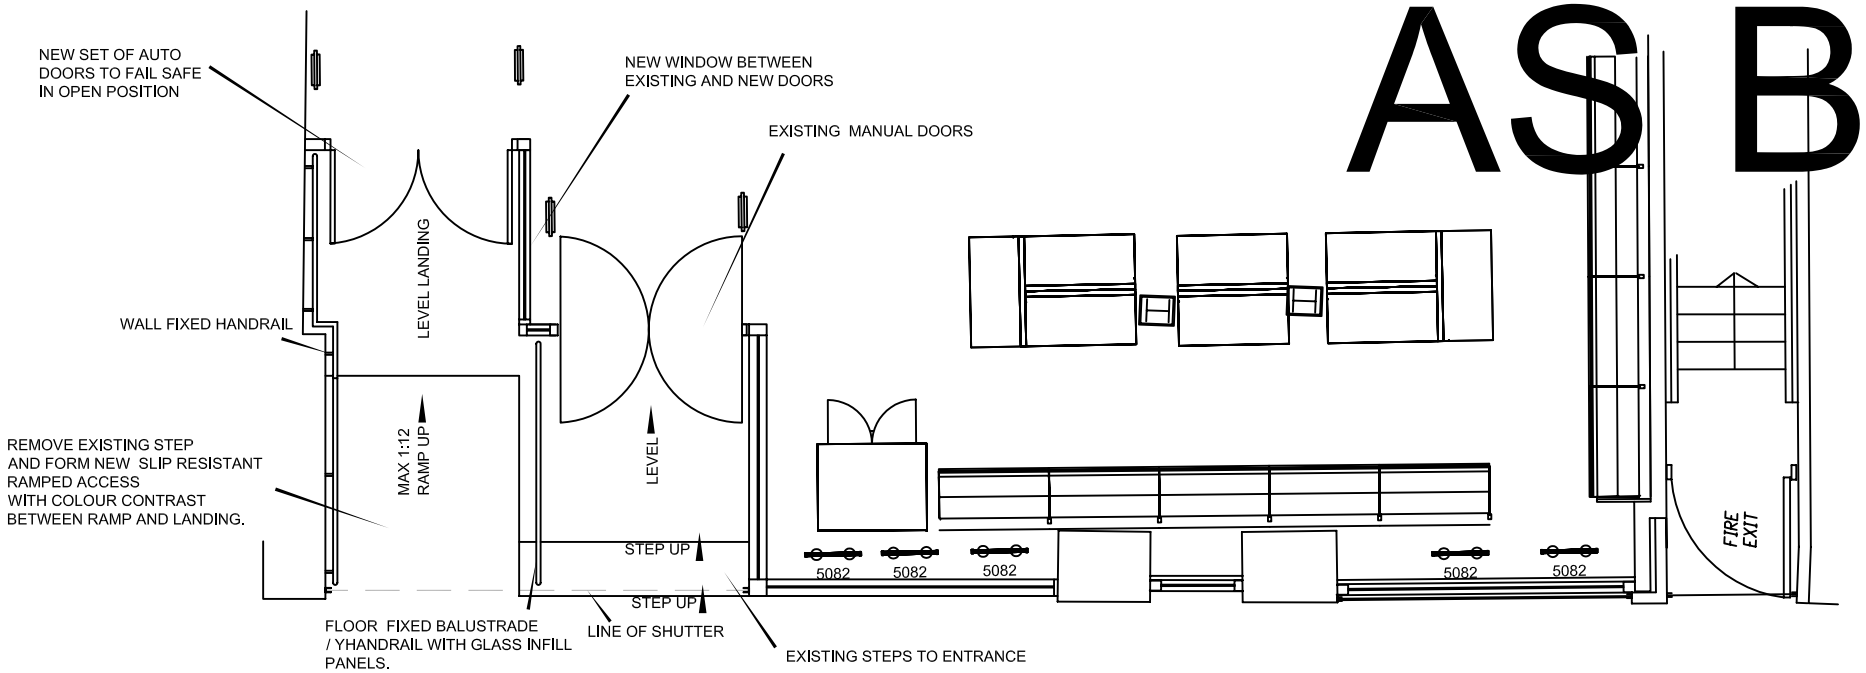

Proposed Shopfront Plan 1:50

Rev. No	Date	Revision
B	05.06.08	Projecting sign shown as built
A	10.12.07	Shopfront signage revised to new design

Business

WHSMITH HIGH STREET

Site Address

29-31 CASTLE STREET
HINCKLEY

Drawing Title

Shopfront Elevation

Branch No	Site No	Scale	Sheet Size
		1:50+1:10	A1

Drawn by	Date	Checked by	Approved by
AR	4th October 2007		

DRAWING NUMBER:	Project No	Sheet No	Rev No	Status
		03	B	

WHSmith Retail Ltd

Property Department

Greenbridge Road
Swindon
Wiltshire SN3 3LD
telephone (01793) 616161
facsimile (01793) 563291