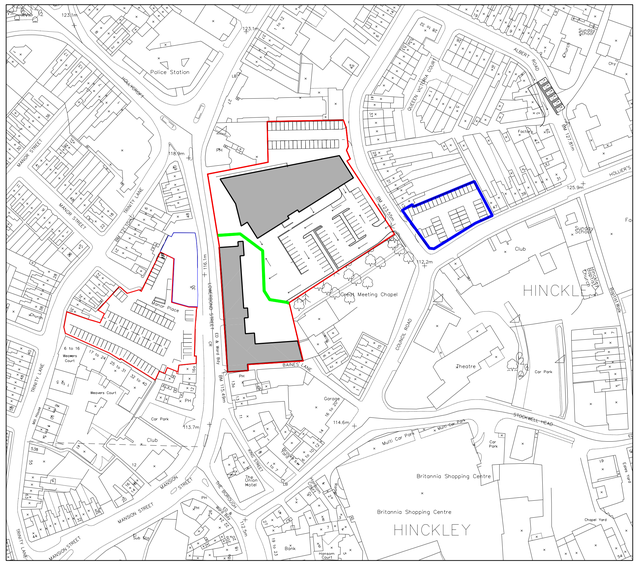

Location Plan @ 1:250

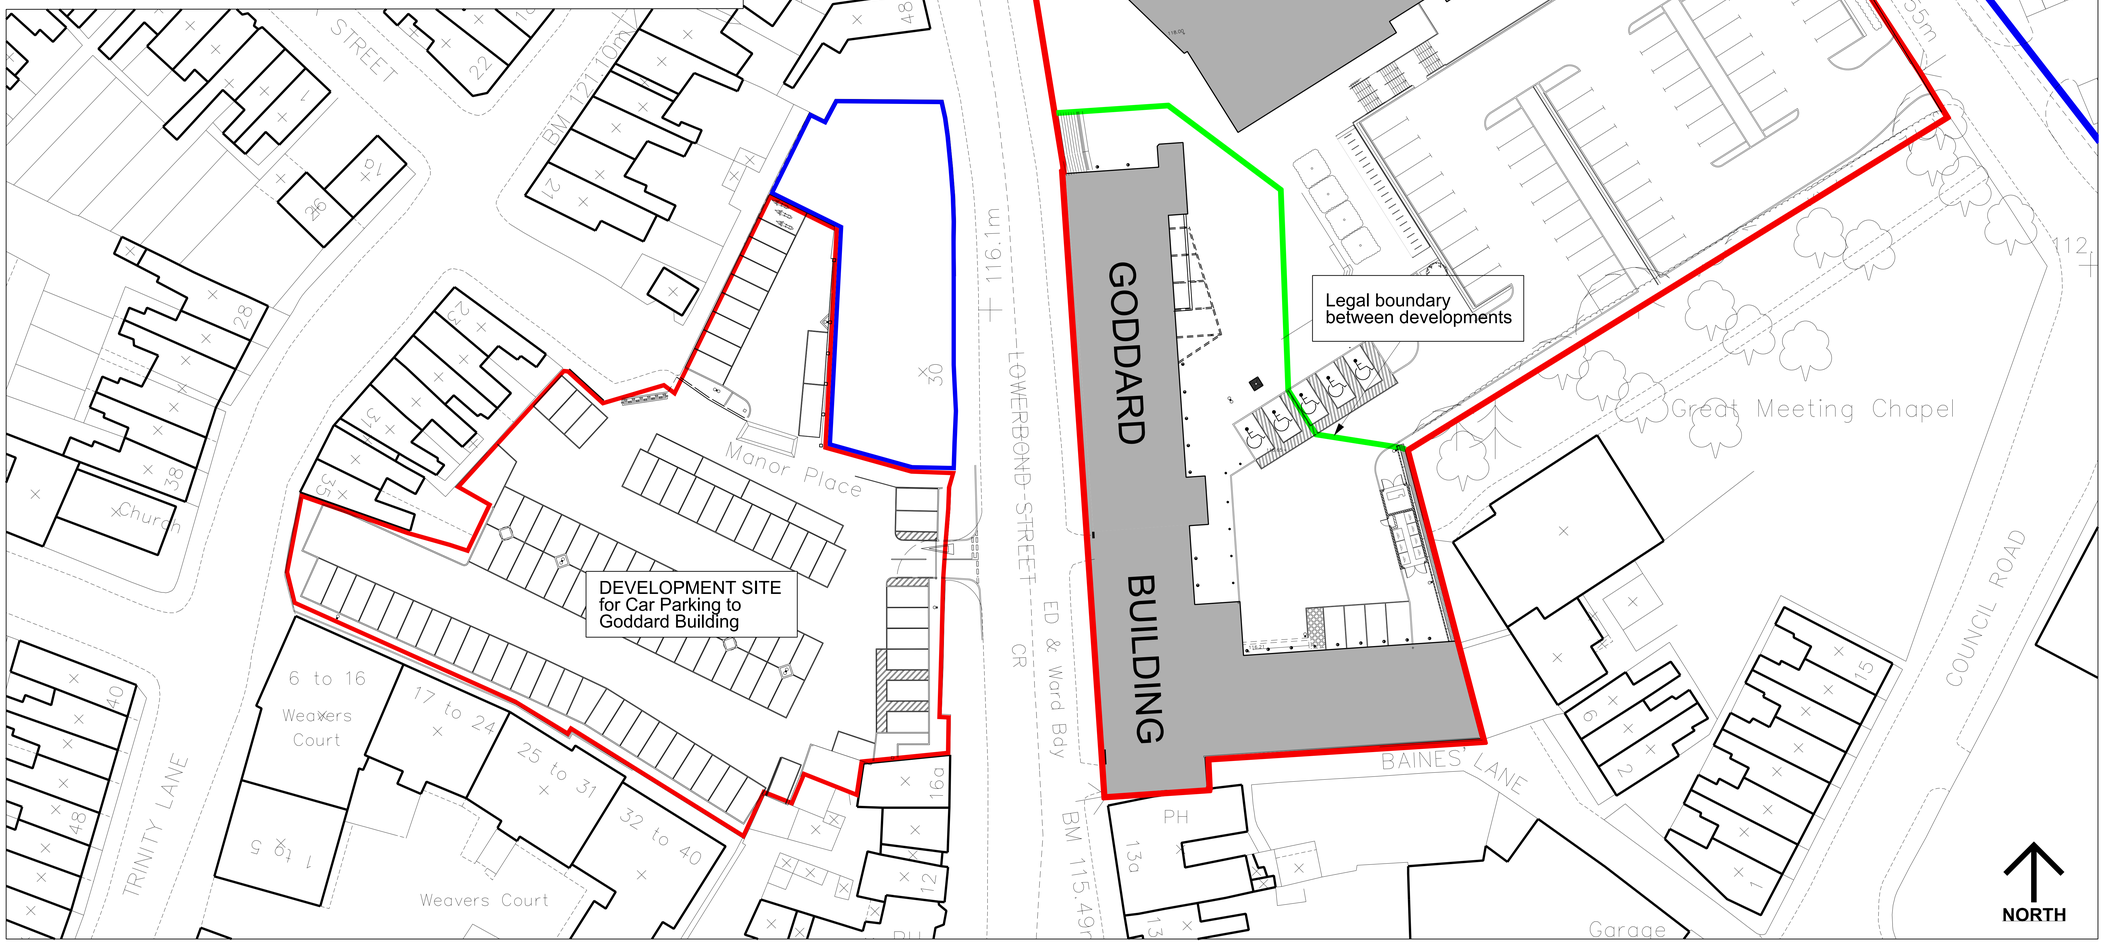

Block Plan @ 1:250

True Scale 100mm

© Archial Architects Ltd. Contractors must work only to figured dimensions which are to be checked on site.

NOTES

AS BUILT

"The information shown on this drawing reflects details originally incorporated or varied by ARCHIAL Architects Ltd and only such other variations as have been advised to them by other parties. ARCHIAL Architects Ltd cannot guarantee that such detail shown has been worked to."

Rev.	Date	By	Chk	Description
H	15.04.10	DH	GM	As built drawing issue
G	11.12.08	DH	GM	Planning boundary amended to include full extent of public footpath
F	09.12.08	DH	GM	College footprint and carparking added.
E	21.11.08	MA	GM	Dev. Site for Goddard Building Boundary amended
D	07.10.08	DC	GM	Planning boundary to Goddard Building amended
C	05.08.08	DC	GM	Site boundary amended
B	18.07.08	DC	GM	Site boundary amended
A	30.06.08	DC	GM	Notional development boundary added

Client

WILLMOTT DIXON

Project

The Goddard Building,
Lower Bond Street,
Hinckley

Drawing Title

Location & Block Plans

Drawn	Chkd	Scale	Date	Size
DC	GM	1:250 & 1:1250	MAY 08	A0

Job No.	Drawing No.	Rev.
08028	0100	H

archial

PREVIOUSLY SMC CORSTORPHINE & WRIGHT KENZIE LOVELL LTD

Brook Hall, Brook Street, Warwick CV34 4BL
Tel. 01926 402323
Fax. 01926 495318